

# TOWN OF ADDISON

## ADDISON, TEXAS

### LINDBERGH DRIVE WATERLINE REPLACEMENT

(FROM MIDWAY RD. TO APPROXIMATELY 1,350 L.F. EAST)

R. SCOTT WHEELER  
*Mayor*

GLYNDA TURNER  
*Mayor Pro-Tem*

DIANE MALLORY  
*Councilman*

BOB BARRETT  
*Councilman*


FRANK R. KLEIN  
*Councilman*

FREDRICK M. SILVER  
*Councilman*

RON WHITEHEAD  
*City Manager*

CATHY WAYS  
*Deputy Mayor Pro-Tem*

MIKE MURPHY  
*Director of Public Works*

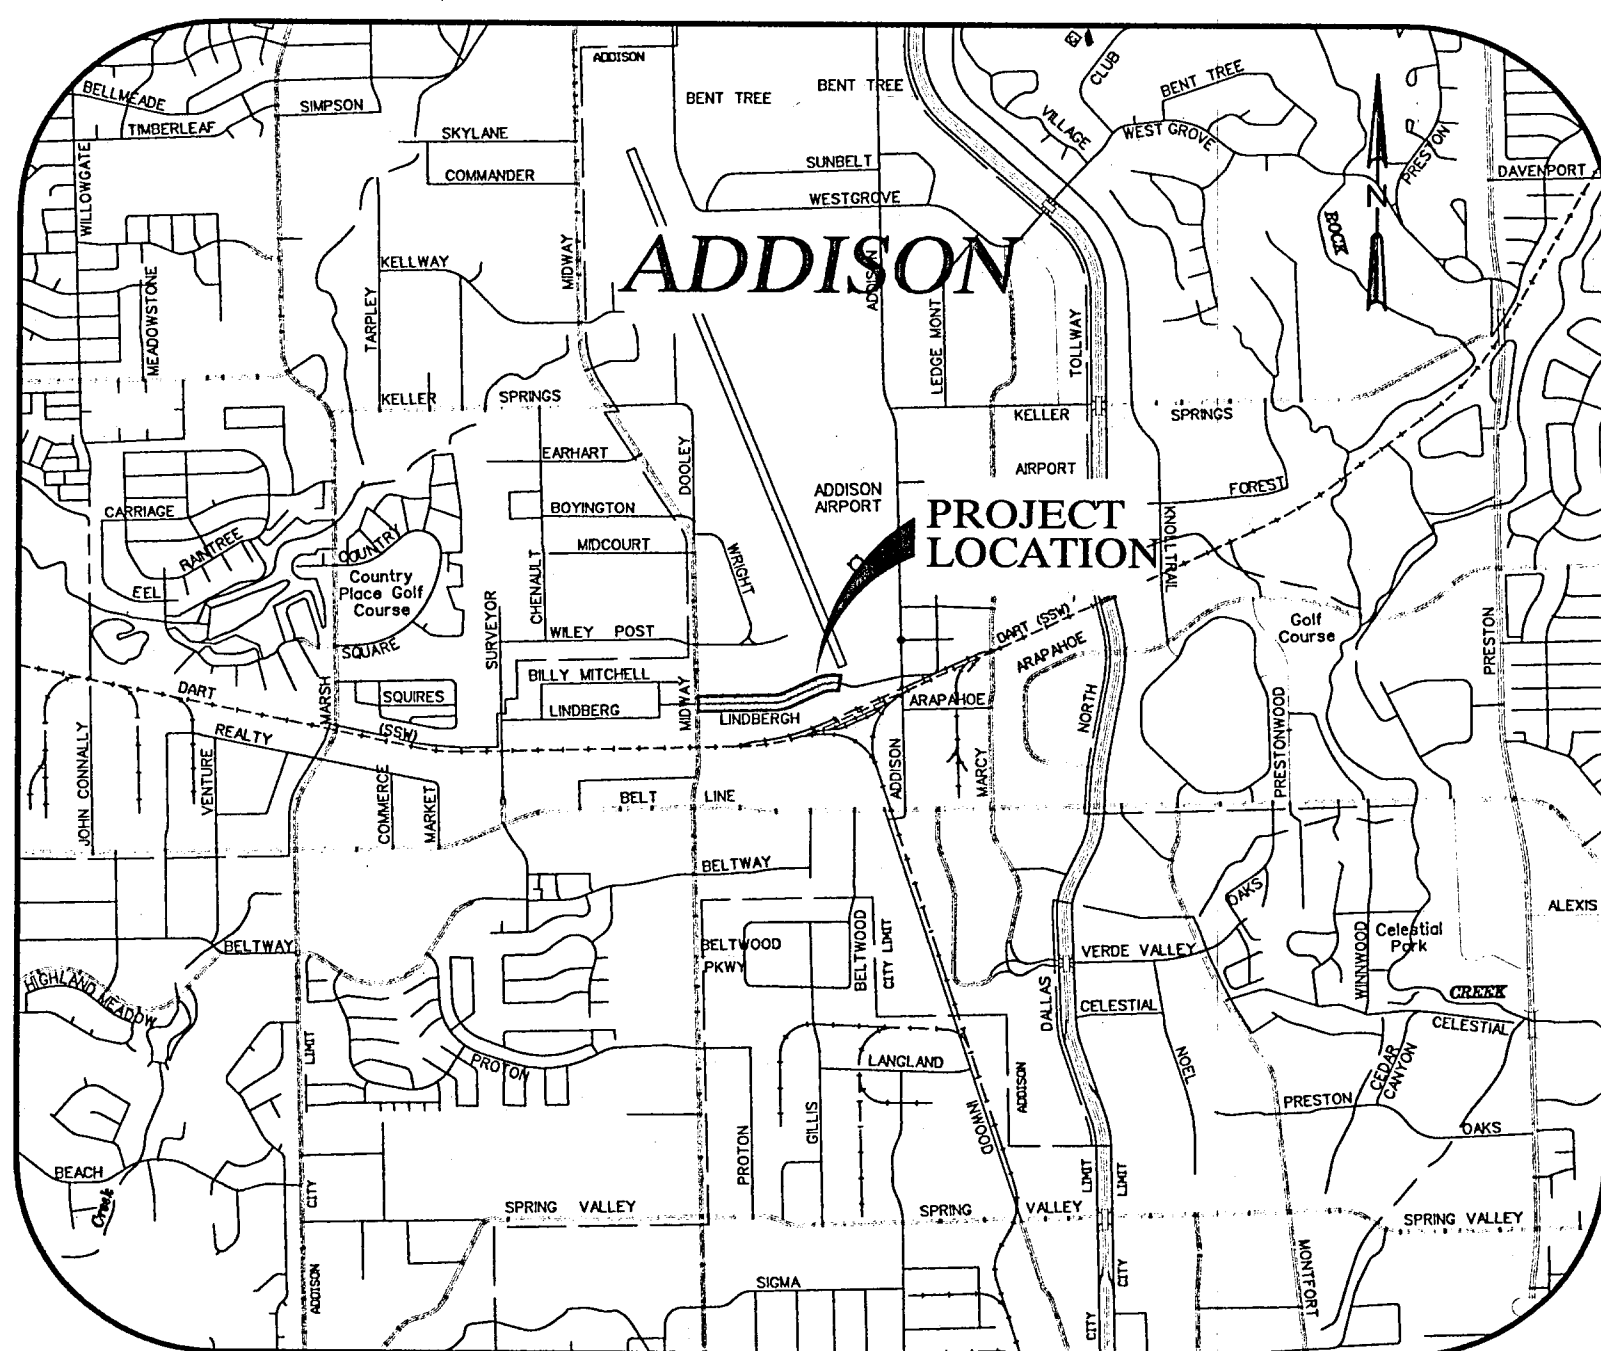


PROJECT LOCATION

DECEMBER 2001



GUTIERREZ, SMOUSE, WILMUT & ASSOC., INC.  
1117 SHADY TRAIL  
DALLAS, TEXAS 75229  
(972) 620-1255  
DALLAS - FT. WORTH - HOUSTON - MIDLAND

SHEET 1	COVER SHEET
SHEET 2	GENERAL NOTES & MISCELLANEOUS DETAILS
SHEET 3	MISCELLANEOUS DETAILS
SHEET 4	TOWN OF ADDISON STD. DETAIL
SHEET 5	WATER PLAN, STA 1+00 TO STA 8+50
SHEET 6	WATER PLAN, STA 8+50 TO STA 15+22

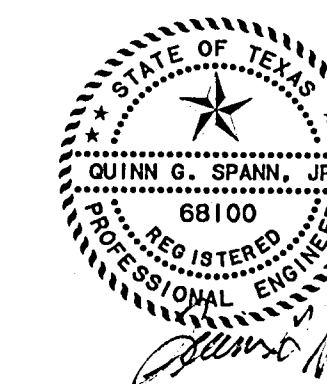

**RECORD DRAWING**  
The improvements shown on this drawing were prepared from periodic observations made by the Engineer, periodic observations made by the Project Representative, information provided by aerial and/or on the ground surveys, information provided by the Owner and/or information provided by the General Contractor. To the best of our knowledge, the information provided herein represents the improvements as constructed.  
DATE: 8/09/2002

INDEX OF SHEETS

LINDBERGH WA REPLACEMENT 2002 A-S-BUILT