

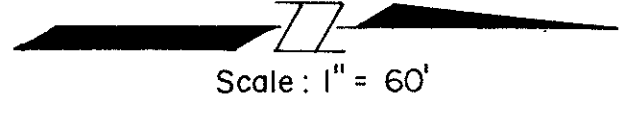


DATE	
BY	
PLAN	
NO. OF SHEETS	
NO. OF THIS SHEET	
NO.	

DATE	
BY	
PROFILE	
NO. OF SHEETS	
NO. OF THIS SHEET	
NO.	

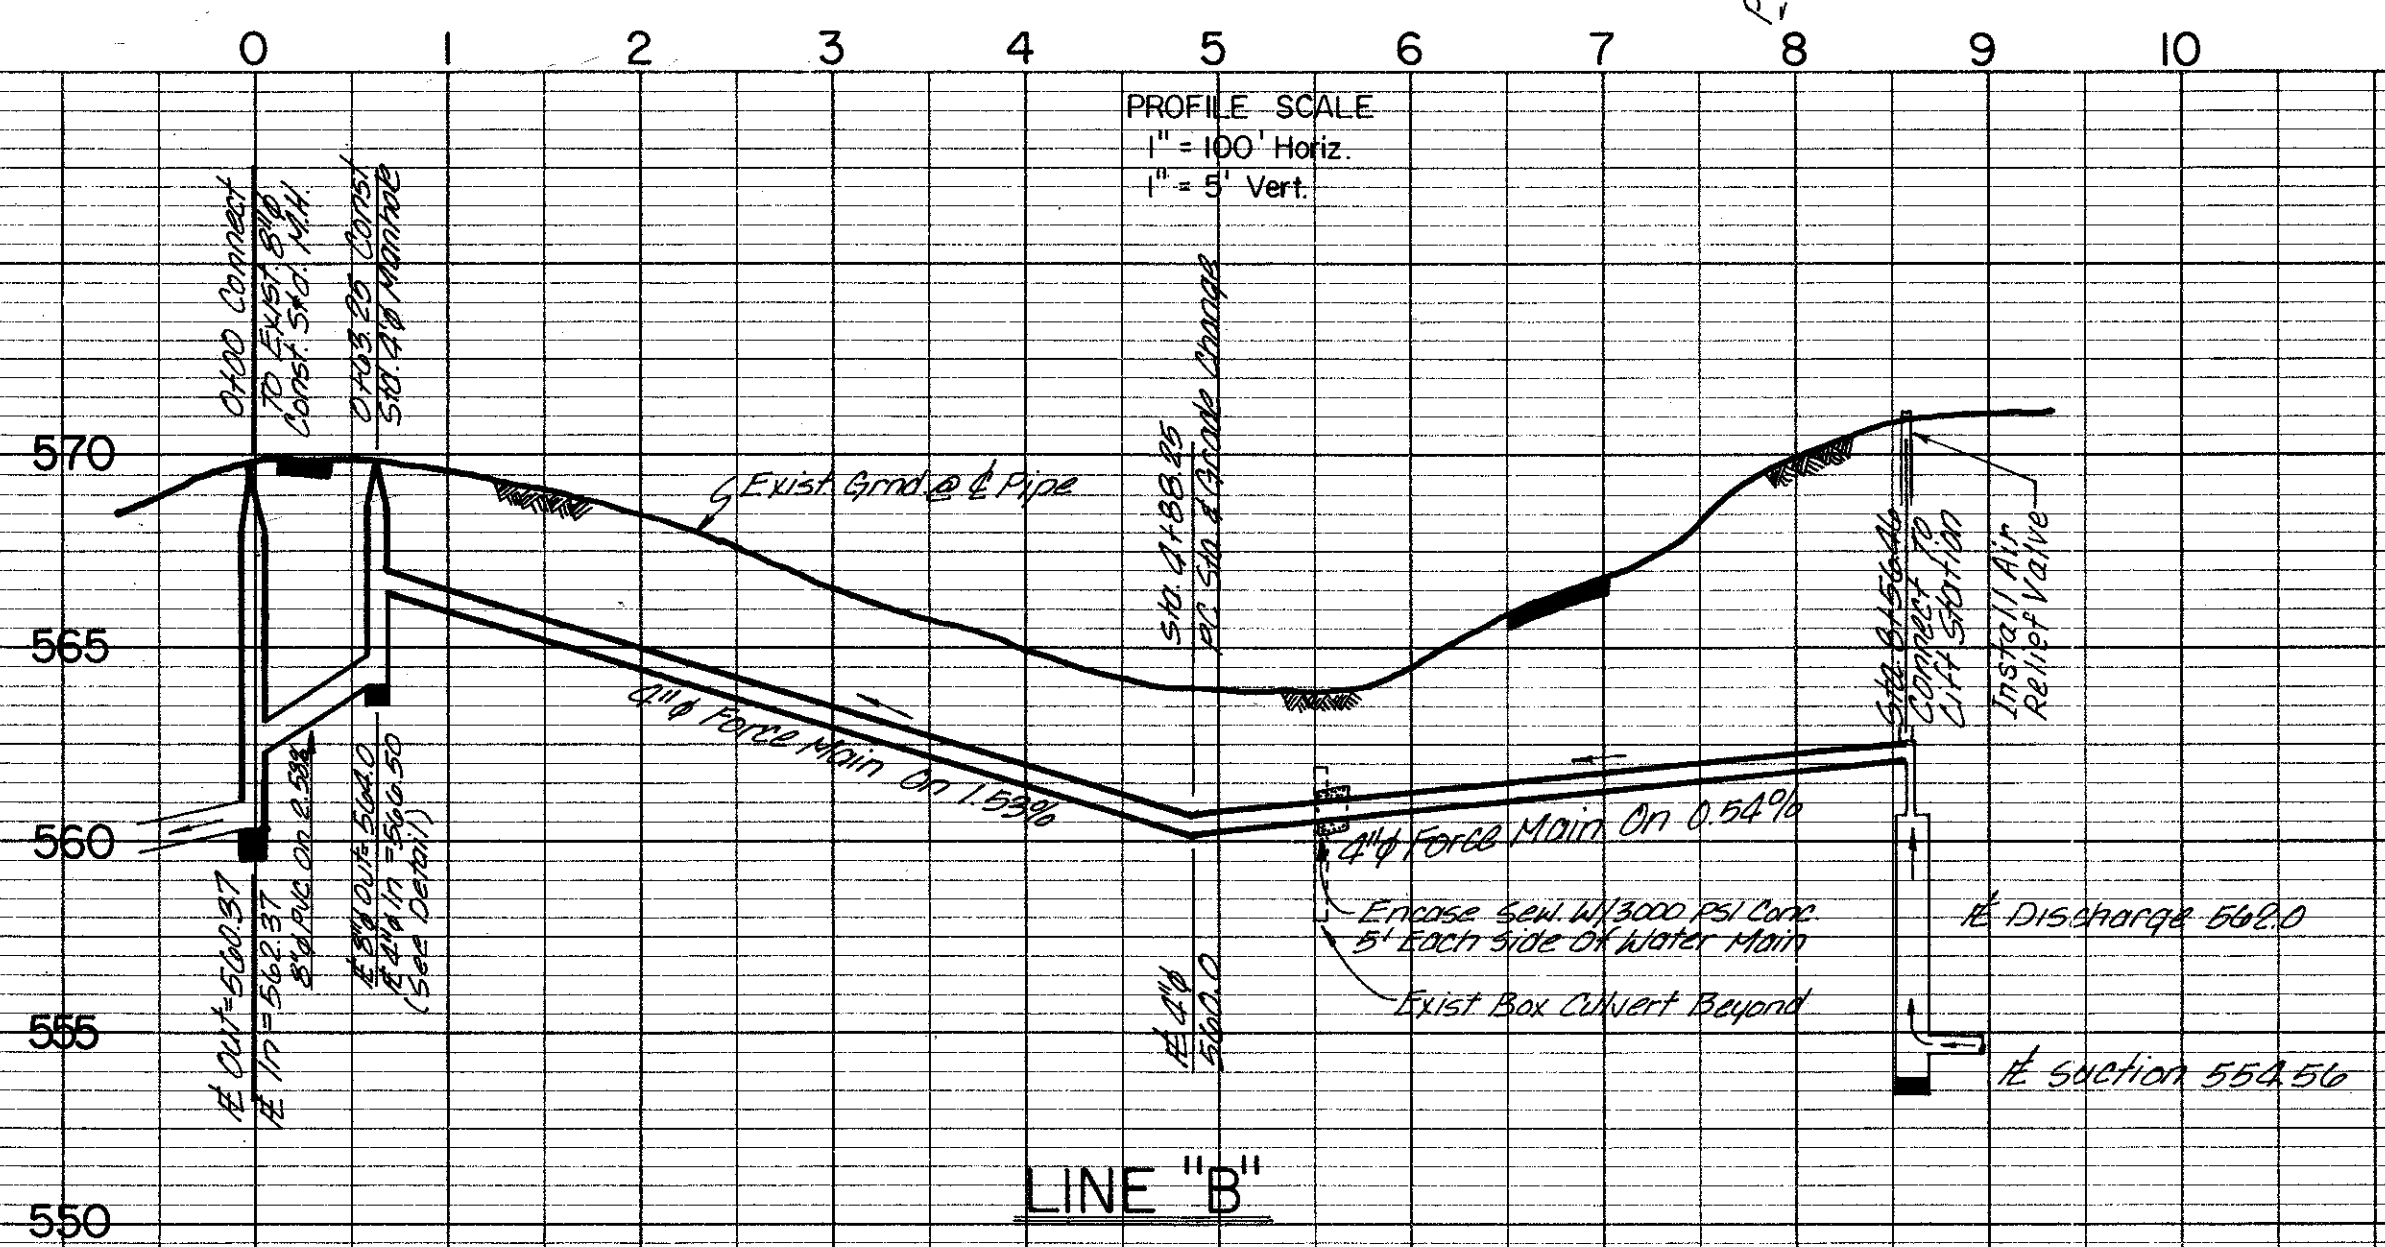

General Notes:  
 1. Pipe For Sanitary Sewer Gravity Main shall Be PVC, SDR#35.  
 2. Pipe For Force Main shall Be PVC Class 150, SDR#18.  
 3. A Plastic Coated #12 Copper Wire shall Be Buried In Trench For Locating Pipe.  
 4. The Contractor shall Investigate Soil Conditions Prior To Bidding.  
 5. The Contractor shall Verify The Location of All Existing Utilities Prior To start of Construction.

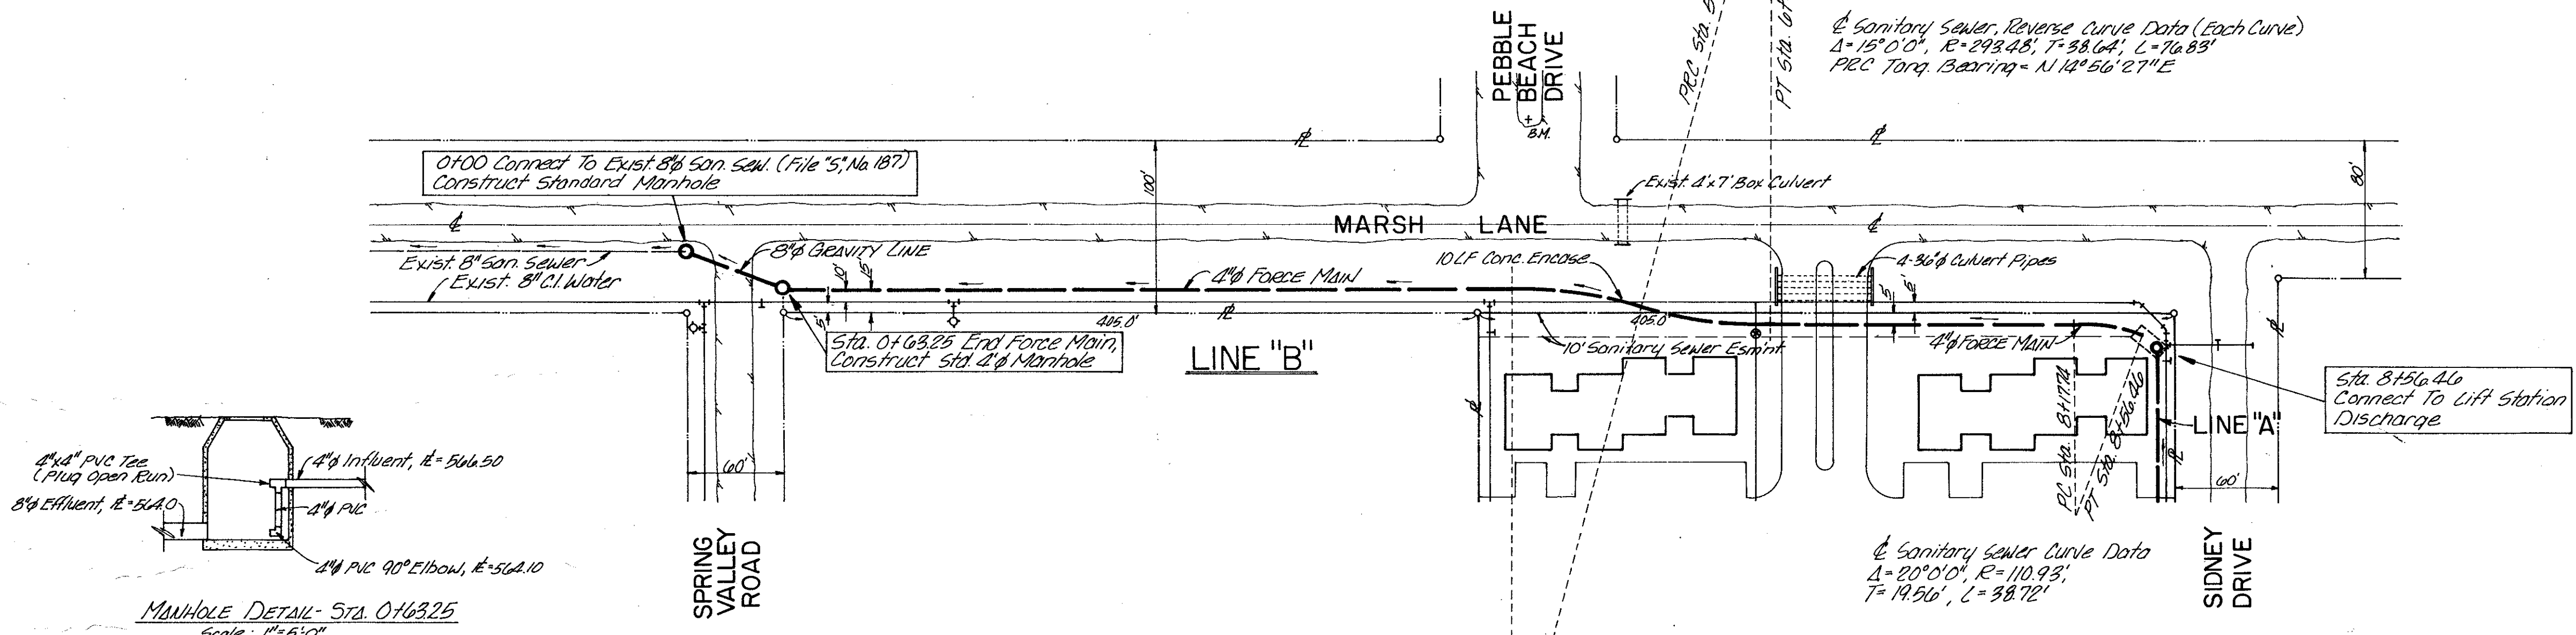

5

4A  
4  
Revised Sheet 4 of 4  
Dated Nov, 1976

OFF-SITE SANITARY SEWER  
**MARSH LANE PROJECT**  
 ADDISON TEXAS

C 1975	APRIL, 1976
REVISIONS	
Complete Revision of Sht. 4	
Rev. From 0100 to 016325 4/27/76	
Rev. Location Air Rel. V. 4-28-76	

**DONALD E. DAVIS**  
 CONSULTING ENGINEERS

3000 McKinney Ave./Dallas, Texas 75204