


CITY OF ADDISON
APPROVED

FOR CONSTRUCTION
John W. Miller for Jackie W. Doyle
BUILDING DEPARTMENT
DATE 4-16-77


NOTE: CONTRACTOR IS HEREBY INSTRUCTED TO EXERCISE CARE IN NOTING OR EXCEEDING ALL REQUIREMENTS OF BOTH NATIONAL AND LOCAL CODES AND/OR ORDINANCES APPLICABLE TO HIS WORK. APPROVAL OF THESE DRAWINGS SHALL NOT BE CONSTRUED TO RELIEVE RESPONSIBILITY OR IMPLY VARIANCE TO SUCH CODES.

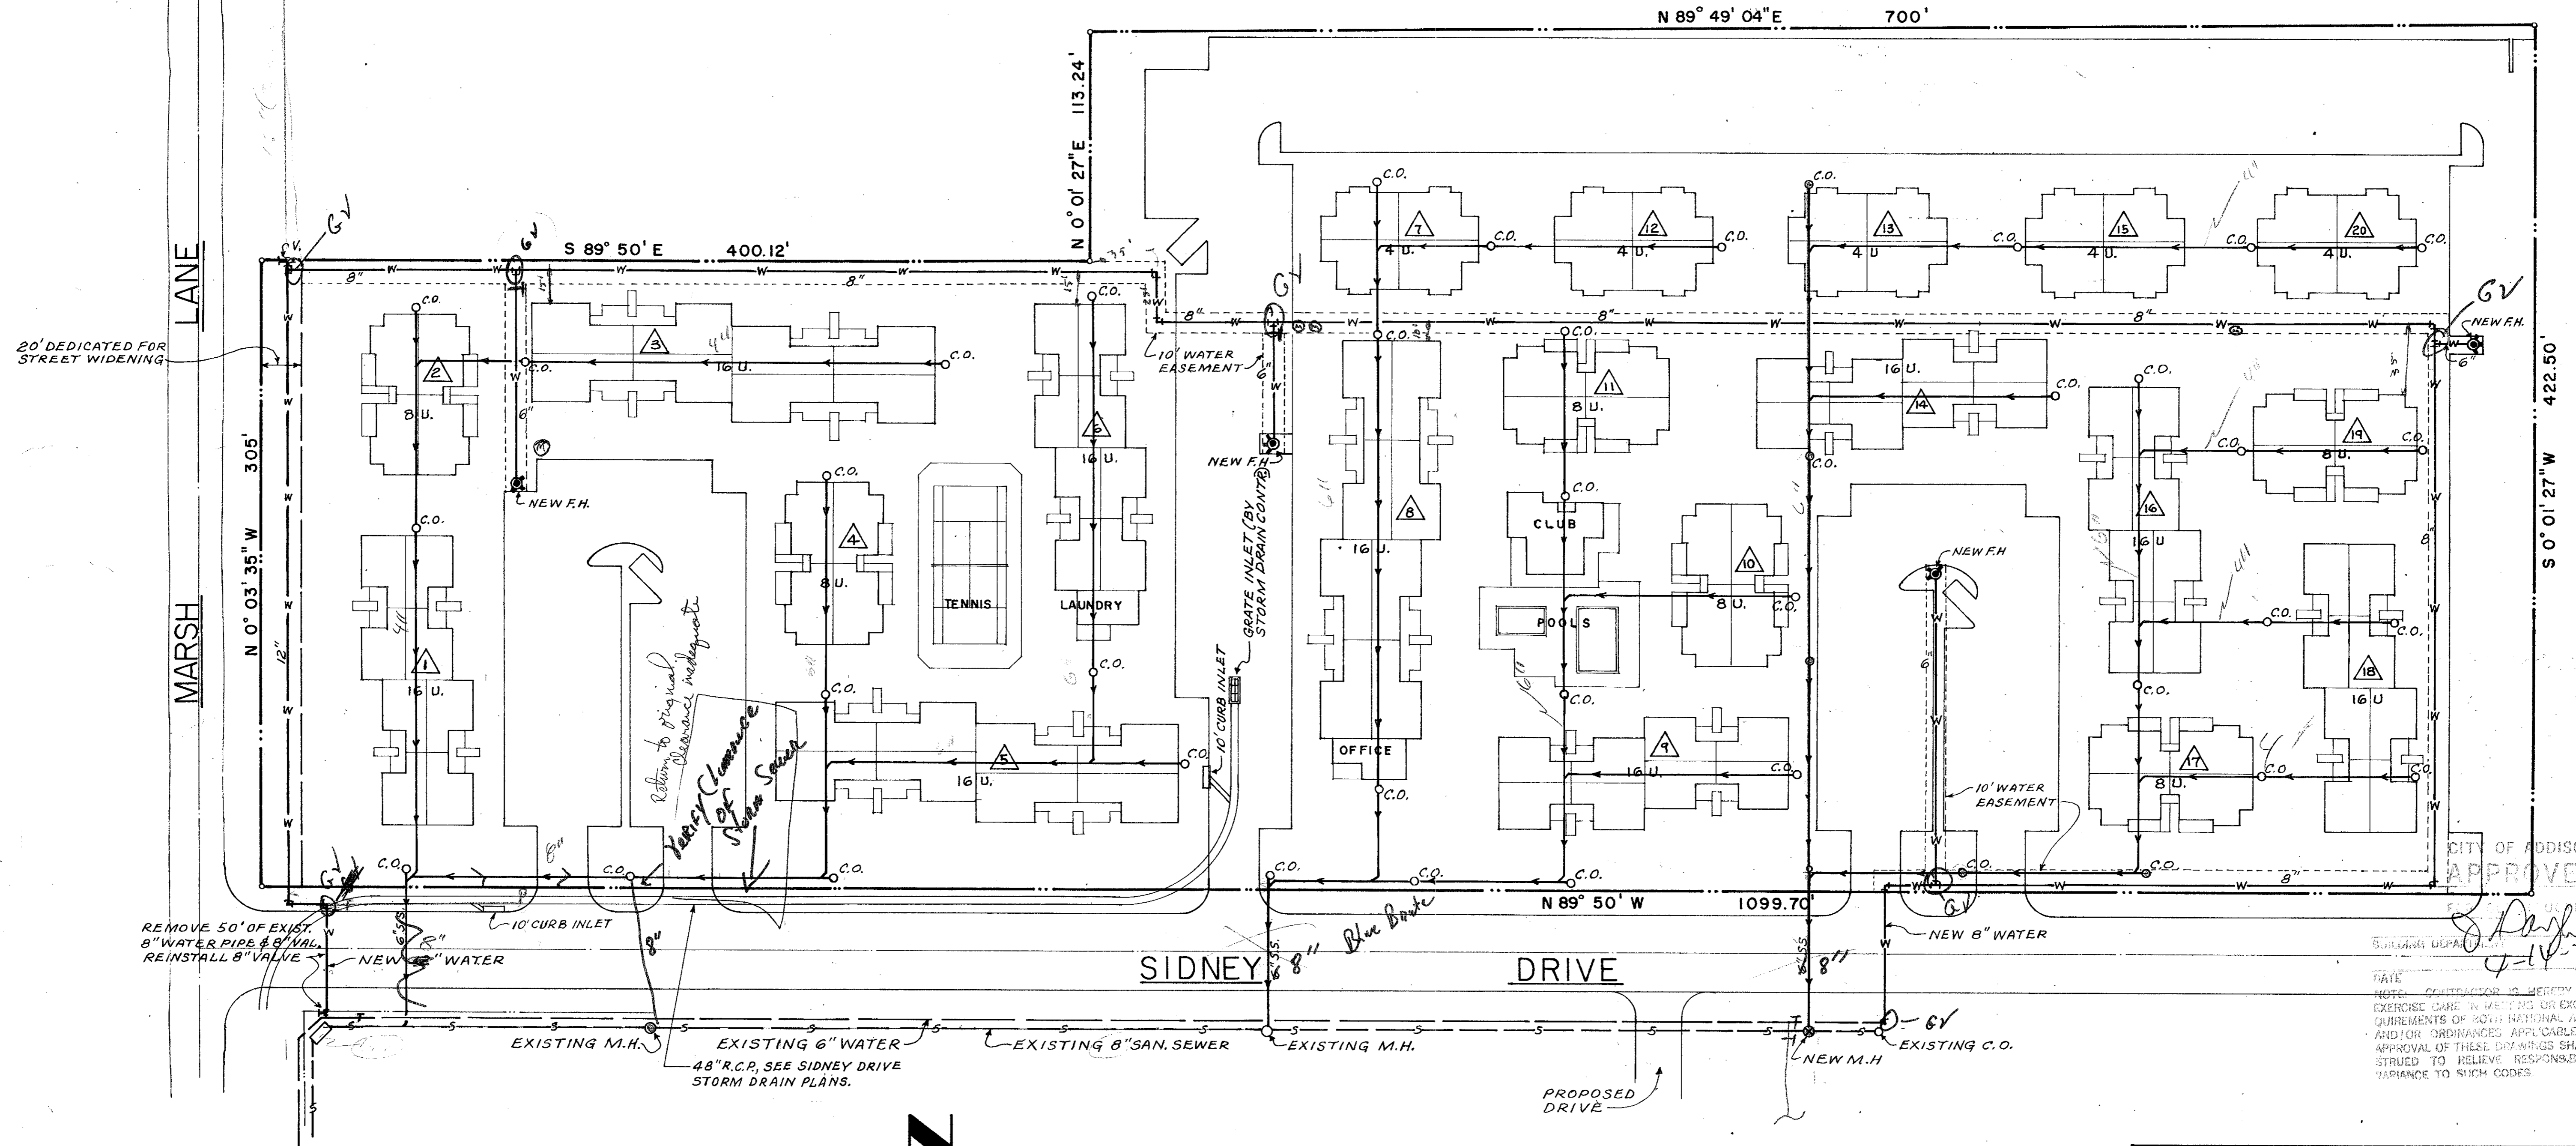

CITY OF ADDISON
APPROVED

John W. Miller for Jackie W. Doyle
BUILDING DEPARTMENT
DATE 4-16-77

NOTE: CONTRACTOR IS HEREBY INSTRUCTED TO EXERCISE CARE IN NOTING OR EXCEEDING ALL REQUIREMENTS OF BOTH NATIONAL AND LOCAL CODES AND/OR ORDINANCES APPLICABLE TO HIS WORK. APPROVAL OF THESE DRAWINGS SHALL NOT BE CONSTRUED TO RELIEVE RESPONSIBILITY OR IMPLY VARIANCE TO SUCH CODES.

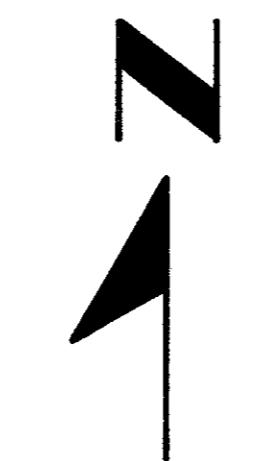

SCALE: 1" = 40'

SITE UTILITY PLAN	
SHADOWOOD APARTMENTS 2	
FOR	
SUMMERS ADDISON,	PROPERTIES, TEXAS
JOB NO. CO976	DATE 12-30-76
REV. 2-14-77 MOVE 8" VALVE AT MARSH LANE & SIDNEY DR.	
DONALD E. DAVIS CONSULTING ENGINEERS	
3000 McKinney Ave./Dallas, Texas 75204	