




5 PLANTING DETAIL FOR TREES ON 3:1 SLOPES N.T.S.

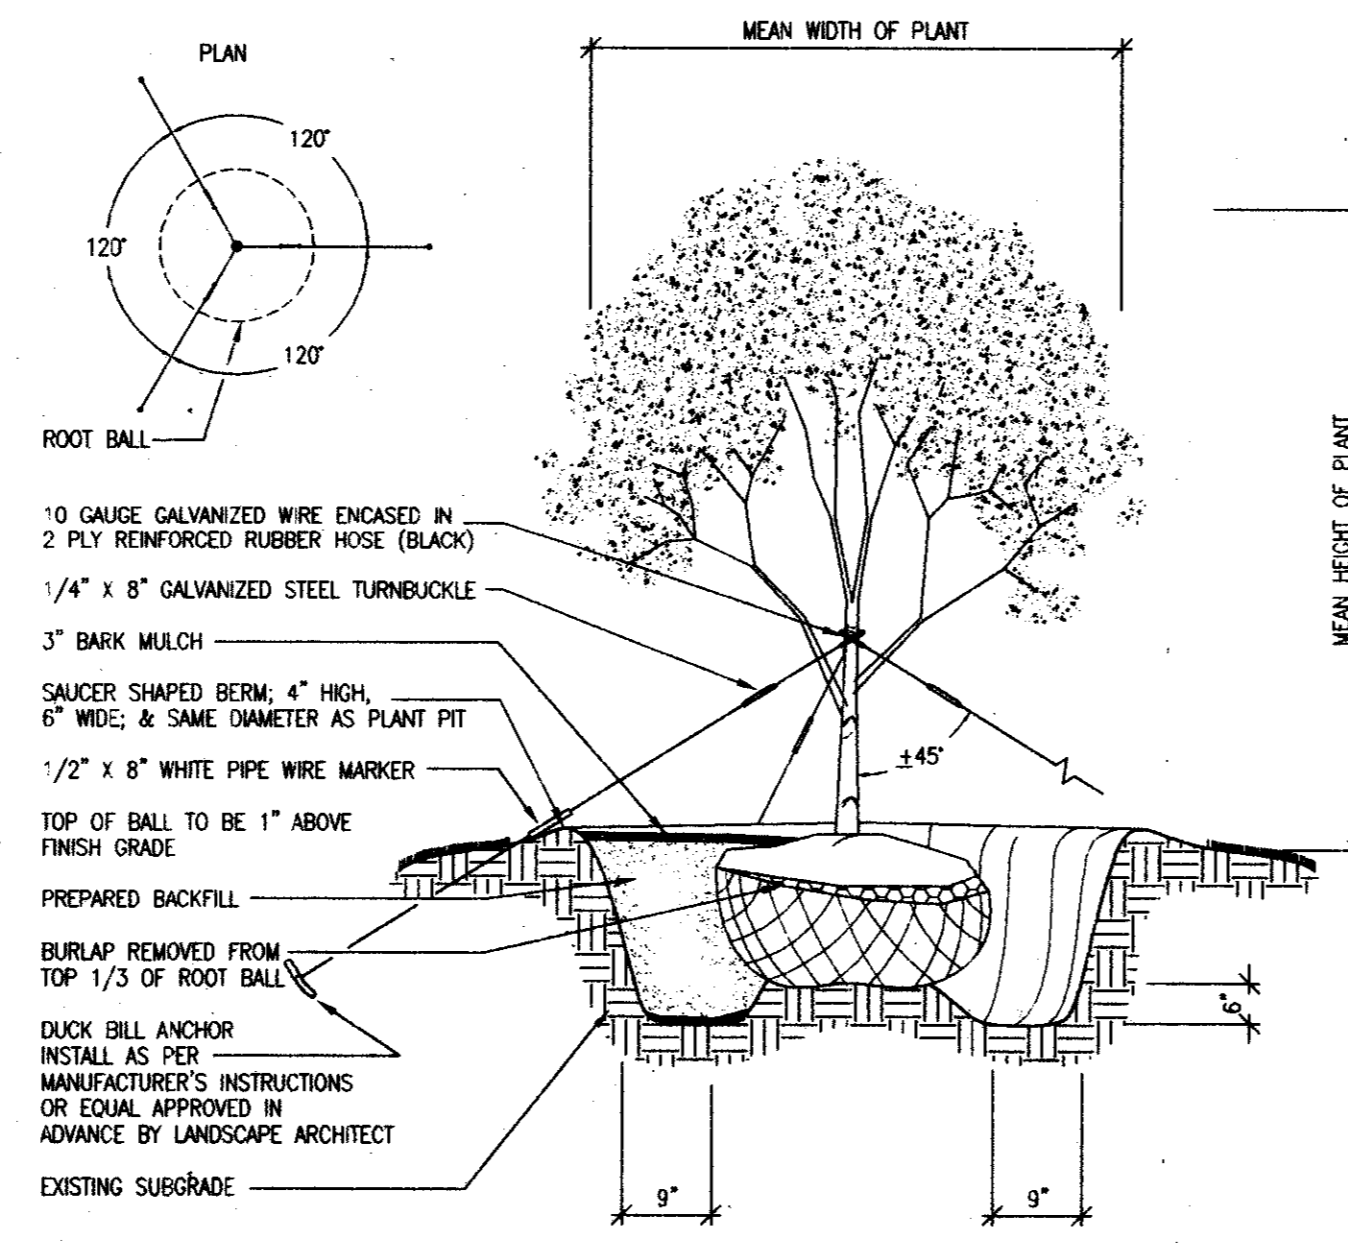


4 PLANTING DETAIL FOR TREES 2 1/2\"/>

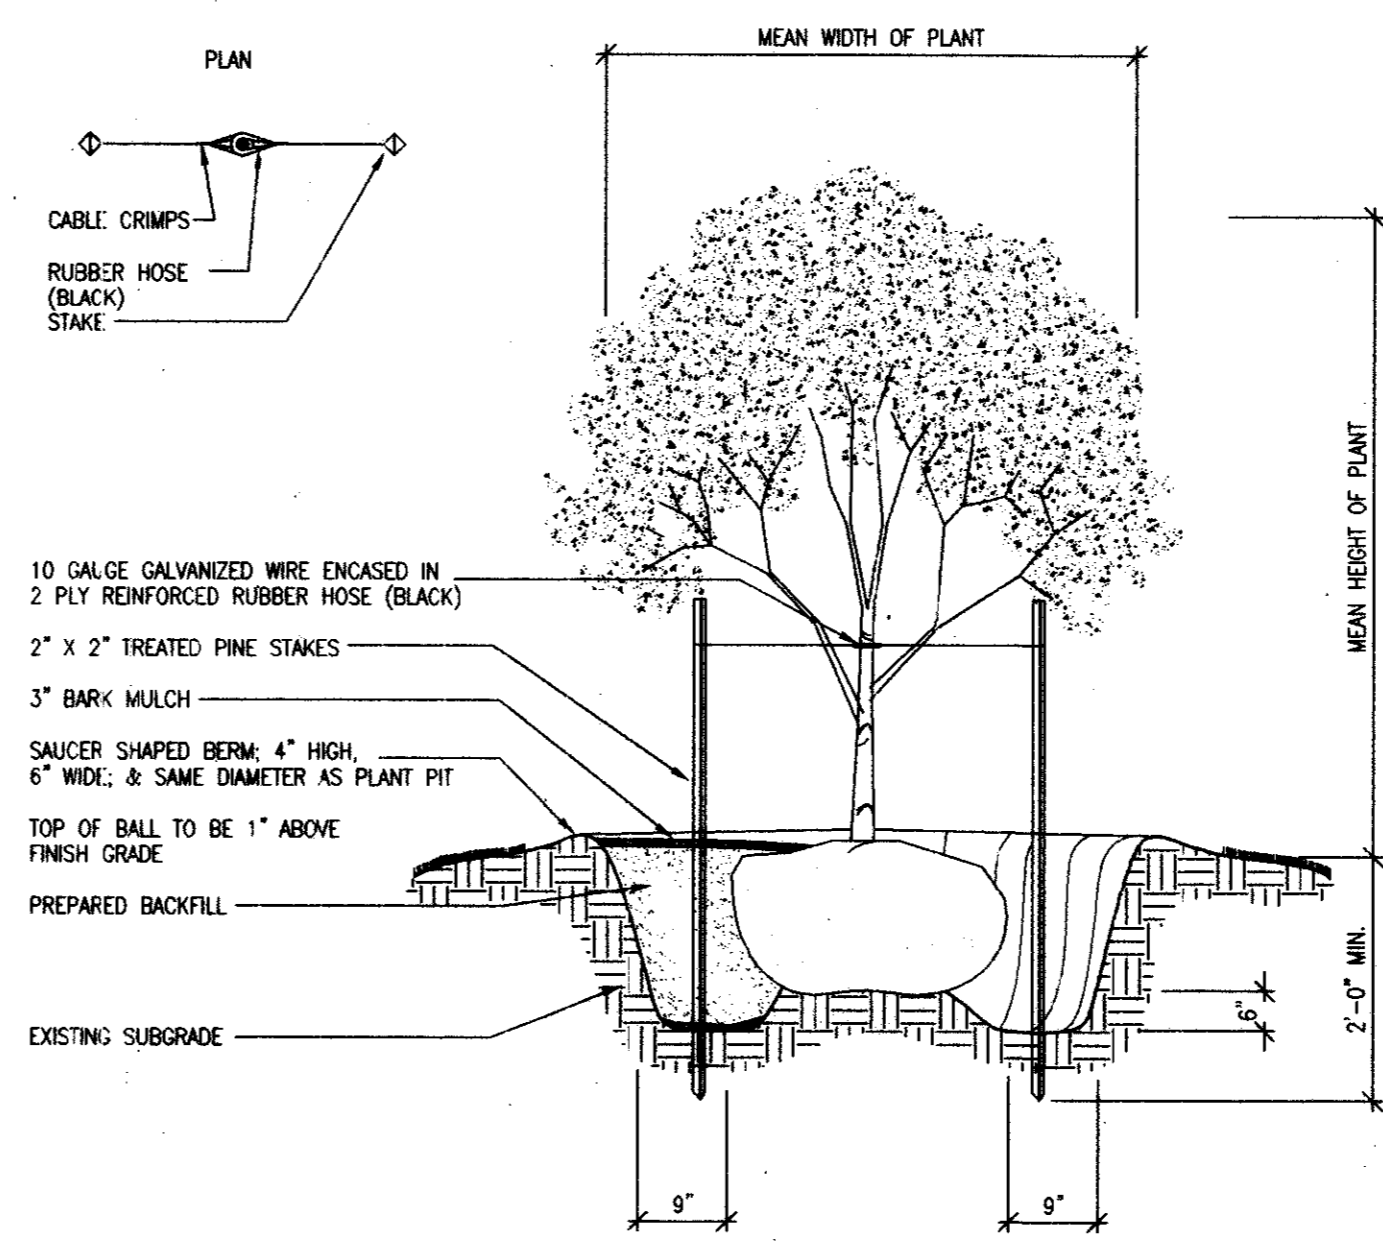


3 CONTAINER GROWN TREE PLANTING DETAIL N.T.S.

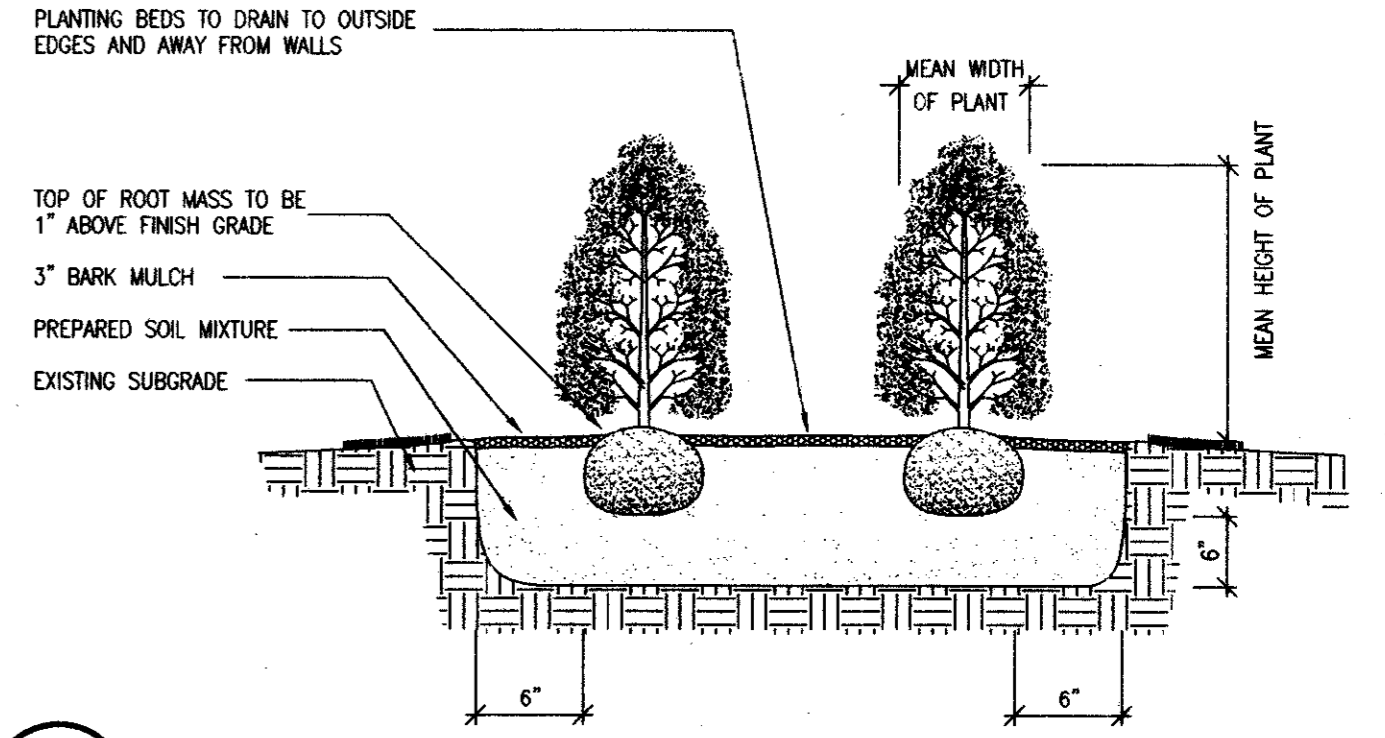

1 SHRUB PLANTING DETAIL N.T.S.

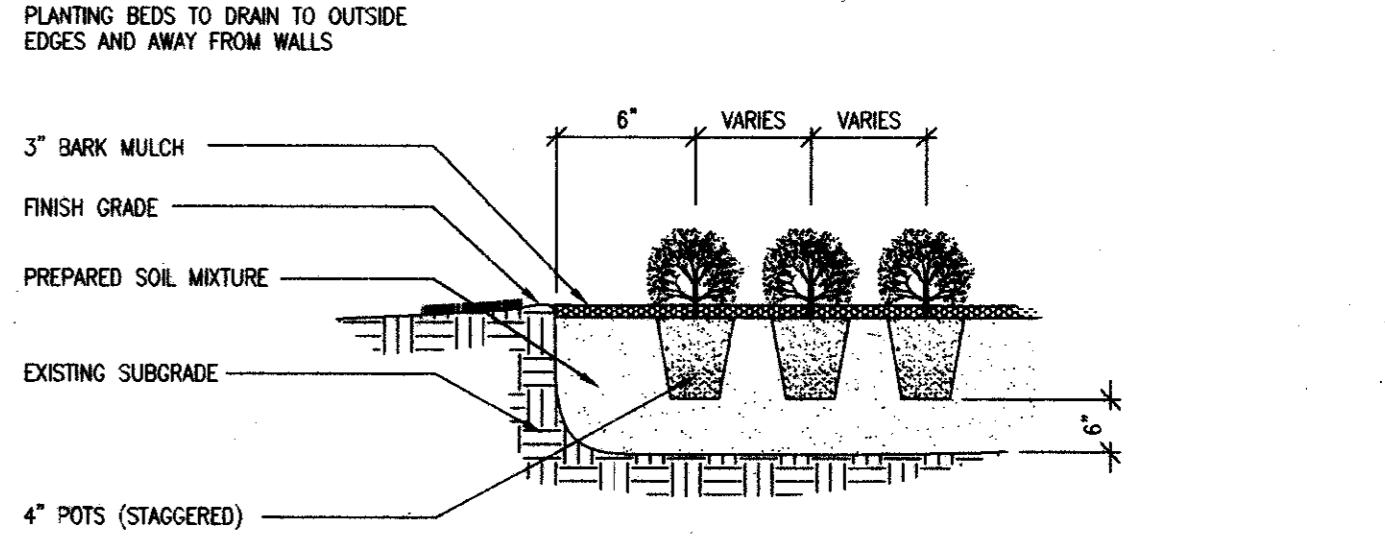


2 GROUNDCOVER/SEASONAL COLOR PLANTING DETAIL N.T.S.

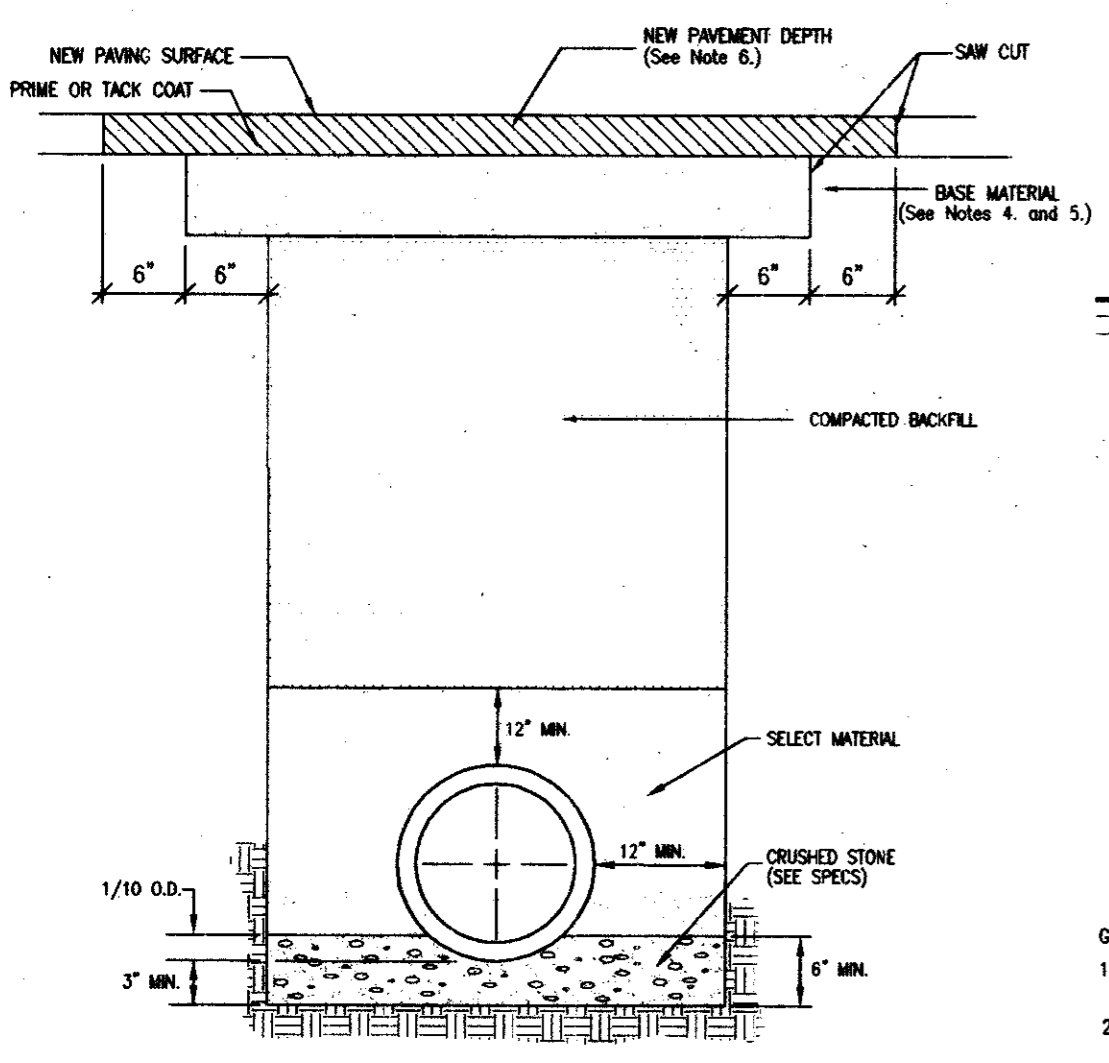


- NOTES:
- THE EXISTING PAVING SURFACE SHALL BE SAW CUT IN A STRAIGHT LINE, A MINIMUM OF 12 INCHES WIDER THAN THE UNDISTURBED SIDES OF THE TRENCH, SYMMETRICAL ABOUT THE CENTER LINE OF THE EXCAVATION.
 - ANY CONCRETE PAVING SHALL BE SAW CUT 6 INCHES WIDER THAN UNDISTURBED SIDES OF EXCAVATION.
 - IF EXCAVATION AREA IS OPEN FOR TEMPORARY PUBLIC USE, THE SURFACE SHALL BE MAINTAINED LEVEL WITH THE ADJACENT FINISH GRADE WITH COLD MIX OR TEMPORARY HOT MIX.
 - ROAD BASE AND SURFACE MATERIALS IN THE TRENCH CUT SHALL BE REPLACED IN KIND OF EQUAL THICKNESS, OR WITH MINIMUM BASE THICKNESS OF 10 INCHES, WHICHEVER IS GREATER.
 - ALL DAMAGED AREAS OF PAVEMENT OUTSIDE THE TRENCH CUT SHALL BE REMOVED AND REPLACED WITH A MINIMUM OF 8 INCHES OF BASE OR MATCH EXISTING, WHICHEVER IS GREATER.
 - SURFACE PAVEMENT SHALL BE OF THE KIND AND THICKNESS AS EXISTING, OR MINIMUM 2", WHICHEVER IS GREATER.

10 TRENCH DETAIL W/PAVED SURFACE N.T.S.

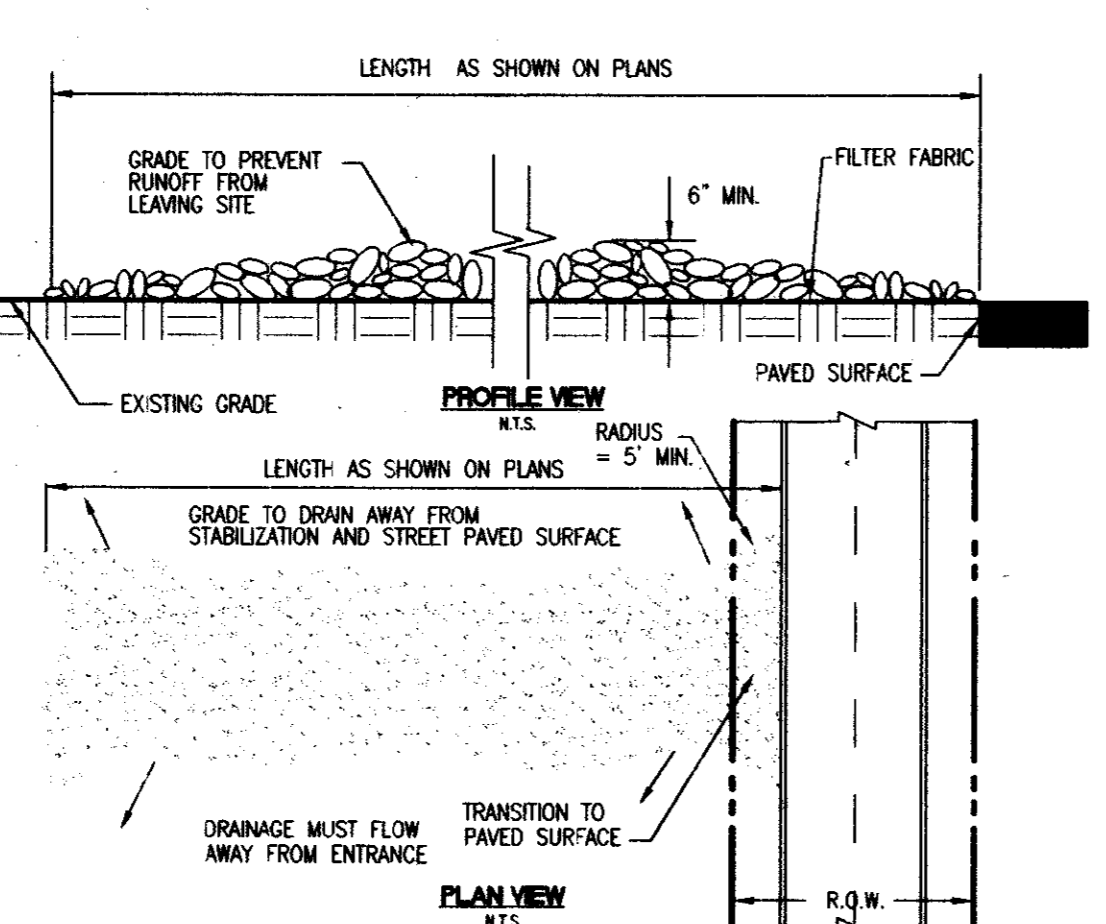


- GENERAL NOTES:
- STONE SHALL BE 3 TO 5 INCH DIAMETER CRUSHED ROCK OR ACCEPTABLE CRUSHED PORTLAND CEMENT CONCRETE.
 - LENGTH SHALL BE SHOWN ON PLANS, WITH A MINIMUM LENGTH OF 30 FEET FOR LOTS WHICH ARE LESS THAN 150 FEET FROM EDGE OF PAVEMENT. THE MINIMUM DEPTH IN ALL OTHER CASES SHALL BE 50 FEET.
 - THE THICKNESS SHALL NOT BE LESS THAN 6 INCHES.
 - THE WIDTH SHALL BE NO LESS THAN THE FULL WIDTH OF ALL POINTS OF INGRESS AND EGRESS.
 - WHEN NECESSARY, VEHICLES SHALL BE CLEANED TO REMOVE SEDIMENT PRIOR TO TRAVEL ONTO A PUBLIC ROADWAY. WHEN WASHING IS REQUIRED, IT SHALL BE DONE ON AN AREA STABILIZED WITH CRUSHED STONE WITH DRAINAGE FLOWING AWAY FROM BOTH THE STREET AND THE STABILIZED ENTRANCE. ALL SEDIMENT SHALL BE PREVENTED FROM ENTERING ANY STORM DRAIN, DITCH OR INTERCOURSE USING APPROVED METHODS.
 - THE ENTRANCE SHALL BE MAINTAINED IN A CONDITION WHICH WILL PREVENT TRACKING OR FLOWING OF SEDIMENT ONTO PAVED SURFACES. THIS MAY REQUIRE PERIODIC TOP DRESSING WITH ADDITIONAL STONE AS CONDITIONS DEMAND. ALL SEDIMENT SPILLED, DROPPED, WASHED, OR TRACKED ONTO PAVED SURFACES, MUST BE REMOVED IMMEDIATELY.
 - THE ENTRANCE MUST BE PROPERLY GRADED OR INCORPORATE A DRAINAGE SWALE TO PREVENT RUNOFF FROM LEAVING THE CONSTRUCTION SITE.

9 STABILIZED CONSTRUCTION ENTRANCE DETAIL N.T.S.

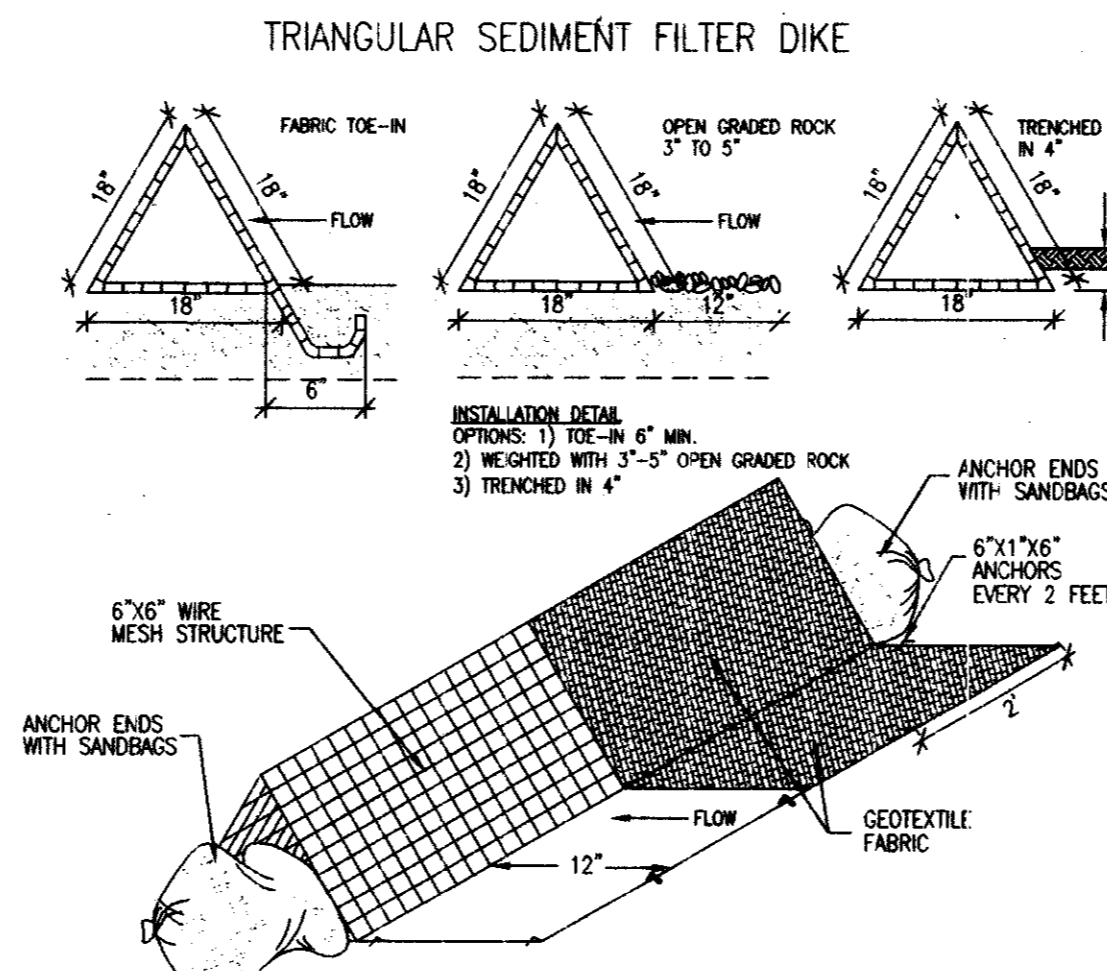


- GENERAL NOTES:
- DIKES SHALL BE PLACED IN A ROW WITH ENDS TIGHTLY ABUTTING THE ADJACENT DIKE.
 - THE FABRIC COVER AND SKIRT SHALL BE A CONTINUOUS WRAPPING OF GEOTEXTILE. THE SKIRT SHALL BE A CONTINUOUS EXTENSION OF THE FABRIC ON THE UPSTREAM FACE.
 - THE SKIRT SHALL BE WEIGHTED WITH A CONTINUOUS LAYER OF 3\"/>

8 TRIANGULAR SEDIMENT FILTER DIKE DETAIL N.T.S.

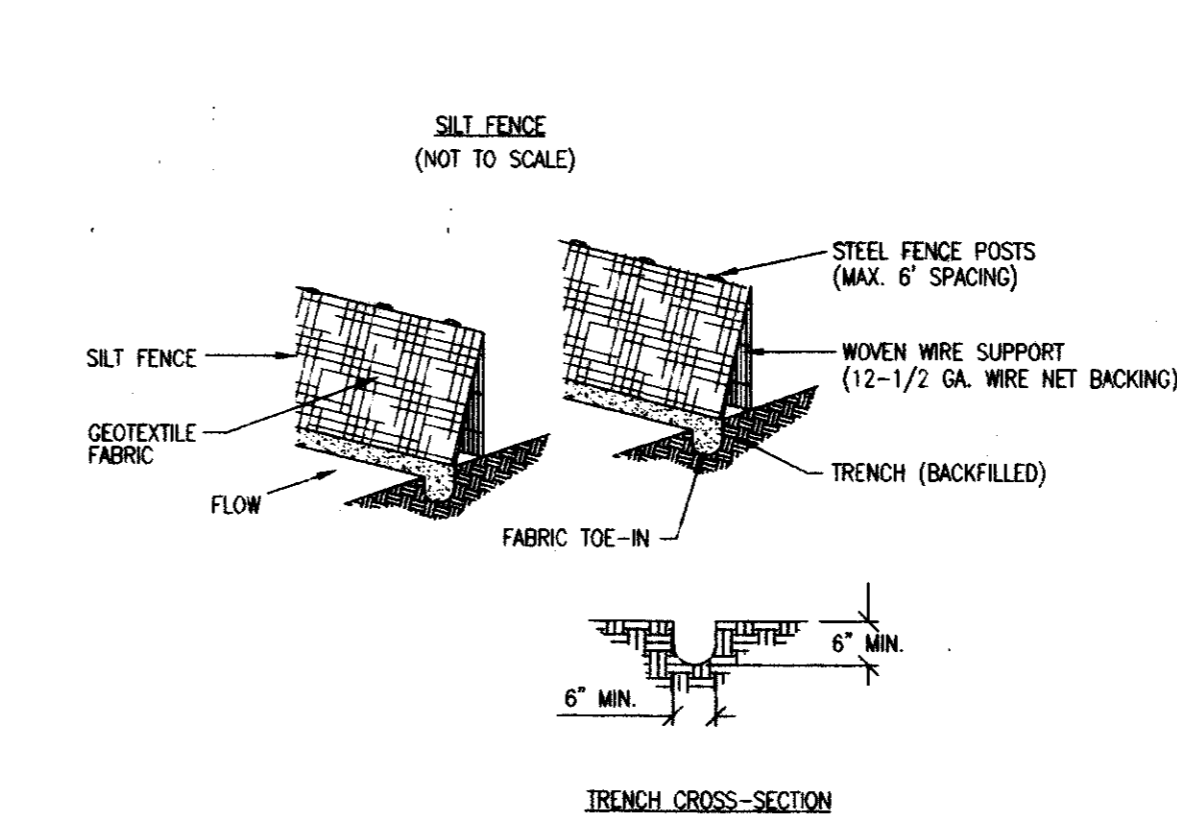

- GENERAL NOTES:
- STEEL POSTS WHICH SUPPORT THE SILT FENCE SHALL BE INSTALLED ON A SLIGHT ANGLE TOWARD THE ANTICIPATED RUNOFF SOURCE. POST MUST BE EMBEDDED A MINIMUM OF ONE FOOT.
 - THE TOE OF THE SILT FENCE SHALL BE TRENCHED IN WITH A SPADE OR MECHANICAL TRENCHER SO THAT THE DOWNSLOPE FACE OF THE TRENCH IS FLAT AND PERPENDICULAR TO THE LINE OF FLOW, WHERE THE FENCE CAN NOT BE TREATED IN (E.G. PAVEMENT) WEIGHT FABRIC FLAP WITH WASHED GRAVEL ON UPSTREAM SIDE TO PREVENT FLOW UNDER FENCE.
 - THE TRENCH MUST BE A MINIMUM OF 6 INCHES DEEP AND 6 INCHES WIDE TO ALLOW FOR THE SILT FENCE FABRIC TO BE LAID IN THE GROUND AND BACKFILLED WITH COMPACTED MATERIAL.
 - SILT FENCE SHOULD BE SECURELY FASTENED TO EACH STEEL SUPPORT POST OR TO WOVEN WIRE, WHICH IS IN TURN ATTACHED TO THE STEEL FENCE POST.
 - INSPECTION SHALL BE MADE WEEKLY OR AFTER EACH RAINFALL EVENT AND REPAIR OR REPLACEMENT SHALL BE MADE PROMPTLY AS NEEDED.
 - SILT FENCE SHALL BE REMOVED WHEN THE SITE IS COMPLETELY STABILIZED SO AS NOT TO BLOCK OR IMPED STORM FLOW OR DRAINAGE.
 - ACCUMULATED SILT SHALL BE REMOVED WHEN IT REACHES A DEPTH OF 6 INCHES. THE SILT SHALL BE DISPOSED OF IN AN APPROVED SITE AND IN SUCH A MANNER AS TO NOT CONTRIBUTE TO ADDITIONAL STABILIZATION.

7 SILT FENCE DETAIL N.T.S.

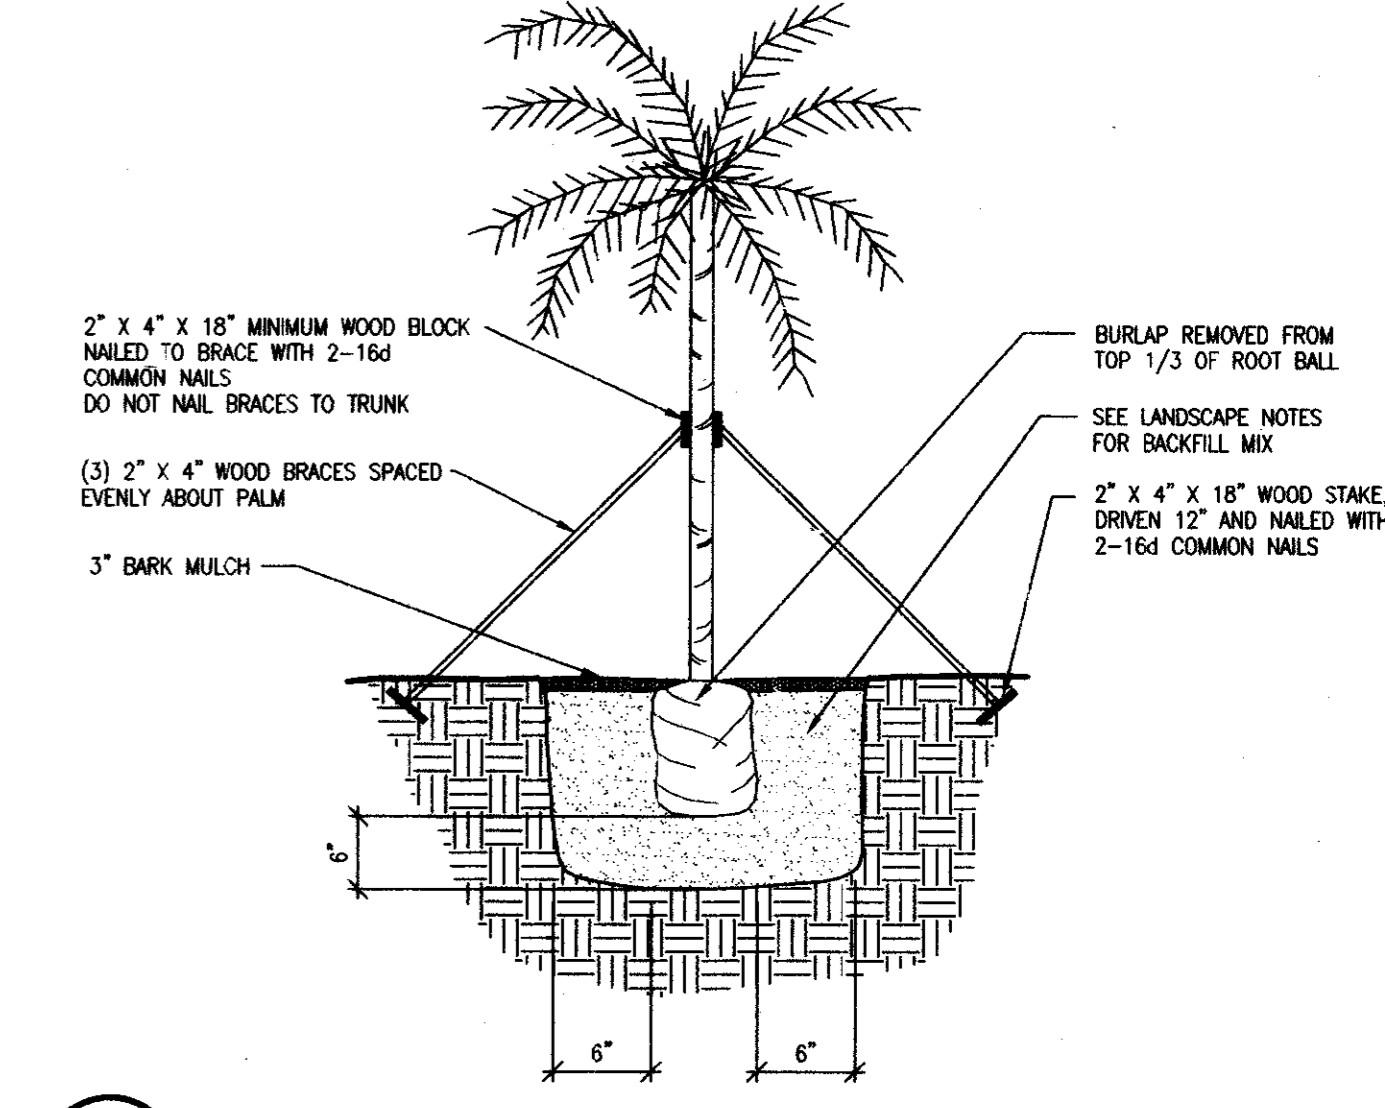


6 PLANTING DETAIL FOR PALM TREES N.T.S.

TABLE OF QUANTITIES OF 2000 PSI CONCRETE GRAVEL OR CRUSHED STONE IN CUBIC YARDS PER 100 LINEAR FEET FOR EACH CLASS EMBODMENT


SIZE OF PIPE IN INCHES	OD OF PIPE IN INCHES	TRENCH WIDTH IN INCHES	CLASS 1 EMBODMENT			CONCRETE EMBODMENT		
			CLASS 1 EMBODMENT CRUSHED STONE	CLASS 2 EMBODMENT CRUSHED STONE	CLASS 3 EMBODMENT CRUSHED STONE	CONCRETE EMBODMENT	CONCRETE EMBODMENT	CONCRETE EMBODMENT
12	15.00	36	1.87	2.1	6.88	4.8	5.8	15.8
15	18.50	36	3.00	4.8	7.8	6.4	7.8	19.2
18	22.00	36	3.8	5.7	8.2	6.2	7.8	21.4
21	26.50	43	3.5	6.9	10.0	10.2	14.9	24.9
24	30.00	46	3.62	8.3	10.1	12.4	18.7	28.7
27	33.50	51	4.23	10.3	10.4	14.4	21.8	31.8
30	37.00	57	4.73	12.7	20.1	17.0	34.8	34.8
33	40.50	61	5.17	15.1	21.8	19.3	37.2	37.2
36	44.00	67	5.58	18.0	23.8	22.1	42.8	42.8

TABLE OF QUANTITIES PER 100 LINEAR FEET-PVC PIPE (IN CUBIC YARDS)

SIZE OF PIPE IN INCHES	OD OF PIPE IN INCHES	TRENCH WIDTH IN INCHES	CLASS 4 EMBODMENT CRUSHED STONE		CONCRETE EMBODMENT
			CLASS 4 EMBODMENT CRUSHED STONE	CONCRETE EMBODMENT	
6	6.28	24	2.00	0.0	11.7
8	8.16	24	2.00	0.7	12.4
10	10.20	24	2.8	2.8	14.2
12	12.24	28	3.75	11.7	16.9
16	15.30	31	5.61	14.0	18.8
24	24.00	42	8.2	3.5	22.8

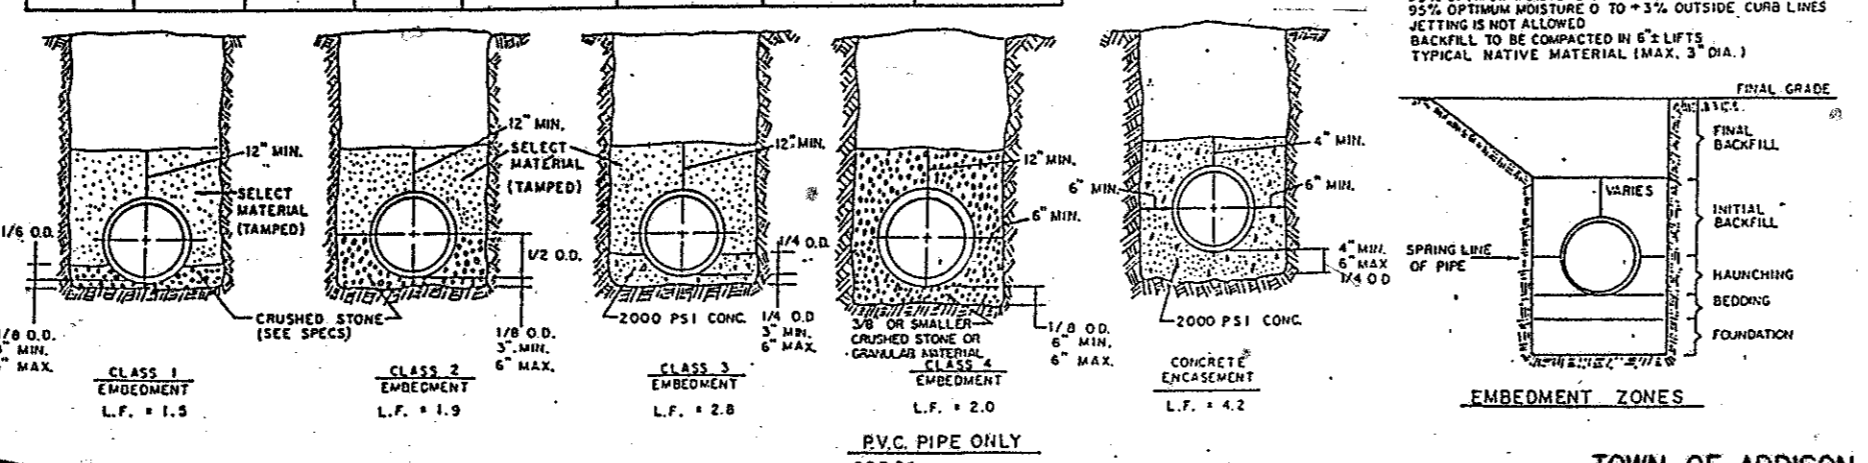

12 EMBEDMENT DETAILS FOR SANITARY SEWER N.T.S.

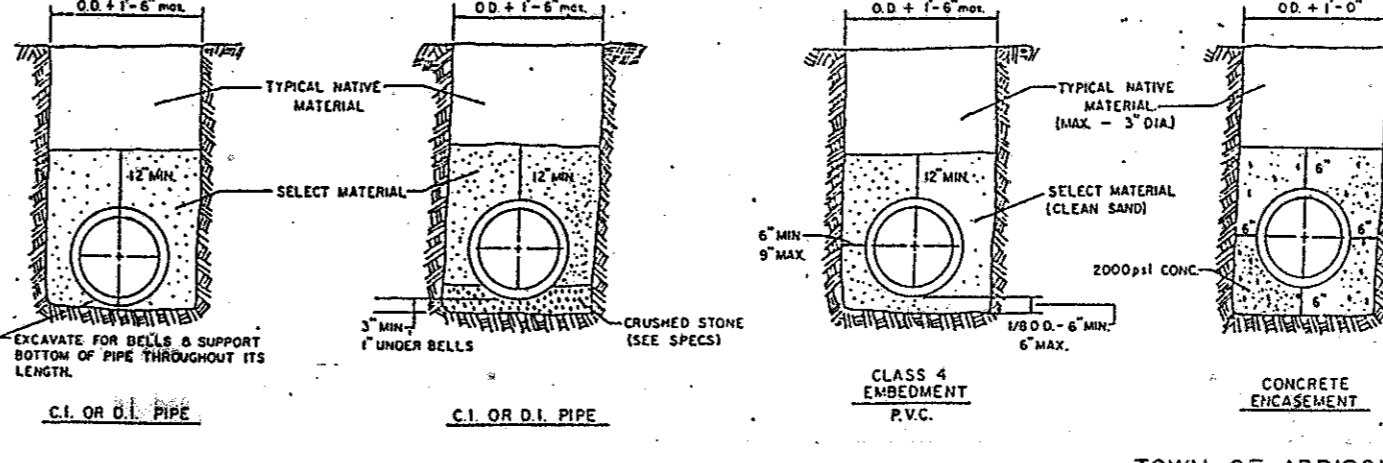

11 EMBEDMENT DETAILS FOR WATER MAIN N.T.S.

ATTENTION
THE ENGINEER ASSUMES NO RESPONSIBILITY FOR THE EXISTENCE OR LOCATION OF ANY SURFACE OR SUBSURFACE STRUCTURES. THE CONTRACTOR IS RESPONSIBLE FOR CONTACTING ALL AGENCIES AND/OR OWNERS TO VERIFY THIS INFORMATION.

ALL CONSTRUCTION MATERIALS AND TECHNIQUES SHALL CONFORM TO CURRENT TOWN OF ADDISON STANDARD SPECIFICATIONS.

Quel Melle
9-24-97

DETAIL SHEET AS BUILT

TACO CABANA
3801 BELT LINE ROAD

SHT. 10 OF 10

DATE: 9-23-97 SCALE: AS SHOWN DRAWN BY: EB

REVISIONS:

Consort, Inc.
315 Bowie / Austin, TX 78703 / (512) 469-0500