

AS BUILT
SITE DEVELOPMENT PLANS



15120 Marsh Ln
~~3801 BELT LINE ROAD~~

For
Taco Cabana
8919 Tesoro Drive Ste. 200
San Antonio, Texas

SHEET INDEX

1. COVER SHEET
2. SITE, PAVING, AND UTILITY PLAN
3. DIMENSION CONTROL PLAN
4. GRADING PLAN
5. DRAINAGE PLAN
6. EROSION AND SEDIMENTATION CONTROL PLAN
7. LANDSCAPE PLAN
8. IRRIGATION PLAN
9. DETAIL SHEET
10. DETAIL SHEET


Submittal Date:

Site Planning, Engineering, & Landscape Architecture



LEGAL DESCRIPTION: PROPOSED LOT 1, BLOCK 2,
MARSH BELT LINE SHOPPING CENTER

ZONING: PD

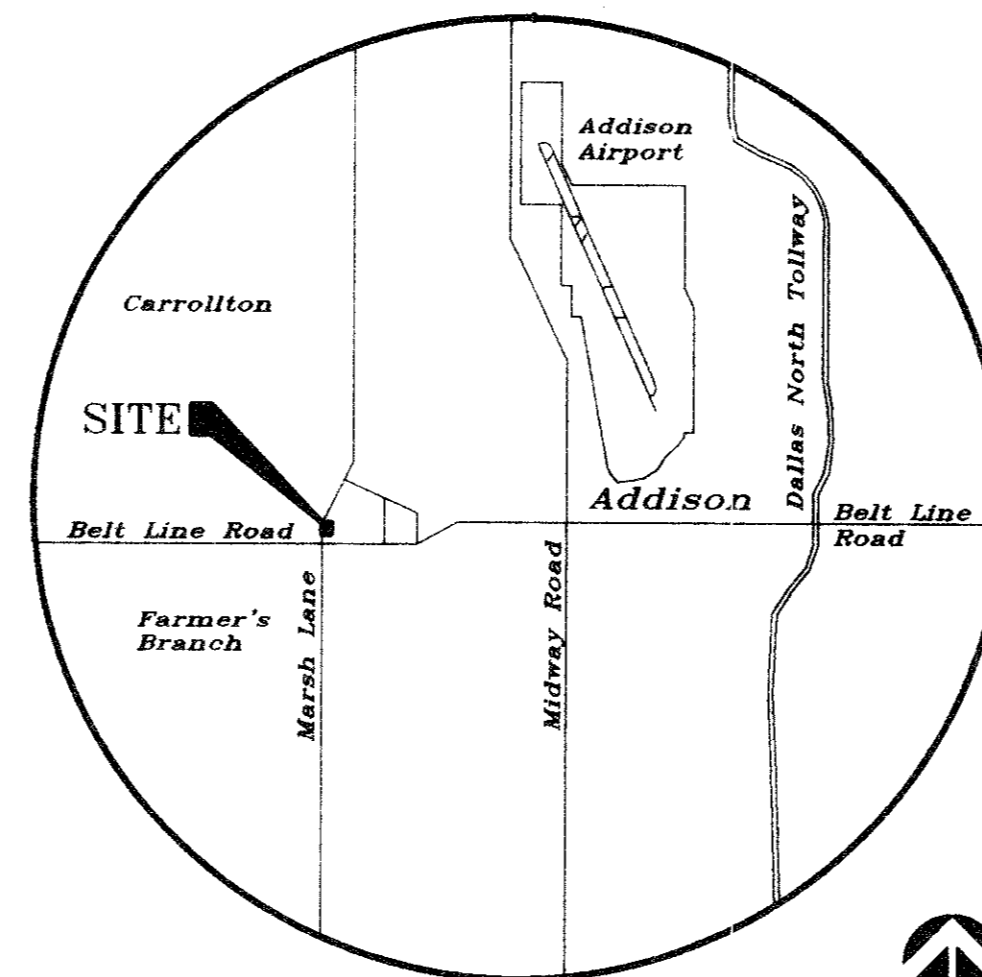

LOCATION MAP

NTS

THIS PROJECT WAS CONSTRUCTED IN CONFORMITY TO THE TOWN OF ADDISON STANDARDS AND SPECIFICATIONS, AND FUNCTIONS AS DESIGNED FROM INFORMATION PROVIDED BY THE CONTRACTOR TO THE BEST OF MY KNOWLEDGE

Anna R. Mele
3-10-98