


DIMENSION CONTROL NOTES


- 1 ALL DIMENSIONS ARE TAKEN TO FACE OF CURB OR BUILDING UNLESS OTHERWISE NOTED.
- 2 CONTRACTOR SHALL VERIFY DIMENSIONS AND NOTIFY ENGINEER OF ANY DISCREPANCIES.
- 3 USE DIMENSIONAL INFORMATION GIVEN. DO NOT SCALE DRAWINGS.
- 4 CONTRACTOR SHALL VERIFY EXACT LOCATIONS AND PROTECT ALL EXISTING SITE IMPROVEMENTS AND UTILITIES DURING CONSTRUCTION OPERATIONS.

PARKING SPACE DIMENSION TABLE

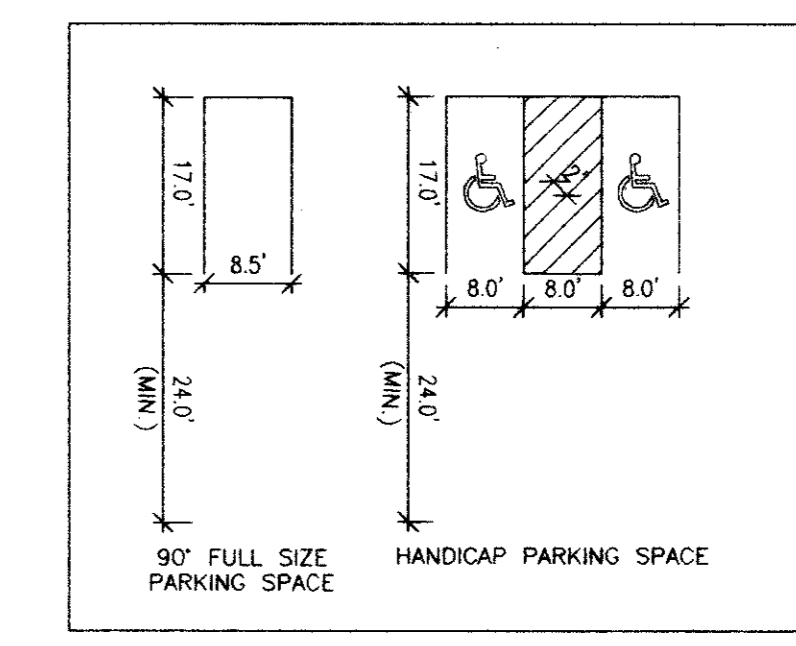


LEGEND

- TG TOP OF GRATE
- INV INVERT
- FL FLOW LINE
- HP HIGH POINT
- BC BOTTOM OF CURB
- TC TOP OF CURB
- TW TOP OF WALL
- BOC BACK OF CURB
- FOC FACE OF CURB
- RETAINING WALL
- MORTAR STACK ROCK WALL
- WATER LINE
- WASTE WATER LINE
- STORM SEWER LINE
- FIRE HYDRANT
- WATER METER
- POWER POLE
- OVERHEAD ELECTRIC
- +100.00 EXISTING SPOT ELEVATION
- 100.00 PROPOSED SPOT ELEVATION
- MISC. CONCRETE PAVING
- LIMITS OF CONSTRUCTION
- PROPERTY LINE
- SILT FENCE
- DRAINAGE AREA
- DRAINAGE AREA BOUNDARY
- FILTER DIKE
- TREE PROTECTION FENCE
- EXISTING CONTOUR
- PROPOSED CONTOUR
- EXISTING TREE TO REMAIN
- EXISTING TREE TO BE REMOVED
- TRAFFIC GUARD RAIL
- FIRE LANE DESIGNATION
- HAND RAILS

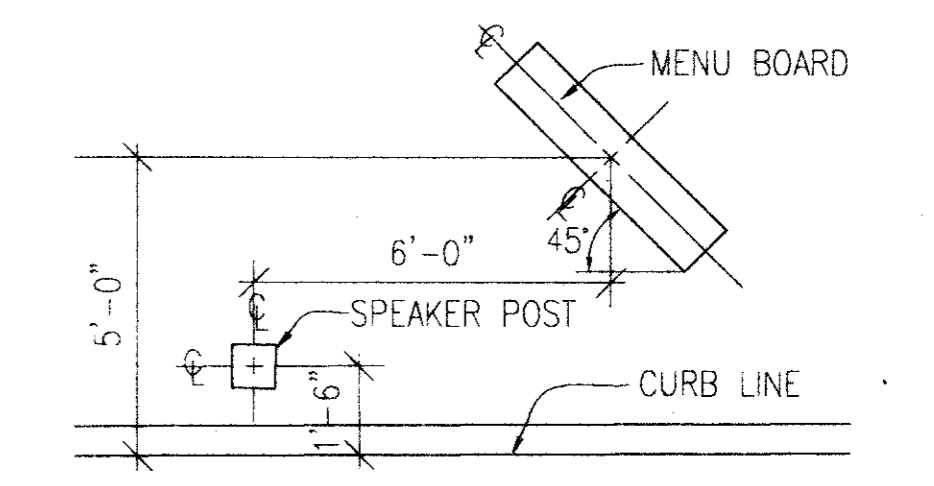

DRIVE THRU MENUBOARD AND SPEAKER LOCATION
NTS

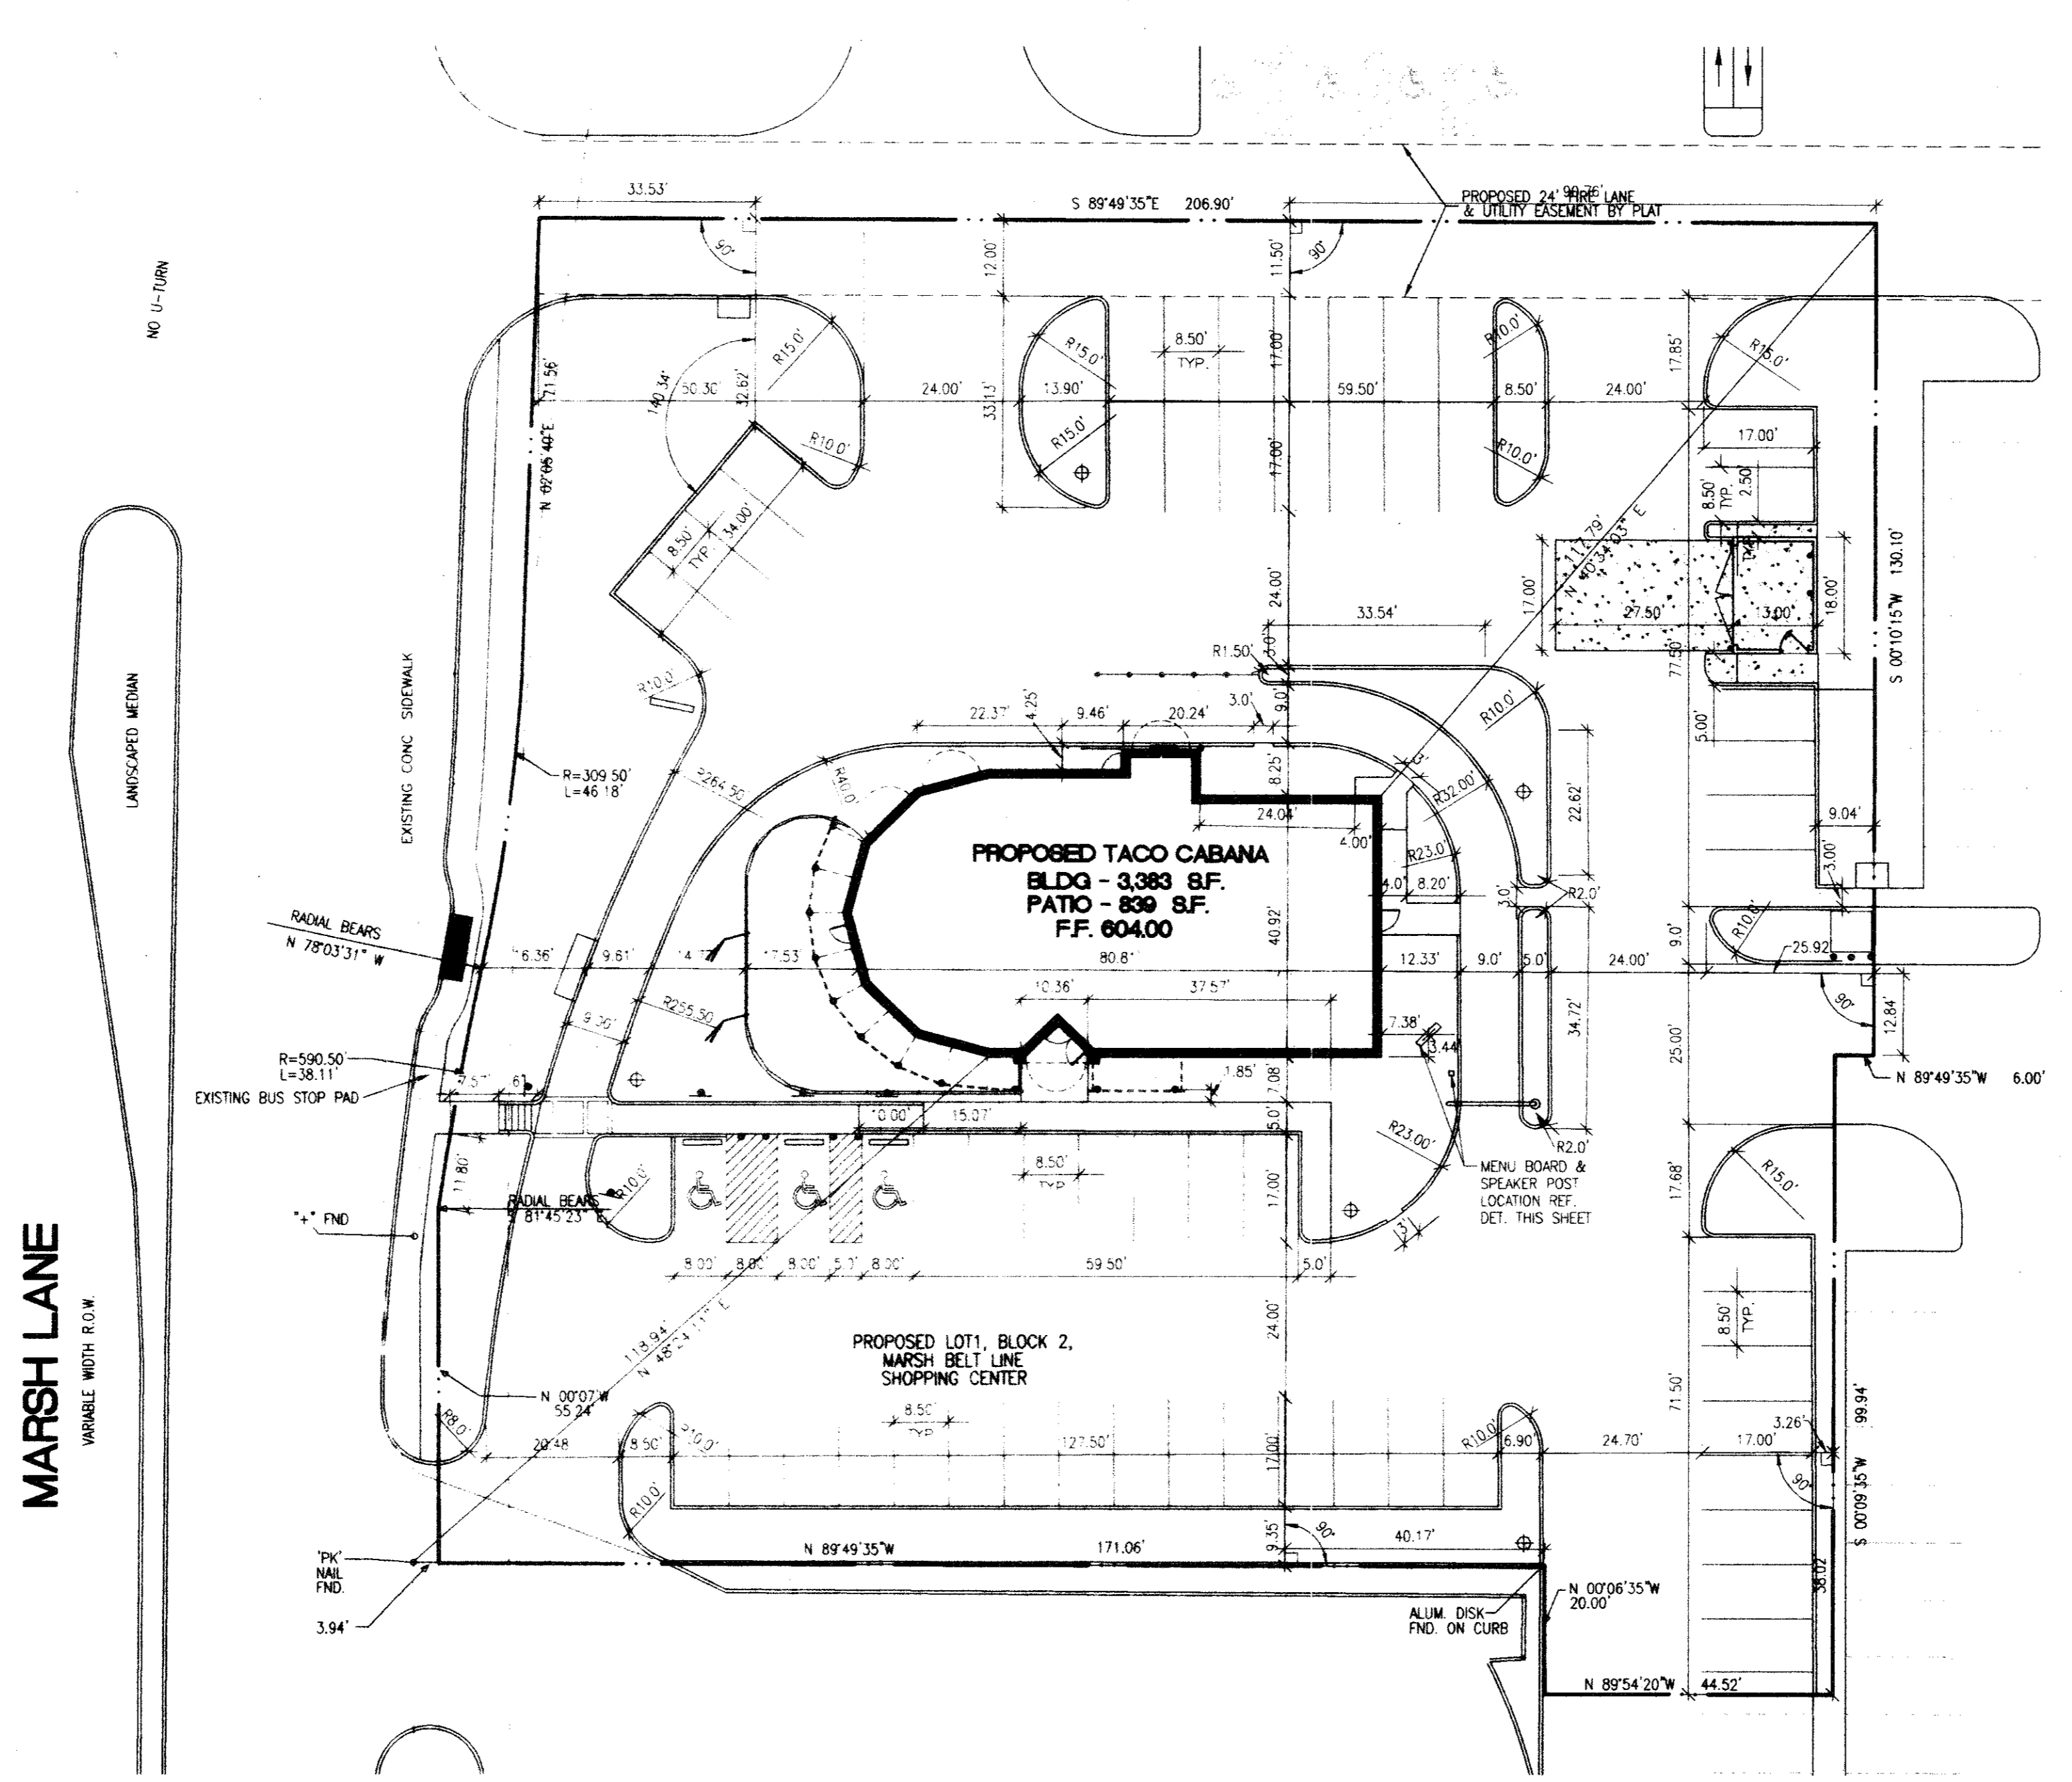

MARSH LANE
VARIABLE WIDTH R.O.W.
LANDSCAPED MEDIAN

ATTENTION
THE ENGINEER ASSUMES NO RESPONSIBILITY FOR THE EXISTENCE OR LOCATION OF ANY SURFACE OR SUBSURFACE STRUCTURES. THE CONTRACTOR IS RESPONSIBLE FOR CONTACTING ALL AGENCIES AND/OR OWNERS TO VERIFY THIS INFORMATION.
ALL CONSTRUCTION MATERIALS AND TECHNIQUES SHALL CONFORM TO CURRENT TOWN OF ADDISON STANDARD SPECIFICATIONS.

Anne R. Mele
3-10-98



1191-004
FILENAME: TCA-DIM.DWG
XREF: TCABASE.DWG

DIMENSION CONTROL PLAN AS BUILT

TACO CABANA 3801 BELT LINE ROAD		SHT. 3 OF 10
DATE: 9-23-97	SCALE: 1" = 20'	DRAWN BY:
REVISIONS: 11-14-97		
 315 Bowie / Austin, TX 78703 / (512) 469-0500		