


MARSH LANE
VARIABLE WIDTH R.O.W.

NO U-TURN

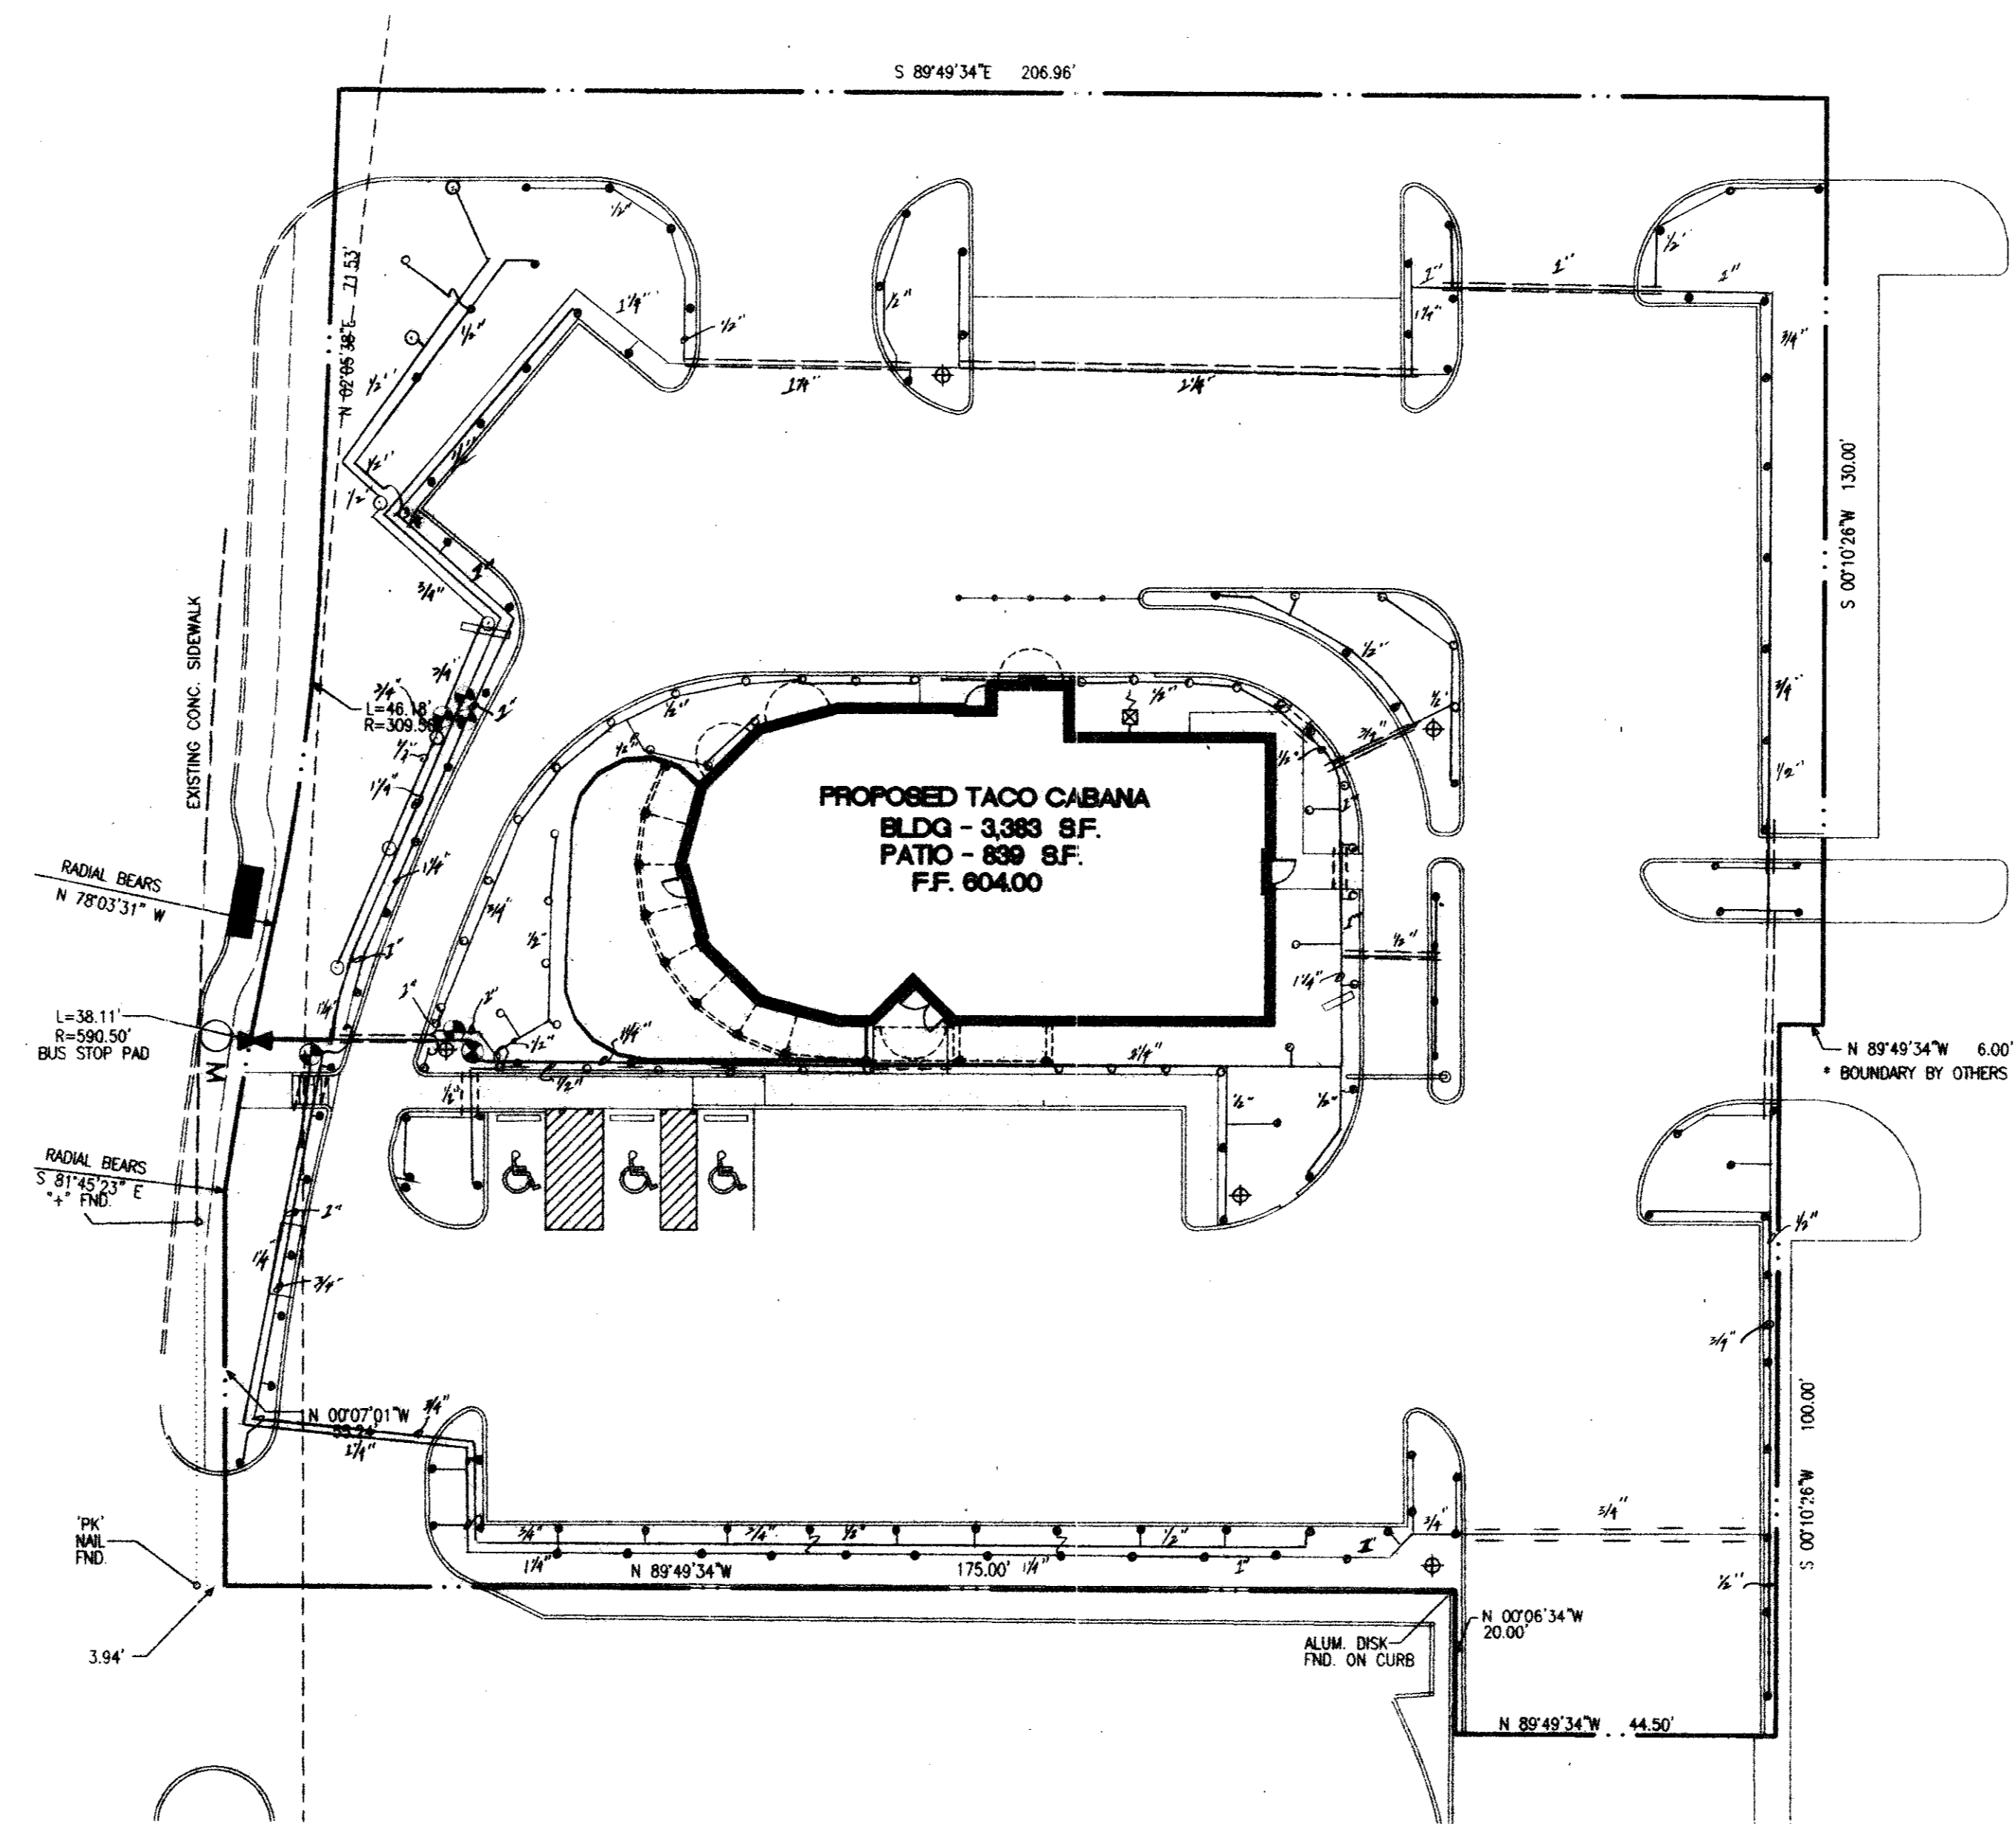


LEGEND

- IRRITROL HS4 POP UP SPRAY HEADS
- IRRITROL HS12 POP UP SPRAY HEADS
- ⊙ RAINBIRD R50 ROTARY HEADS
- ⊕ RAIN BIRD 100 DV ELECTRIC VALVES
- ⊗ WILKINS DOUBLE CHECK VALVE ASSEMBLY
- PVC SDR-21 PIPE



1191-004

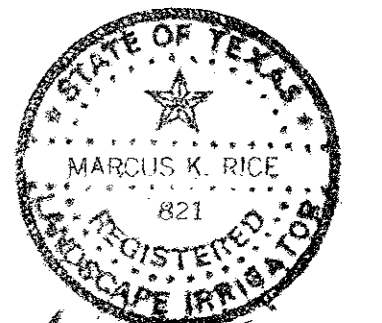

IRRIGATION PLAN AS BUILT

TACO CABANA 3801 BELT LINE ROAD		SHT. 8 OF 10
DATE: 9-23-97	SCALE: 1" = 20'	DRAWN BY:
REVISIONS:		