
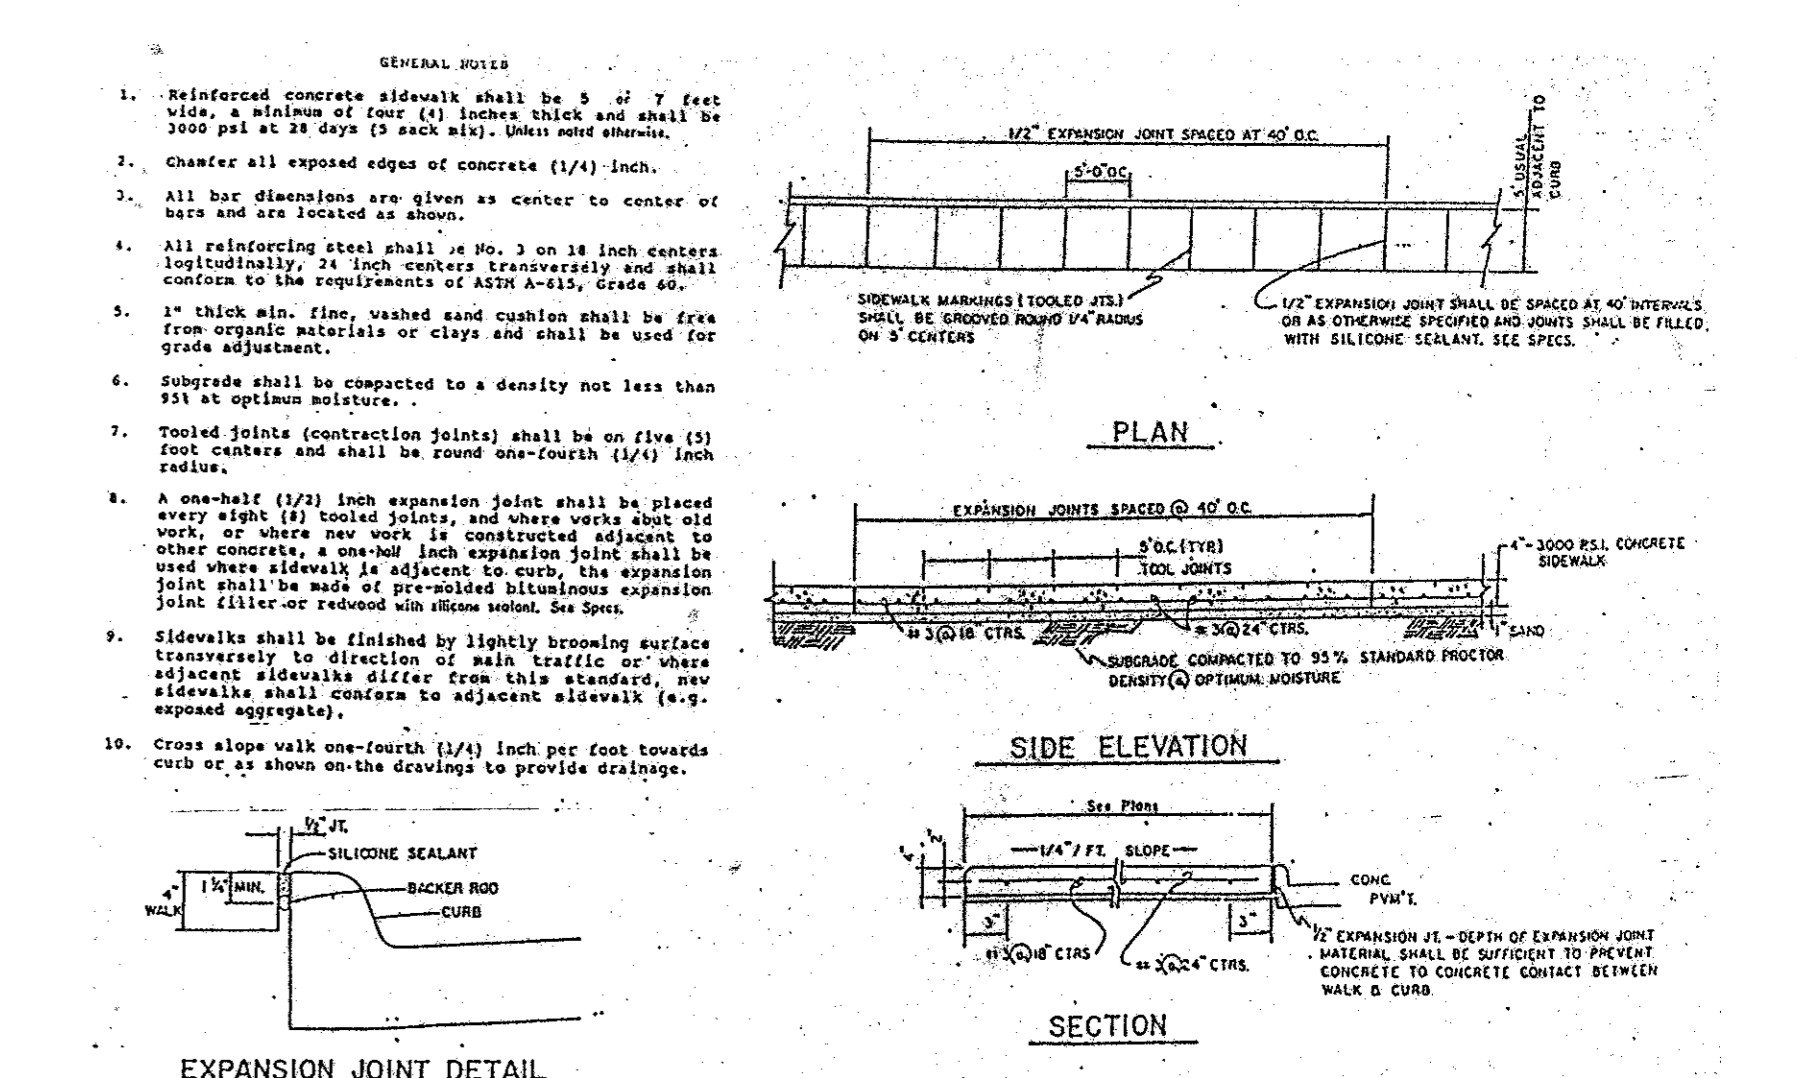
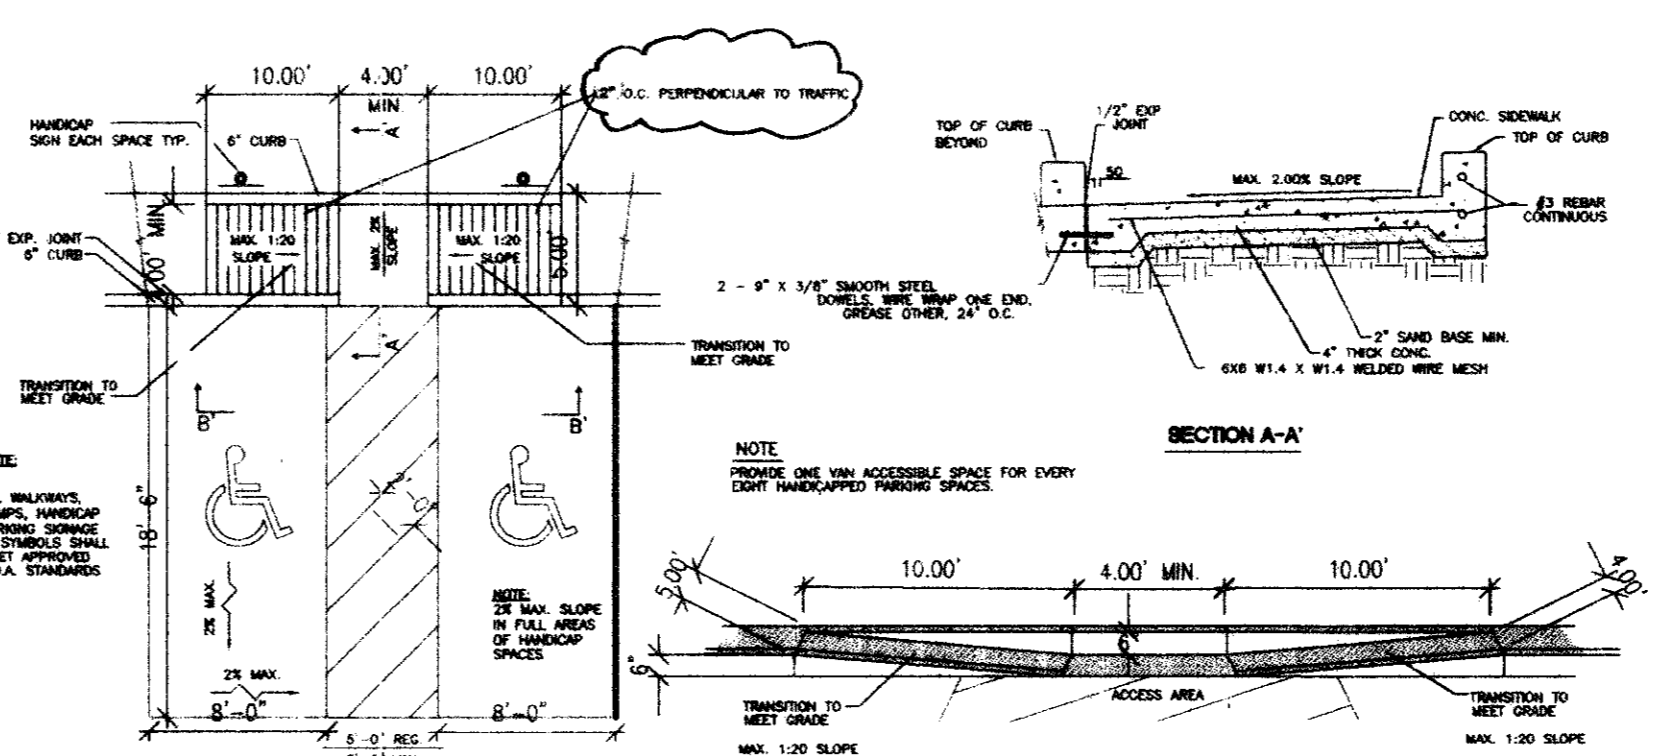


**NOTES:**

- WELDS:**
  - All shop and field welds shall be made by welders who have been qualified and certified to make the required welds within the previous year in accordance with the latest American Welding Society Specification AWS D11.
  - Grind and weld spatter smooth.
  - Grind all welds smooth.
  - Remove all slag prior to painting.
- PRIME PAINTING:**
  - Thoroughly clean all surfaces of dirt, scale, or other foreign material.
  - Prime all metal surfaces with one coat red oxide primer.
- FINISH PAINTING:**
  - Lightly sand all surfaces to be painted.
  - Paint all metal surfaces with Sherwin-Williams Silicone Alkyd Industrial Enamel "Taco Cabana Pink" except lettering.
  - Paint all lettering with GLO-GUARD 4550 Series Alkyd Industrial Enamel "White".





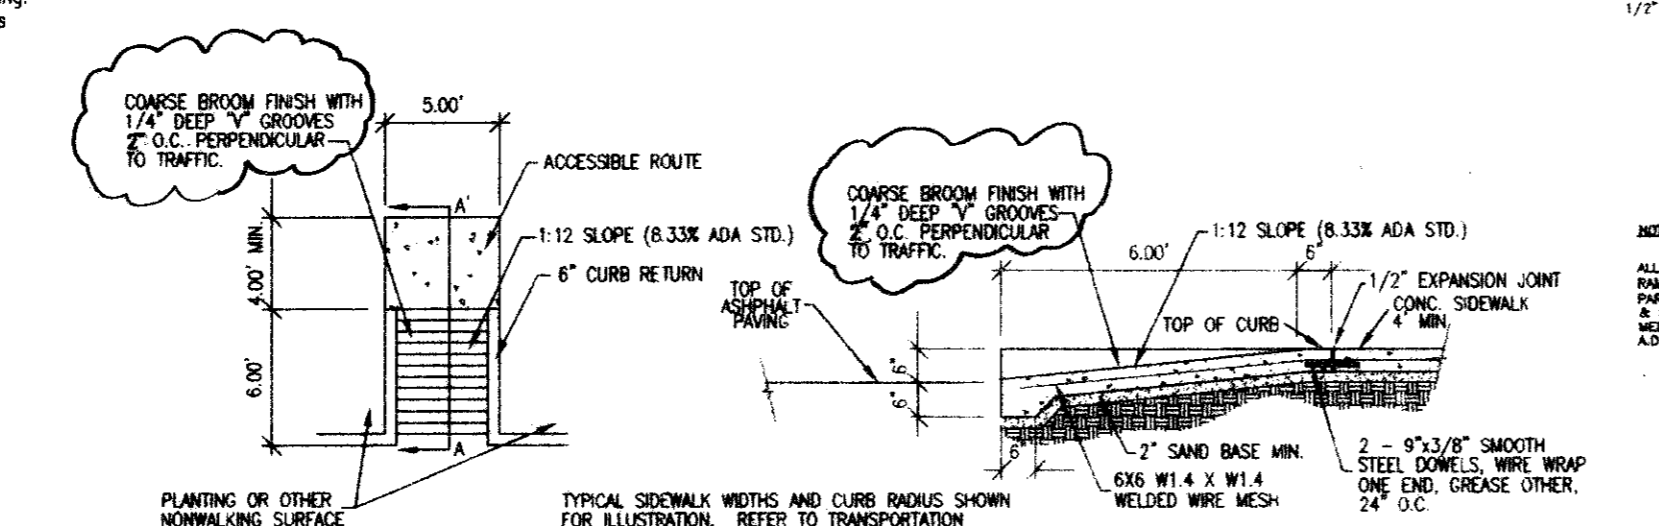


**4 OVERHEAD VEHICLE RESTRICTION STRUCTURE** NTS

**3 HANDICAPPED RAMP DETAIL TYPE** NTS

**2 HANDICAPPED ACCESS DETAIL** NTS

**1 CONCRETE SIDEWALK DETAIL** TOWN OF ADDISON NTS

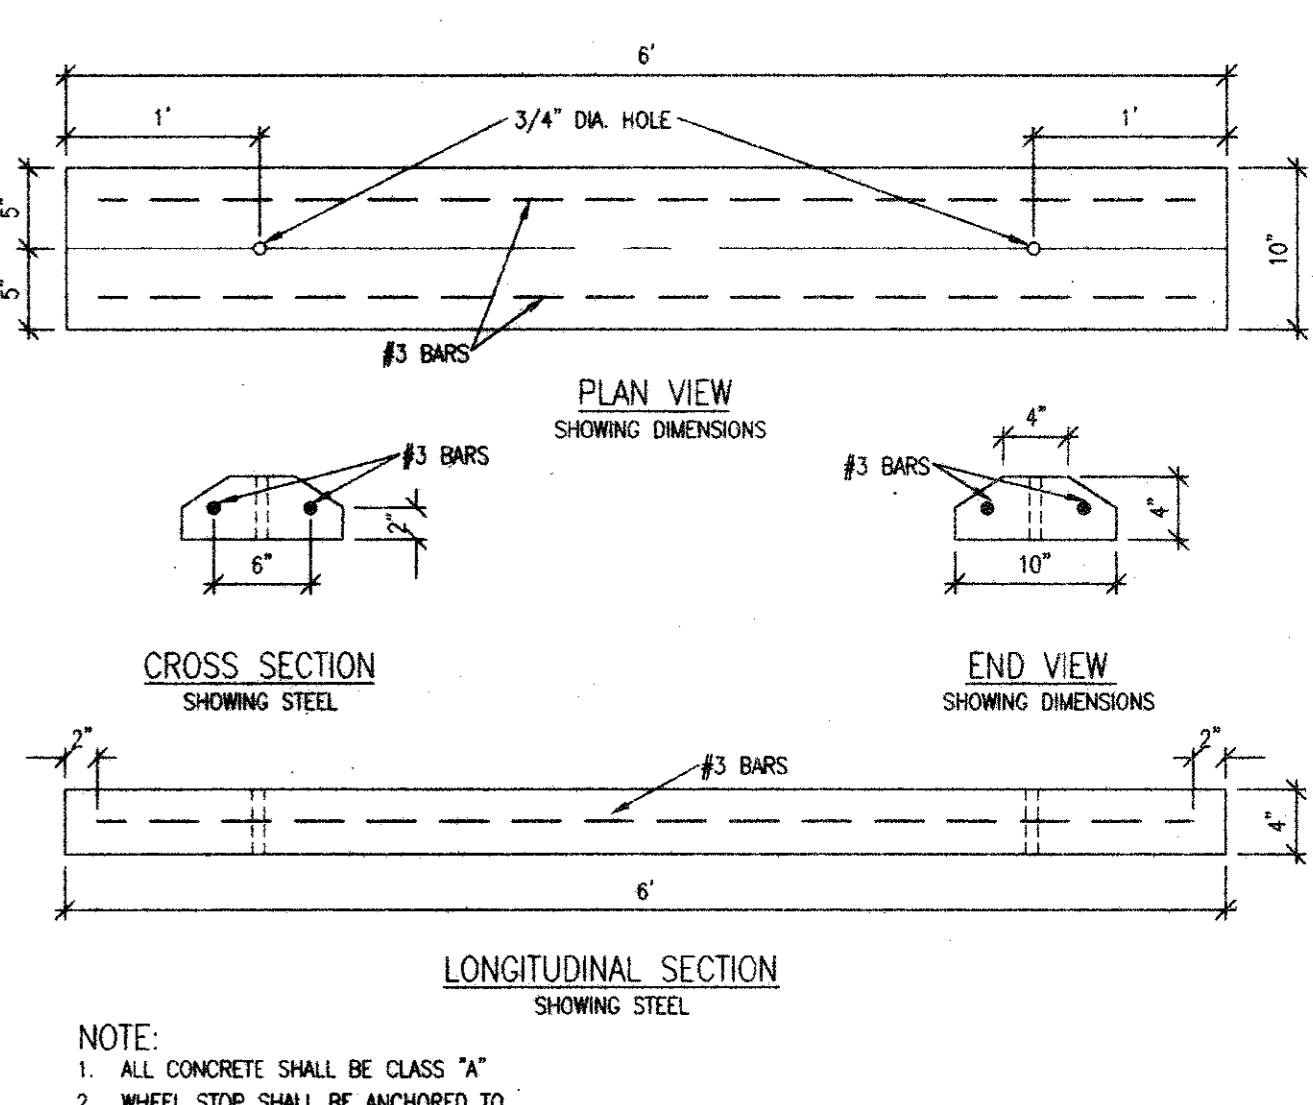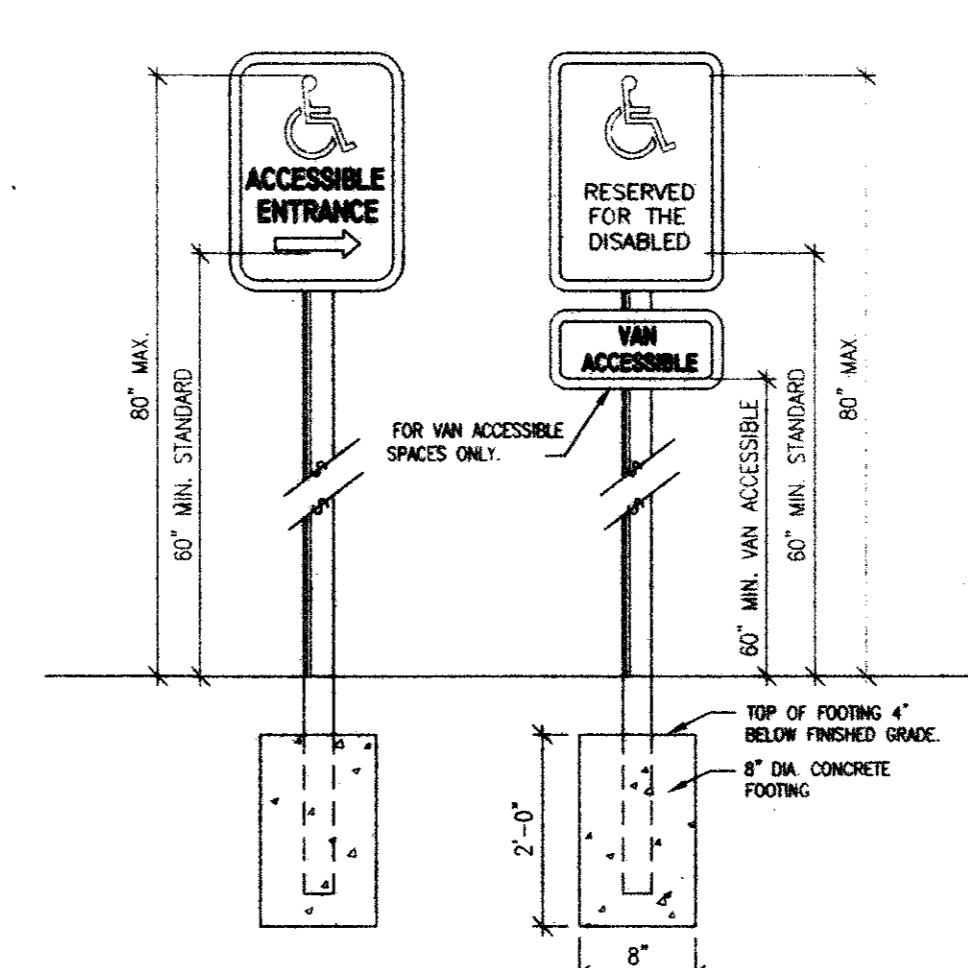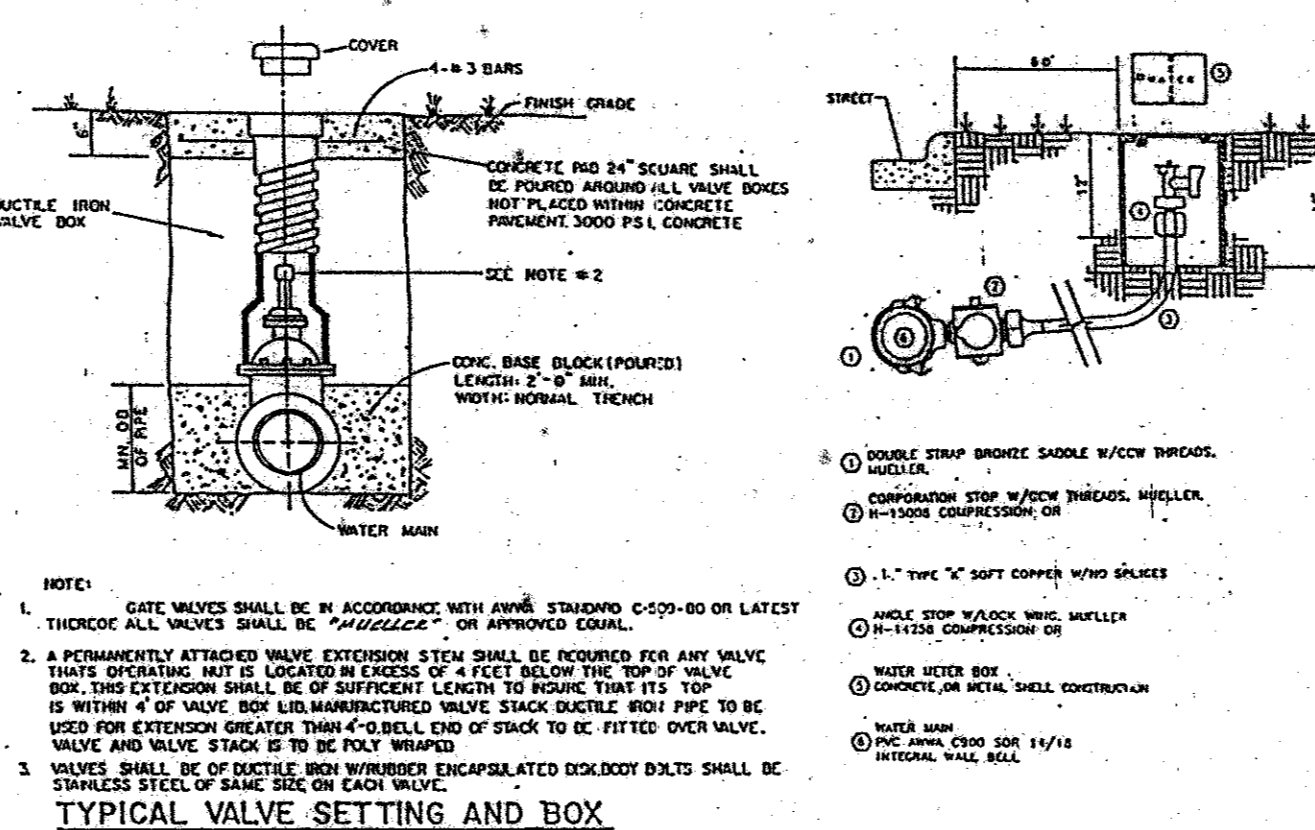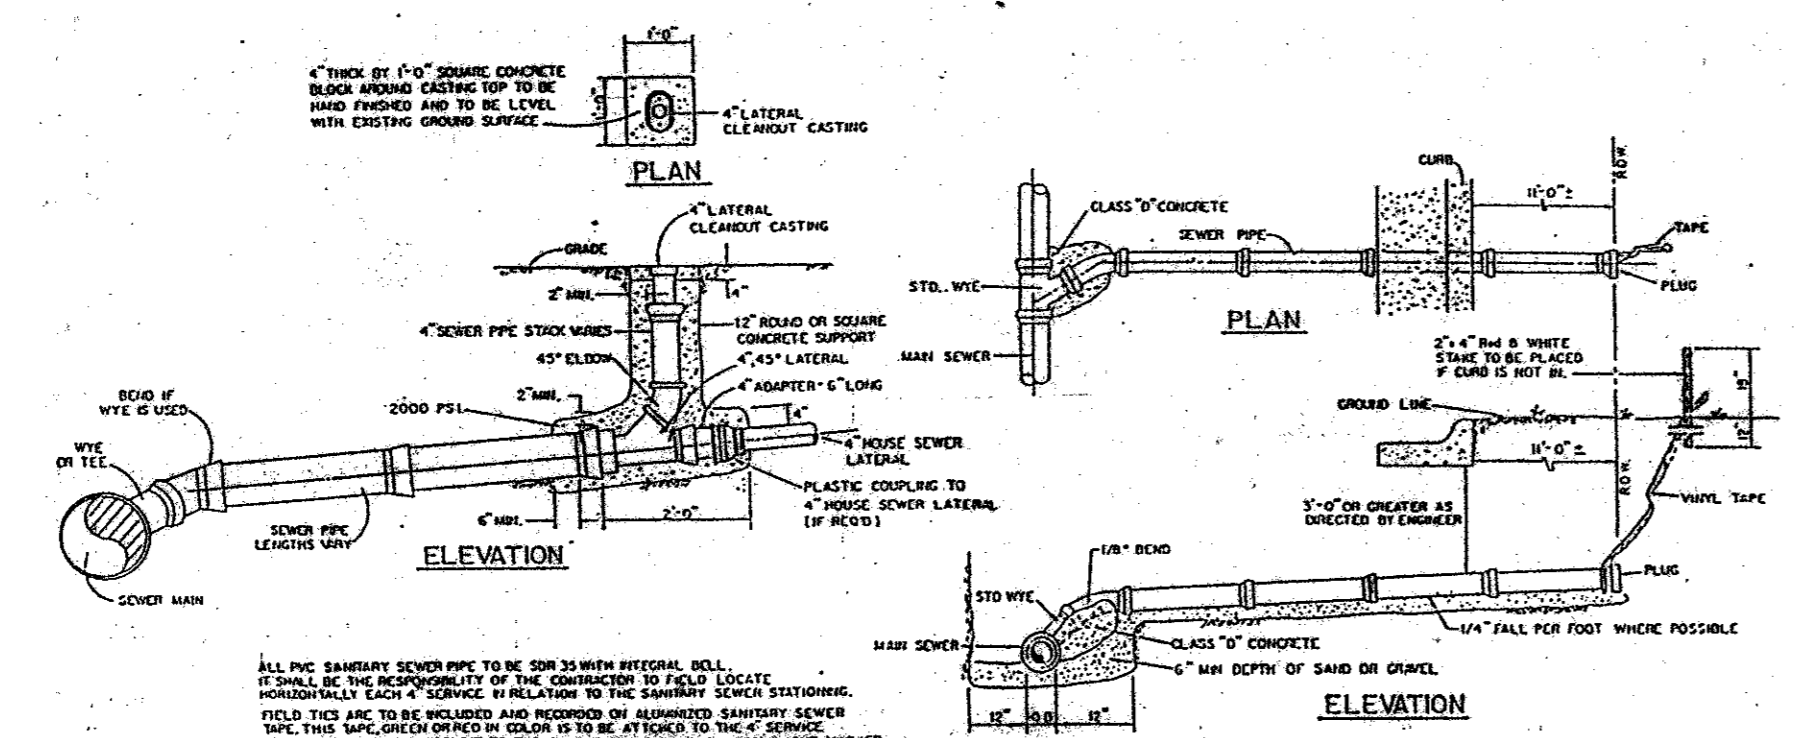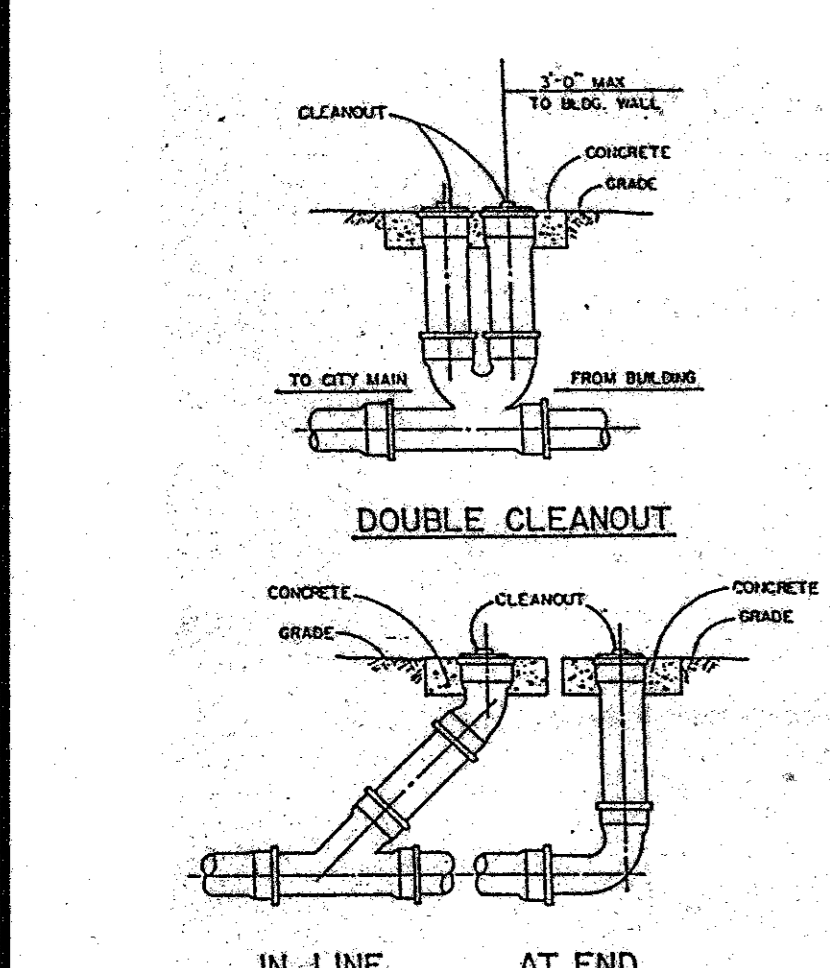


**9 CLEANOUT DETAILS** TOWN OF ADDISON NTS

**8 SANITARY SEWER SERVICE CONNECTION** TOWN OF ADDISON NTS

**7 WATER SERVICE CONNECTION** TOWN OF ADDISON NTS


**6 ACCESSIBILITY SIGNAGE DETAILS** NTS

**5 WHEELSTOP DETAIL** NTS

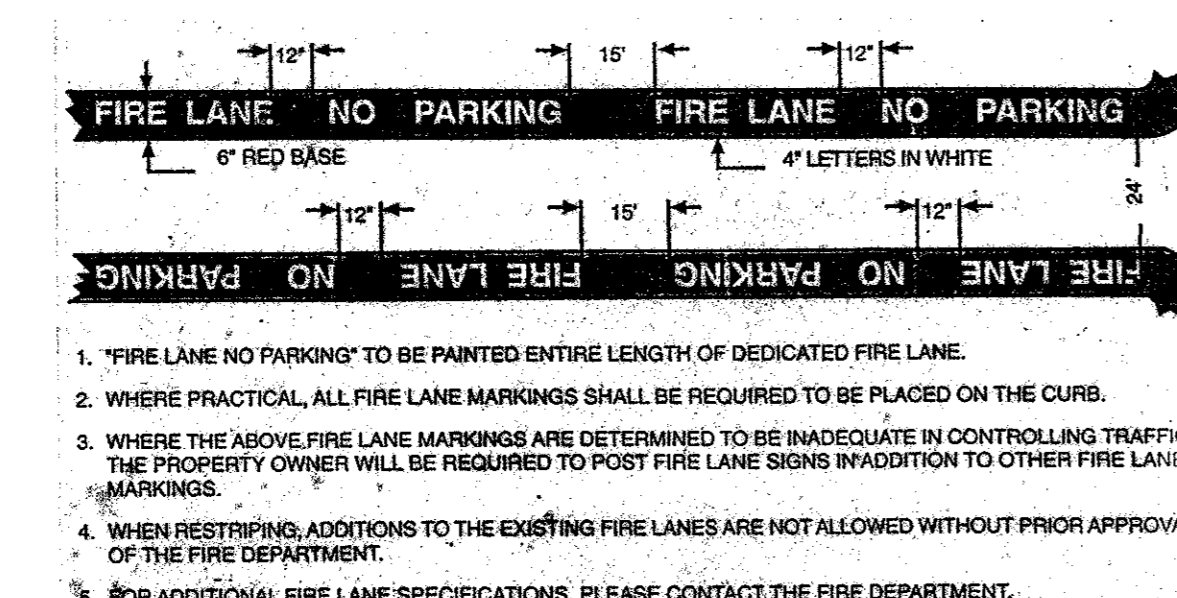


- "FIRE LANE NO PARKING" TO BE PAINTED ENTIRE LENGTH OF DEDICATED FIRE LANE.
- WHERE PRACTICAL, ALL FIRE LANE MARKINGS SHALL BE REQUIRED TO BE PLACED ON THE CURB.
- WHERE THE ABOVE FIRE LANE MARKINGS ARE DETERMINED TO BE INADEQUATE IN CONTROLLING TRAFFIC, THE PROPERTY OWNER WILL BE REQUIRED TO POST FIRE LANE SIGNS IN ADDITION TO OTHER FIRE LANE MARKINGS.
- WHEN RESTRIPTING, ADDITIONS TO THE EXISTING FIRE LANES ARE NOT ALLOWED WITHOUT PRIOR APPROVAL OF THE FIRE DEPARTMENT.
- FOR ADDITIONAL FIRE LANE SPECIFICATIONS, PLEASE CONTACT THE FIRE DEPARTMENT.


**13 TYPICAL FIRELANE MARKING DETAIL** NTS

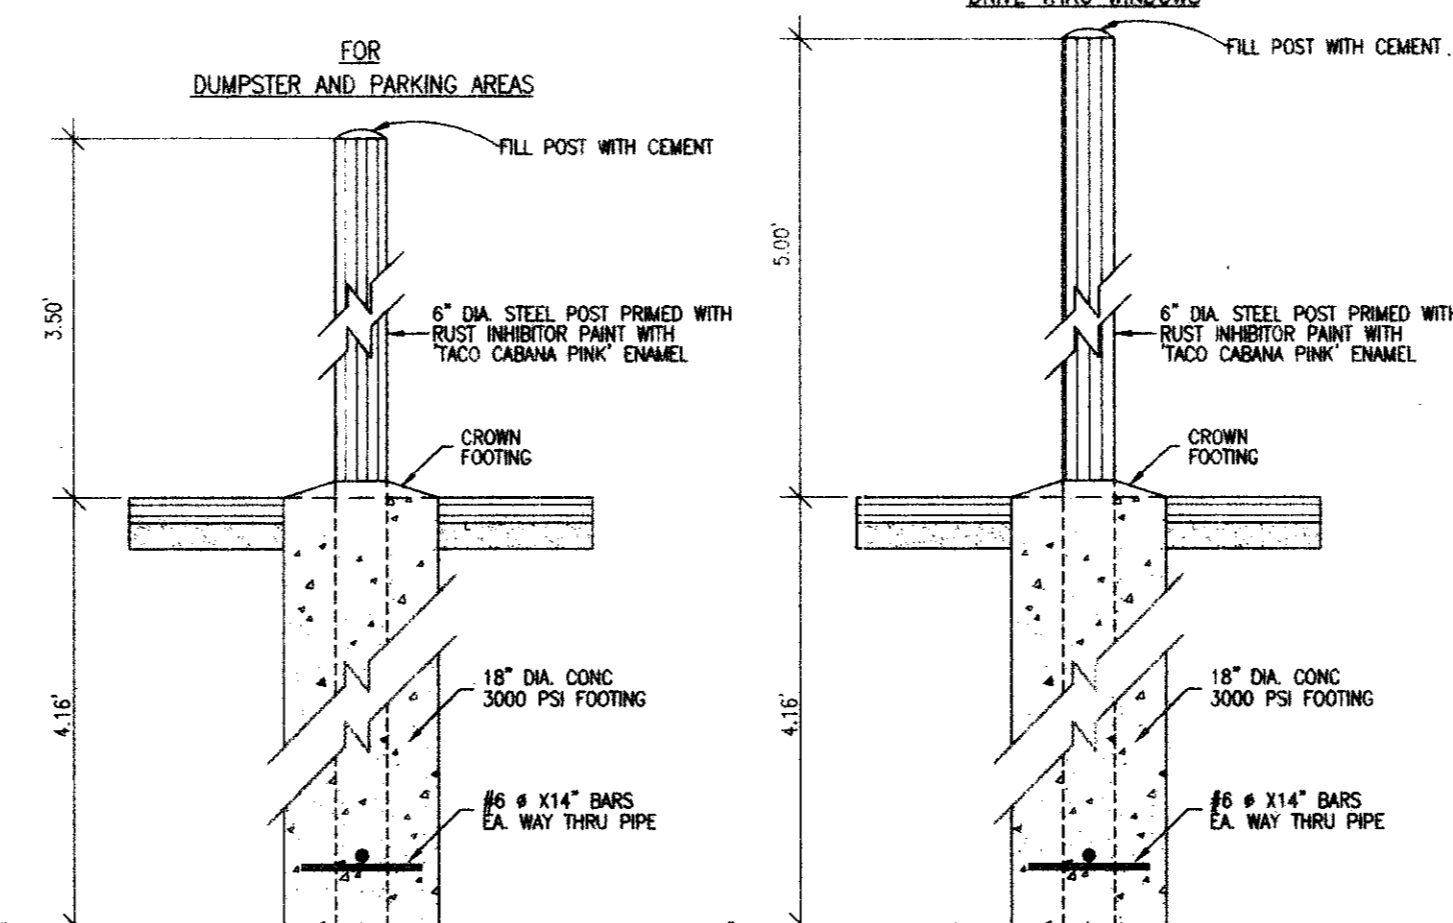

**12 METAL BOLLARD DETAILS** NTS

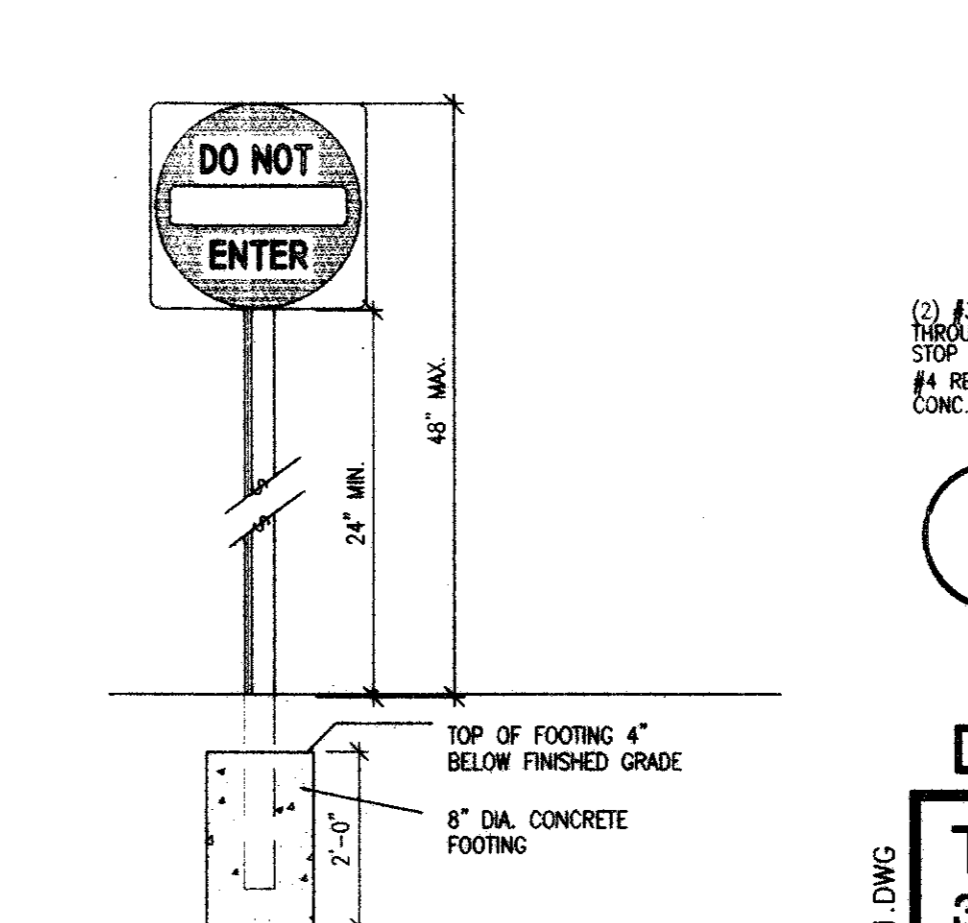

**11 DIRECTION SIGNAGE DETAIL** NTS

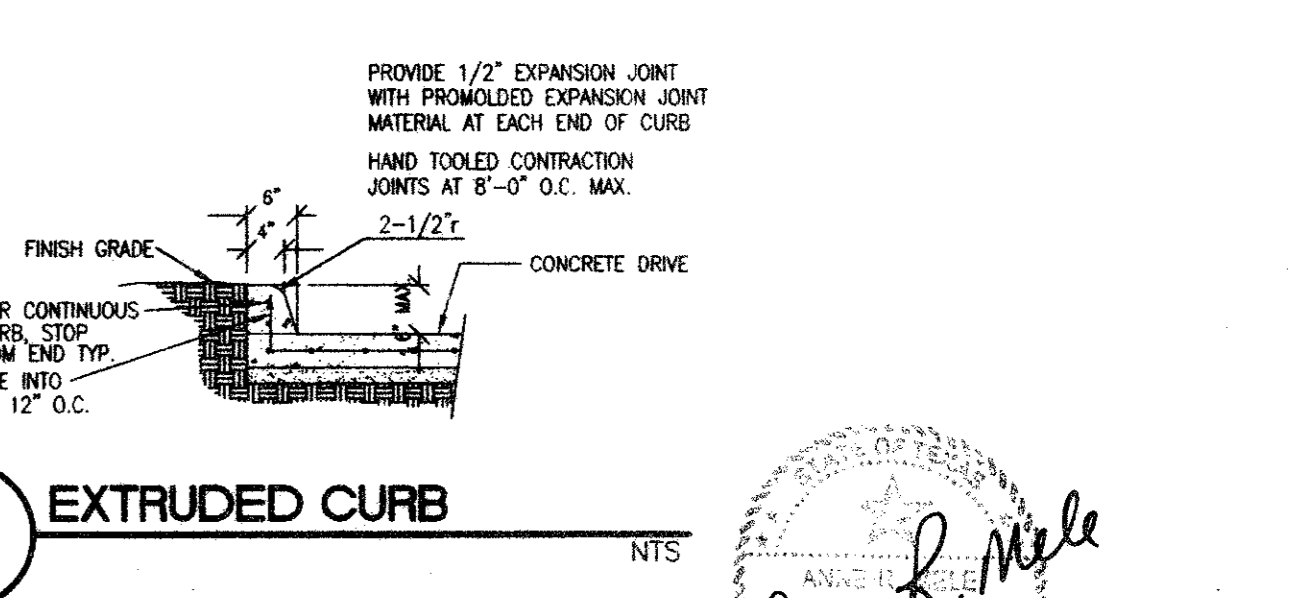

**10 EXTRUDED CURB** NTS

**ATTENTION**  
THE ENGINEER ASSUMES NO RESPONSIBILITY FOR THE EXISTENCE OR LOCATION OF ANY SURFACE OR SUBSURFACE STRUCTURES. THE CONTRACTOR IS RESPONSIBLE FOR CONTACTING ALL AGENCIES AND/OR OWNERS TO VERIFY THIS INFORMATION.  
ALL CONSTRUCTION MATERIALS AND TECHNIQUES SHALL CONFORM TO CURRENT TOWN OF ADDISON STANDARD SPECIFICATIONS.

**DETAIL SHEET AS BUILT**

**TACO CABANA**  
3801 BELT LINE ROAD

DATE: 9-23-97 SCALE: AS SHOWN DRAWN BY: *BB*

SHT. OF 9 OF 10

REVISIONS:

*Consort, Inc.*  
315 Bowie / Austin, TX 78703 / (512) 469-0500

1191-004  
FILENAME: TCAR-DTI.DWG

*Amie R. Melle*  
9-24-97