

CONSTRUCTION PLANS FOR

SUITES OF AMERICA


CITY OF ADDISON DALLAS COUNTY, TEXAS

DEVELOPER:

BIGELOW DEVELOPMENT CORPORATION
4004 BELTLINE ROAD, SUITE 240, LOCK BOX #1
DALLAS, TEXAS 75244
(972) 503-8880

ENGINEER:

JONES & BOYD, INC.
16800 DALLAS PARKWAY, SUITE 240
DALLAS, TEXAS 75248
(214) 248-7676

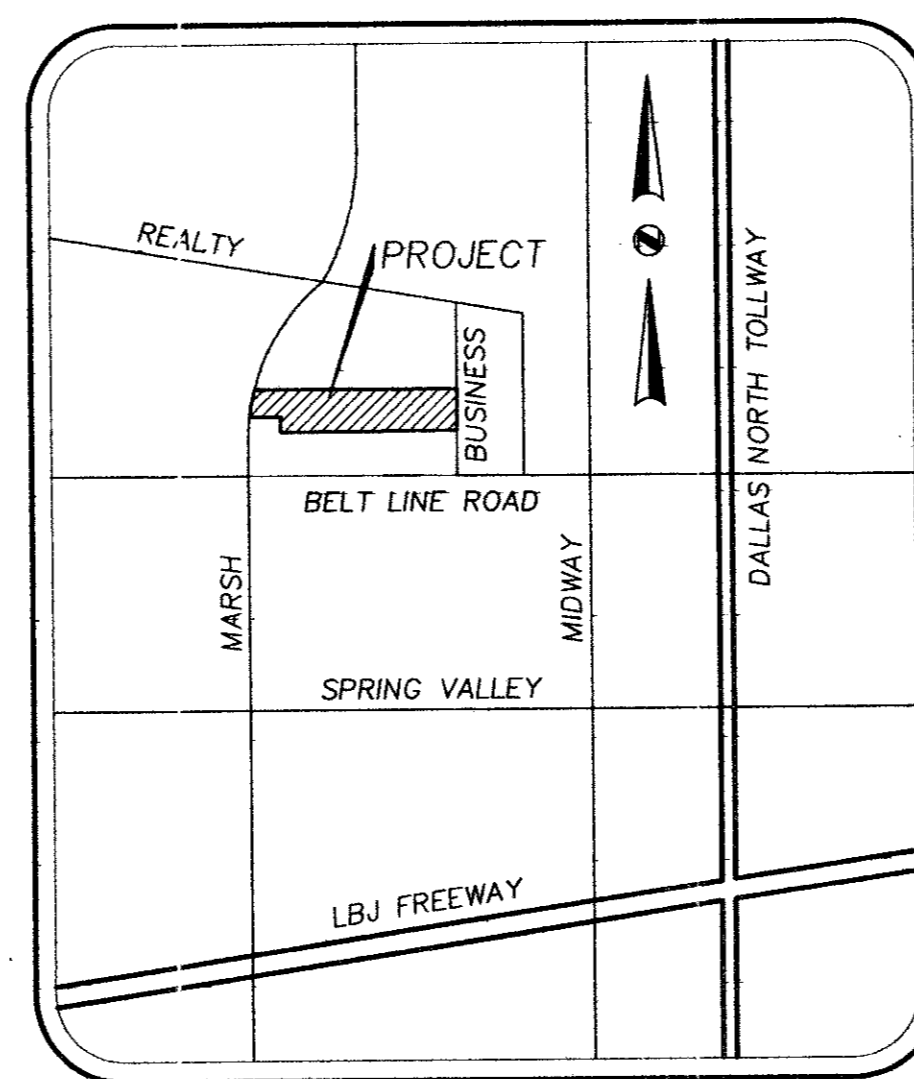

LOCATION MAP
NOT TO SCALE

INDEX


SHEET NO.	DESCRIPTION
1	PAVING & DIMENSION CONTROL PLAN
2	PAVING DETAILS
3	GRADING PLAN
4	DRAINAGE PLAN
5	STORM SEWER PLAN
6	STORM SEWER PROFILES
7	WATER & SANITARY SEWER PLAN
8	EROSION CONTROL PLAN




Richard W. Akin
5/20/99

RECORD DRAWING
THIS DRAWING HAS BEEN REVISED
TO REFLECT THE ACTUAL
CONSTRUCTION DETAILS AS
COMPALED IN THE RECORDS OF THE
CONTRACTOR. ELEVATIONS SHOWN ON
THIS PLAN WERE NOT FIELD VERIFIED.
BY: *[Signature]*
DATE: 2/1/00


Raised 5/26/99

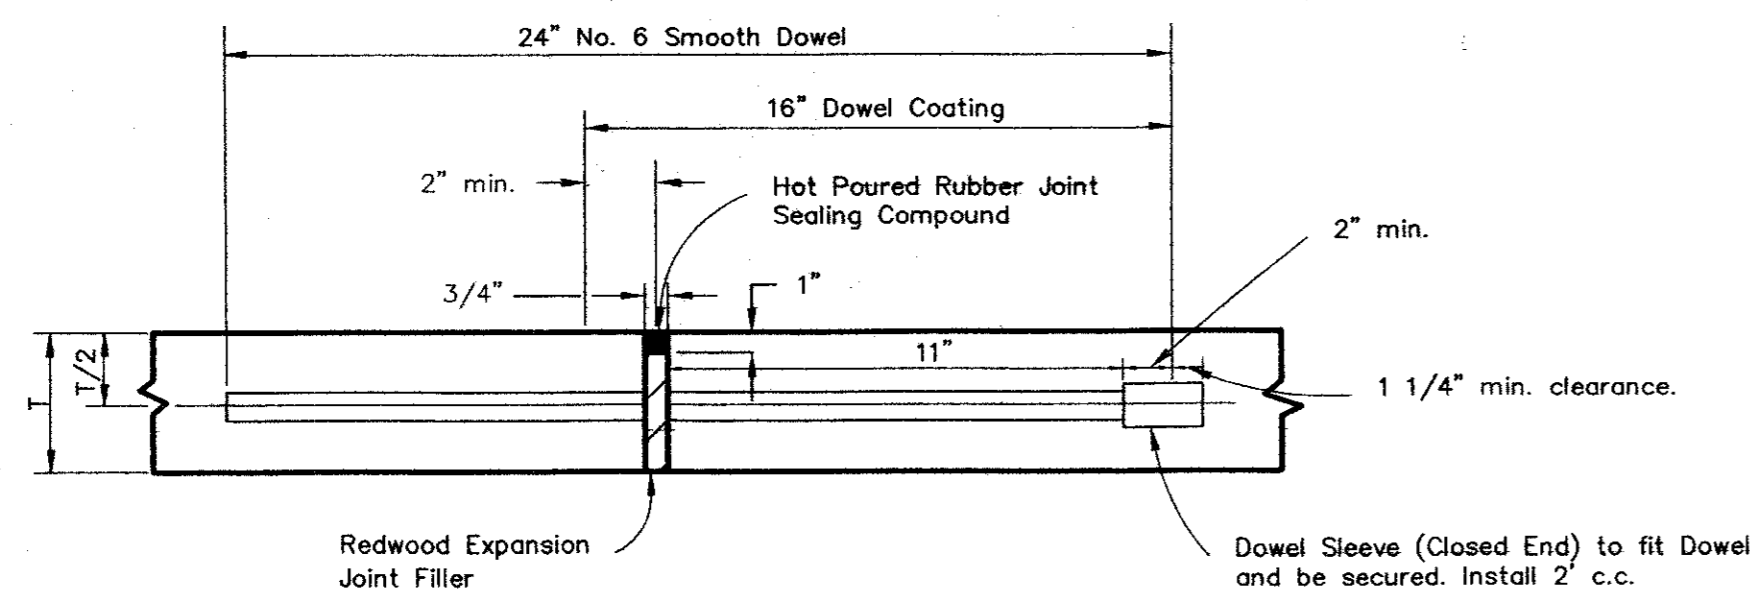


TRANSVERSE EXPANSION JOINT (ON-SITE)
N.T.S.

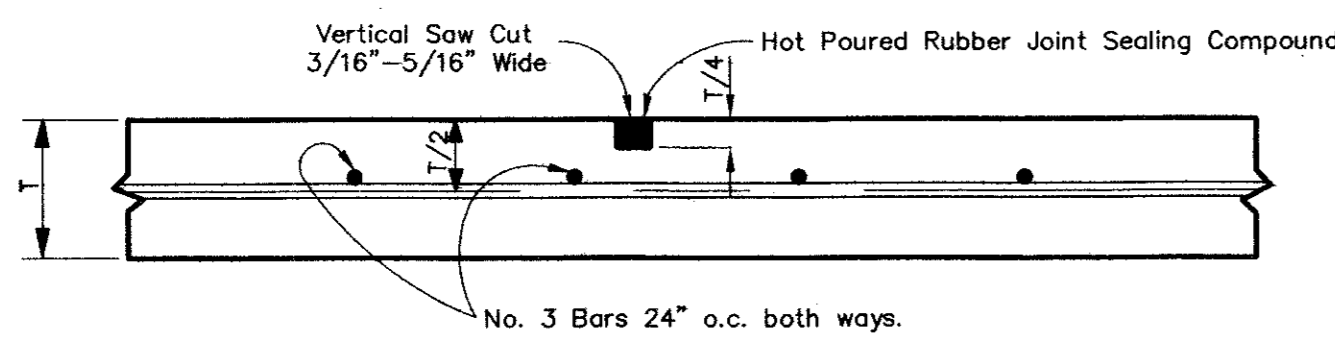

SAWED DUMMY JOINT (ON-SITE)
N.T.S.

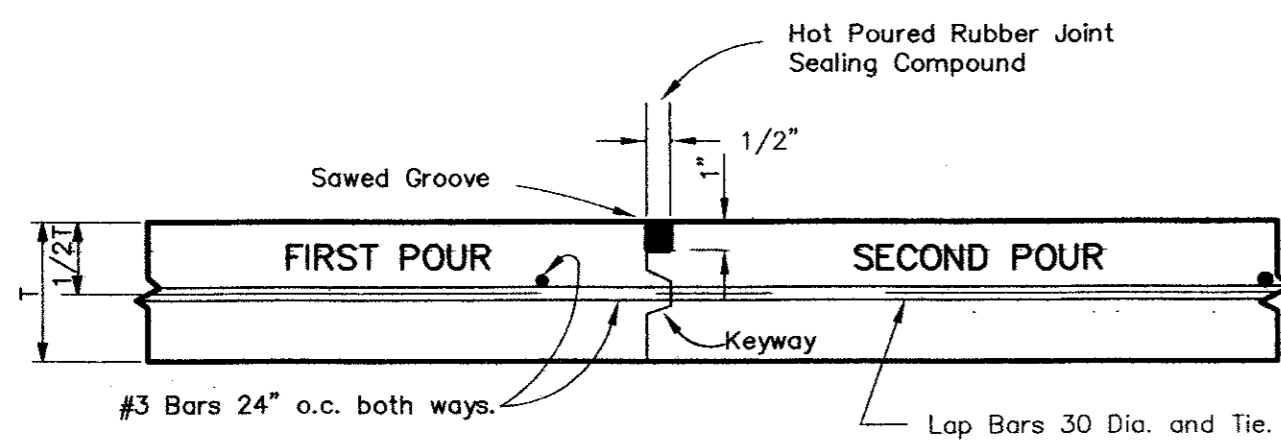


CONSTRUCTION JOINT (ON-SITE)
N.T.S.

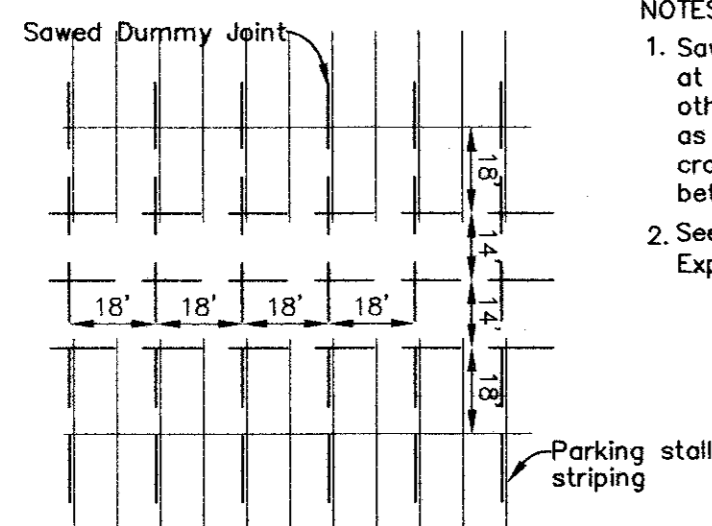


TYPICAL SAWED DUMMY JOINT LAYOUT
N.T.S.


NOTES:
1. Sawed Dummy Joints required at all curb return points and other points at curb islands as necessary to prevent cracking. Maximum distance between joints shall be 18'.
2. See sh. 4 for Transverse Expansion Joint locations.

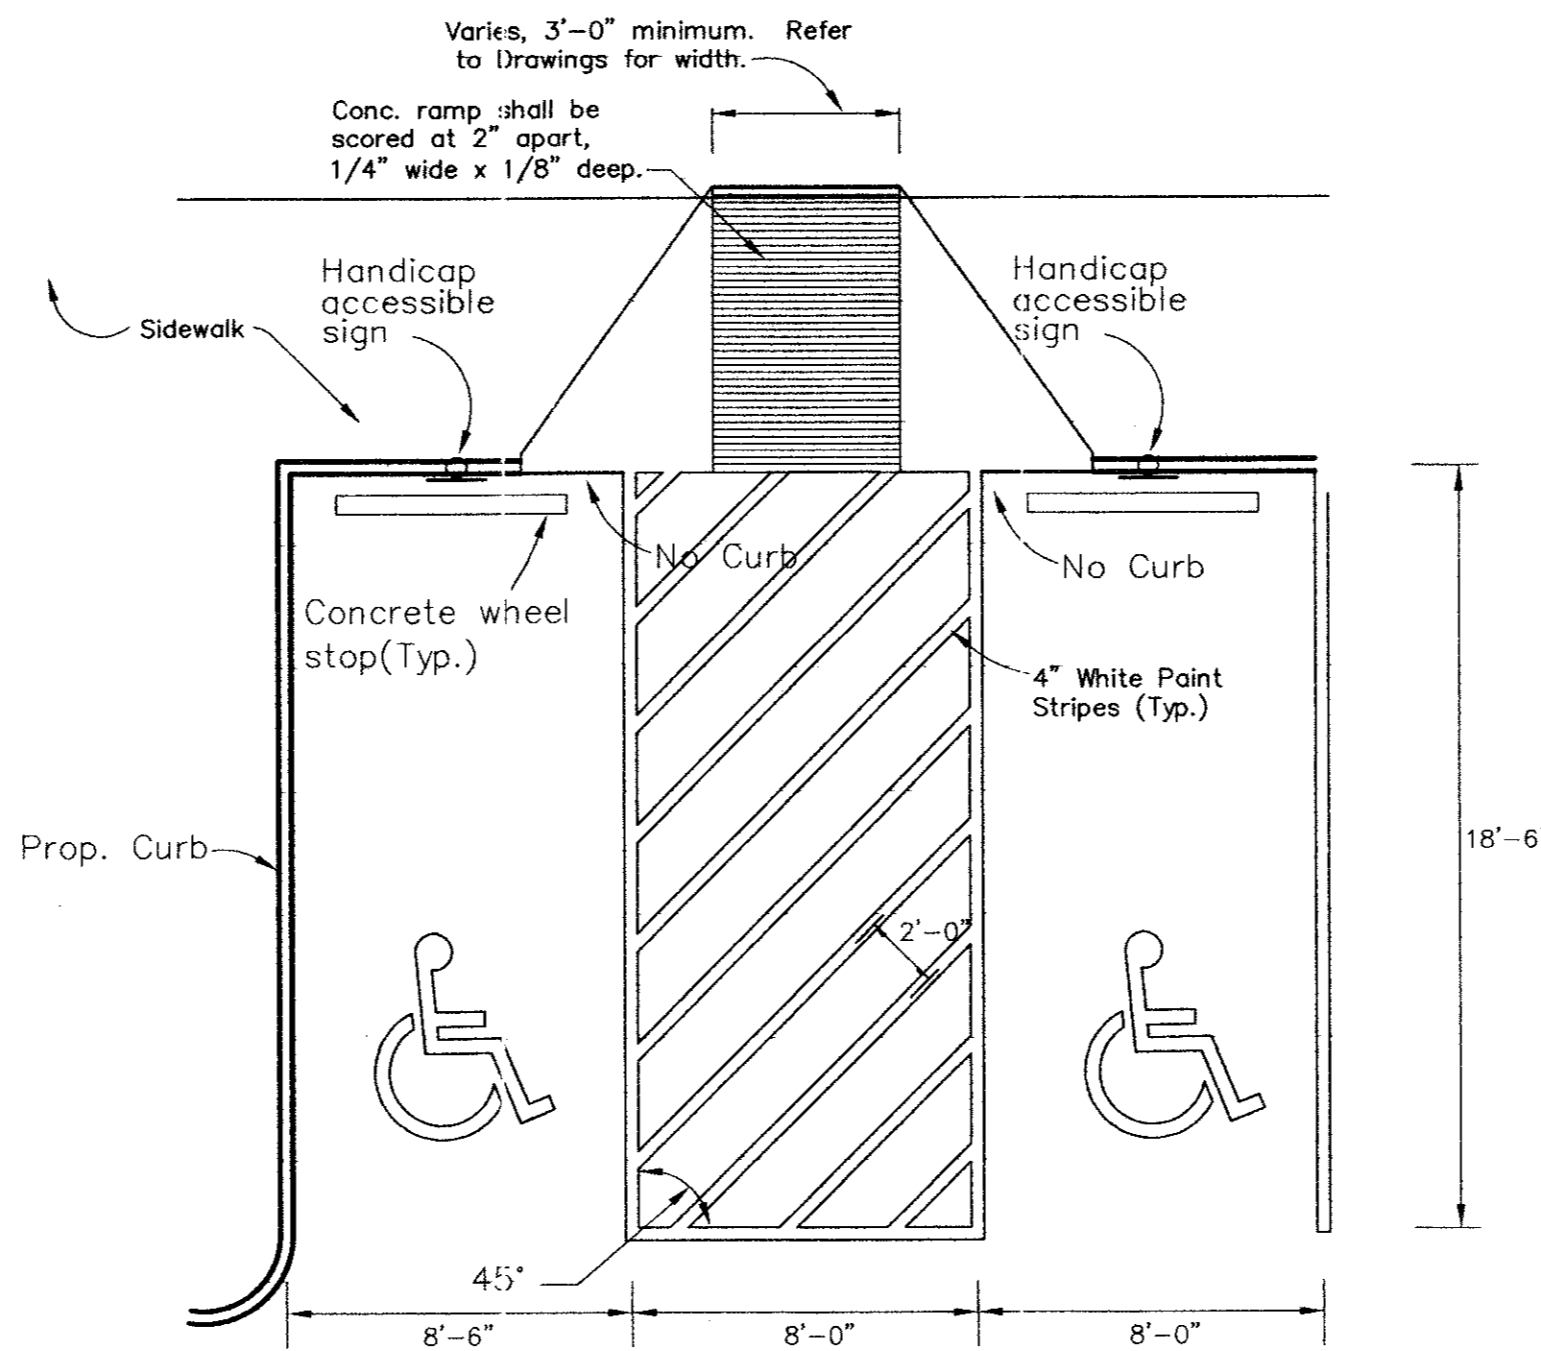


HANDICAP VAN & STANDARD PARKING
N.T.S.

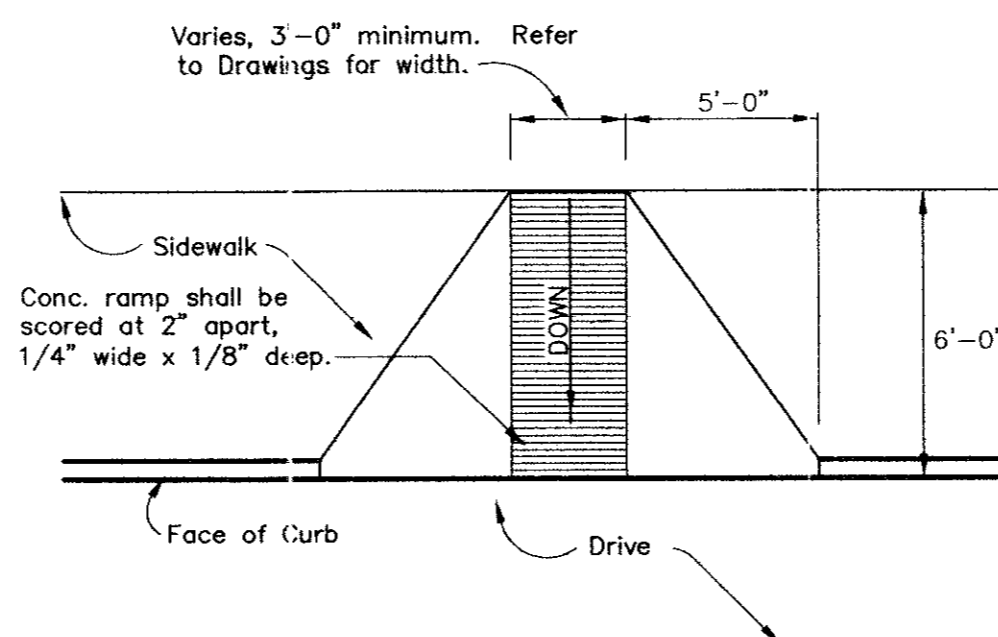


TYPICAL CURB RAMP - PLAN (ON-SITE)
1"=5'

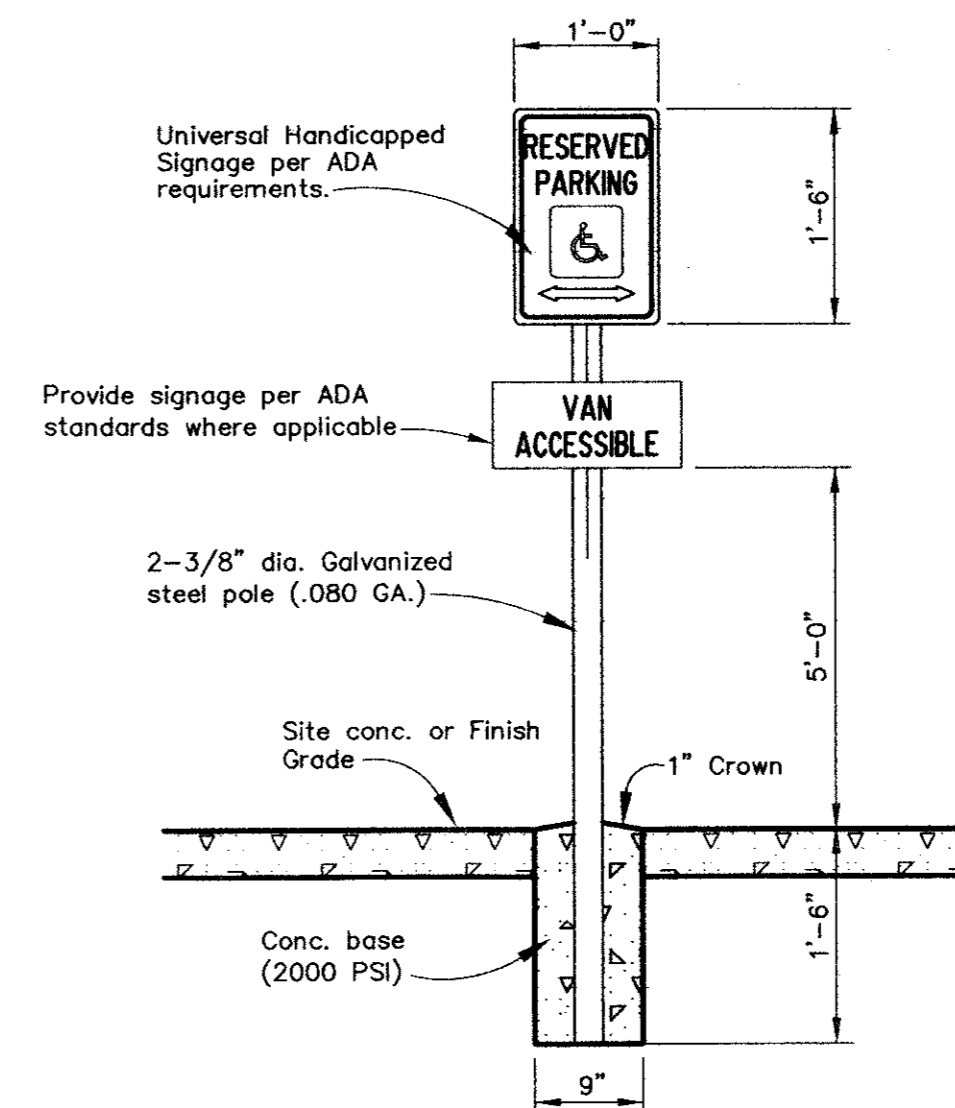


HANDICAP SIGNAGE DETAIL
N.T.S.

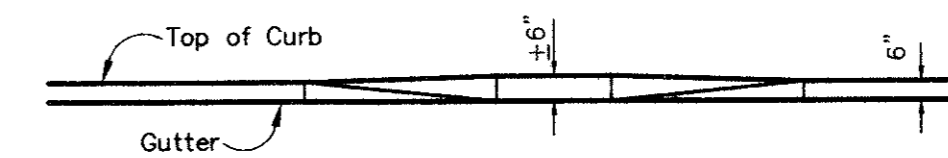

CURB RAMP - ELEVATION (ON-SITE)
1"=5'


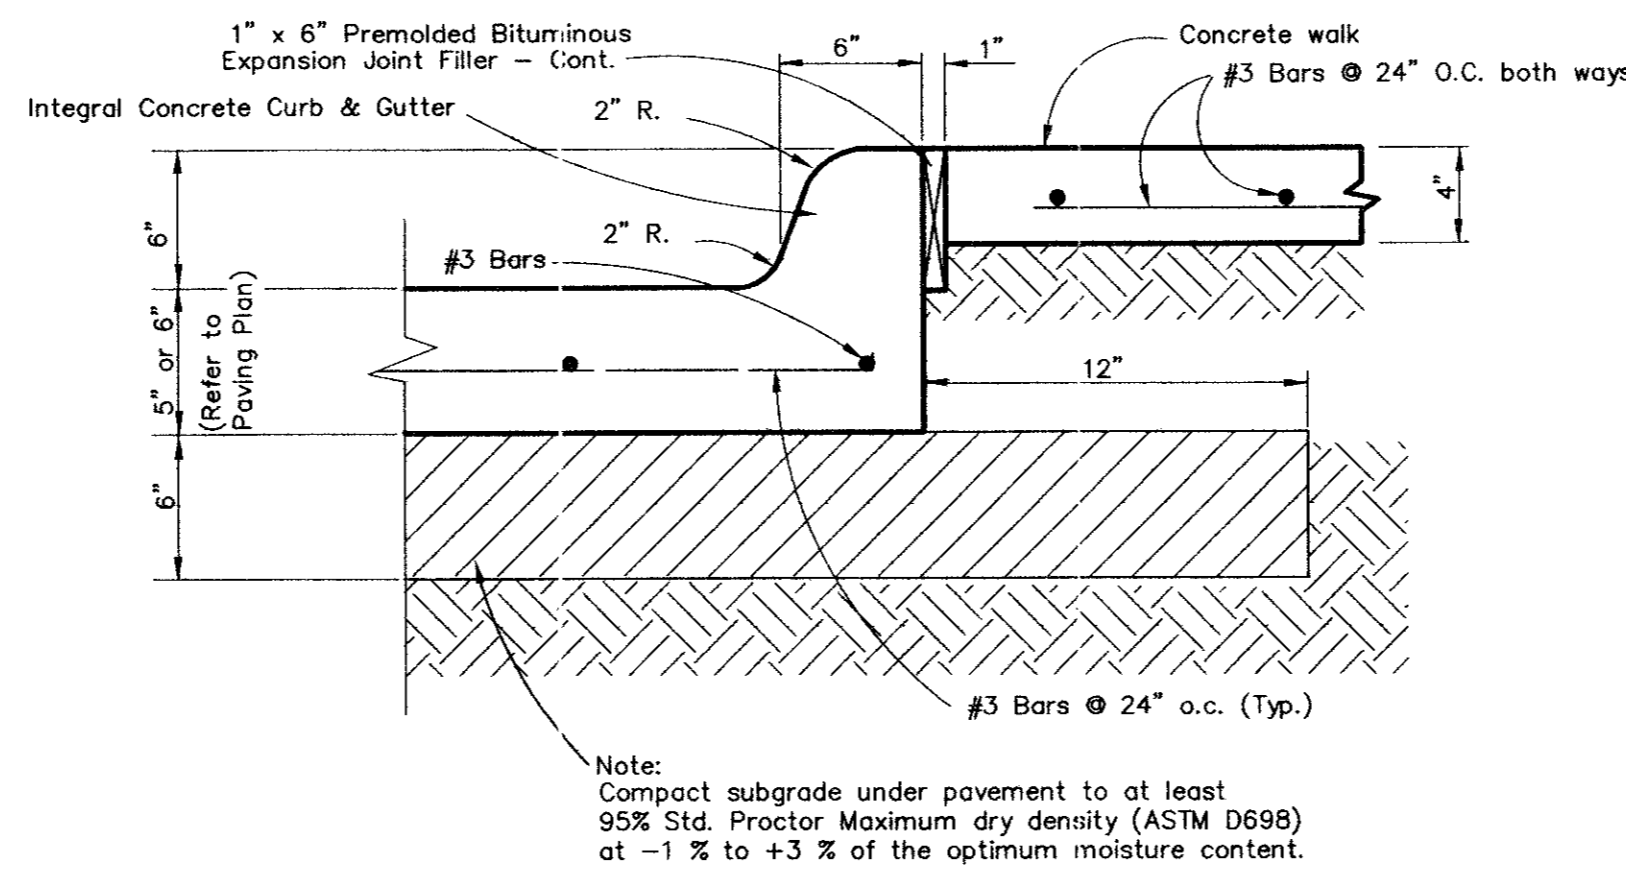


CURB DETAIL w/ WALK (ON-SITE)
N.T.S.

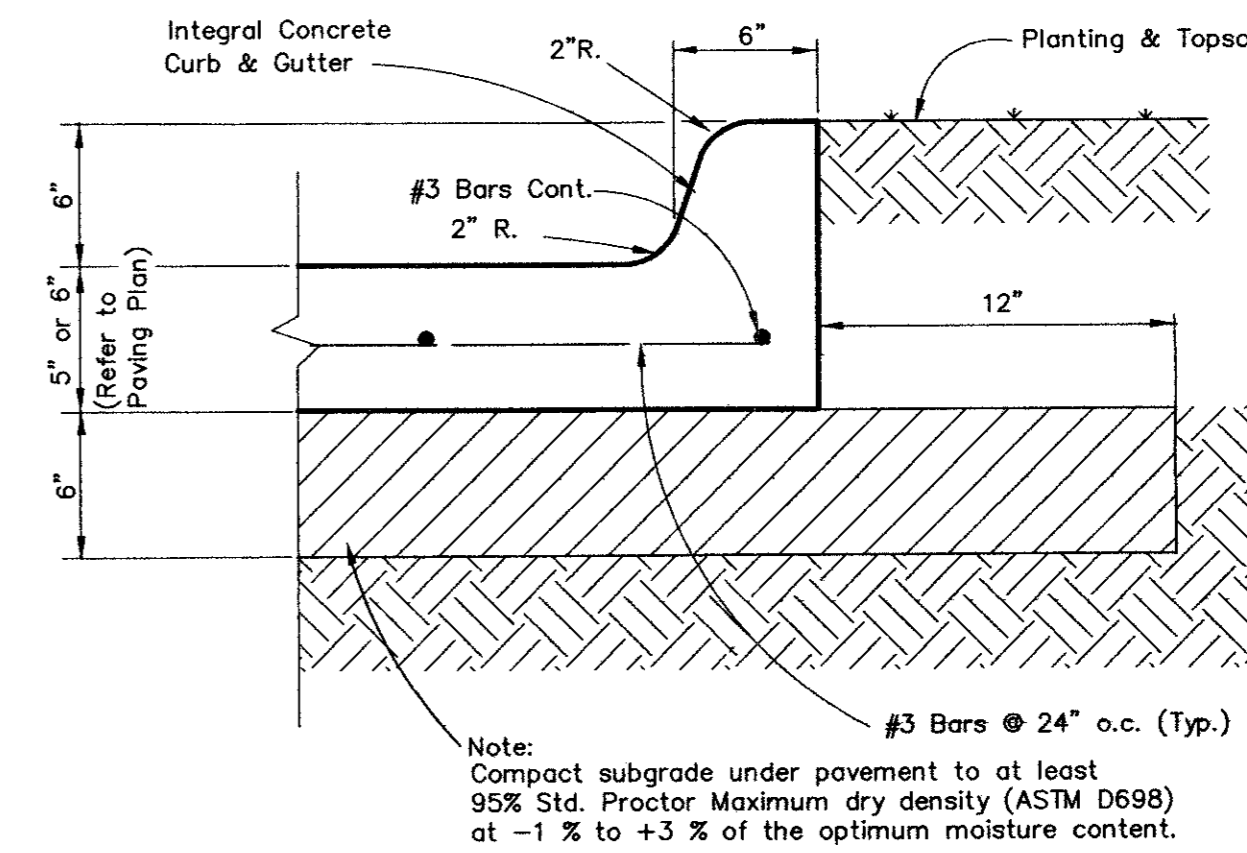

CURB DETAIL (ON-SITE)
N.T.S.

NO.	REVISIONS DURING CONSTRUCTION	BY	DATE	NO.	REVISIONS DURING PLAN REVIEW	BY	DATE

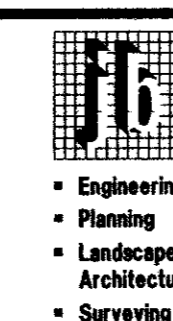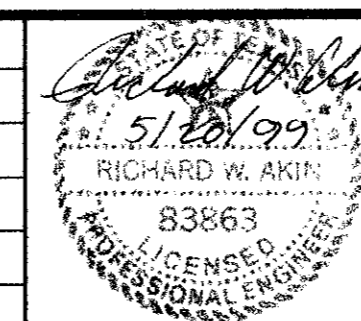

Jones & Boyd, Inc.
16800 Dallas Parkway, Suite 240
Dallas, Texas 75248
Tel: 972-248-7676
Fax: 972-248-1414



PAVING DETAILS
SUITES OF AMERICA
TOWN OF ADDISON,
DALLAS COUNTY, TEXAS

PROJECT NO.
BG403
SHEET NO.
C2

Handwritten signature and date: 5/21/00

Delta=07'18"58"
Radius=1223.09'
Arc=156.18'
Tangent=78.20'
Chd.=N 11'03"01" E

GRAPHIC SCALE

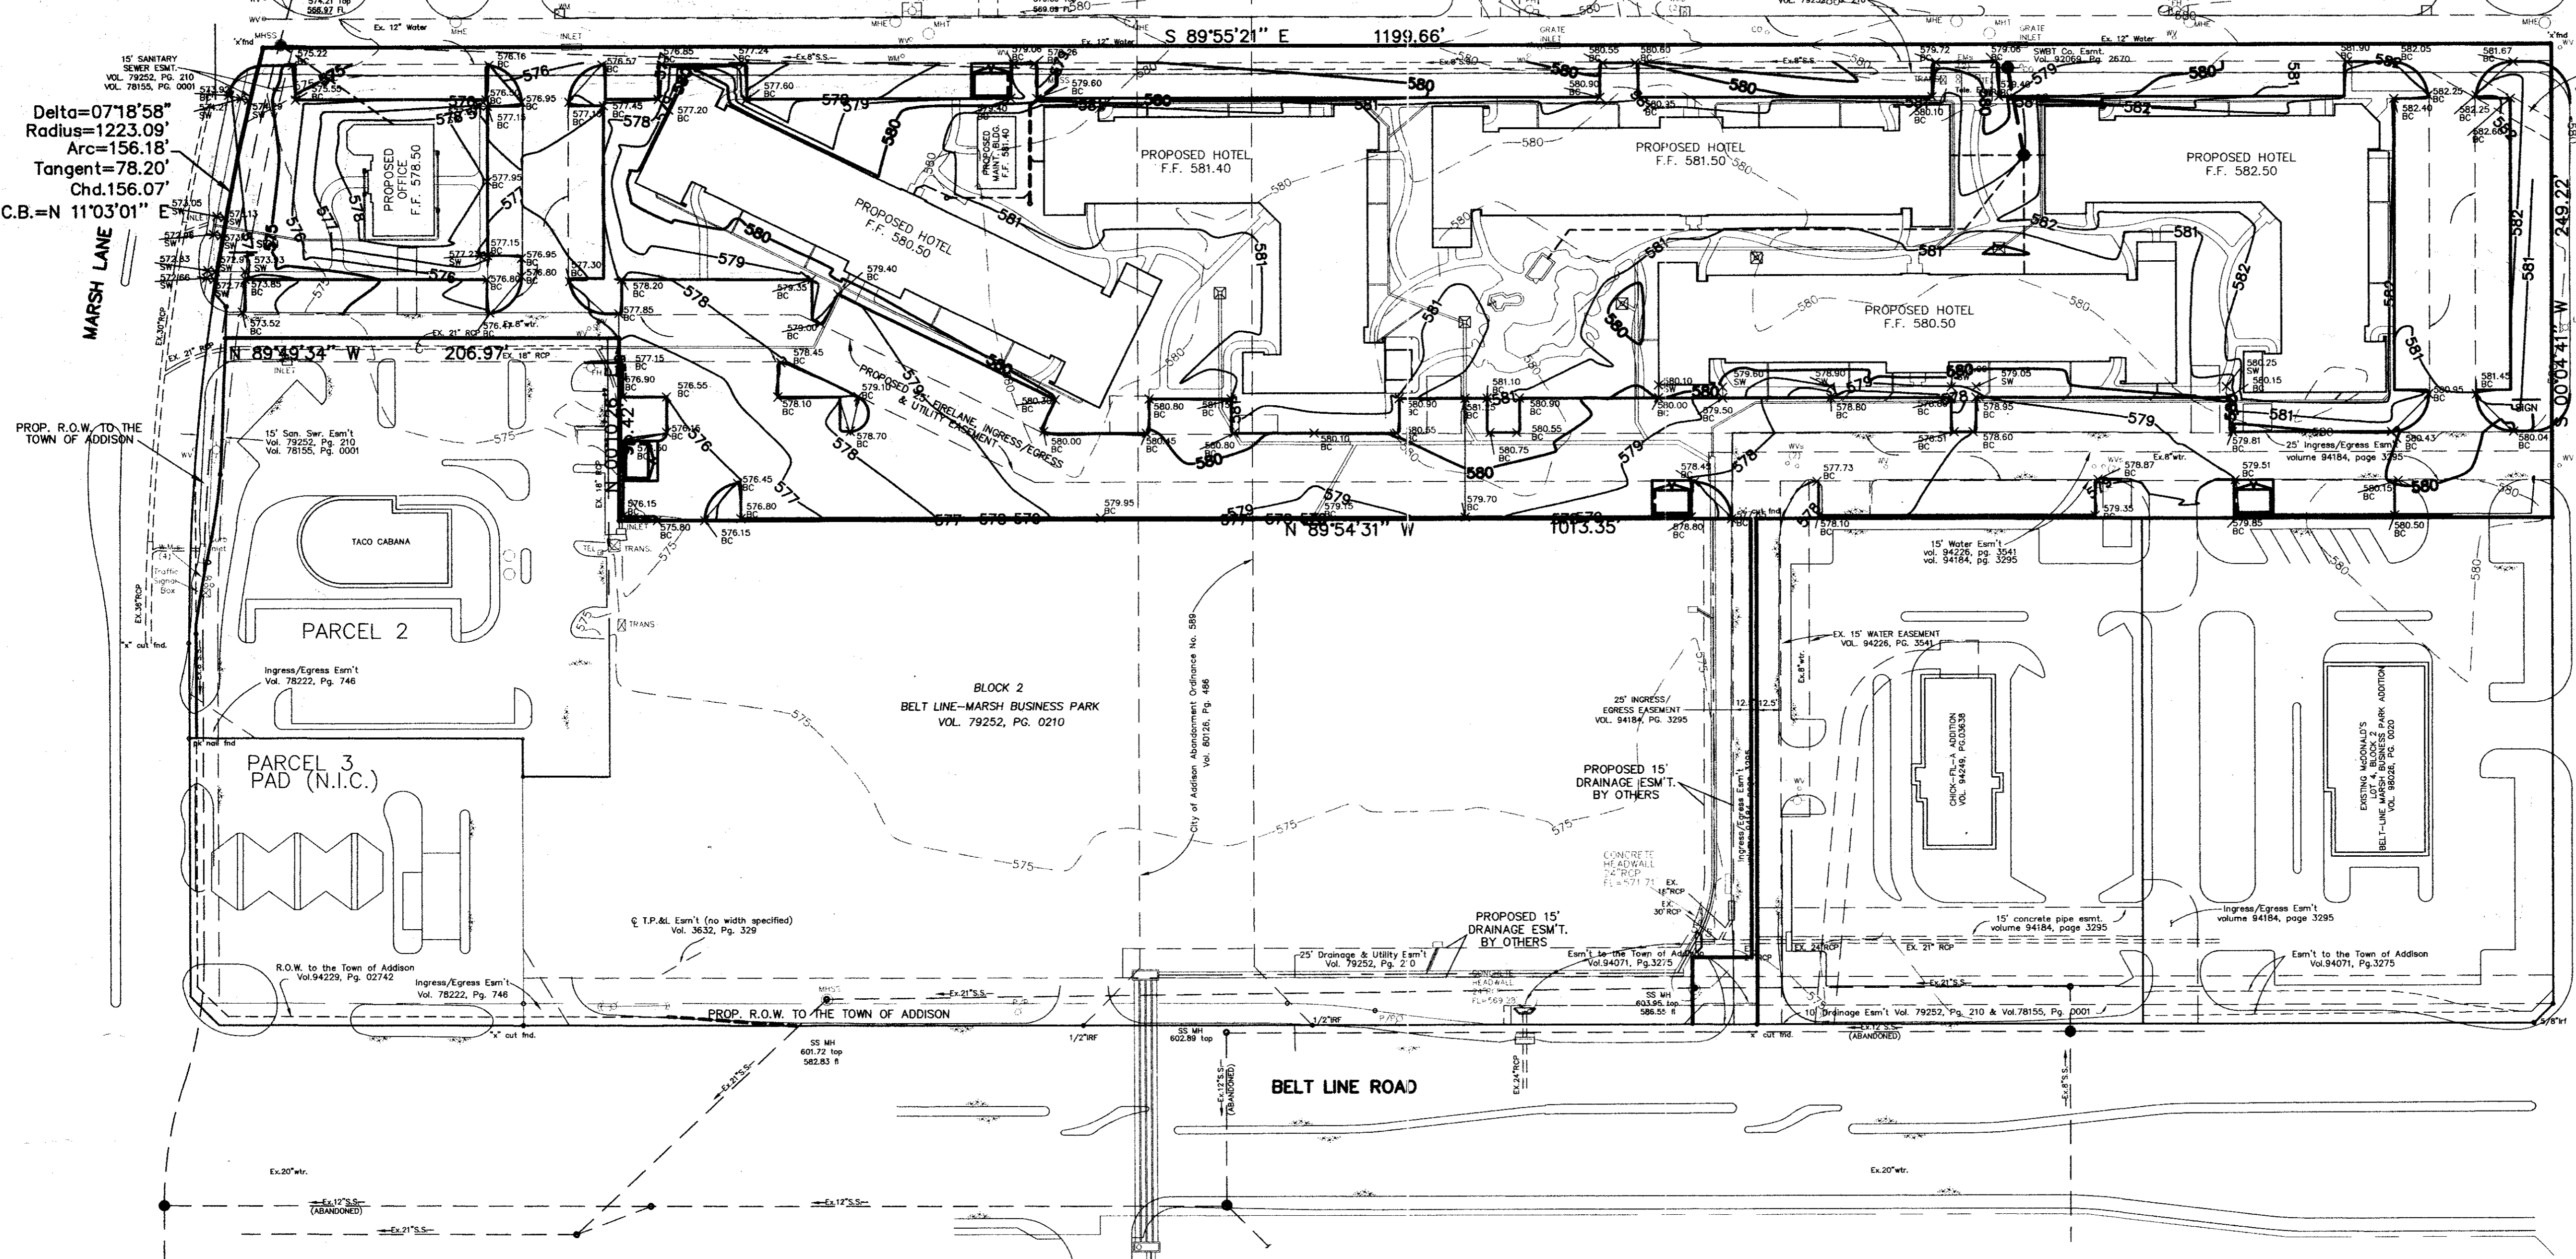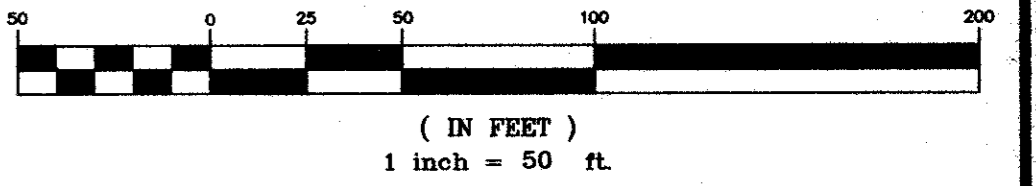

EARTHWORK NOTES

- Site Preparation**
Prior to and in conjunction with the compacting operation, each layer should be brought to the proper moisture content as determined by ASTM D 698, within plus or minus three (3) percentage points of optimum for fill containing limestone rock pieces and between optimum and the percentage points above the optimum for clayey soils.
- Compacting Area to be Filled**
All areas to be filled should be disc or blade until uniform and free from large clods, brought to a moisture content between optimum and five (5) percentage points above the optimum moisture value for clayey soils and between optimum to +3 percentage points for silty clay soils and soil containing limestone fragments and compacted to between 95 and 100 percent of optimum density in accordance with ASTM D 698.
- Fill Materials**
Off-site materials to be used for fill should be approved by the Soils Engineer. There should be no roots, vegetation or any other undesirable matter in the soil, and no rocks larger than six (6) inches in diameter.
- Depth of Mixing of Fill Layers**
The fill material should be placed in level, uniform layers, which, when compacted, should have a moisture content and density conforming to the stipulations called for herein. Each layer should be thoroughly mixed during the spreading to insure the uniformity of the layer. The fill thickness should not exceed 10-inch loose lifts.
- Rock**
There should be no rock incorporated within the fill which exceeds six (6) inches in its greatest dimension, and no large rocks will be permitted within twelve (12) inches of the finished subgrade.
- Moisture Content**
Prior to and in conjunction with the compacting operation, each layer should be brought to the proper moisture content as determined by ASTM D 698, within plus or minus three (3) percentage points of optimum for fill containing limestone rock pieces and between optimum and the percentage points above the optimum for clayey soils.
- Amount of compaction**
After each layer has been properly placed, mixed and spread, it should be thoroughly compacted to between 95 and 100 percent of Standard Proctor Density as determined by ASTM D 698.
- Compaction of Fill Layers**
Compaction equipment should be of such design that it will be able to compact the fill to the specified density. Compaction of each layer shall be continuous over its entire area.
- Density Tests**
Field Density tests should be made by the Soils Engineer or his representative. Density tests should be taken in the compacted material below the disturbed surface. After each layer of fill, compaction tests, as necessary, should be made by the Soils Engineer. If the materials fail to meet the density specified, the course should be reworked as necessary to obtain the specified compaction.
- Supervision**
Supervision by the Soils Engineer should be of such continuity during the grading operation that he can certify that all cut and filled areas were graded in accordance with the accepted specifications.
- Slope Control**
Embankment slopes should not be steeper than a ratio of three (3) horizontal to one (1) vertical for either fill or cut slopes. Any slope, existing or proposed, steeper than three (3) feet in height should incorporate stabilization methods to include erosion control, embankment stabilization and other slope control measures as required by the slope control specialist.
- Reports**
The Soils Engineer shall send one (1) copy of each test, inspection or evaluation report to the Engineer, Owner, City and Contractor.
- The Owner's Engineer shall provide one-time, initial survey staking for each of the following:**
A. Street and alley excavation, including rough cut stakes every 1000 feet and lot grading, including rough cut stakes at the center of each lot. Also included is verification that the Earthwork Contractor has graded the streets and alleys within 0.1' and lots within 0.2' of the plan grades prior to utility construction. The Earthwork Contractor shall leave rough cut stakes in place until verified by the Engineer. Utility Contractor shall return street grades to within 0.1' of the Earthwork Contractor's rough grade prior to street paving.
B. Street paving construction, including stakes offset along the paving every 50 feet.
C. Pads FHA grading to be graded by Earthwork Contractor after street paving is complete, including two stakes set on each property line with grades to finish pad elevation and offset corner of pad.

RECORD DRAWING
THIS DRAWING HAS BEEN REVISIONED TO REFLECT THE ACTUAL CONSTRUCTION EXCEPT AS CORRECTED IN THE RECORDS OF THIS CONTRACTOR. ELEVATIONS SHOWN ON THIS PLAN WERE NOT FIELD VERIFIED.
DATE: 2/11/00

- LEGEND**
- IRF IRON ROD FOUND
 - POWER POLE
 - CONCRETE LIGHT POLE BASE
 - RCP REINFORCED CONCRETE PIPE
 - FH FIRE HYDRANT
 - FL FLOWLINE
 - Denotes CONCRETE PAVEMENT
 - CONCRETE HEADWALL
 - CI CURB INLET
 - Proposed TOP OF CURB ELEVATION
 - Proposed TOP OF PAVEMENT ELEVATION


- BENCHMARK :**
- SQUARE CUT ON TOP OF CURB INLET AT NORTHEAST CORNER OF INTERSECTION OF BUSINESS AVE. AND BELTLINE ROAD. ELEVATION = 577.57'
 - "X" AT INLET ON TOP OF CURB WEST SIDE OF BUSINESS AVE. 200' +/- NORTH OF BELTLINE ROAD. ELEVATION = 578.57'

NO.	REVISIONS DURING CONSTRUCTION	BY	DATE	NO.	REVISIONS DURING PLAN REVIEW	BY	DATE
				1	ADDED MAINTENANCE BLDG.	RWA	5/25/99


Jones & Boyd, Inc.
18800 Dallas Parkway, Suite 240
Dallas, Texas 75248
Tel: 972-248-7676
Fax: 972-248-1414

Engineering • Planning • Landscape • Surveying
Architecture

GRADING PLAN	PROJECT NO.
SUITES OF AMERICA	BG403
TOWN OF ADDISON, DALLAS COUNTY, TEXAS	SHEET NO.
	C3

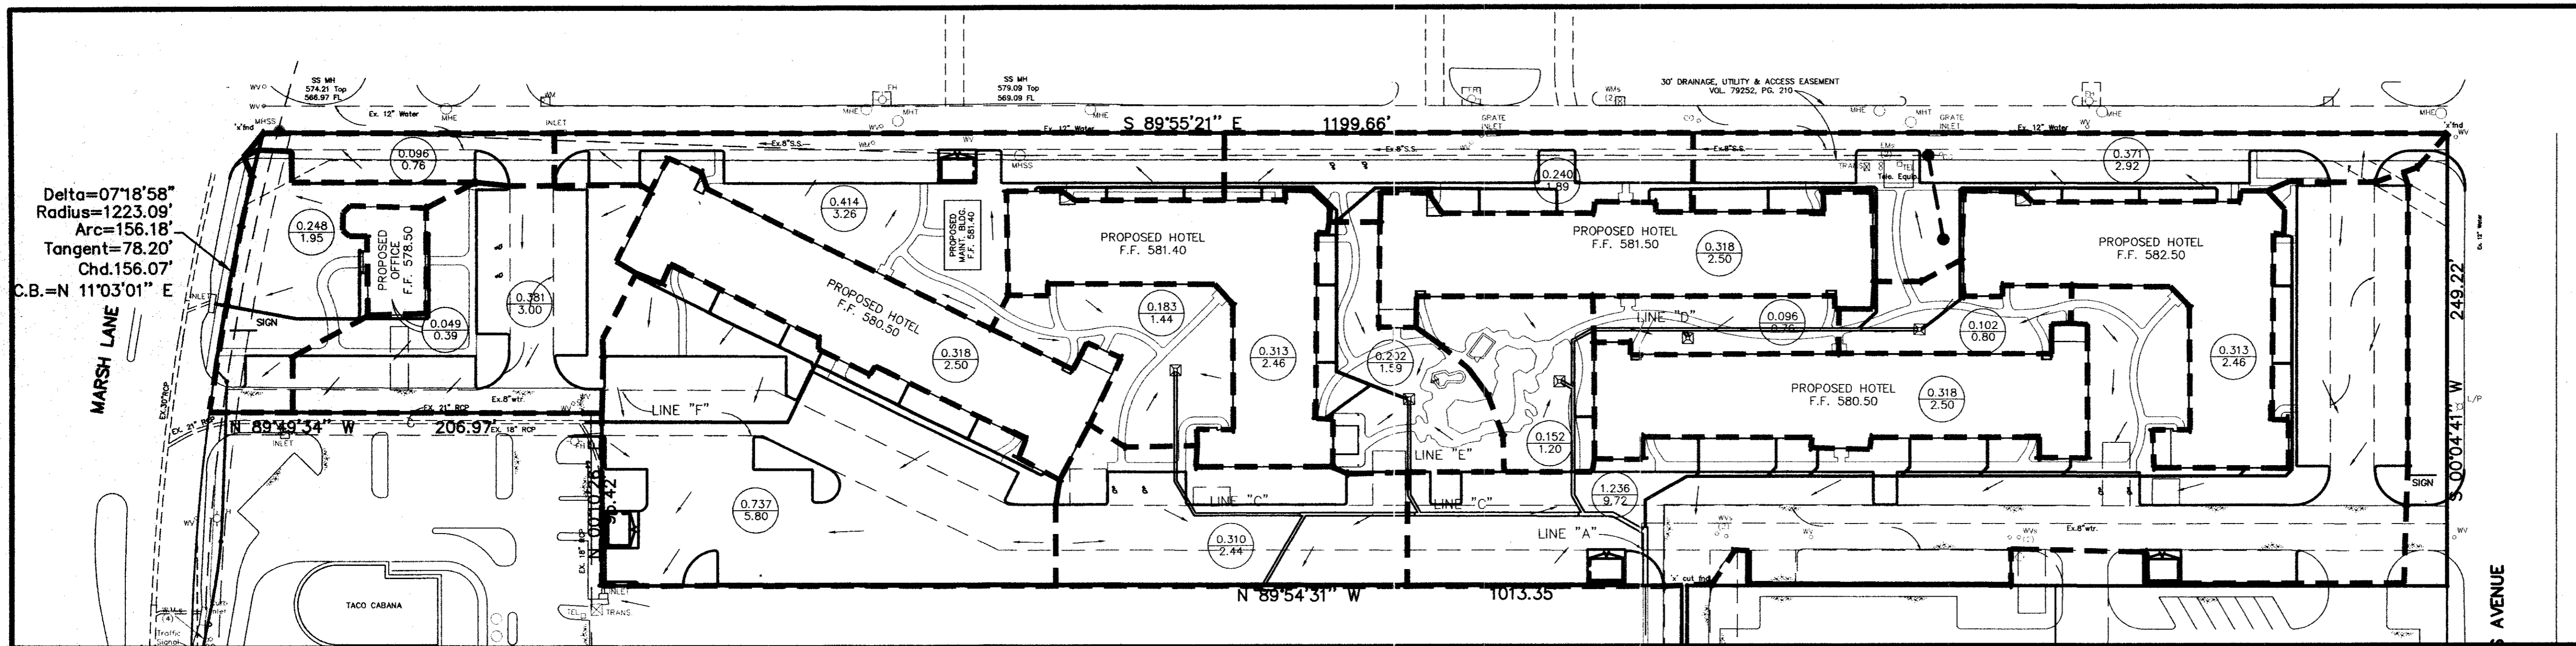

Delta=07'18"58"
 Radius=1223.09'
 Arc=156.18'
 Tangent=78.20'
 Chd.156.07'
 C.B.=N 11°03'01" E

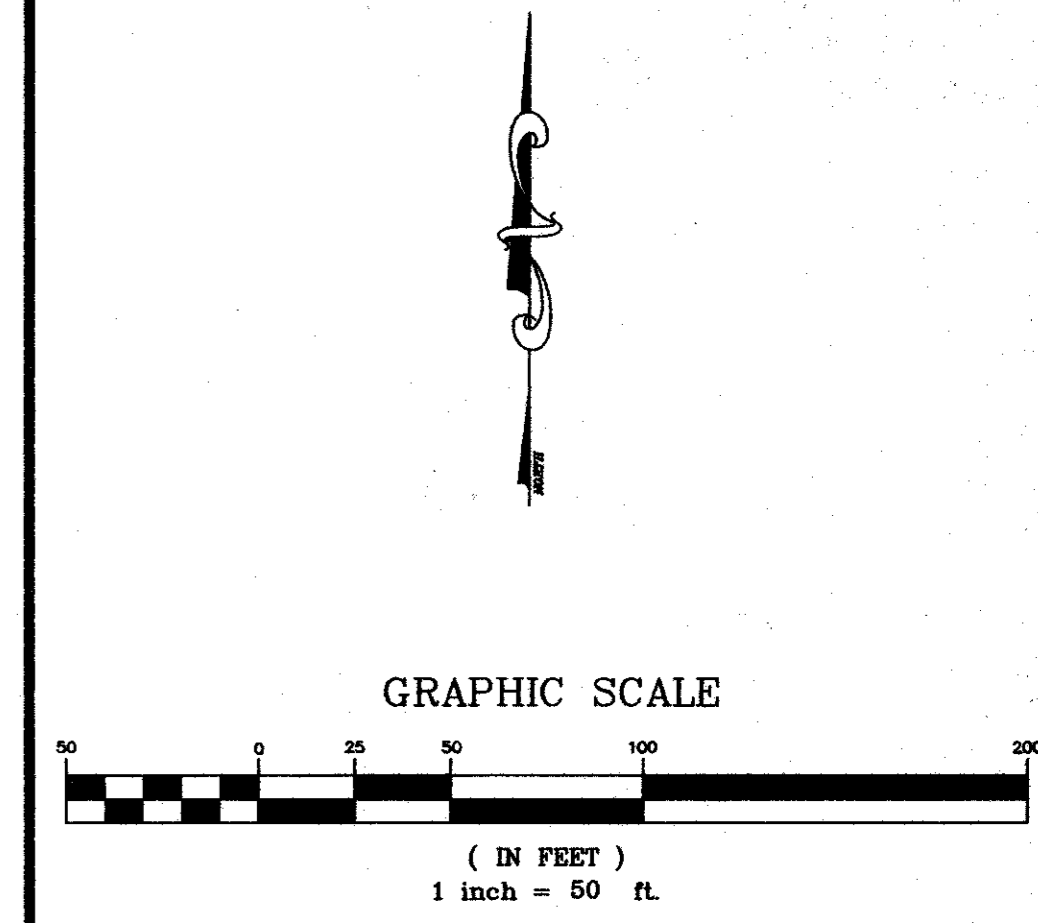

DRAINAGE AREA MAP

SCALE: 1" = 50'

LEGEND

Drainage Design Theory

Rational Method
 Q = CIA
 Q ~ Flow in c.f.s.
 I ~ Intensity (8.74 in./hr. for T=10 Min.)
 A ~ Area in Acres
 C ~ Coefficient of runoff (0.90)

0.313
2.46
DRAINAGE AREA IN ACRES
FLOW (c.f.s.)
DRAINAGE AREA DIVIDE
PROPOSED EASEMENT

UPSTREAM STATION	DNSTREAM STATION	DISTANCE "L"	AREA "A" NO.	AREA "A" (ACRES)	RUNOFF COEF. "C"	INCREM. "CA"	ACCUM. "CA"	TIME AT UPSTREAM STATION (MIN)	STORM FREQUENCY (YEARS)	INTENSITY "I" (IN/HR)	RUNOFF "Q" (CFS)	SLOPE HYDRAULIC GRADIENT "S" (FT/FT)	STORM SEWER SIZE (IN)	VELOCITY "V" (FPS)	"L" x "S"	Kj	PIPE CHANGE & BEND LOSSES	INLET LOSSES
Line "A"																		
50.42	47.42	3	0	0.90	0.00	0.00	10.00	100	8.74	0.0	0.0000	21	0.00	0.00	1.00	0.46	0.00	
47.42	32.24	15	1.658	0.90	1.49	1.49	10.00	100	8.74	13.0	0.0067	21	5.42	0.10	1.00	-0.17	0.46	
32.24	29.24	3	0.00	0.90	0.00	1.49	10.05	100	8.73	13.0	0.0010	30	2.85	0.00	1.00	0.39	0.11	
29.24	0.00	29	1.89	0.90	1.70	3.19	10.07	100	8.73	27.8	0.0046	30	5.67	0.13	1.00	-0.25	0.50	

UPSTREAM STATION	DNSTREAM STATION	DISTANCE "L"	AREA "A" NO.	AREA "A" (ACRES)	RUNOFF COEF. "C"	INCREM. "CA"	ACCUM. "CA"	TIME AT UPSTREAM STATION (MIN)	STORM FREQUENCY (YEARS)	INTENSITY "I" (IN/HR)	RUNOFF "Q" (CFS)	SLOPE HYDRAULIC GRADIENT "S" (FT/FT)	STORM SEWER SIZE (IN)	VELOCITY "V" (FPS)	"L" x "S"	Kj	PIPE CHANGE & BEND LOSSES	INLET LOSSES
Line "B" NOT USED																		

UPSTREAM STATION	DNSTREAM STATION	DISTANCE "L"	AREA "A" NO.	AREA "A" (ACRES)	RUNOFF COEF. "C"	INCREM. "CA"	ACCUM. "CA"	TIME AT UPSTREAM STATION (MIN)	STORM FREQUENCY (YEARS)	INTENSITY "I" (IN/HR)	RUNOFF "Q" (CFS)	SLOPE HYDRAULIC GRADIENT "S" (FT/FT)	STORM SEWER SIZE (IN)	VELOCITY "V" (FPS)	"L" x "S"	Kj	PIPE CHANGE & BEND LOSSES	INLET LOSSES
Line "C"																		
331.93	192.51	139	0.183	0.90	0.16	0.16	10.00	100	8.74	1.4	0.0002	18	0.81	0.03	1.00	0.00	0.01	
192.51	189.51	3	0	0.90	0.00	0.16	12.85	100	8.10	1.3	0.0001	21	0.55	0.00	1.00	0.03	0.00	
189.51	129.26	60	0.31	0.90	0.28	0.44	12.94	100	8.08	3.6	0.0005	21	1.49	0.03	1.00	-0.0	0.03	
129.26	126.26	3	0	0.90	0.00	0.44	13.62	100	7.93	3.5	0.0002	24	1.12	0.00	1.00	0.09	0.02	
126.26	39.39	87	0.67	0.90	0.60	1.05	13.66	100	7.92	8.3	0.0013	24	2.64	0.12	1.00	-0.07	0.11	
39.39	36.39	3	0	0.90	0.00	1.05	14.21	100	7.80	8.2	0.0007	27	2.05	0.00	1.00	0.11	0.07	
36.39	0	36	0.719	0.90	0.65	1.69	14.23	100	7.79	13.2	0.0018	27	3.32	0.07	1.00	-0.07	0.17	

UPSTREAM STATION	DNSTREAM STATION	DISTANCE "L"	AREA "A" NO.	AREA "A" (ACRES)	RUNOFF COEF. "C"	INCREM. "CA"	ACCUM. "CA"	TIME AT UPSTREAM STATION (MIN)	STORM FREQUENCY (YEARS)	INTENSITY "I" (IN/HR)	RUNOFF "Q" (CFS)	SLOPE HYDRAULIC GRADIENT "S" (FT/FT)	STORM SEWER SIZE (IN)	VELOCITY "V" (FPS)	"L" x "S"	Kj	PIPE CHANGE & BEND LOSSES	INLET LOSSES
Line "D"																		
287.86	256	32	0.259	0.90	0.23	0.23	10.00	100	8.74	2.0	0.0004	18	1.15	0.01	1.00	0.03	0.02	
256	159.5	97	0.159	0.90	0.14	0.38	10.46	100	8.64	3.2	0.0010	18	1.84	0.09	1.00	0.02	0.05	
159.5	66.56	93	0.096	0.90	0.09	0.46	11.34	100	8.44	3.9	0.0014	18	2.21	0.13	1.00	-0.02	0.08	
66.56	63.56	3	0	0.90	0.00	0.46	12.04	100	8.28	3.8	0.0006	21	1.59	0.00	1.00	0.03	0.04	
63.56	53.38	10	0.152	0.90	0.14	0.60	12.07	100	8.28	5.0	0.0010	21	2.06	0.01	1.00	-0.03	0.07	
53.38	0	53	0.053	0.90	0.05	0.65	12.15	100	8.26	5.3	0.0011	21	2.22	0.06	1.00	-0.04	0.08	



UPSTREAM STATION	DNSTREAM STATION	DISTANCE "L"	AREA "A" NO.	AREA "A" (ACRES)	RUNOFF COEF. "C"	INCREM. "CA"	ACCUM. "CA"	TIME AT UPSTREAM STATION (MIN)	STORM FREQUENCY (YEARS)	INTENSITY "I" (IN/HR)	RUNOFF "Q" (CFS)	SLOPE HYDRAULIC GRADIENT "S" (FT/FT)	STORM SEWER SIZE (IN)	VELOCITY "V" (FPS)	"L" x "S"	Kj	PIPE CHANGE & BEND LOSSES	INLET LOSSES
Line "E"																		
65.05	0	65	0.674	0.90	0.61	0.61	10.00	100	8.74	5.3	0.0011	21	2.20	0.07	1.00	-0.04	0.08	

UPSTREAM STATION	DNSTREAM STATION	DISTANCE "L"	AREA "A" NO.	AREA "A" (ACRES)	RUNOFF COEF. "C"	INCREM. "CA"	ACCUM. "CA"	TIME AT UPSTREAM STATION (MIN)	STORM FREQUENCY (YEARS)	INTENSITY "I" (IN/HR)	RUNOFF "Q" (CFS)	SLOPE HYDRAULIC GRADIENT "S" (FT/FT)	STORM SEWER SIZE (IN)	VELOCITY "V" (FPS)	"L" x "S"	Kj	PIPE CHANGE & BEND LOSSES	INLET LOSSES
Line "F" NOT USED																		

RECORD DRAWING
 THIS DRAWING HAS BEEN REVISED TO REFLECT THE ACTUAL CONSTRUCTION DETAILS AS CONTAINED IN THE RECORDS OF THE CONTRACTOR. ELEVATIONS SHOWN ON THIS PLAN WERE NOT FIELD VERIFIED.
 JONES BY: [Signature] DATE: 2/1/00

- BENCHMARK :**
- SQUARE CUT ON TOP OF CURB INLET AT NORTHEAST CORNER OF INTERSECTION OF BUSINESS AVE. AND BELTLINE ROAD. ELEVATION = 577.59'
 - "X" AT INLET ON TOP OF CURB WEST SIDE OF BUSINESS AVE. 200' +/- NORTH OF BELTLINE ROAD. ELEVATION = 578.57'

NO.	REVISIONS DURING CONSTRUCTION	BY	DATE	NO.	REVISIONS DURING PLAN REVIEW	BY	DATE
1	ADDED MAINTENANCE BLDG.						

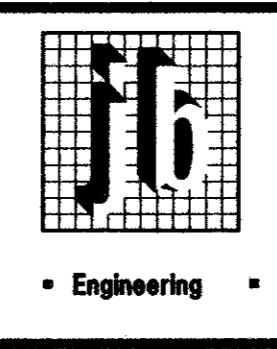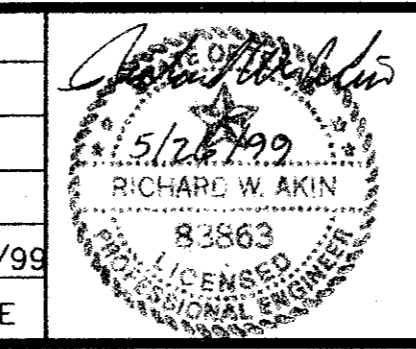



Jones & Boyd, Inc.
 16800 Dallas Parkway, Suite 280
 Dallas, Texas 75248
 Tel: 972-248-7878
 Fax: 972-248-1414
 Engineering Planning Landscape Surveying Architecture

DRAINAGE PLAN
 SUITES OF AMERICA
 TOWN OF ADDISON,
 DALLAS COUNTY, TEXAS

PROJECT NO.
BG403
 SHEET NO.
C4

BLOCK 2
BELT LINE-MARSH BUSINESS PARK
VOL. 79252, PG. 0210

GRAPHIC SCALE

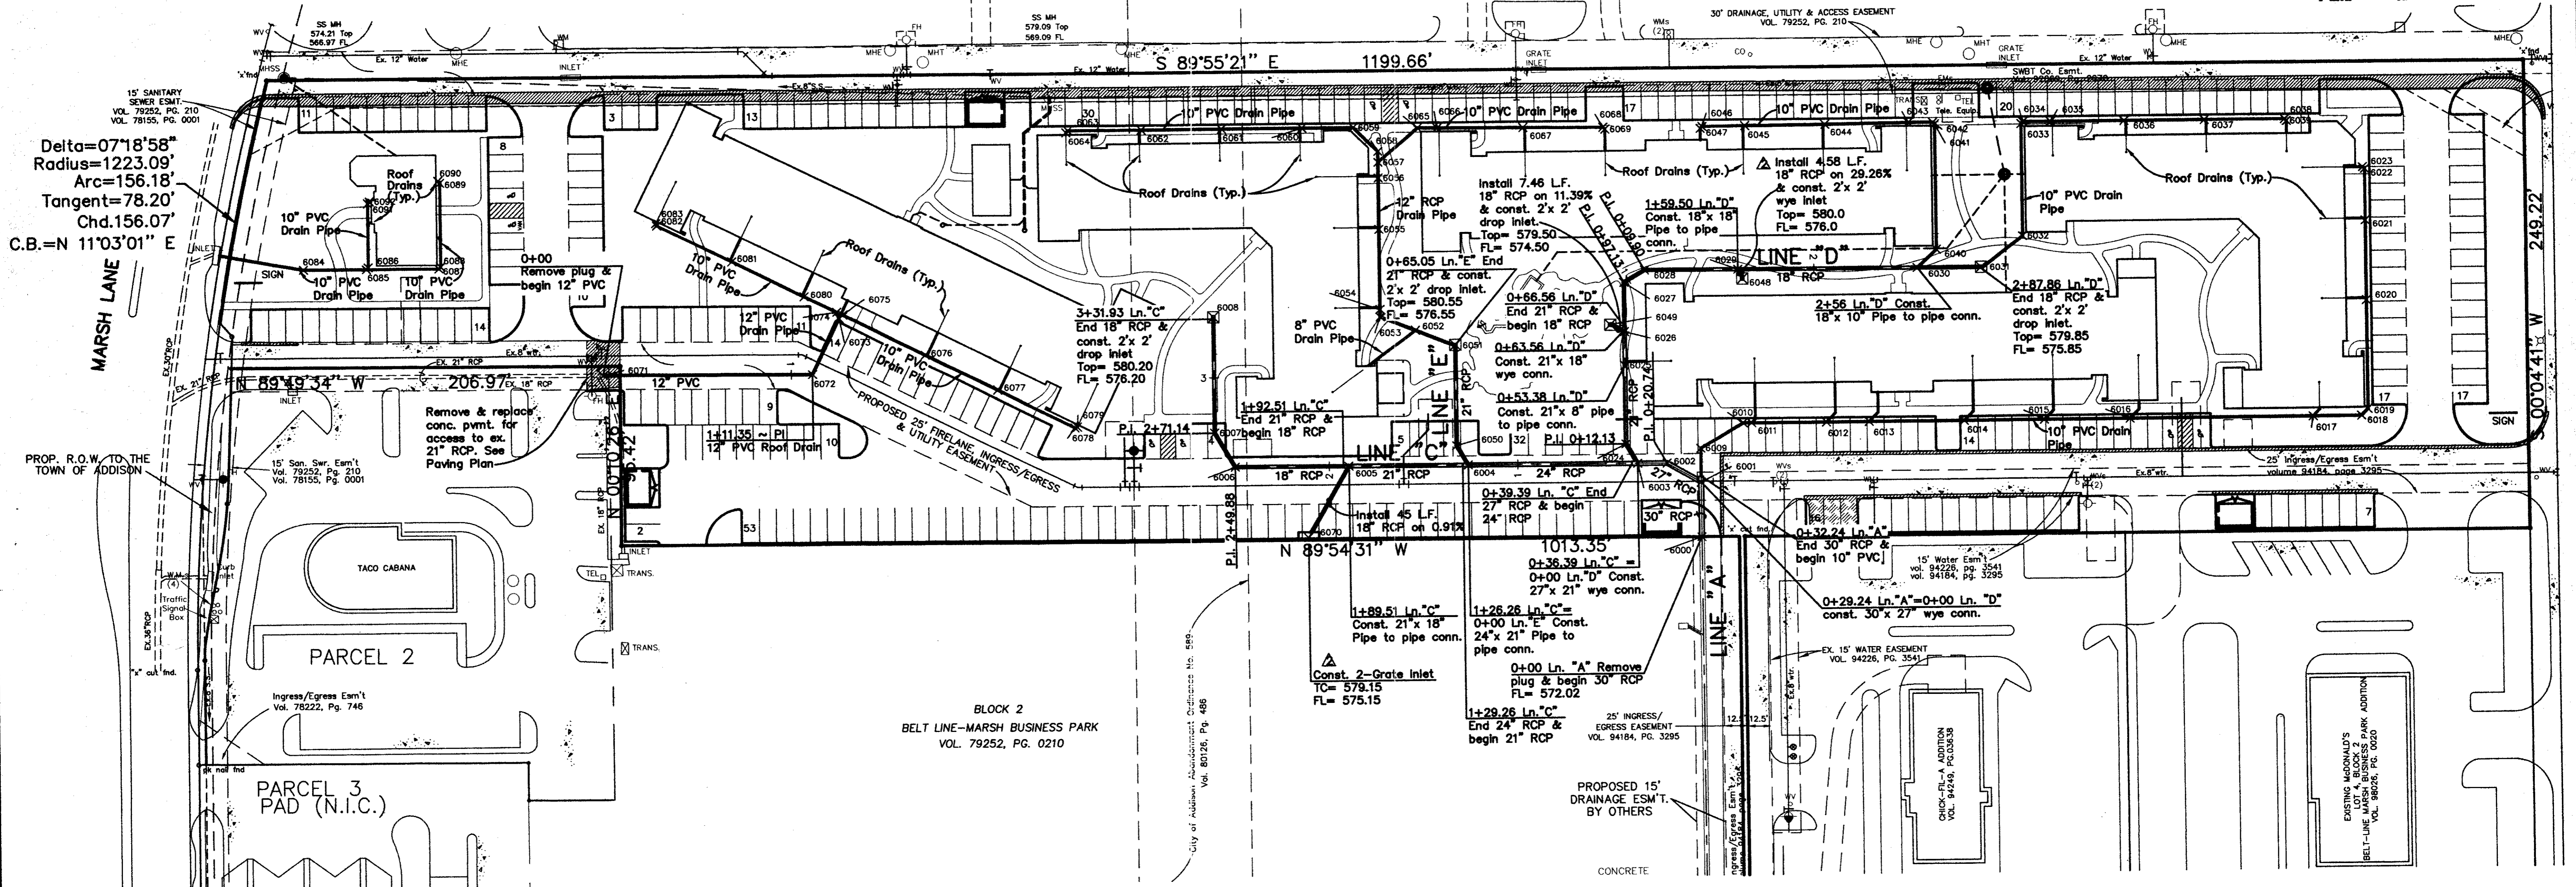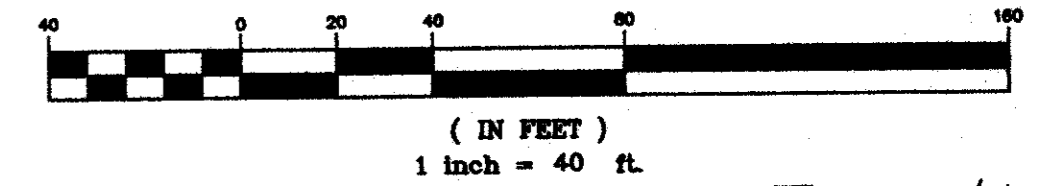

Delta=07°18'58"
Radius=1223.09'
Arc=156.18'
Tangent=78.20'
Chd.156.07'
C.B.=N 11°03'01" E

STORM SEWER COORDINATE POINTS

POINT #	NORTHING	EASTING	POINT #	NORTHING	EASTING	POINT #	NORTHING	EASTING	POINT #	NORTHING	EASTING
6000	4751.47055491	4559.86852258	6025	4842.89252300	4520.27629933	6050	4801.76272912	4430.34376646	6075	4873.67813265	4105.38142855
6001	4780.71348213	4559.86852258	6026	4860.51816471	4520.30005487	6051	4854.68537748	4430.41509470	6076	4852.24873607	4148.97370944
6002	4791.11807222	4541.92552166	6027	4886.64179796	4520.33526385	6052	4862.49656808	4409.36581691	6077	4833.46248314	4187.18897332
6003	4791.13289606	4526.27846331	6028	4893.02165690	4531.40272110	6053	4869.77476552	4390.68136802	6078	4813.37111870	4228.05929176
6004	4791.25403065	4436.40152774	6029	4892.95480954	4581.00073896	6054	4873.77476552	4390.68137866	6079	4813.82738052	4229.39785249
6005	4791.33927749	4373.15184252	6030	4892.82629032	4676.35677399	6055	4916.35809886	4390.68149200	6080	4883.71846701	4084.95716305
6006	4791.42063596	4312.78717592	6031	4892.78046773	4710.35527009	6056	4943.84600957	4390.68156517	6081	4902.50471995	4046.74176068
6007	4809.84526783	4302.16625824	6032	4908.98356866	4732.66181469	6057	4952.30359750	4390.68158768	6082	4922.0631067	4006.95586232
6008	4870.62893047	4302.24818141	6033	4969.10856866	4732.66197472	6058	4958.23644231	4390.68160347	6083	4923.40160140	4006.49960050
6009	4798.89215012	4559.86852258	6034	4970.10856800	4733.66197738	6059	4971.06625341	4377.85186066	6084	4900.08318325	3818.539+1951
6010	4811.99117177	4582.59204411	6035	4970.10852670	4748.42630143	6060	4971.06632601	4350.57584078	6085	4900.08318325	3852.21913438
6011	4811.99115978	4587.09415707	6036	4970.10842271	4787.49531071	6061	4971.06643940	4307.97330428	6086	4901.08318325	3853.21913438
6012	4811.99105397	4626.84760280	6037	4970.10830937	4830.07864404	6062	4971.0665274	4265.38997095	6087	4900.08318325	3890.70371772
6013	4811.99099340	4649.60631399	6038	4970.10819598	4872.68118054	6063	4971.06665673	4226.32096167	6088	4901.08318325	3891.70371772
6014	4811.99085879	4700.18093614	6039	4969.10819332	4873.68117788	6064	4970.06665939	4225.32095901	6089	4946.0969068	3891.70371772
6015	4811.99074545	4742.76426947	6040	4902.34796193	4686.75313378	6065	4970.51536021	4411.87831521	6090	4947.0969068	3890.70371772
6016	4811.99062423	4788.30593614	6041	4969.51462859	4686.75312555	6066	4970.43189412	4422.37834656	6091	4935.45538542	3853.219+3438
6017	4811.99036542	4885.54376020	6042	4970.50686370	4685.75334536	6067	4970.06987760	4467.92001227	6092	4936.45538542	3854.21913438
6018	4811.99029888	4911.29376020	6043	4970.40591664	4672.75328475	6068	4969.73137725	4510.50334470			
6019	4815.48308391	4914.78656582	6044	4970.06166288	4628.41995050	6069	4968.72342838	4511.50331044			
6020	4872.81663017	4914.78681842	6045	4969.73099808	4585.83681629	6070	4753.30868284	4351.16068385			
6021	4915.39996350	4914.78683176	6046	4969.55427300	4583.07790463	6071	4842.90965676	3977.62829375			
6022	4942.88787422	4914.78690493	6047	4968.54650901	4562.07793212	6072	4842.57172410	4088.97557768			
6023	4943.88787888	4913.78890759	6048	4887.98728094	4583.28648189	6073	4871.87573141	4103.38109114			
6024	4801.64159453	4520.22070204	6049	4864.25150849	4512.84609719	6074	4875.22220824	4102.24043657			

LEGEND

	Exist. Water Line and Valve		Prop. Water Line and Valve
	Exist. Fire Hydrant		Prop. Fire Hydrant
	Exist. Sewer Line		Prop. Sewer Line
	Exist. Manhole		Prop. Manhole
	Exist. Storm Sewer		Prop. Cleanout
			Prop. Storm Sewer

RECORD DRAWING
THIS DRAWING HAS BEEN REVISED TO REFLECT THE LATEST CONSTRUCTION DEPARTMENT RECORDS OF THE COUNTY. ELEVATION STATION ON THIS DRAWING WERE NOT FIELD VERIFIED.
DATE: 2/1/00

- BENCHMARK :
- SQUARE CUT ON TOP OF CURB INLET AT NORTHEAST CORNER OF INTERSECTION OF BUSINESS AVE. AND BELTLINE ROAD. ELEVATION = 577.59'
 - "X" AT INLET ON TOP OF CURB WEST SIDE OF BUSINESS AVE. 200' +/- NORTH OF BELTLINE ROAD. ELEVATION = 578.57'

NO.	REVISIONS DURING CONSTRUCTION	BY	DATE	NO.	REVISIONS DURING PLAN REVIEW	BY	DATE
2	as-built - inlets	CBM	2/1/00				
1	ADDED COORDINATES	RWA	5/22/99	1	ADDED MAINTENANCE BLDG.	RWA	5/25/99

Jones & Boyd, Inc.
16800 Dallas Parkway, Suite 240
Dallas, Texas 75248
Tel: 972-248-7676
Fax: 972-248-1414

Engineering Planning Landscape Surveying Architecture

STORM SEWER PLAN


SUITES OF AMERICA

TOWN OF ADDISON,
DALLAS COUNTY, TEXAS


PROJECT NO. **BG403**
SHEET NO. **C5**

RWA BG403STM.dwg H:\Projects\BG403\CAD\BG403 6/22/99 9:47 am


0+00 LINE "A" 1+00

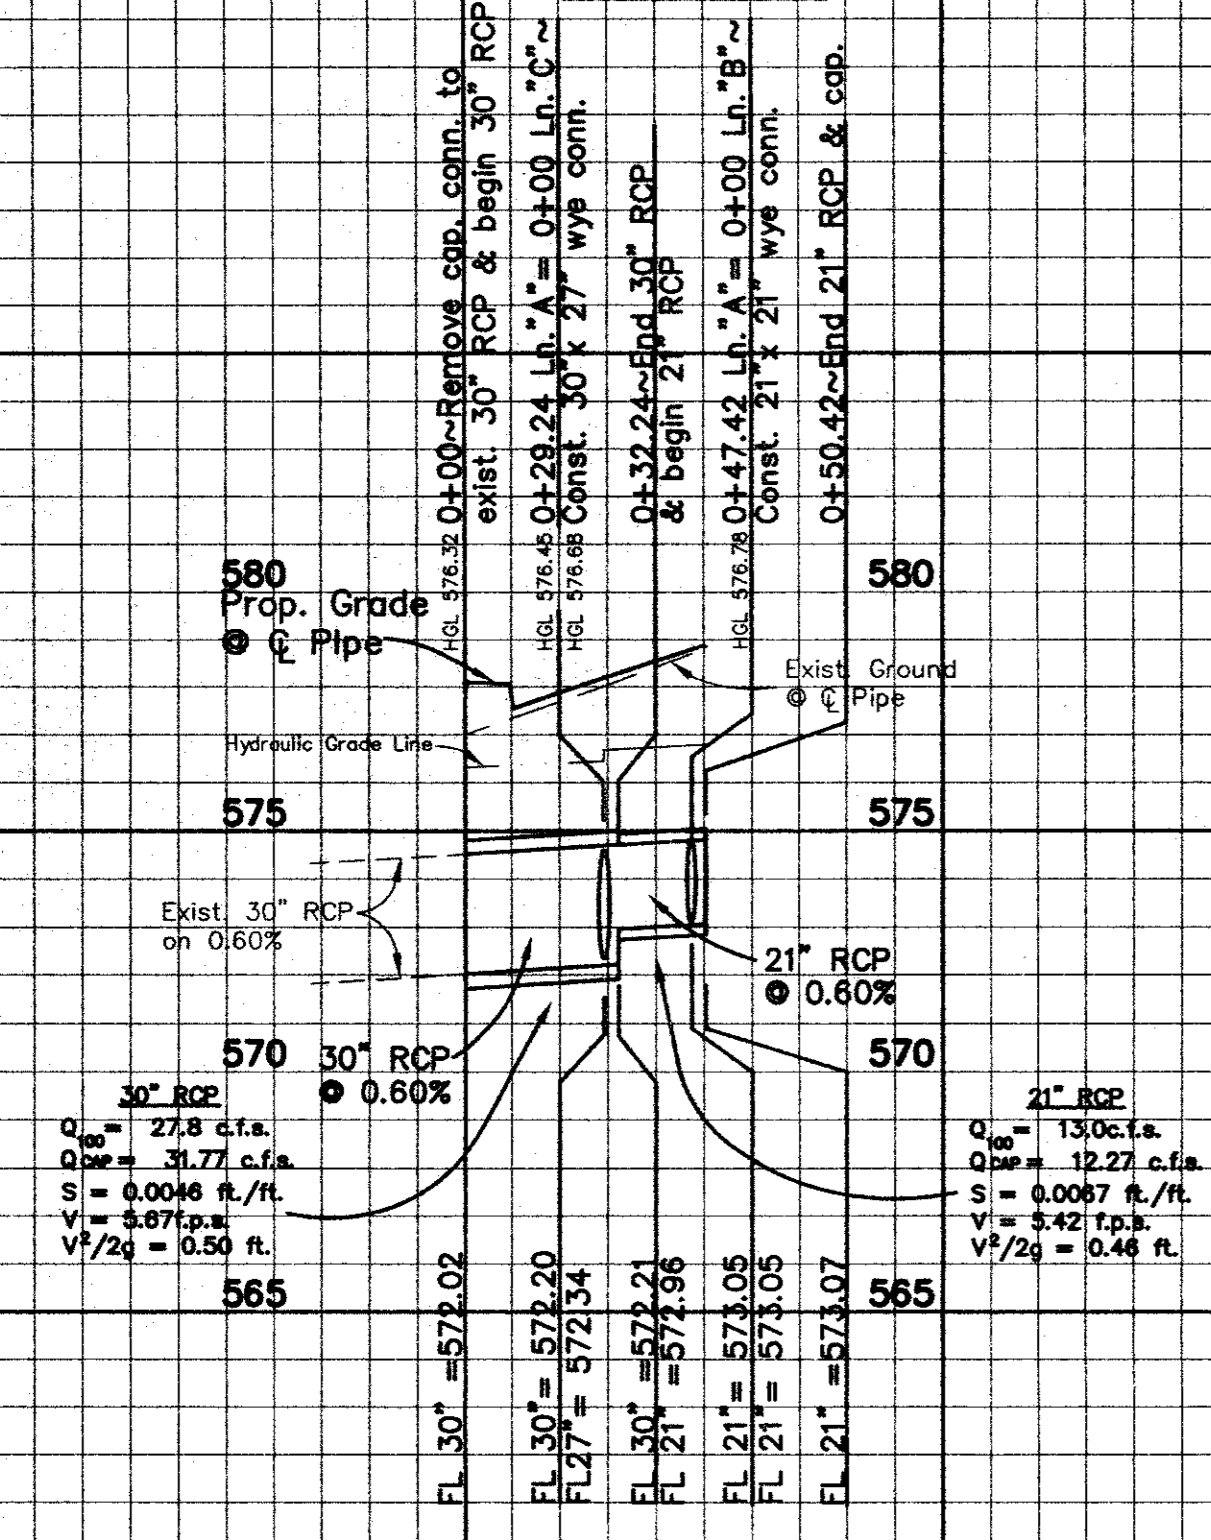


0+00 LINE "C" 1+00 2+00 3+00

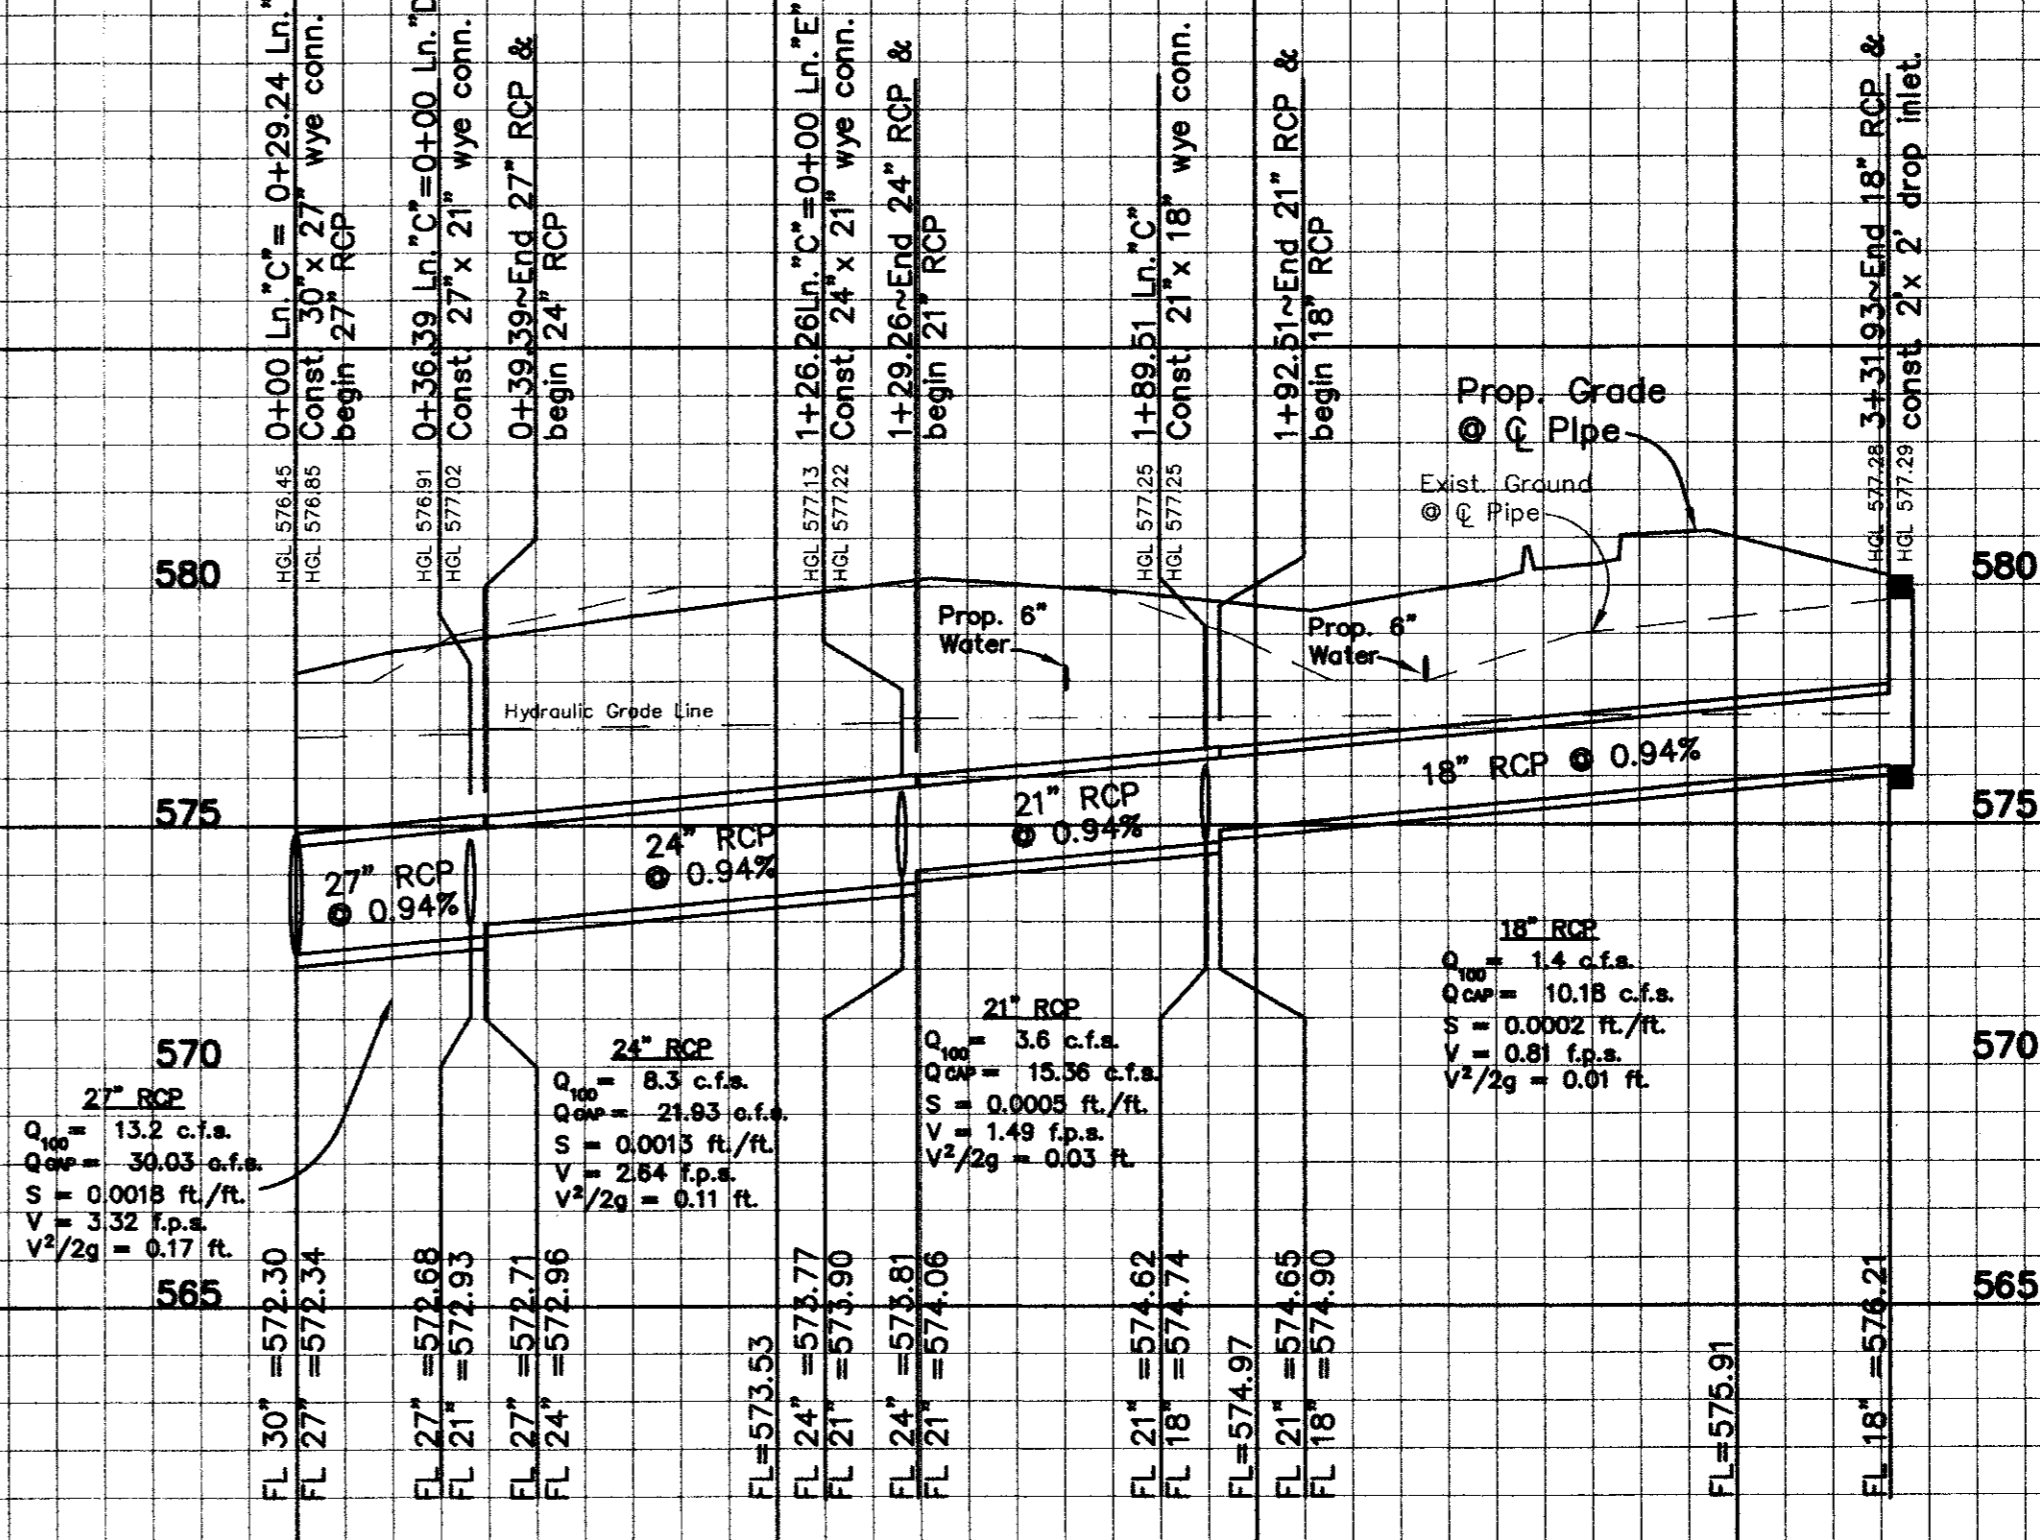

0+00 LINE "D" 1+00 2+00 3+00

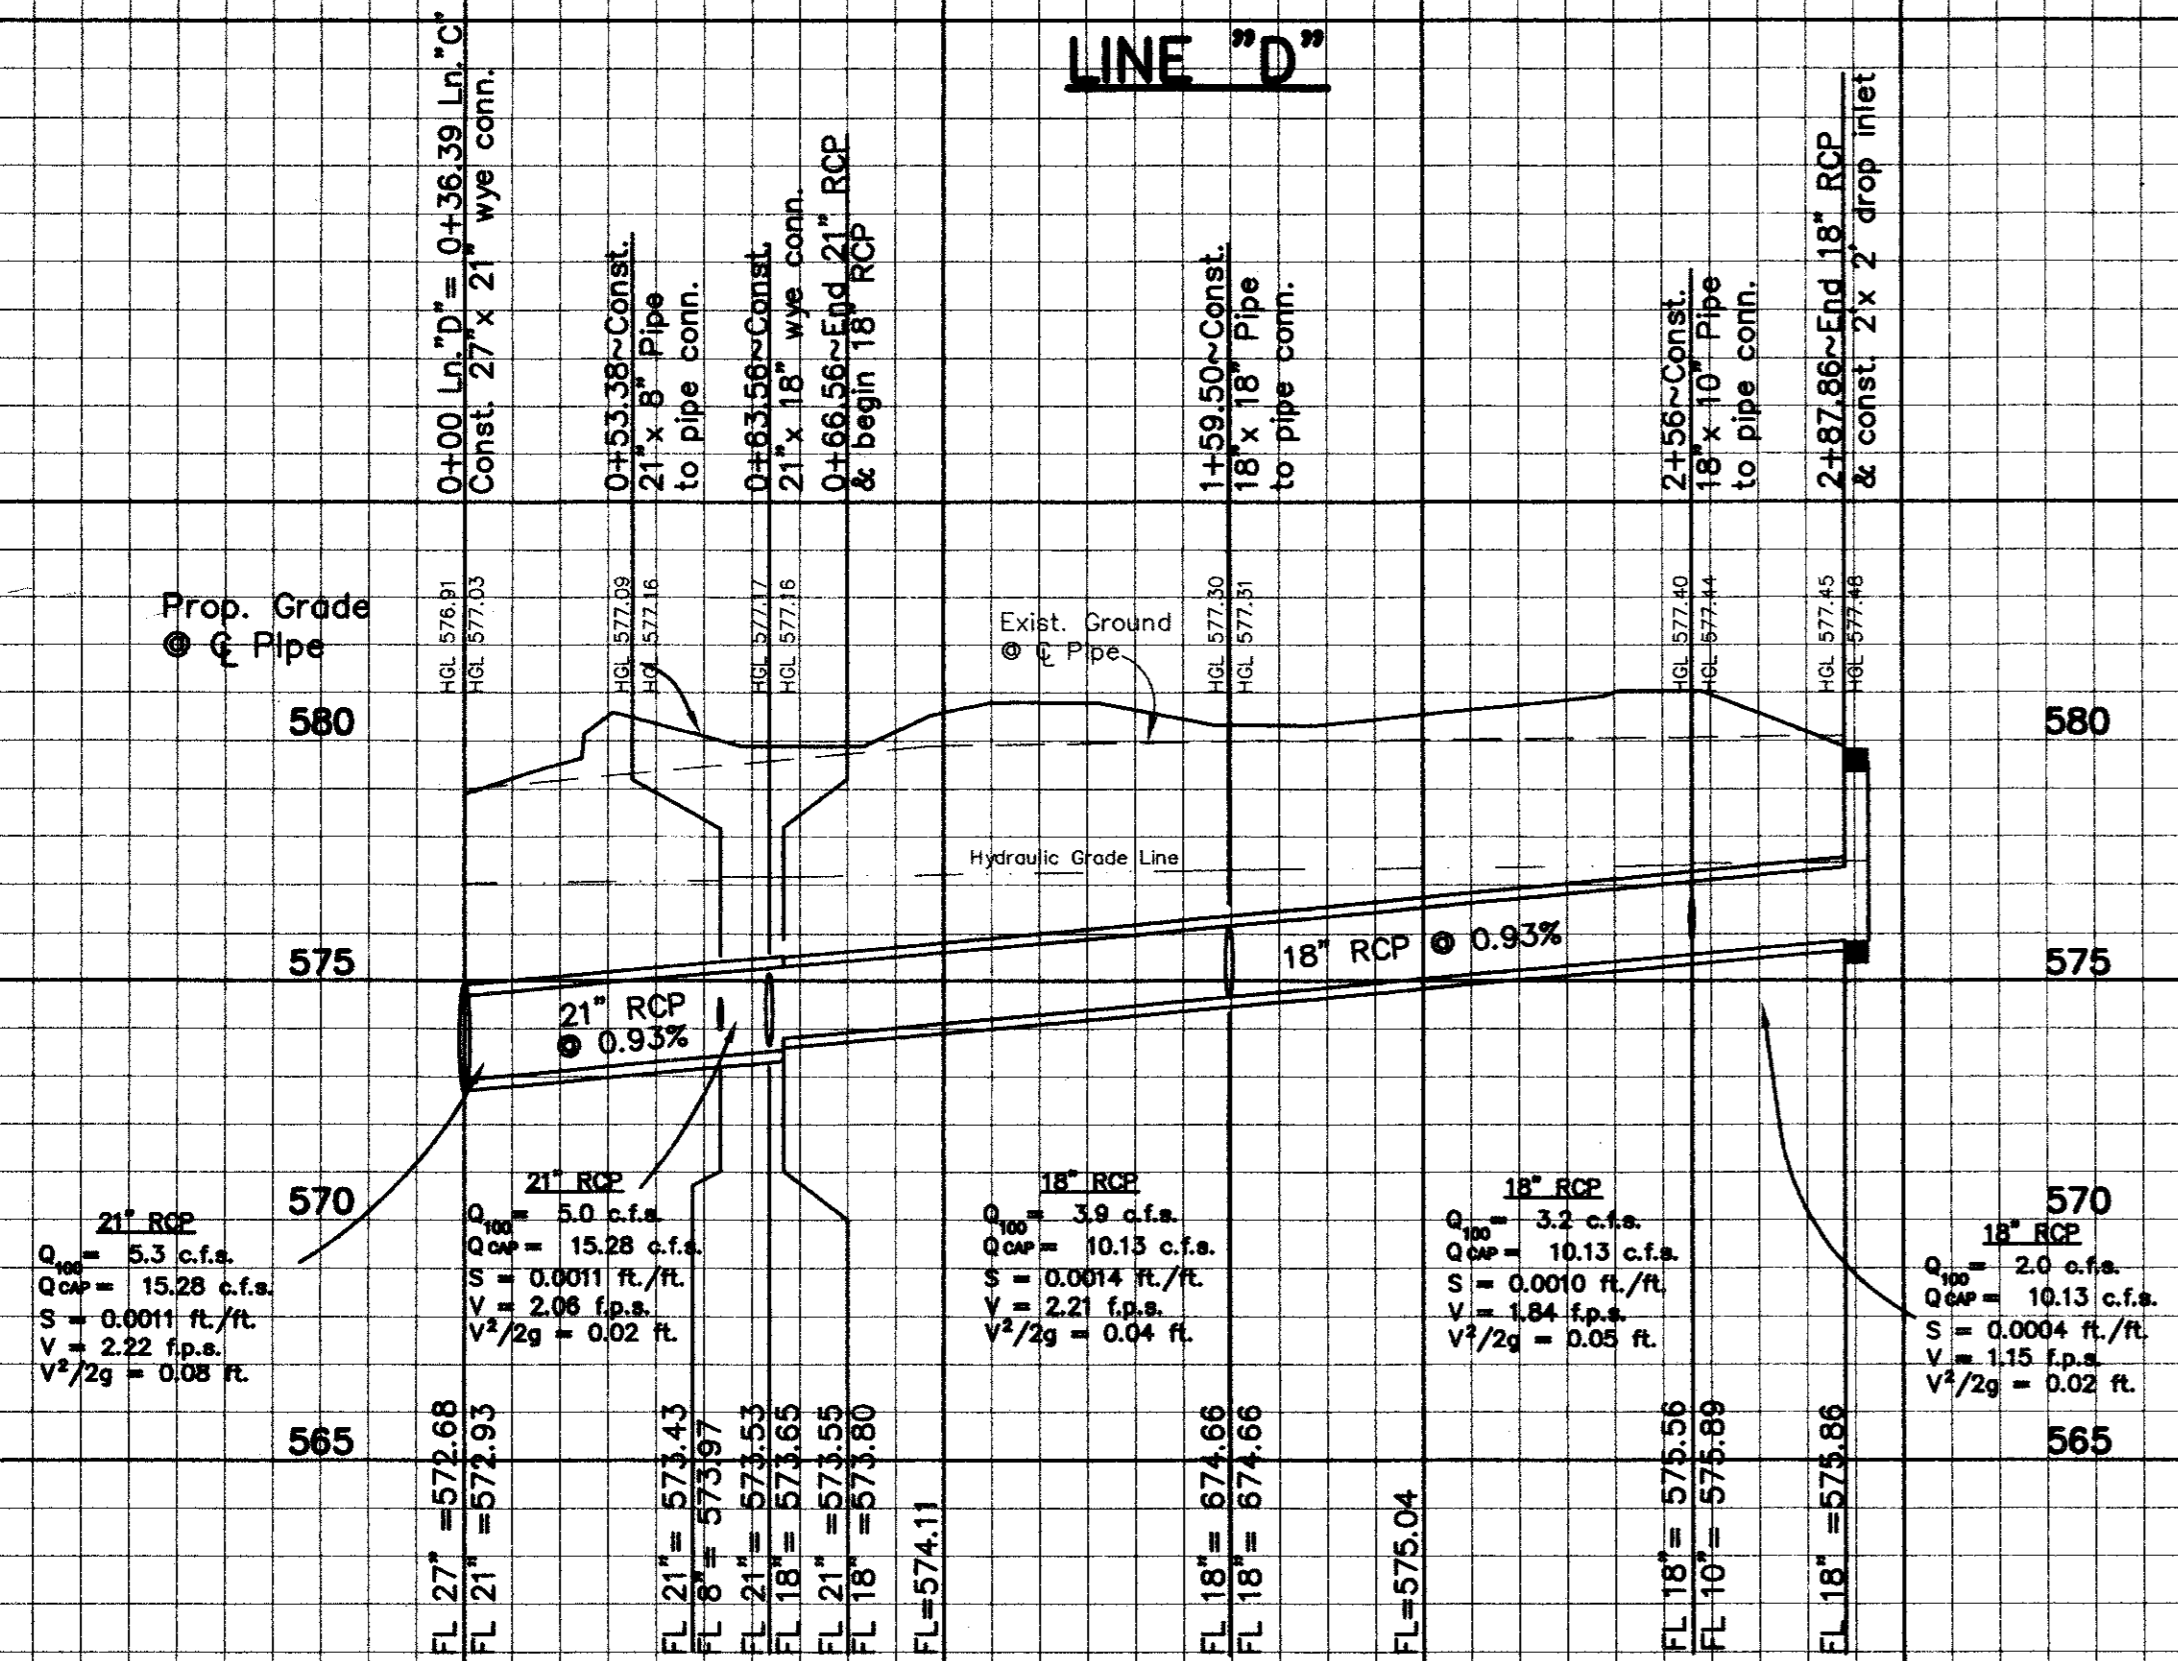

0+00 LINE "E" 1+00

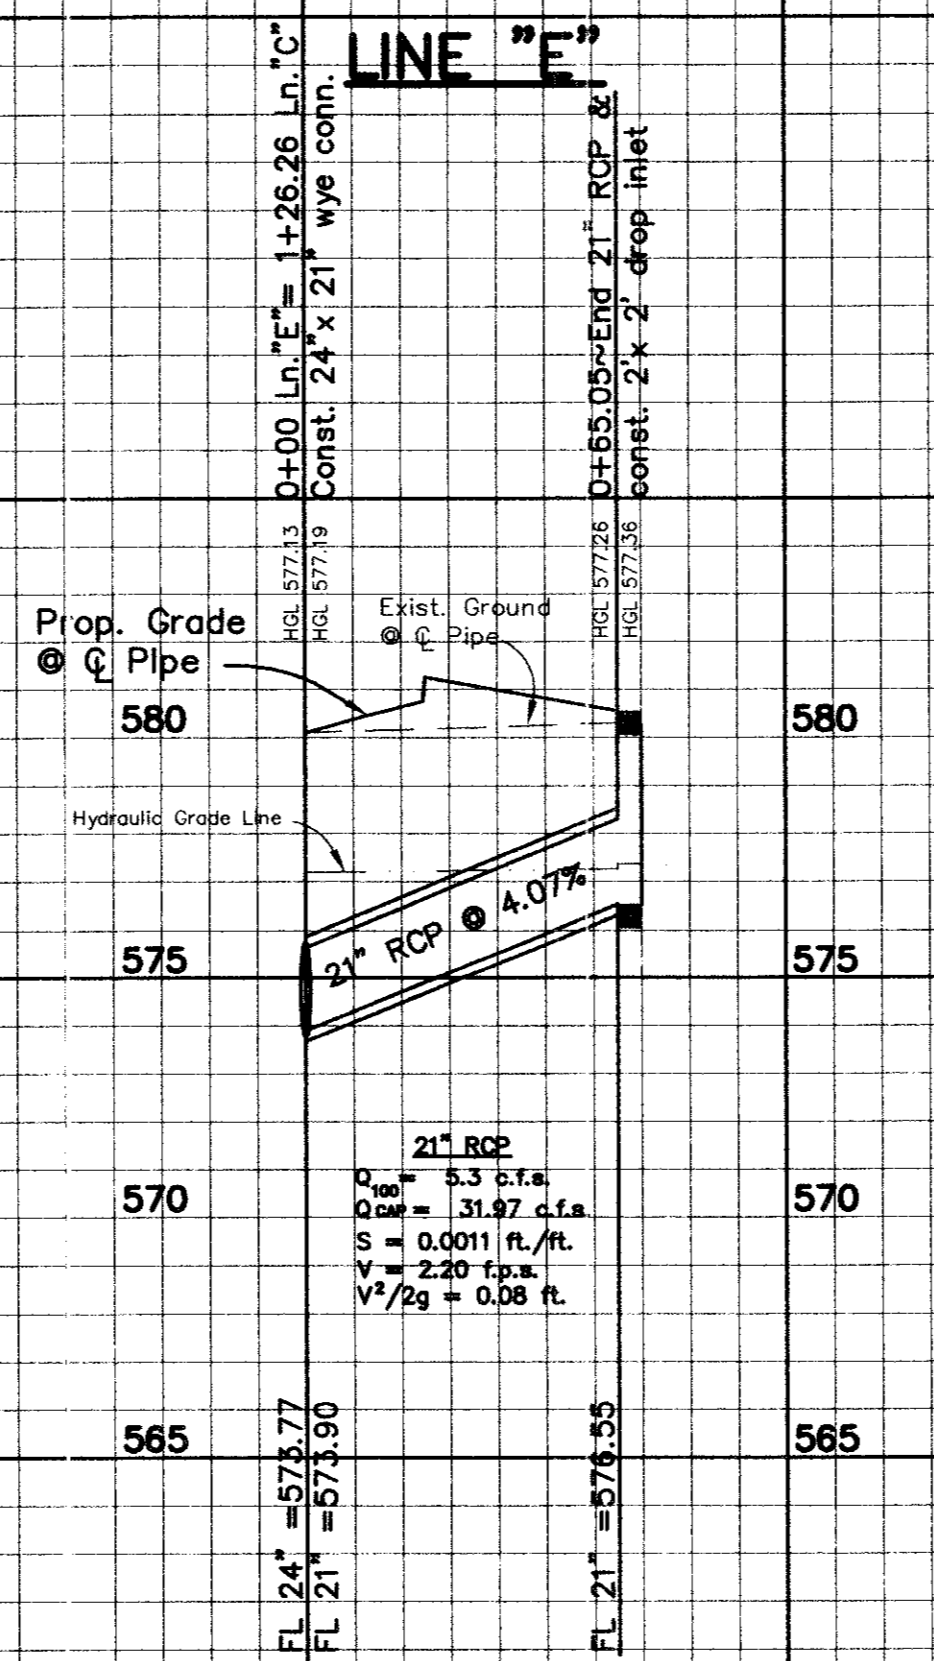


RECORD DRAWING
 THIS DRAWING HAS BEEN REVIEWED
 TO INSURE THE DESIGN IS
 CONFORMANT WITH THE
 CONDITIONS IN THE AGREEMENT OF THE
 CONTRACT. EMBLEM SHOWN ON
 THIS DRAWING IS NOW FIELD VERIFIED.

JONES & BOYD
 2/11/02

NOTE:
 PVC PIPE OF CLASS 150 OR BETTER MAY BE USED IN PLACE OF RCP
 FOR STORM SEWER.

- BENCHMARK :
- SQUARE CUT ON TOP OF CURB INLET AT NORTHEAST CORNER OF INTERSECTION OF BUSINESS AVE. AND BELTLINE ROAD. ELEVATION = 577.59'
 - "X" AT INLET ON TOP OF CURB WEST SIDE OF BUSINESS AVE. 200' +/- NORTH OF BELTLINE ROAD. ELEVATION = 578.57'

NO.	REVISIONS DURING CONSTRUCTION	BY	DATE	NO.	REVISIONS DURING PLAN REVIEW	BY	DATE

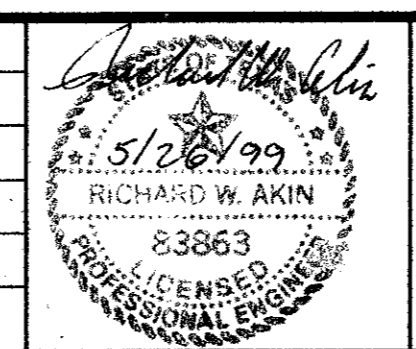

Jones & Boyd, Inc.
 16800 Dallas Parkway, Suite 240
 Dallas, Texas 75248
 Tel: 972-248-7676
 Fax: 972-248-1414

- Engineering
- Planning
- Landscape Architecture
- Surveying



STORM SEWER PROFILES

SUITES OF AMERICA

TOWN OF ADDISON,
 DALLAS COUNTY, TEXAS

PROJECT NO.	BG403
SHEET NO.	C6

BLOCK 2
BELT LINE-MARSH BUSINESS PARK
VOL. 79252, PG. 0210

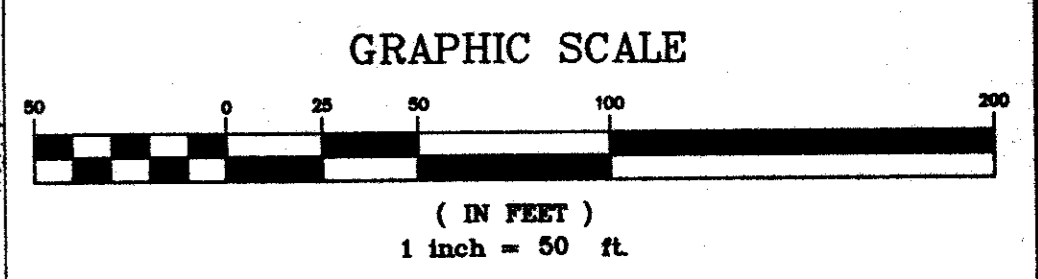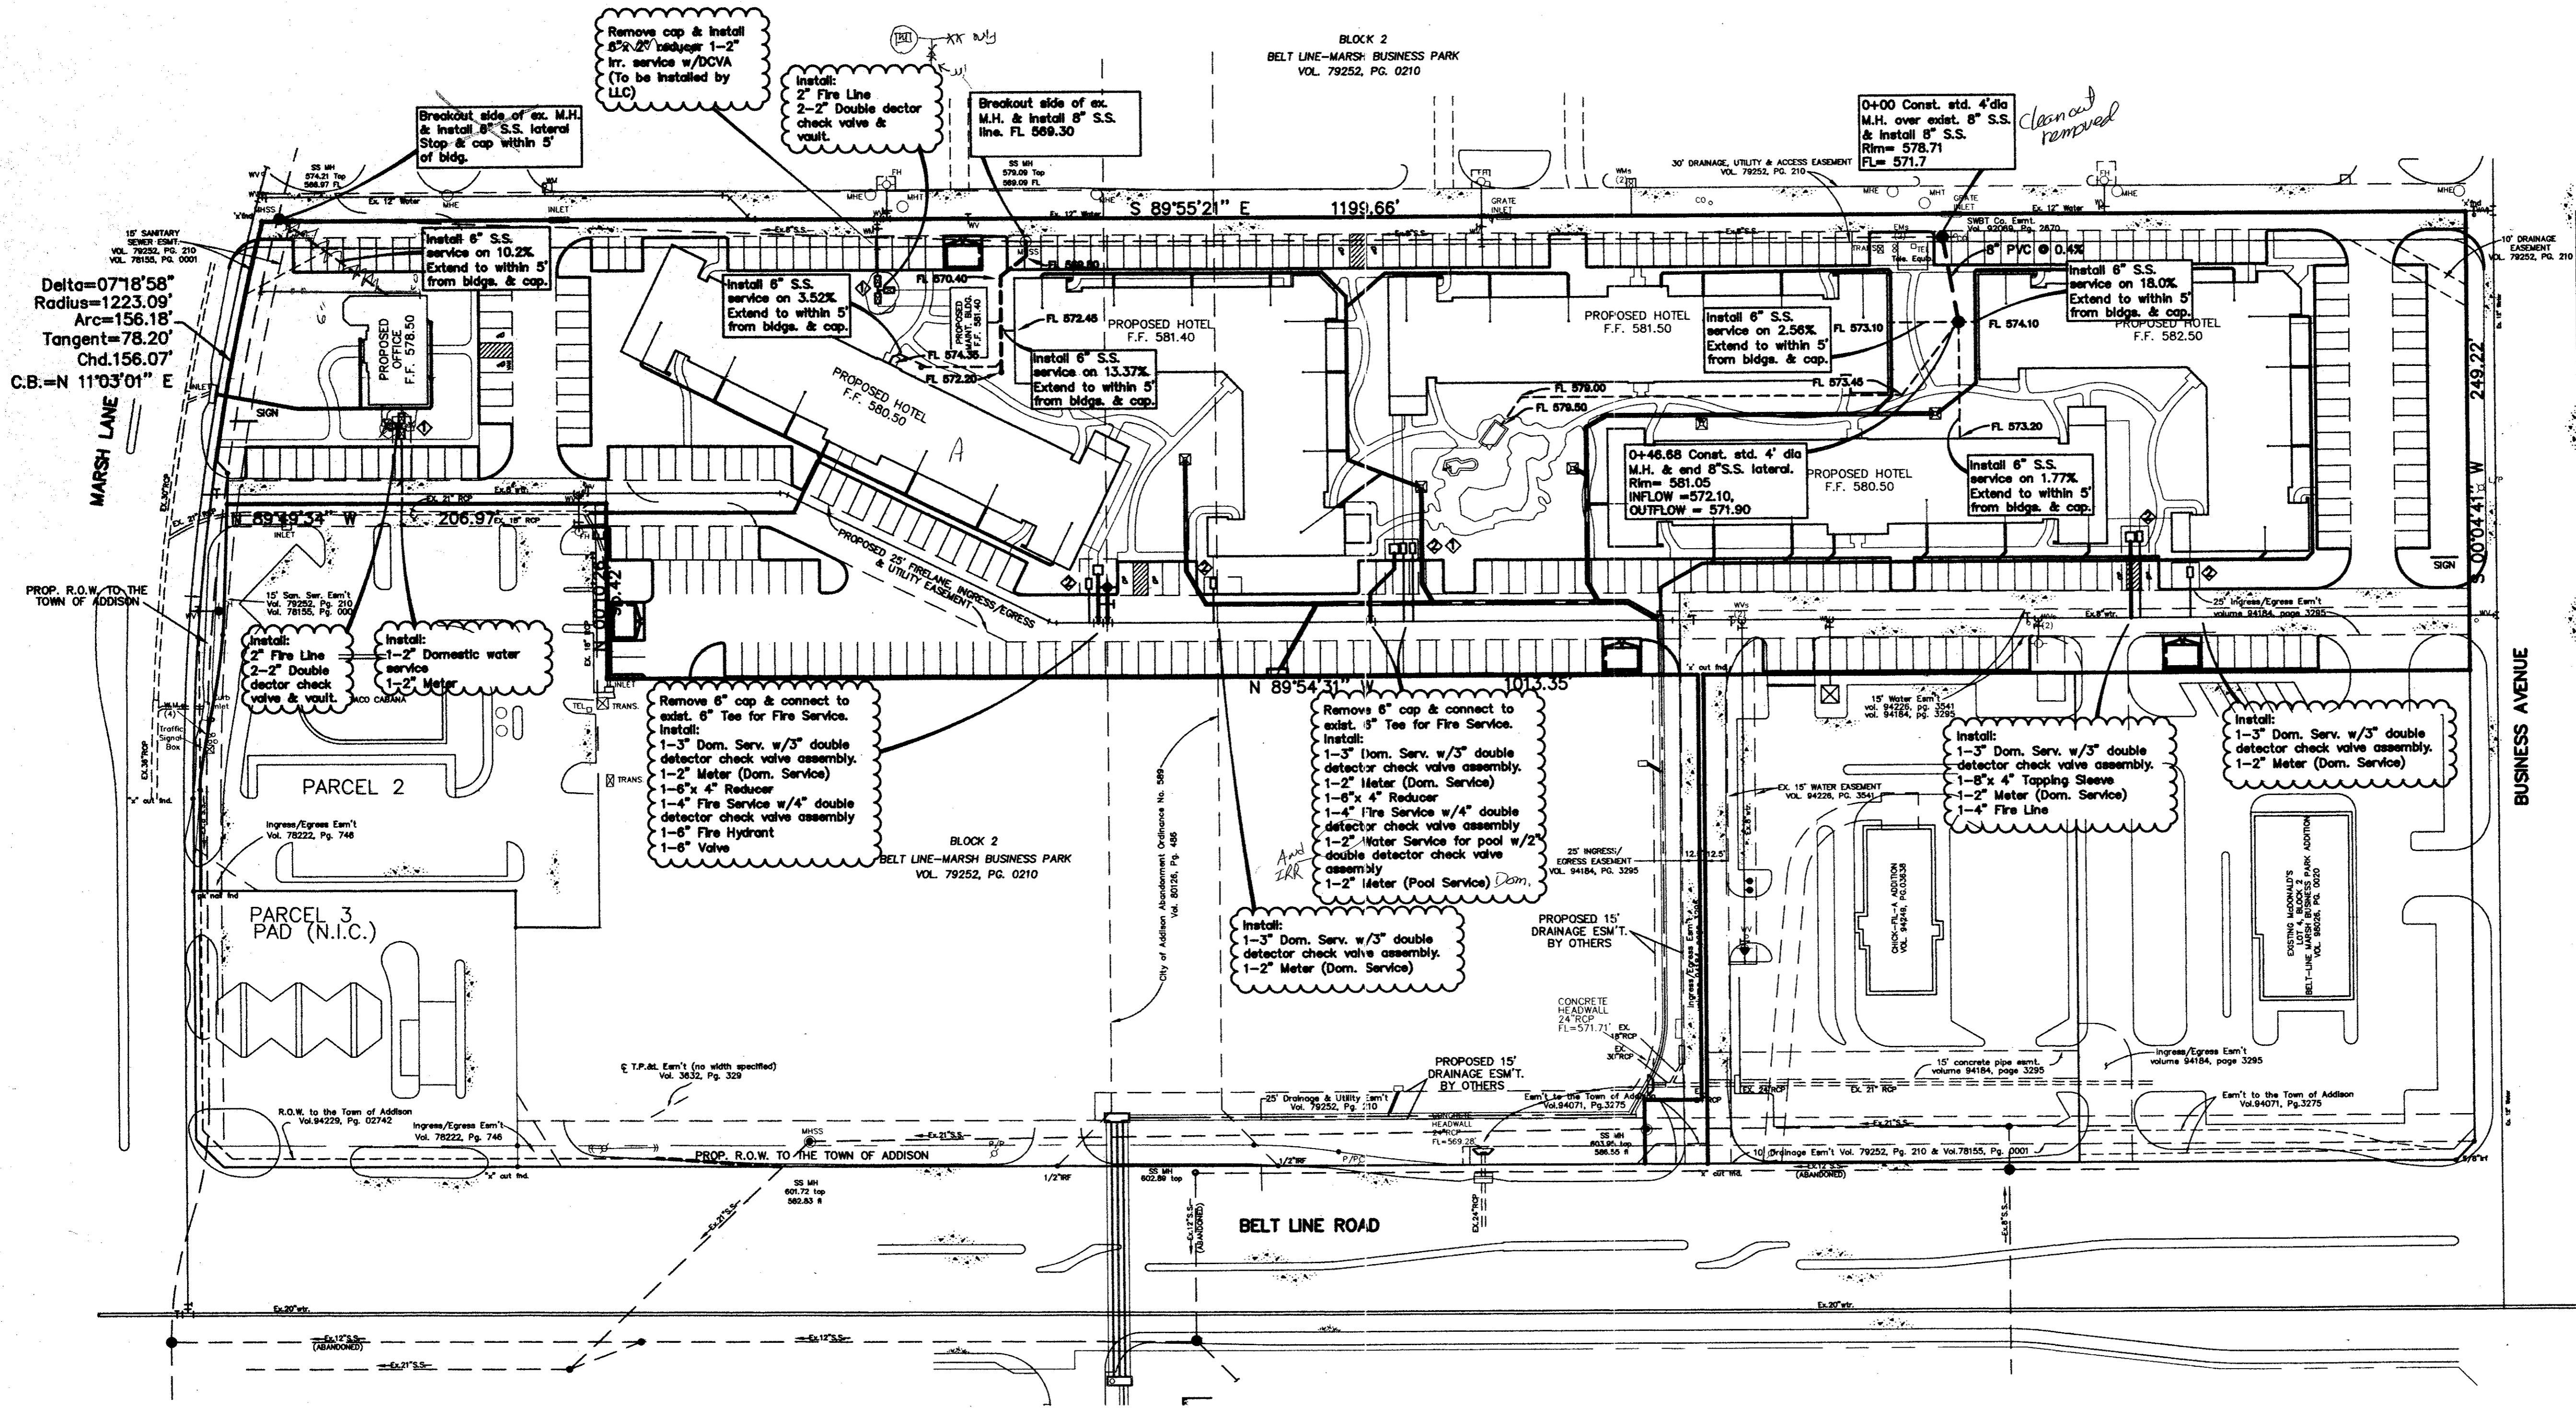

GENERAL NOTES

- All water main pipe fittings will be in accordance with "Standard Specifications for Public Works Construction" as modified by the City of Addison Special Provisions.
- All water mains shall have a minimum cover as follows: 6" - 42", 8" - 48", 12" - 54" or as required to clear utilities.
- All water services will consist of a minimum 2" compression fitting composite stop (AWWA C-500), 2" minimum type "K" copper tubing, 2" minimum compression fitting angle stop, and meter box, unless otherwise shown on the plans. Angle stops will be located within the meter box and facing toward the building per City of Addison Standard Construction Details.
- All ductile iron fittings shall be of mechanical joint type or slip joint type and shall be Class D or Class 250 on sizes 12" or smaller in accordance with AWWA Specification C-110-64 and Specification C-111-64.
- Water taps of 2" or less on existing mains will be made by the City forces. Sanitary sewer taps of 4" on existing mains will be made by City forces.
- Fire hydrants shall be approved by the City Engineer.
- Fire Sprinkler line shall be sized and installed by a state licensed fire sprinkler contractor.
- Fire hydrants shall be placed 2.5 feet from the back of curb as shown on the plan.
- Fire hydrant bonnets and caps will be painted to conform to the State Insurance color coding. Paint used for painting City fire hydrants will meet City Specifications.
- Gate valves will be resilient seat conforming to AWWA C-509 and City of Addison Special Provisions.
- Valves will be in the closed position on stub outs installed for future service.
- SDR 35 PVC pipe shall be used for sanitary sewer.
- Contractor shall verify location and elevation of all existing utilities and notify the Engineer of any discrepancies.
- All manholes, cleanouts, valve boxes, fire hydrants, etc. must be adjusted to proper line and grade by the Contractor after placing of permanent pavement.
- Unless otherwise noted, all materials and construction will conform to the "Standard Specifications for Public Works Construction for North Central Texas", with Amendments and the City of Addison Special Provisions.
- In the event an item is not covered in the Specifications, the City Engineer's decision will apply.
- Any water or sanitary sewer service located outside of a street, alley, or easement shall be installed by a plumber and be inspected by Code Enforcement. All installation shall be in accordance with City Code Enforcement regulations.
- Concrete encasement at utility crossings shall be 9 feet on either side of the lowest crossing pipe.
- Trench excavation for trenches 5 feet or more in depth shall be in accordance with all provisions of Part 1928, Subpart P - "Excavations, Trenching, and Shoring of the Occupational Safety and Health's Standards and Interpretations. It shall be the responsibility of the Contractor to conform to the above provisions.
- A blue Stimsonite, Fire-Lite reflector or approved equal shall be placed in the center of the fire lane opposite fire hydrants.
- All sanitary sewer manholes shall be constructed so the top of the cone is 8 inches below the top of the manhole elevation on the profiles. Manholes shall be adjusted to finish pavement grade, with approved adjustment rings, at the time of paving.
- All water & sewer services & fire lines to building are shown to within 5' of the buildings. Limits of Site work Utility Contractor's work shall be to 5' of the buildings. Meter box location where adjacent to buildings shall be coordinated with General Contractor.
- Fire line shall be sized & installed by a licensed Fire Protection Contractor.
- All water mains 12-inch in diameter and under shall be ductile iron or AWWA C900 PVC, mechanical joint, or a joint of the type which provides a recession in the bell for the employment of a single rubber gasket to be placed before the insertion of the succeeding spigot. Joint material for PVC shall conform to ASTM F477. Tracer wire shall be installed over all PVC mains.

BENCHMARK:


- SQUARE CUT ON TOP OF CURB INLET AT NORTHEAST CORNER OF INTERSECTION OF BUSINESS AVE. AND BELTLINE ROAD. ELEVATION = 577.59'
- "X" AT INLET ON TOP OF CURB WEST SIDE OF BUSINESS AVE. 200' +/- NORTH OF BELTLINE ROAD. ELEVATION = 578.57'

NO.	REVISIONS DURING CONSTRUCTION	BY	DATE	NO.	REVISIONS DURING PLAN REVIEW	BY	DATE
1	ADDED 2" FIRE LINE TO MAINT. BLDG. AND OFFICE BLDG.	SWY	11/9/99	1	ADDED MAINTENANCE BLDG.	RWA	5/25/99

RECORD DRAWING
THIS DRAWING HAS BEEN REVISIONED TO REFLECT THE LATEST REVISIONS TO THE ORIGINAL DRAWING. ALL CHANGES ARE SHOWN IN RED. THE ORIGINAL DRAWING IS NOT TO BE USED FOR CONSTRUCTION. ELEVATIONS SHOWN ON THIS DRAWING ARE NOT FIELD VERIFIED.
DATE: 2/11/00

I.D. NO.	QUANTITY	SERVICE SIZE	METER SIZE	DOMESTIC	IRRIGATION	SAN. SWR.
1	2	2"	2"	X		6"
2	5	3"	2"	X		6"
3	1	2"	2"		X	N/A

Note:
All Fire Service Lines to buildings are 4" unless otherwise noted on the plan.

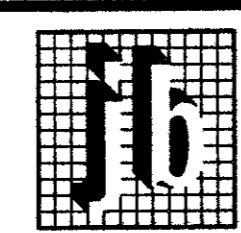



Jones & Boyd, Inc.
16800 Dallas Parkway, Suite 240
Dallas, Texas 75248
Tel: 972-248-7676
Fax: 972-248-1414

WATER & SANITARY SEWER PLAN
SUITES OF AMERICA
TOWN OF ADDISON,
DALLAS COUNTY, TEXAS


PROJECT NO.
BG403
SHEET NO.
C7

BLOCK 2
BELT LINE-MARSH BUSINESS PARK
VOL. 79252, PG. 0210


GRAPHIC SCALE

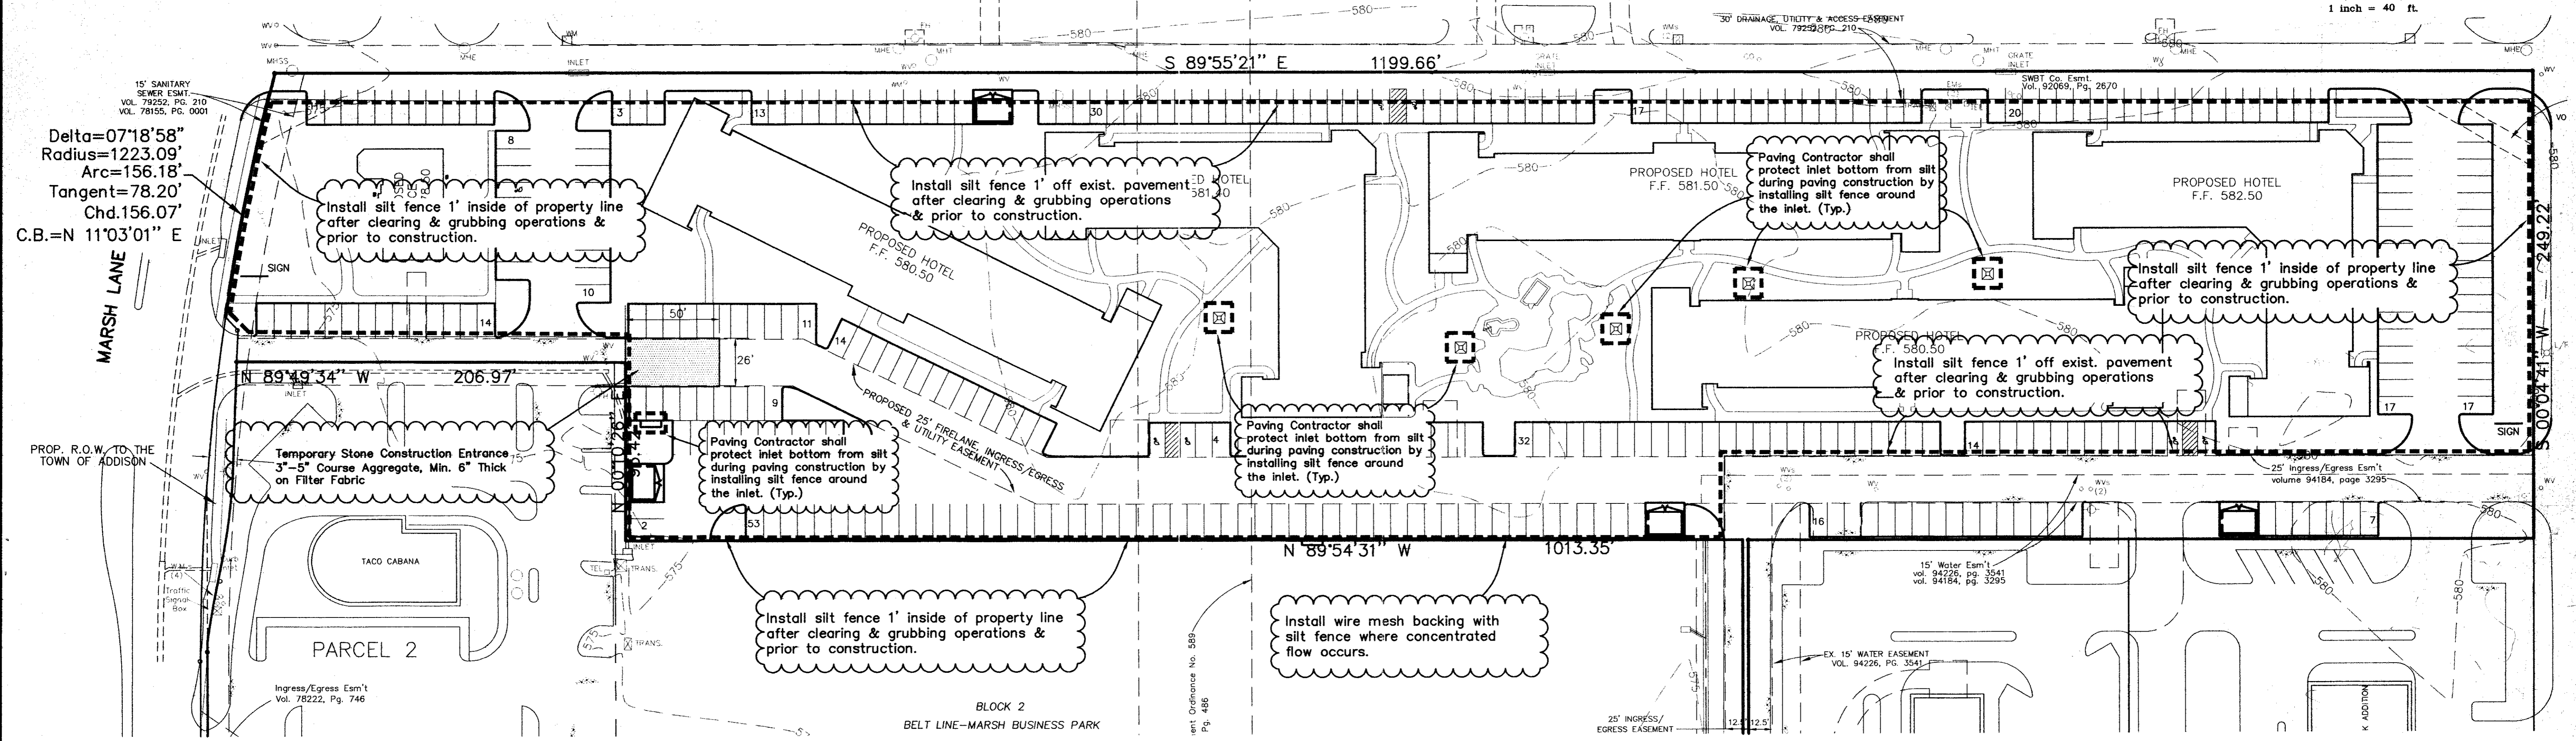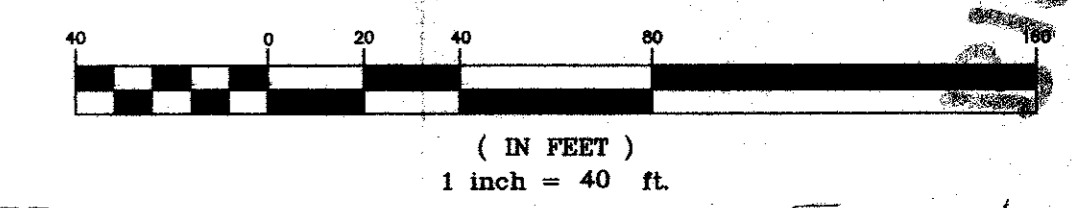


Delta=07'18"58"
Radius=1223.09'
Arc=156.18'
Tangent=78.20'
Chd.156.07'
C.B.=N 11°03'01" E

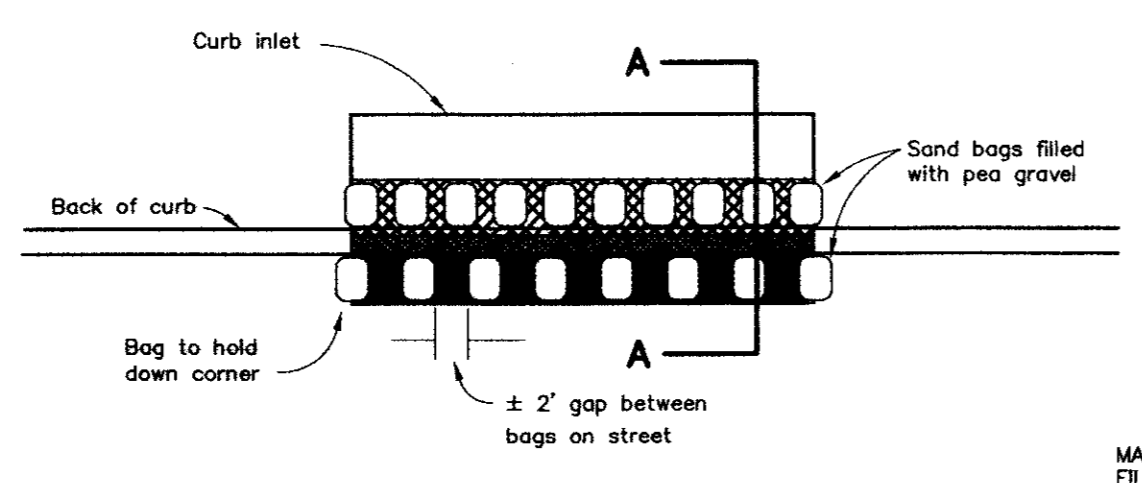


INLET EROSION PROTECTION
PLAN VIEW
N.T.S.

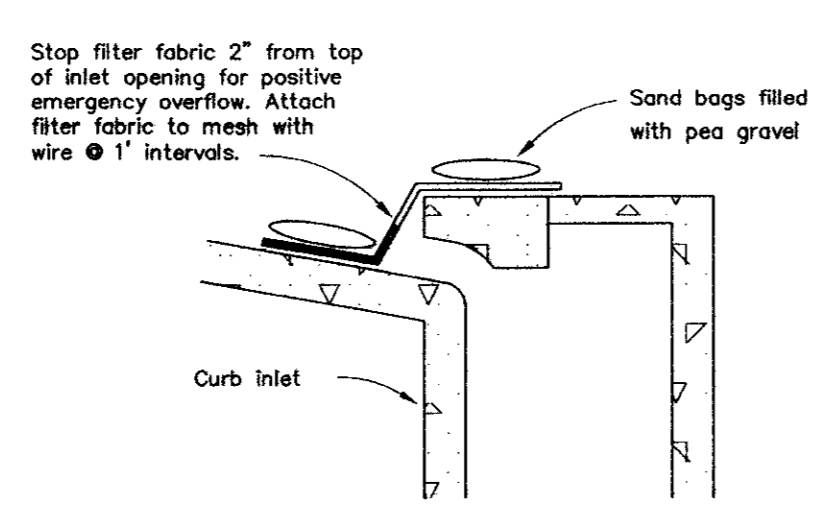

SECTION A-A
N.T.S.

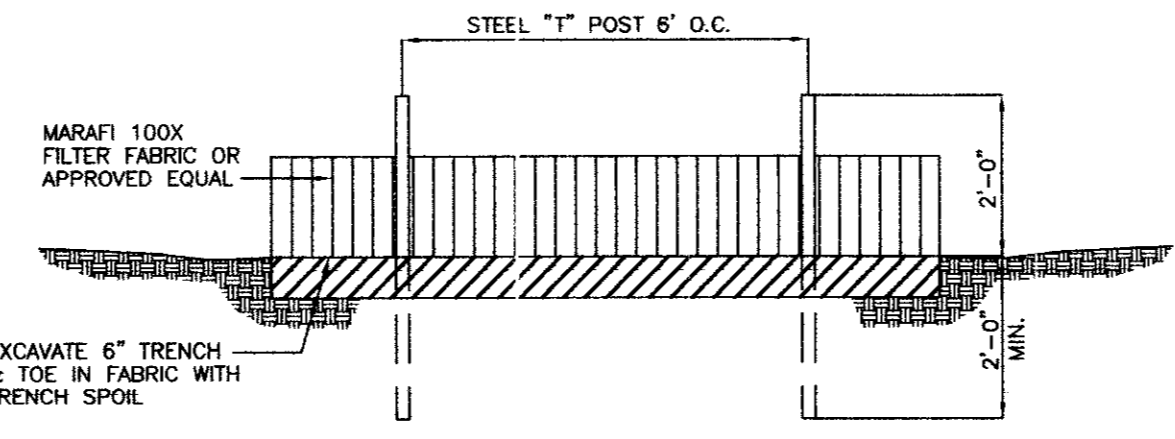

ELEVATION
N.T.S.

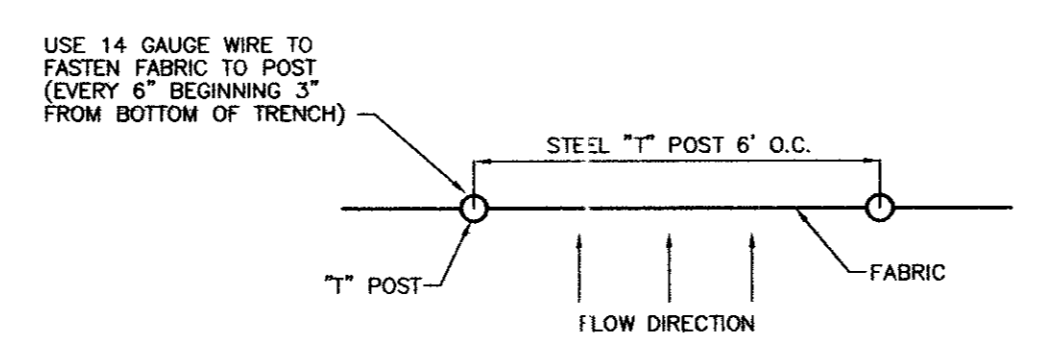

PLAN VIEW SILT FENCE DETAIL
N.T.S.

- SILT FENCE GENERAL NOTES:**
1. Steel posts which support the silt fence shall be installed on a slight angle toward the anticipated runoff source.
 2. The toe of the silt fence shall be trenched in with a spade or mechanical trencher, so that the downslope face of the trench is flat and perpendicular to the line of flow.
 3. The trench should be a minimum of six inches deep and four inches wide to allow for the silt fence to be laid in the ground and backfilled.
 4. Silt fence should be securely fastened to each support post.
 5. Inspection shall be frequent and repair or replacement shall be made promptly as needed.
 6. Silt fence shall be removed when it has served its usefulness, so as not to block or impede storm flow or drainage.
 7. Sediment trapped by this practice shall be disposed of in an approved site in a manner that will not contribute to additional siltation.
 8. Accumulated silt shall be removed when it reaches a depth of six inches and disposed of in an approved spoil site or as in No. 7 above.
 9. At point of surface flow concentration reinforce silt fence with wire mesh backing on downstream side of fence.
 10. Filter fabric is to be Marafi 100X or approved equal. (Marafi, Inc.: 800-438-1855)

RECORD DRAWING
THIS DRAWING HAS BEEN REPRODUCED
FOR THE RECORDS OF THE CITY OF ADDISON
DATE: 2/1/00
CMB


LEGEND

- Silt Fence
- Inlet w/ Erosion protection

- BENCHMARK :**
1. SQUARE CUT ON TOP OF CURB INLET AT NORTHEAST CORNER OF INTERSECTION OF BUSINESS AVE. AND BELTLINE ROAD. ELEVATION = 577.59'
 2. "X" AT INLET ON TOP OF CURB WEST SIDE OF BUSINESS AVE. 200' +/- NORTH OF BELTLINE ROAD. ELEVATION = 578.57'

NO.	REVISIONS DURING CONSTRUCTION	BY	DATE	NO.	REVISIONS DURING PLAN REVIEW	BY	DATE

5/28/99
RICHARD W. AKIN
83863
LICENSED PROFESSIONAL ENGINEER

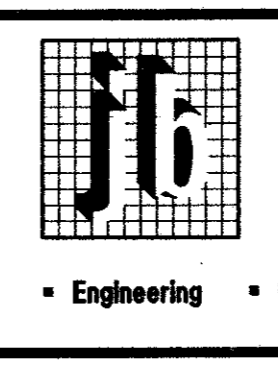

Jones & Boyd, Inc.
18000 Dallas Parkway, Suite 240
Dallas, Texas 75248
Tel: 972-248-7878
Fax: 972-248-1414
• Engineering • Planning • Landscape Architecture • Surveying

EROSION CONTROL PLAN
SUITES OF AMERICA
CITY OF ADDISON,
DALLAS COUNTY, TEXAS

PROJECT NO.
BG403
SHEET NO.
C8