

CONSTRUCTION PLANS FOR

SUITES OF AMERICA


CITY OF ADDISON DALLAS COUNTY, TEXAS

DEVELOPER:

BIGELOW DEVELOPMENT CORPORATION
4004 BELTLINE ROAD, SUITE 240, LOCK BOX #1
DALLAS, TEXAS 75244
(972) 503-8880

ENGINEER:


JONES & BOYD, INC.
16800 DALLAS PARKWAY, SUITE 240
DALLAS, TEXAS 75248
(214) 248-7676

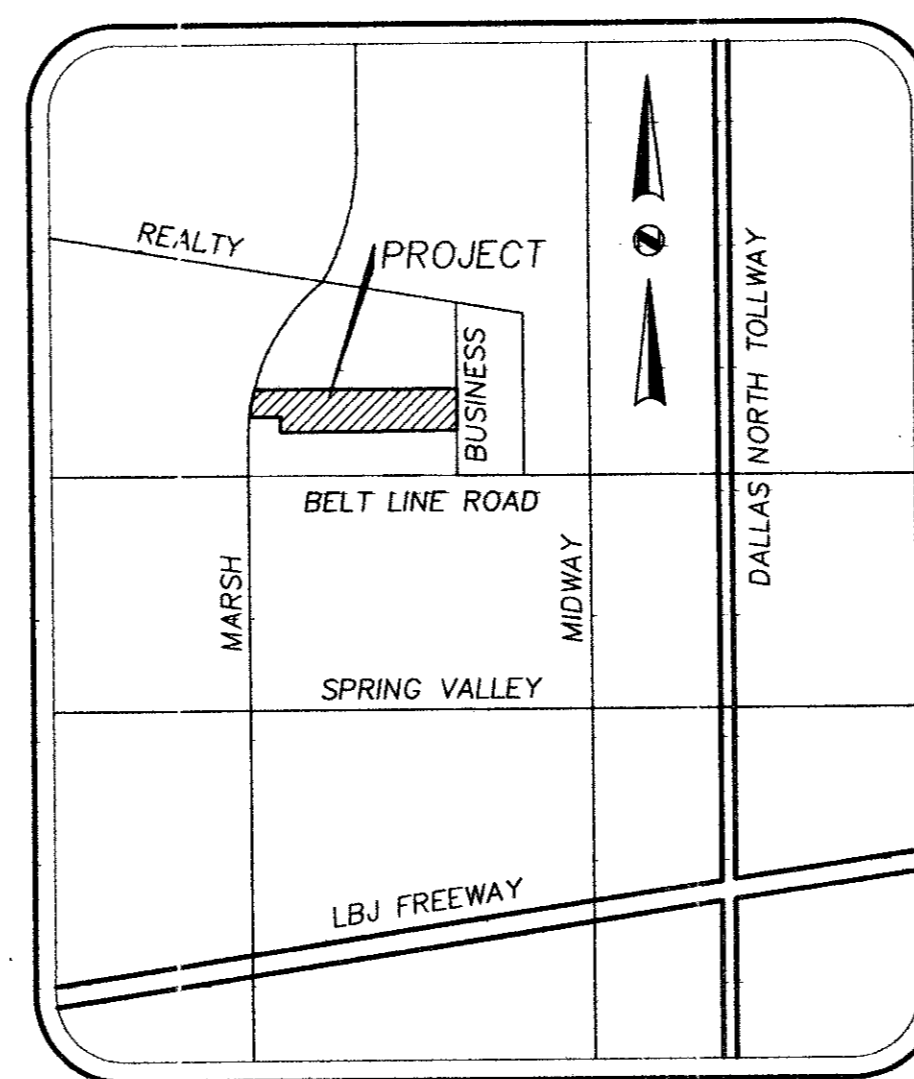

LOCATION MAP
NOT TO SCALE

INDEX

SHEET NO.	DESCRIPTION
1	PAVING & DIMENSION CONTROL PLAN
2	PAVING DETAILS
3	GRADING PLAN
4	DRAINAGE PLAN
5	STORM SEWER PLAN
6	STORM SEWER PROFILES
7	WATER & SANITARY SEWER PLAN
8	EROSION CONTROL PLAN

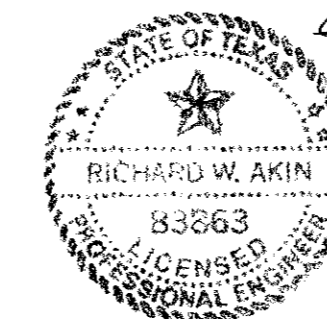

Richard W. Akin
5/20/99

RECORD DRAWING
THIS DRAWING HAS BEEN REVISED
TO REFLECT THE ACTUAL
CONSTRUCTION DETAILS AS
COMPALED IN THE RECORDS OF THE
CONTRACTOR. ELEVATIONS SHOWN ON
THIS PLAN WERE NOT FIELD VERIFIED.
BY: *[Signature]*
DATE: 2/1/00

Raised 5/26/99