
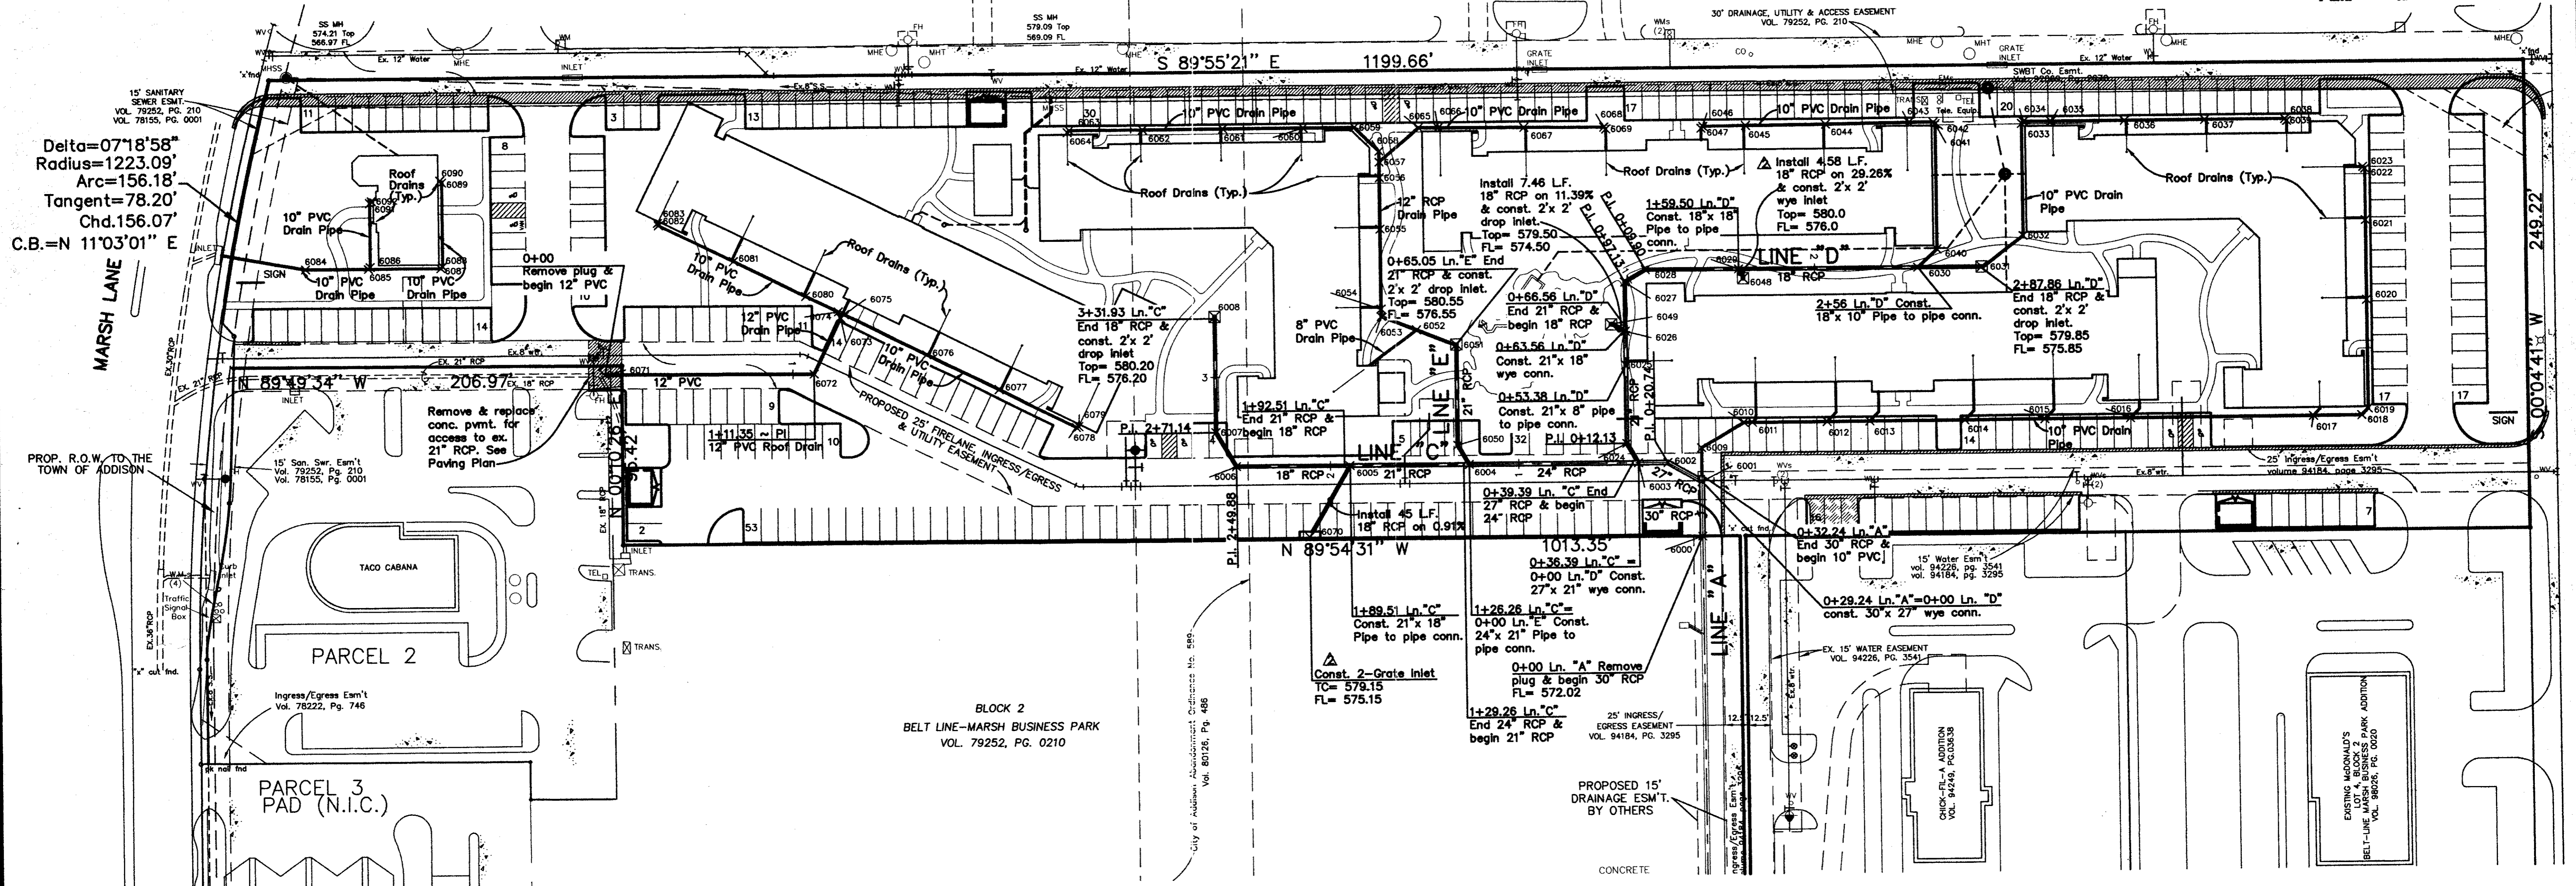


BLOCK 2
BELT LINE-MARSH BUSINESS PARK
VOL. 79252, PG. 0210

GRAPHIC SCALE

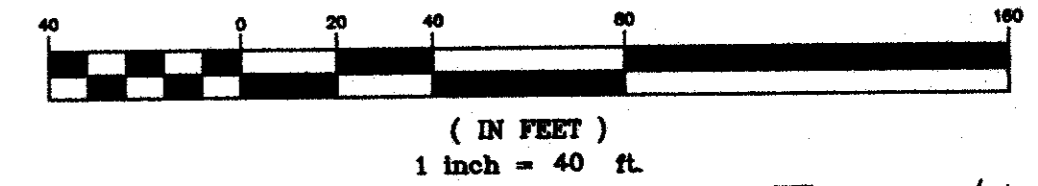

Delta=07°18'58"
Radius=1223.09'
Arc=156.18'
Tangent=78.20'
Chd.156.07'
C.B.=N 11°03'01" E

STORM SEWER COORDINATE POINTS

POINT #	NORTHING	EASTING	POINT #	NORTHING	EASTING	POINT #	NORTHING	EASTING	POINT #	NORTHING	EASTING
6000	4751.47055491	4559.86852258	6025	4842.89252300	4520.27629933	6050	4801.76272912	4430.34376646	6075	4873.67813265	4105.38142855
6001	4780.71348213	4559.86852258	6026	4860.51816471	4520.30005487	6051	4854.68537748	4430.41509470	6076	4852.24873607	4148.97370944
6002	4791.11807222	4541.92552166	6027	4886.64179796	4520.33526385	6052	4862.49656808	4409.36581691	6077	4833.46248314	4187.18897332
6003	4791.13289606	4526.27846331	6028	4893.02165690	4531.40272110	6053	4869.77476552	4390.68136802	6078	4813.37118700	4228.05929176
6004	4791.25403065	4436.40152774	6029	4892.95480954	4511.00073896	6054	4873.77476552	4390.68137866	6079	4813.82738052	4229.39785249
6005	4791.33927749	4373.15184252	6030	4892.82629032	4676.35677399	6055	4916.35809886	4390.68149200	6080	4883.71846701	4084.95716305
6006	4791.42063596	4312.78717592	6031	4892.78046773	4710.35527009	6056	4943.84600957	4390.68156517	6081	4902.50471995	4046.74176068
6007	4809.84526783	4302.16625824	6032	4908.98356866	4732.66181469	6057	4952.30359750	4390.68158768	6082	4922.0631067	4006.95586232
6008	4870.62893047	4302.24818141	6033	4969.10856866	4732.66197472	6058	4958.23644231	4390.68160347	6083	4923.40160140	4006.49960050
6009	4798.89215012	4559.86852258	6034	4970.10856800	4733.66197738	6059	4971.06625341	4377.85186066	6084	4900.08318325	3818.539+1951
6010	4811.99117177	4582.59204411	6035	4970.10852670	4748.42630143	6060	4971.06632601	4350.57584078	6085	4900.08318325	3853.21913438
6011	4811.99115978	4587.09415707	6036	4970.10842271	4787.49531071	6061	4971.06643940	4307.97330428	6086	4901.08318325	3853.21913438
6012	4811.99105397	4626.84760280	6037	4970.10830937	4830.07864404	6062	4971.0665274	4265.38997095	6087	4900.08318325	3890.70317172
6013	4811.99099340	4649.60631399	6038	4970.10819598	4872.68118054	6063	4971.06665673	4226.32096167	6088	4901.08318325	3891.70317172
6014	4811.99085879	4700.18093614	6039	4969.10819332	4873.68117788	6064	4970.06665939	4225.32095901	6089	4946.0969068	3891.70317172
6015	4811.99074545	4742.76426947	6040	4902.34796193	4686.75313378	6065	4970.51536021	4411.87831521	6090	4947.0969068	3890.70317172
6016	4811.99062423	4788.30593614	6041	4969.51462859	4686.75313255	6066	4970.43189412	4422.37834656	6091	4935.45538542	3853.219+3438
6017	4811.99036542	4885.54376020	6042	4970.50686370	4685.75334536	6067	4970.06987760	4467.92001227	6092	4936.45538542	3854.21913438
6018	4811.99029688	4911.29376020	6043	4970.40591664	4672.75328475	6068	4969.73137725	4510.50334470			
6019	4815.48308391	4914.78656582	6044	4970.06166288	4628.41995050	6069	4968.72342838	4511.50331044			
6020	4872.81663017	4914.78681842	6045	4969.73099808	4585.83681629	6070	4753.30868284	4351.16068385			
6021	4915.39996350	4914.78683176	6046	4969.55427300	4583.07790463	6071	4842.90965676	3977.62829375			
6022	4942.88787422	4914.78690493	6047	4968.54650901	4562.07793212	6072	4842.57172410	4088.97557768			
6023	4943.88787888	4913.78890759	6048	4887.98728094	4583.28648189	6073	4871.87573141	4103.38109114			
6024	4801.64159453	4520.22070204	6049	4864.25150849	4512.84609719	6074	4875.22220824	4102.24043657			

LEGEND

	Exist. Water Line and Valve		Prop. Water Line and Valve
	Exist. Fire Hydrant		Prop. Fire Hydrant
	Exist. Sewer Line		Prop. Sewer Line
	Exist. Manhole		Prop. Manhole
	Exist. Storm Sewer		Prop. Storm Sewer
			Prop. Cleanout

RECORD DRAWING
THIS DRAWING HAS BEEN REVISED TO REFLECT THE ACTUAL CONSTRUCTION DELETED AS NOTED IN THE RECORDS OF THE CONTRACTOR. ELEVATION STATION ON THIS DRAWING WERE NOT FIELD VERIFIED.
DATE: 2/1/00

- BENCHMARK :
- SQUARE CUT ON TOP OF CURB INLET AT NORTHEAST CORNER OF INTERSECTION OF BUSINESS AVE. AND BELTLINE ROAD. ELEVATION = 577.59'
 - "X" AT INLET ON TOP OF CURB WEST SIDE OF BUSINESS AVE. 200' +/- NORTH OF BELTLINE ROAD. ELEVATION = 578.57'

NO.	REVISIONS DURING CONSTRUCTION	BY	DATE	NO.	REVISIONS DURING PLAN REVIEW	BY	DATE
2	as-builts - inlets	CBM	2/1/00				
1	ADDED COORDINATES	RWA	5/22/99	1	ADDED MAINTENANCE BLDG.	RWA	5/25/99

Jones & Boyd, Inc.
16800 Dallas Parkway, Suite 240
Dallas, Texas 75248
Tel: 972-248-7676
Fax: 972-248-1414

• Engineering • Planning • Landscape Architecture • Surveying

STORM SEWER PLAN

SUITES OF AMERICA

TOWN OF ADDISON,
DALLAS COUNTY, TEXAS

PROJECT NO. **BG403**
SHEET NO. **C5**