


LINE	BEARING	DISTANCE
1 (L)	N 11°42'00"E	72.00'
2 (L)	N 82°00'00"E	117.00'
3 (L)	S 30°00'00"E	102.00'
4 (L)	S 30°00'00"E	102.00'
5 (L)	N 82°00'00"E	117.00'
6 (L)	N 11°42'00"E	72.00'
7 (R)	N 72°30'00"E	112.00'
8 (R)	N 20°00'00"E	74.00'
9 (R)	N 20°00'00"E	74.00'
10 (R)	S 30°00'00"E	102.00'
11 (R)	S 30°00'00"E	102.00'
12 (R)	N 82°00'00"E	117.00'
13 (R)	N 11°42'00"E	72.00'

CURVE	DELTA	BEARING	LENGTH
C1 (M)	89°32'	S121°12'01"W	74.00'
C2 (M)	89°32'	N 11°42'00"E	72.00'
C3 (M)	89°32'	N 82°00'00"E	117.00'
C4 (M)	89°32'	S 30°00'00"E	102.00'
C5 (M)	89°32'	S 30°00'00"E	102.00'
C6 (M)	89°32'	N 82°00'00"E	117.00'
C7 (M)	89°32'	N 11°42'00"E	72.00'
C8 (M)	89°32'	N 20°00'00"E	74.00'
C9 (M)	89°32'	N 20°00'00"E	74.00'
C10 (M)	89°32'	S 30°00'00"E	102.00'
C11 (M)	89°32'	S 30°00'00"E	102.00'
C12 (M)	89°32'	N 82°00'00"E	117.00'
C13 (M)	89°32'	N 11°42'00"E	72.00'
C14 (M)	89°32'	N 82°00'00"E	117.00'
C15 (M)	89°32'	N 20°00'00"E	74.00'
C16 (M)	89°32'	N 20°00'00"E	74.00'
C17 (M)	89°32'	S 30°00'00"E	102.00'
C18 (M)	89°32'	S 30°00'00"E	102.00'
C19 (M)	89°32'	N 82°00'00"E	117.00'
C20 (M)	89°32'	N 11°42'00"E	72.00'

ST. LOUIS & SOUTHW
(100' RIGHT)

MARSH LANE
(VARIABLE WIDTH RIGHT-OF-WAY)

L 20' WATER & SANITARY
SEWER EASEMENT
INST. NO. 200100100113
O.P.R.D.C.T.

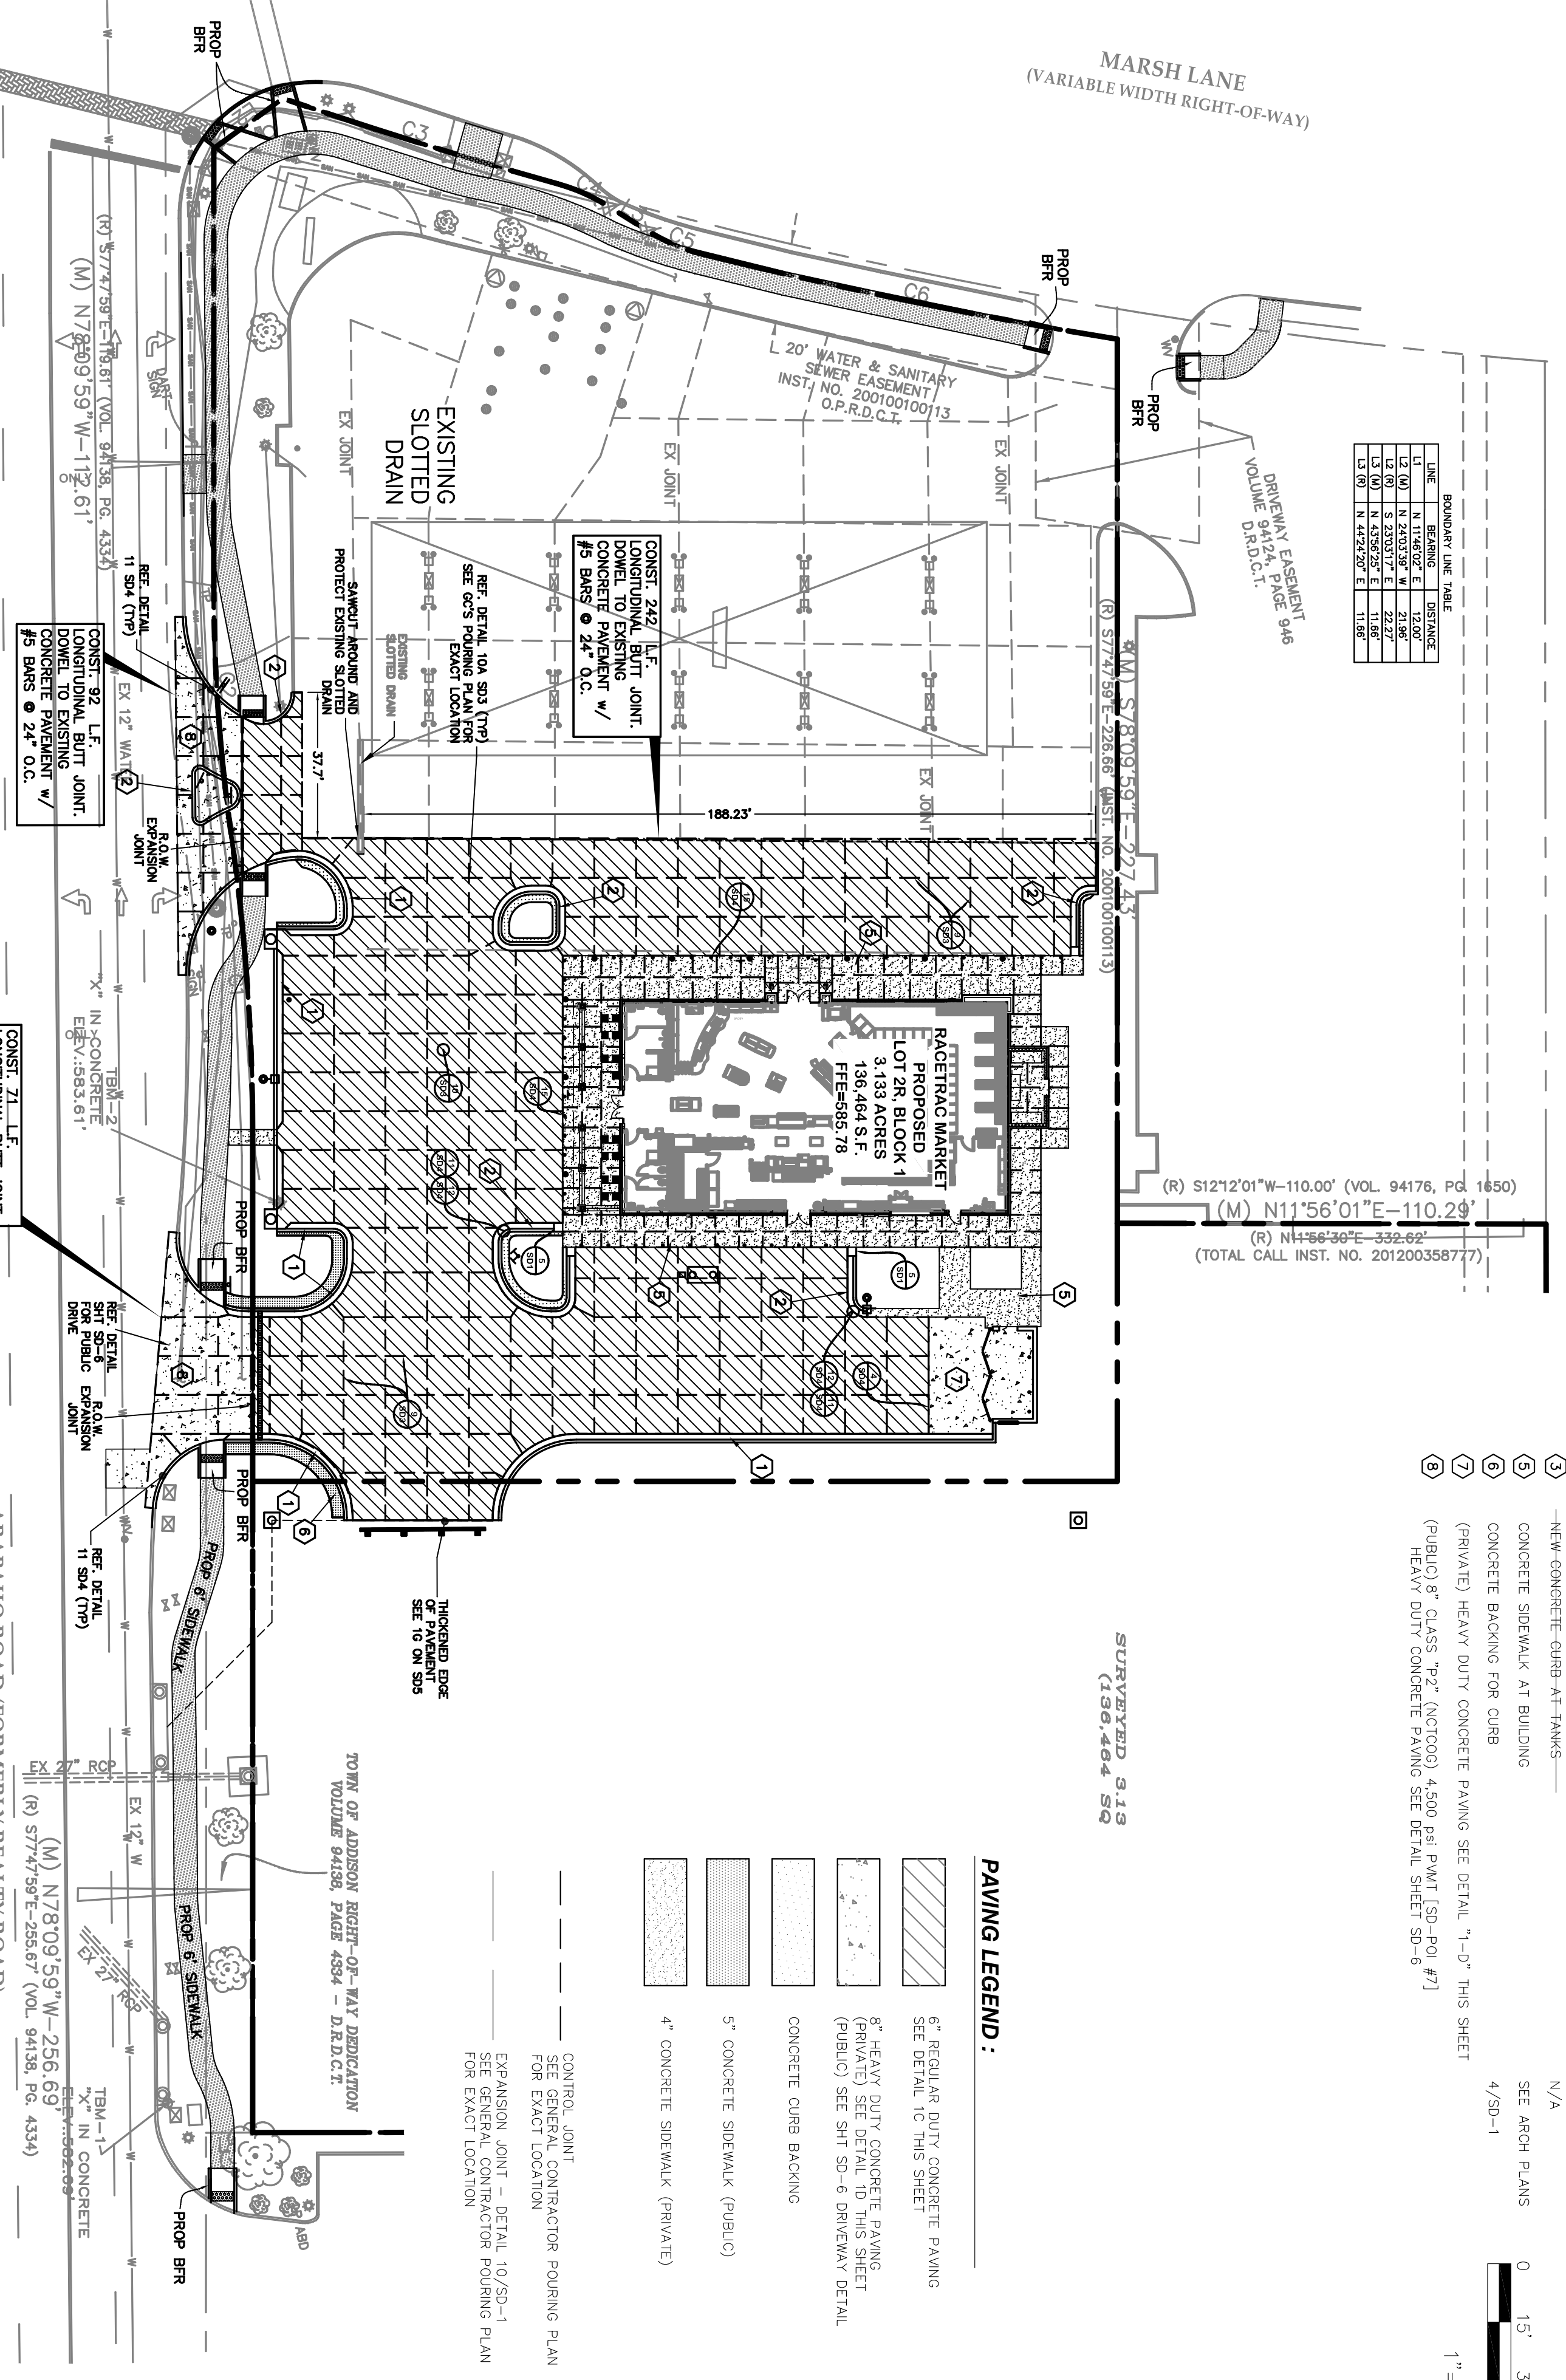

BENCHMARK
BENCHMARK NO. 1 - "X" CUT IN CONCRETE STORM INLET ON NORTH SIDE OF ARAPAHO ROAD APPROXIMATELY 575' EAST OF THE CENTERLINE INTERSECTION OF ARAPAHO ROAD AND MARSH LANE.
ELEV.: 582.69'
BENCHMARK NO. 2 - "X" CUT IN CONCRETE GRAPE INLET APPROXIMATELY 360' EAST OF THE CENTERLINE INTERSECTION OF ARAPAHO ROAD AND MARSH LANE.
ELEV.: 583.61'
ELEVATIONS ARE NAVD88 BASED ON GPS OBSERVATIONS.


- SITE NOTES AND DETAILS:**
- 1 NEW CONCRETE CATCH CURB
 - 2 NEW CONCRETE SHED CURB
 - 3 NEW CONCRETE CURB AT FAHNS
 - 4 CONCRETE SIDEWALK AT BUILDING
 - 5 CONCRETE BACKING FOR CURB
 - 6 (PRIVATE) HEAVY DUTY CONCRETE PAVING SEE DETAIL "1" OF THIS SHEET (PUBLIC) 8" CLASS "P-2" (NOTGOO) 4,500 PSI PAVT [SP-POI #7] HEAVY DUTY CONCRETE PAVING SEE DETAIL SHEET SP-6
 - 7
 - 8

(R) S121°12'01"W-110.00' (VOL. 94176, PG. 1650)
(M) N11°56'01"E-110.29'
(R) N45°36'36"E-332.62'
(TOTAL CALL INST. NO. 201200358777)

**SURVEYED 5.19
(196,464 SQ)**


- PAVING LEGEND:**
- 6" REGULAR DUTY CONCRETE PAVING SEE DETAIL "C" THIS SHEET
 - 8" HEAVY DUTY CONCRETE PAVING (PRIVATE) SEE DETAIL "D" THIS SHEET (PUBLIC) SEE SH1 SP-6 DRIVEWAY DETAIL
 - CONCRETE CURB BACKING
 - 5" CONCRETE SIDEWALK (PUBLIC)
 - 4" CONCRETE SIDEWALK (PRIVATE)

CONTROL JOINT
SEE GENERAL CONTRACTOR PAVING PLAN FOR EXACT LOCATION
EXPANSION JOINT - DETAIL TO SP-1
SEE GENERAL CONTRACTOR PAVING PLAN FOR EXACT LOCATION

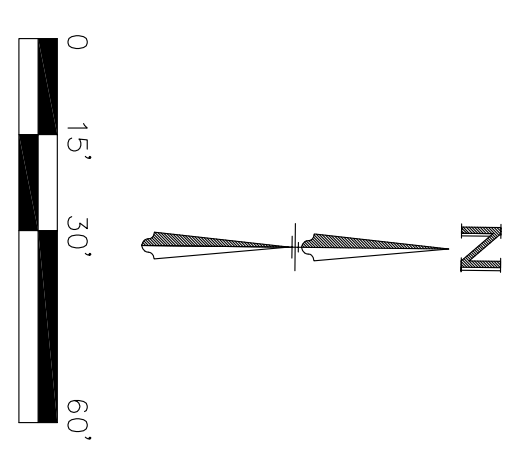

PAVING PLAN NOTES:

- STANDARD DUTY PAVEMENT AREAS SHALL BE PORTLAND CEMENT CONCRETE. DETAILS OF THE STANDARD DUTY CONCRETE PAVEMENT ARE PROVIDED ON DETAIL SHEETS.
- NOTIFY OWNER 3 DAYS PRIOR TO FOUR OF INITIAL SECTION OF DRIVEWAY PAVING. RACETRAC REPRESENTATIVE TO APPROVE INITIAL POUR.
- TESTING OF MATERIALS REQUIRED FOR THE CONSTRUCTION OF THE PAVING IMPROVEMENTS SHALL BE PERFORMED BY AN AGENCY APPROVED BY THE OWNER FOR TESTING MATERIALS. IT SHALL BE THE CONTRACTOR'S RESPONSIBILITY TO ENSURE BY THE STANDARD TESTING PROCEDURES THAT THE WORK CONSTRUCTED MEETS THE REQUIREMENTS OF THE PROJECT SPECIFICATIONS.
- ALL SIGNS, PAVEMENT MARKINGS, AND OTHER TRAFFIC CONTROL DEVICES SHALL CONFORM TO THE "MANUAL ON UNIFORM TRAFFIC CONTROL DEVICES" LATEST EDITION.
- TRAFFIC CONTROL SHALL BE IN ACCORDANCE WITH THE STATE DOT STANDARD SPECIFICATIONS FOR ROADS AND BRIDGES. CONTRACTOR SHALL REVIEW ALL TRAFFIC CONTROL DEVICES WITH DOT PRIOR TO INSTALLATION.
- CONTRACTOR SHALL FURNISH AND INSTALL ALL PAVEMENT MARKINGS FOR PARKING STALLS, HANDICAPPED PARKING SYMBOLS, AND MISCELLANEOUS STRIPING WITHIN PARKING LOT AND AROUND BUILDING.
SEE IRRIGATION PLAN AND MEP PLANS PRIOR TO PAVING FOR LOCATION OF PROPOSED SLEEVING AND CONDUITS. EXTRA CONDUIT SHALL BE PLACED UNDER DRIVEWAYS FOR FUTURE USE.
ALL HANDICAP RAMPS, STRIPING, AND PAVEMENT MARKINGS SHALL CONFORM TO THE AMERICANS WITH DISABILITIES ACT OF 1990.
- CONTRACTOR SHALL INSTALL CONSTRUCTION/EXPANSION JOINTS AT THE END OF A DAYS POUR AT ALL RADIUS POINTS. OR MAXIMUM 50' O.C. SPACING. CONTROL JOINTS SHALL BE PLACED AT MAXIMUM 15' IN BOTH DIRECTIONS.
CONTRACTOR TO SUBMIT A JOINTING PLAN TO THE CONSTRUCTION MANAGER PRIOR TO THE BEGINNING OF ANY PAVING WORK.
PAVING CONTRACTOR TO COORDINATE WITH BUILDING CONTRACTOR ON THE CONSTRUCTION AND PAVING NEAR THE SCREENING WALLS AND THE DUMPSTER PADS.
- ALL DISCREPANCIES FOUND BY CONTRACTOR RELATED TO UNDERGROUND UTILITIES OR OTHER APPROPRIANCES SHALL BE RESOLVED TO THE SATISFACTION OF OWNER AND ENGINEER PRIOR TO PLACEMENT OF ANY PAVING. CONTRACTOR SHALL ENSURE POSITIVE DRAINAGE FROM THE PROPOSED BUILDINGS AND NO PONDING IN SUBGRADE OF AREAS TO BE PAVED, AND NOTIFY OWNER AND ENGINEER IF ANY DISCREPANCIES ARE FOUND PRIOR TO INSTALLATION OF ANY PAVING.
EXISTING MANHOLE TOPS, VALVE BOXES, ETC. ARE TO BE ADJUSTED AS REQUIRED TO MATCH PROPOSED GRADES. IF NECESSARY, RE-ADJUSTMENTS SHALL BE PERFORMED UPON COMPLETION OF PAVING AND FINE GRADING TO ENSURE A SMOOTH TRANSITION.
ALL JOINTS SHALL EXTEND THROUGH THE CURB.
COMPACTION SHALL BE DONE IN ACCORDANCE WITH THE RECOMMENDATIONS OF THE GEOTECHNICAL REPORT.
ALL PAVEMENT TO BE SLOPED FOR POSITIVE DRAINAGE.

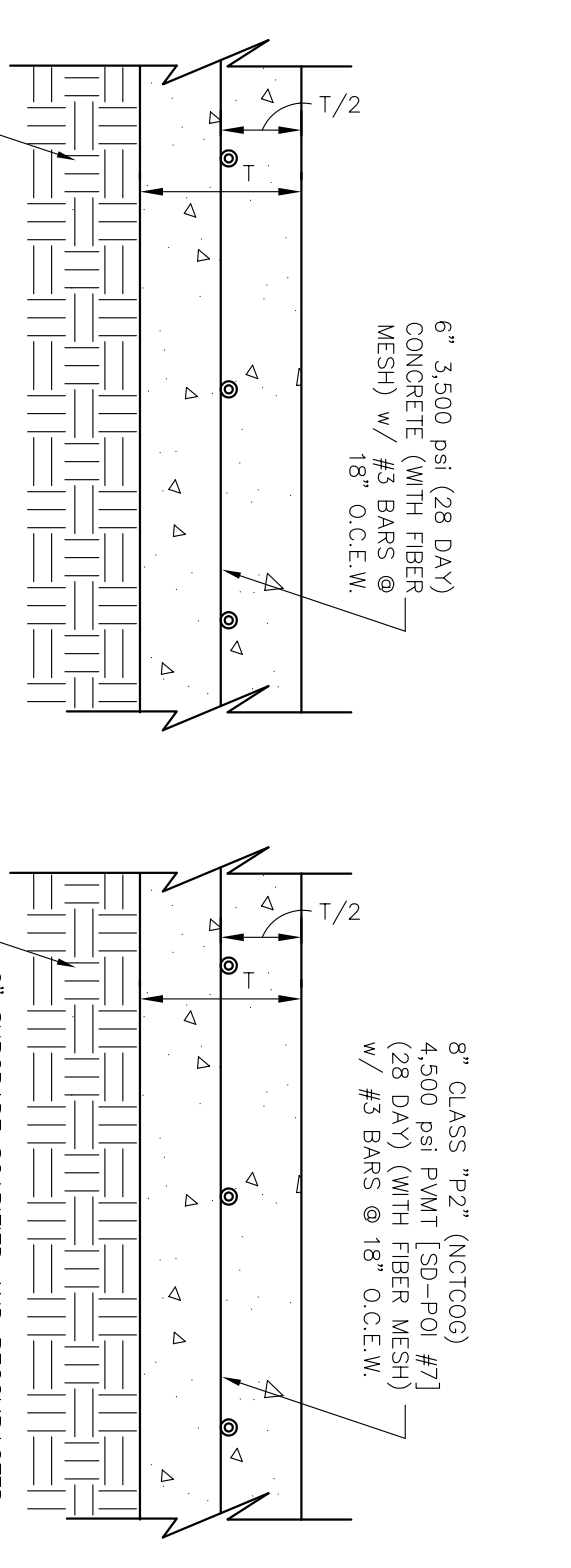


IC REINFORCED REGULAR DUTY CONCRETE PAVING
ID REINFORCED HEAVY DUTY CONCRETE PAVING

1. REFER TO GEO-TECHNICAL REPORT #03421480 BY PSI ENGINEERING DATED 02/12/2018 FOR ADDITIONAL RECOMMENDATIONS AND REQUIREMENTS. IF ANY CONFLICTS WITH THIS REPORT AND THESE DETAILS, THE MORE STRINGENT SPECIFICATION SHALL BE PLACED IN THIS REPORT AND THESE DETAILS.
2. ALL AREAS OF CONCRETE IN THE FIRE LANE ENTRANCEMENT AREAS OF CONCRETE IN THE FIRE LANE SHALL MEET OR EXCEED THE MINIMUM REQUIREMENTS OF THE TOWN OF ADDISON.
- 3.
- 4.

Line Treated Soils: Soils are soils that are treated with 6 to 8% of lime expressed as percent of the dry weight of the soil to be treated. In order to determine the percentage of lime addition, lime series testing should be performed in accordance with ASTM D6276 or TxDOT test method TEX-112-E (pH-Series). In addition, the soils should be checked for sulfates (TEX-145-E) prior to the use of lime. Lime treatment should be performed in accordance with the applicable provisions of Item 280 of the TxDOT Specification. Lime treated soils should be placed and compacted to the specifications as shown in Table 3.1.

Subgrade Soil Preparation: Based on subsurface soil information, PSI recommends that at least the upper 8 inches of these soils be treated on a subgrade soil basis. The treatment shall be in accordance with Item 280 of the TxDOT Specification. Lime treated soils should be placed and compacted to the specifications as shown in Table 3.1.

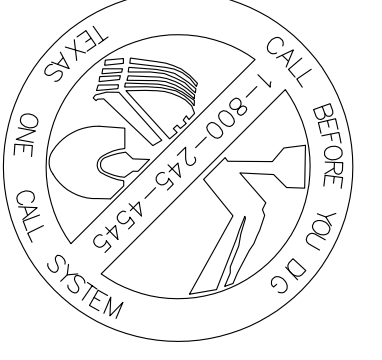

TEXAS EXCAVATION
SAFETY SERVICES
1-800-344-8377

AS-BUILTS

Trans J. Bousquet, PE
Date: May 22, 20

NO.	REVISION	DATE
8	As-Built to City	05/22/20
7	Modification to sidewalk along Arapaho	04/16/20
6	Additional Spot elevations to GC	11/07/19
5	REVISED PLANS TO TOWN	08/23/2019
4	TOWN SUBMITTAL	04/05/2019
3	TOWN SUBMITTAL	08/30/2018
2	TOWN SUBMITTAL	08/28/2018
1	TOWN SUBMITTAL	02/12/2018

Professional Engineer Registration No. F-439
698 McCarroll Road, Suite 220, Fort Worth, TX 76117-462-260-2200

RaceTrac
RACETRAC PETROLEUM, INC.
3225 CUMBERLAND BOULEVARD
SUITE 100 ATLANTA, GA 30339
(770) 431-7600

THESE PLANS ARE
SUBJECT TO FEDERAL
COPYRIGHT LAWS:
ANY USE OF SAME
WITHOUT THE
EXPRESSED WRITTEN
PERMISSION OF
RACETRAC
PETROLEUM, INC. IS
PROHIBITED.

PAVING PLAN
RACETRAC
Beltline/Marsh Business Park
Lot 2, Block 1
3.133 Ac. - Zoned: Light Retail
Addison, Texas

DATE: May 22, 20
SCALE: 1"=30'
DRAWN-BY: TJB
DRAWING NAME: PAVING PLAN

C-1.4
SHEET NO. VERSION