

CURVE	DELTA	RADIUS	LENGTH
C1 (M)	89°53'	548.00'	76.72'
C1 (R)	N 82°13'58" W	76.65'	76.65'
C2 (M)	89°53'	548.00'	76.72'
C2 (R)	N 82°13'58" W	76.65'	76.65'
C3 (M)	89°53'	548.00'	76.72'
C3 (R)	N 82°13'58" W	76.65'	76.65'
C4 (M)	89°53'	548.00'	76.72'
C4 (R)	N 82°13'58" W	76.65'	76.65'

CURVE	DELTA	RADIUS	LENGTH
C5 (M)	89°53'	548.00'	76.72'
C5 (R)	N 82°13'58" W	76.65'	76.65'
C6 (M)	89°53'	548.00'	76.72'
C6 (R)	N 82°13'58" W	76.65'	76.65'


  

CURVE	DELTA	RADIUS	LENGTH
C7 (M)	89°53'	548.00'	76.72'
C7 (R)	N 82°13'58" W	76.65'	76.65'
C8 (M)	89°53'	548.00'	76.72'
C8 (R)	N 82°13'58" W	76.65'	76.65'



  

CURVE	DELTA	RADIUS	LENGTH
C9 (M)	89°53'	548.00'	76.72'
C9 (R)	N 82°13'58" W	76.65'	76.65'

LINE	BEARING	DISTANCE
L1 (M)	N 1°46'02" E	12.80'
L1 (R)	S 2°03'17" E	22.27'
L2 (M)	N 4°24'29" E	11.86'

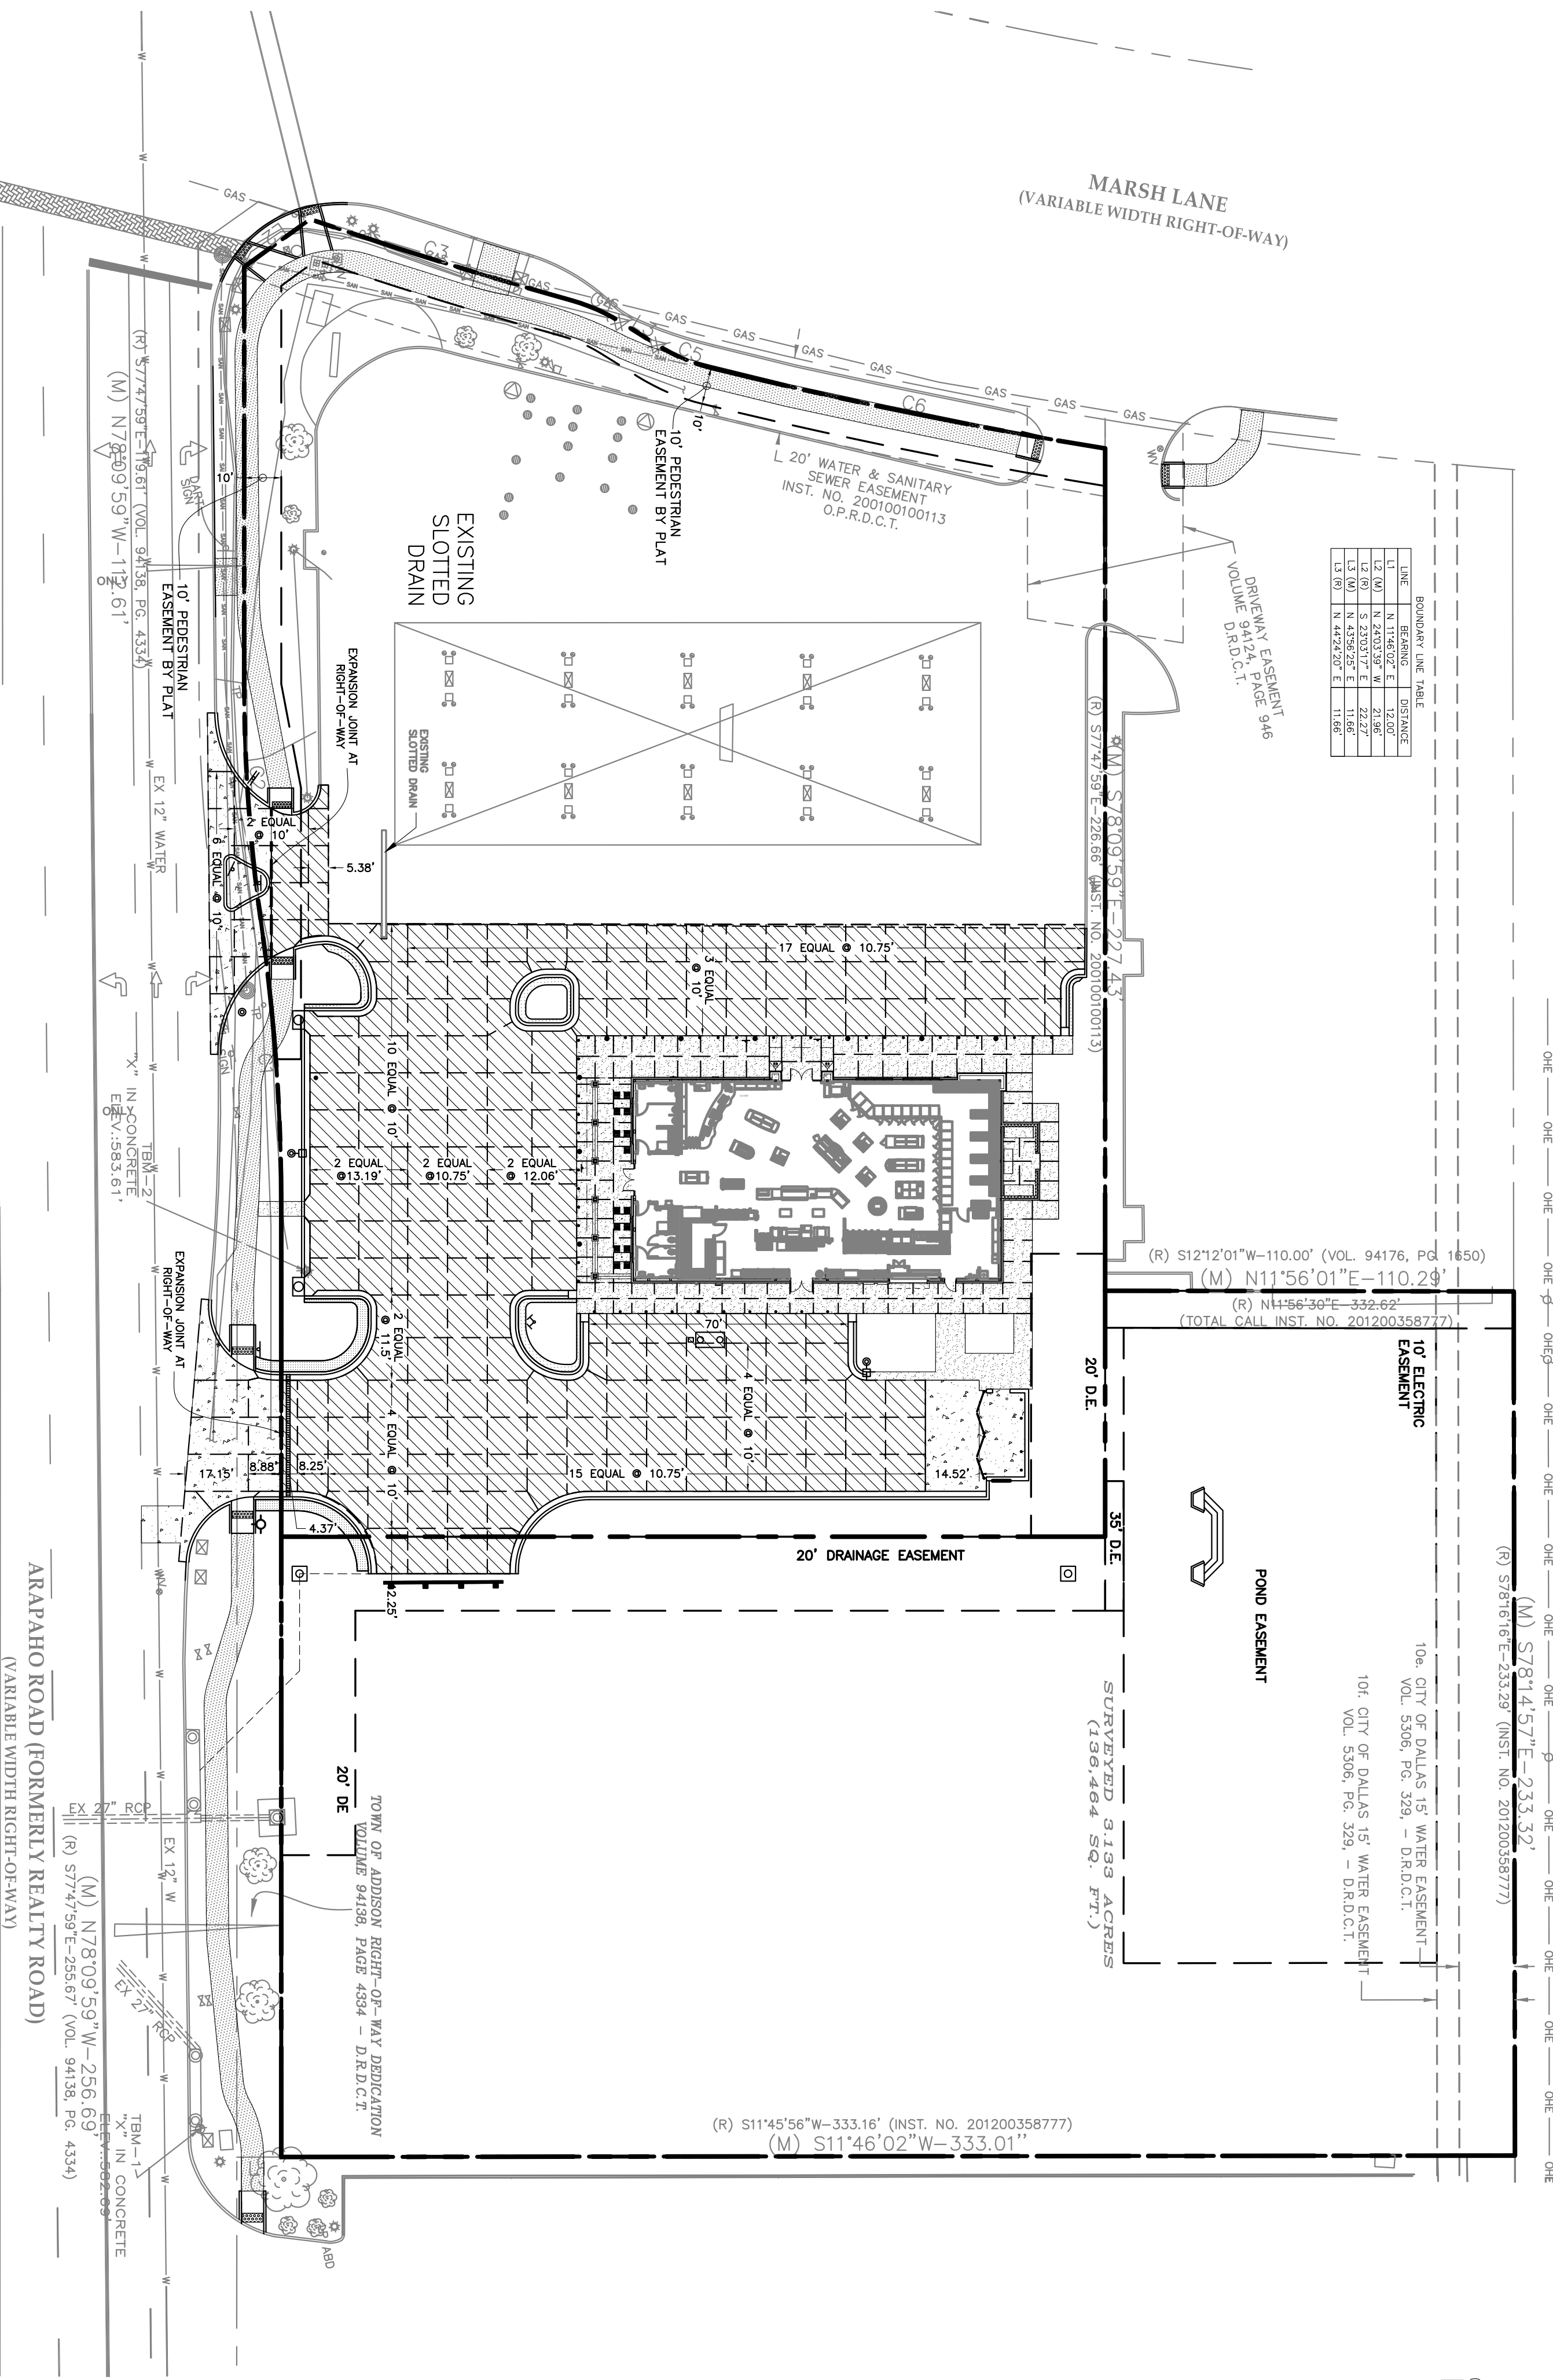

ST. LOUIS & SOUTHWESTERN RAILROAD  
(100' RIGHT-OF-WAY)

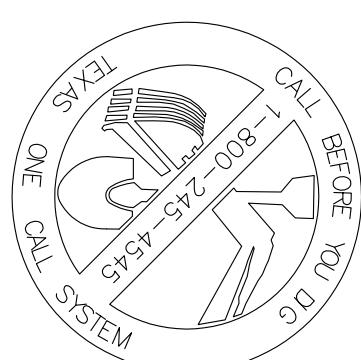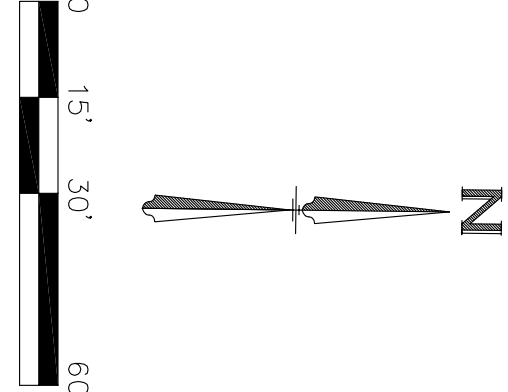

TEXAS EXCAVATION SAFETY SERVICES  
1-800-344-8377


AS-BUILTS

Travis J. Bousquet, PE  
Date: May 22, 20

<b>JOINTING PLAN</b>	
<b>RACETRAC</b>	
Beltline/Marsh Business Park Lot 2, Block 1 3.133 Ac. - Zoned: Light Retail Addison, Texas	
DATE	May 22, 20
SCALE	1"=30'
DRAWN BY	TJB
DRAWING NAME	
SHEET NO.	C-1.5
VERSION	-

**RaceTrac**  
RACETRAC PETROLEUM, INC.  
3225 CUMBERLAND BOULEVARD  
SUITE 100 ATLANTA, GA 30339  
(770) 431-7600

THESE PLANS ARE SUBJECT TO FEDERAL COPYRIGHT LAWS. ANY USE OF SAME WITHOUT THE EXPRESSED WRITTEN PERMISSION OF RACETRAC PETROLEUM, INC. IS PROHIBITED.

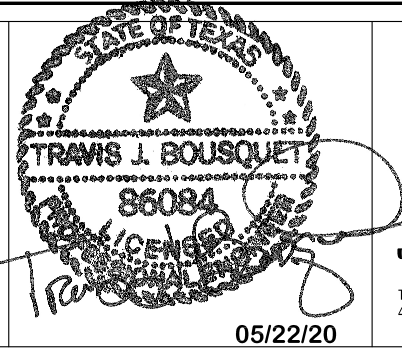

05/22/20

**JC**  
**JONES CARTER**  
Texas Board of Professional Engineers Registration No. F-439  
608 Mccordle Road Drive, Suite 200 - Fort Worth, TX 76117-462-266-200

NO.	DESCRIPTION	DATE
8	As-Builts to City	05/22/20
7	Modification to sidewalk along Arapaho	04/16/20
6	Additional Spot elevations to GC	11/07/19
5	REVISED PLANS TO TOWN	08/23/2019
4	TOWN SUBMITTAL	04/05/2019
3	TOWN SUBMITTAL	08/30/2018
2	TOWN SUBMITTAL	08/28/2018
1	TOWN SUBMITTAL	02/11/2018