

**STORM SEWER LEGEND AND NOTES:**

- PROPOSED STORM SEWER PIPE
- PROPOSED CURB INLET
- PROPOSED GRATE INLET
- ① CONNECT 6" ROOF DRAIN, SEE MEP PLANS FOR CONTINUATION OF SERVICE


STA 3+39.57 LN B  
INSTALL 5" CURB INLET  
GUTTER EL. = 582.97  
10' HOPE PIPE = 580.70  
PROP 18" (N) FL = 580.22

STA 2+67.73 LN B  
INSTALL 5" CURB INLET  
GUTTER EL. = 582.97  
10' HOPE PIPE = 580.70  
PROP 18" (N) FL = 579.86  
PROP 24" (N) FL = 579.58

AQUADUCT TRENCH DRAIN.  
SEE DETAILS PROVIDED BY  
MANUFACTURER. TRENCH TO  
BE 18" WIDE.

STA 0+00 LN A  
CONNECT TO BACK OF  
EXISTING 20" CURB INLET  
PROP 24" FL = 578.25

NOTE  
INFORMATION SHOWN FOR  
EXISTING STORM SEWER  
FROM ASPHALT ROAD PHASE  
IN PLANS DATED DEC. 2001

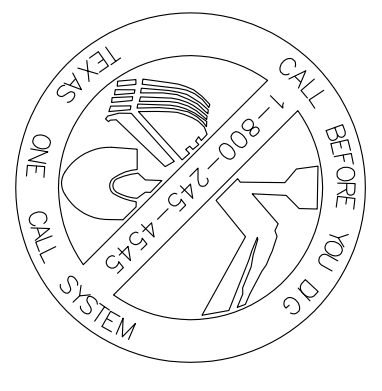

TEXAS EXCAVATION  
SAFETY SERVICES  
1-800-344-8377

**BENCH MARK**

Benchmark # 1  
CITY OF LEWISVILLE BENCH MARK #30, FOUND BRASS DISK IN  
CONCRETE 350' +/- WESTERLY OF THE INTERSECTION OF DENTON  
TAP ROAD AND WEST VISTA RIDGE MALL DRIVE.  
PUBLISHED ELEVATION = 544.62'  
TEMPORARY BENCHMARK #2  
SET MAG NAIL WITH WASHER STAMPED "JPH LAND SURVEYING"  
NEAR THE SOUTHWEST CORNER OF THE SUBJECT PROPERTY.  
ELEVATION=550.94'

**AS-BUILTS**  
Travis J. Bousoquet, PE  
May 22, '20  
Date

<b>STORM DRAIN PLAN</b>	
<b>RACETRAC</b>	
Beltline/Marsh Business Park Lot 2, Block 1 3.133 Ac. - Zoned: Light Retail Addison, Texas	
DATE	May 22, '20
SCALE	1"=30'
DRAWN-BY	TJB
DRAWING NAME	
SHEET NO.	C-2.4
VERSION	-

RACETRAC PETROLEUM, INC.  
3225 CUMBERLAND BOULEVARD  
SUITE 100 ATLANTA, GA 30339  
(770) 431-7600

THESE PLANS ARE  
SUBJECT TO FEDERAL  
COPYRIGHT LAWS.  
ANY USE OF SAME  
WITHOUT THE  
EXPRESSED WRITTEN  
PERMISSION OF  
RACETRAC  
PETROLEUM, INC. IS  
PROHIBITED.

TRAVIS J. BOUSOQUET  
85084  
PE  
05/22/20

JONES CARTER  
Texas Board of Professional Engineers Registration No. F-439  
4300 Merced Plaza Drive, Suite 220 • Fort Worth, TX 76137 • 817.268.2200

8	As-Builts to City	05/22/20
7	Modification to sidewalk along Arapaho	04/16/20
6	Additional Spot elevations to GC	11/07/19
5	REVISED PLANS TO TOWN	08/23/2019
4	TOWN SUBMITTAL	04/05/2019
3	TOWN SUBMITTAL	08/30/2018
2	TOWN SUBMITTAL	08/28/2018
1	TOWN SUBMITTAL	02/12/2018
NO.		DATE