


RACETRAC SERVICE STATION, #646

Marsh Ln. @ Arapaho Road Addison, Texas

RACETRAC PETROLEUM, INC.
300 TECHNOLOGY CT.
SMYRNA, GEORGIA 30082
(770) 330-5299 EXT. 1029
CONTACT: JULIE BOWEN

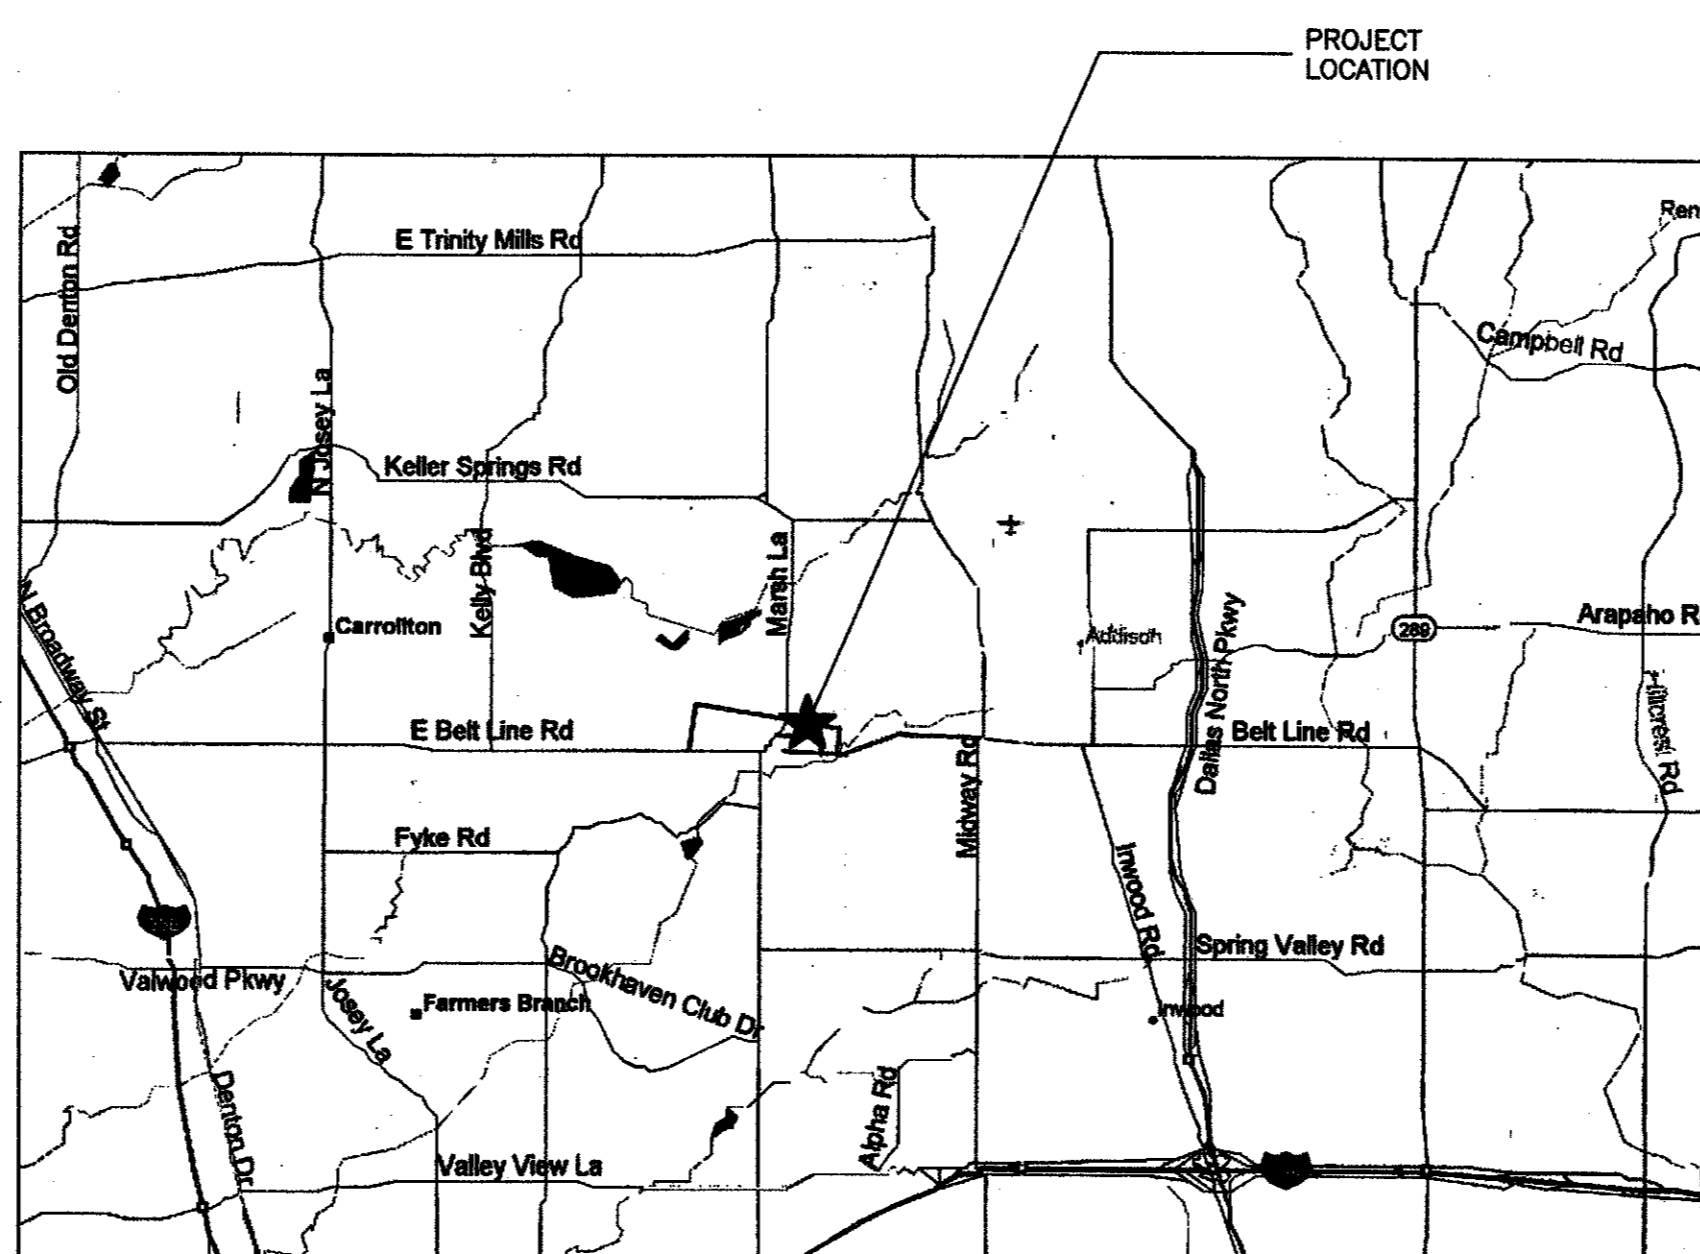


LOCATION MAP

CONTENTS

- 1 BOUNDARY & TOPOGRAPHIC SURVEY
- 2 REVISED TOPOGRAPHIC SURVEY
- 3 PLAT
- 4 C1 OF 9C DRAINAGE ANALYSIS
- 5 C2 OF 9C EROSION CONTROL PLAN
- 6 C3 OF 9C SITE LAYOUT
- 7 C4 OF 9C SITE DIMENSIONAL CONTROL PLAN
- 8 C5 OF 9C SITE PAVING PLAN
- 9 C6 OF 9C GRADING/DRAINAGE PLAN
- 10 C7 OF 9C STORM DRAIN PLAN & PROFILE
- 11 C8 OF 9C UTILITY SITE PLAN
- 12 C9 OF 9C SITE, PAVING & MISC. DETAILS
- 12 SD1 RACETRAC STANDARD DETAILS
- 13 L1 OF 5L PLANTING PLAN
- 14 L2 OF 5L IRRIGATION PLAN
- 15 L3 OF 5L LANDSCAPE/IRRIGATION DETAILS
- 16 L4 OF 5L PLANTING & GRASS SPECIFICATIONS
- 17 L5 OF 5L IRRIGATION SPECIFICATIONS

DRAWING FILE: E:\2002\000\000\2002.015.000\dwg\COVER SHEET.DWG


BHB Baird, Hampton & Brown, Inc.
Engineering & Surveying
309 W. 7th St., Ste. 500 Ft. Worth, TX 76102 Tel:(817)338-1277 Fax:(817)338-9245 E-Mail:mail@bhinc.com

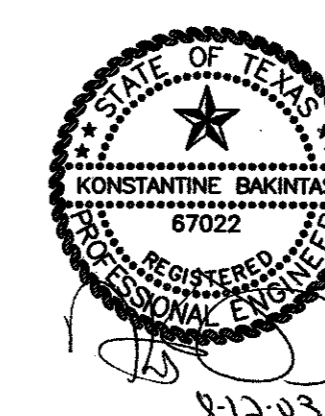

AS-BUILT DRAWINGS

THESE DOCUMENTS REFLECT AS-BUILT CONDITIONS PER INFORMATION SUBMITTED BY THE OWNER, CONTRACTOR AND/OR INSPECTING ENTITY.

Konstantine Bakintas
Konstantine Bakintas, PE

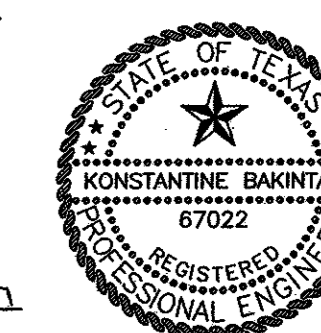

15196 MARSH LN.
RACETRAC SERVICE STATION, #646 - MARSH IN. @ ARAPAHO ROAD, ADDISON, TEXAS