

Portion of
Block 1
Belt Line/Marsh Business Park
Volume 81060, Page 170
D.R.D.C.T.

Remainder of
A. Lee Pfluger Children's Trust
Volume 95134, Page 2868
D.R.D.C.T.

LEGEND

—	EXISTING	---	PROPOSED
---	PROPERTY LINE	---	
---	DRAINAGE BOUNDARY	---	
→	FLOW DIRECTION	→	

Drainage Area	Design Storm (yr)	Area (Acres)	Runoff Coefficient 'C'	Time to Concentration (Tc)	Storm Intensity (q)	Runoff (cfs)	Comments
A	100	0.11	0.81	10	8.74	0.78	Drains East to proposed storm drain
B	100	1.01	0.81	10	8.74	7.15	Drains to Proposed Detention Basin
C	100	0.24	0.81	10	8.74	1.70	Sheet Flow to Public ROW
OFFSITE	100	0.57	0.80	10	8.74	4.02	Drains to proposed storm drain

CALCULATION FOR C

IMPERVIOUS AREA (AI) = 0.960 ACRE
PERVIOUS AREA (AP) = 0.412 ACRE
TOTAL AREA (A) = 1.372 ACRE

$C = (AP) * 0.35 + (AI) * 1.00 / 1.372 = 0.81$

DRAINAGE AREA MAP & CALCULATIONS

Detention Basin Calculations Basin Inlet Calculation

Existing Conditions

C_{PRE} = 0.35
T_c = 10 MIN
I₁₀₀ = 8.74
AREA = 1.4 ACRE
Q_{EXIST} = 4.28 CFS

18" RCP @ 0.5%
Q_{QAP} = 7.43 CFS
n = 0.013
Q₁₀₀ = 7.15 CFS
V = 4.8 FPS

Proposed Conditions

C_{PROP} = 0.81
T_c = 10 MIN
I₁₀₀ = 8.74
AREA 'A' = 0.1 ACRE
AREA 'B' = 1.0 ACRE
AREA 'C' = 0.2 ACRE

Basin Outlet Calculation



Q_{ALLOW} = 1.80 CFS
FL AT BASIN = 580.62
WSEL AT J-BOX = 582.82
BASIN WSEL₁₀₀ = 584.20
h = 3.38'
Q_{outfall} = 1.80 CFS
CALCULATED ORIFICE ϕ = 6.0"
EQUIVALENT AREA ORIFICE ϕ = 5.67"

Allowable Flow from Basin

Q_{ALLOW} = Q_{PROP} - Q_A - Q_C
Q_{ALLOW} = 4.28 - 0.78 - 1.7 = 1.8 CFS

Detention Volume

VOL = (Q_{PRE} - Q_{ALLOW}) * T_c
VOL = (9.63 - 4.3) CFS * 10min * (60 SEC/MIN)
VOL = 3,210 FT³

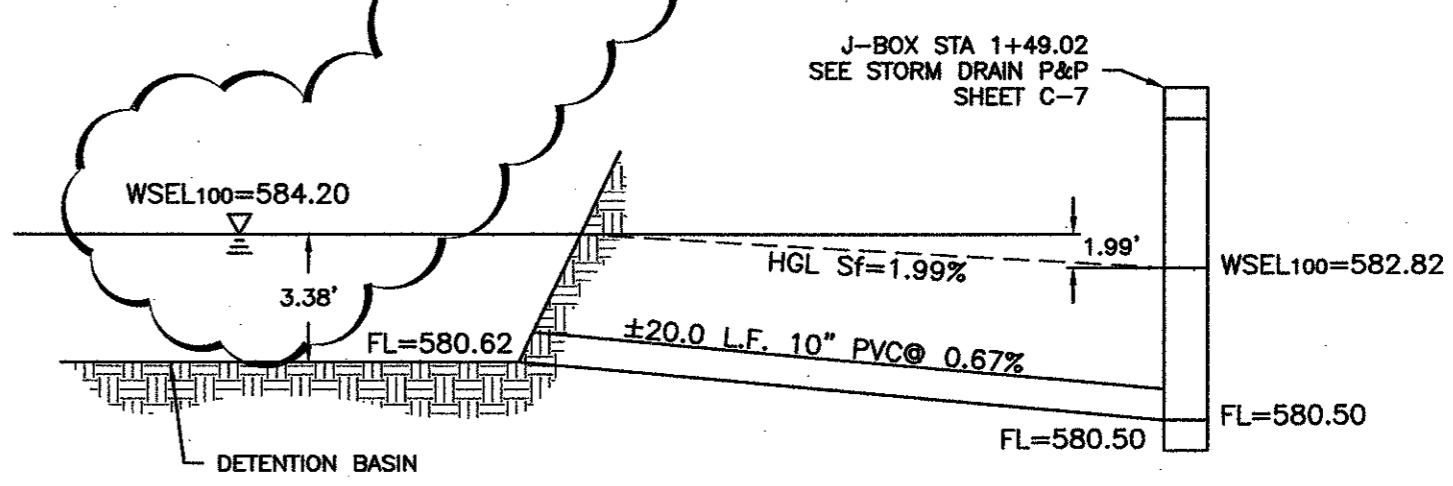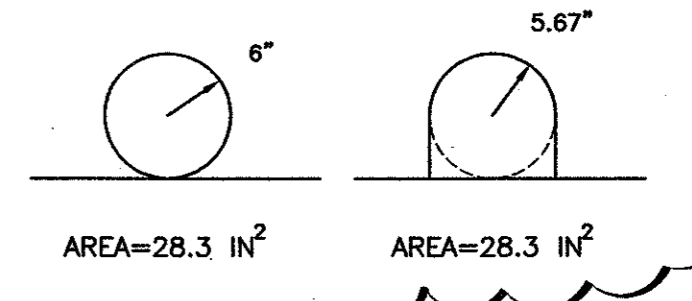

OFFSITE AREA

AREA = 0.57 ACRE
Q₁₀₀ = 4.02 CFS CFS
DRAINS TO PROPOSED STORM DRAIN

AREA A

AREA = 0.11 ACRE
Q₁₀₀ = 0.78 CFS
DRAINS EAST TO ADJACENT PROPERTY

AREA B

AREA = 1.01 ACRE
Q₁₀₀ = 7.15 CFS CFS
DRAINS TO PROPOSED DETENTION BASIN

AREA C

AREA = 0.24 ACRE
Q₁₀₀ = 1.70 CFS
DRAINS TO PUBLIC ROW

Pfluger Addition
Volume 94176, Page 1650
D.R.D.C.T.

SURI Management Corp.
Volume 98015, Page 496
D.R.D.C.T.

Driveway Easement
Volume 94124, Page 946
D.R.D.C.T.

MARSH LANE
(CONCRETE PAVEMENT)

8.0' STREET DEDICATION
20' Water & Sanitary Sewer Easement
Volume 94138, Page 4340
D.R.D.C.T.

ARAPAHO ROAD
(CONCRETE PAVEMENT)

BENCHMARK:

Square cut on the centerline of a curb inlet at the northeast corner of the intersection of Beltway Drive and Marsh Lane. Benchmark provide by the City of Addison, Texas.
Elev: 585.21

TBM

Square cut on the top of a concrete curb at the median nose located on the North side of the intersection of Realty Drive and Marsh Lane.
N: -92.45
E: -714.89
Elev: 585.15

AS-BUILT DRAWINGS

THESE DOCUMENTS REFLECT AS-BUILT CONDITIONS PER INFORMATION SUBMITTED BY THE OWNER, CONTRACTOR AND/OR INSPECTING ENTITY.

Konstantine Bakintas, PE

RaceTrac Petroleum, Inc.
300 Technology Ct.
Smyrna, GA 30082
Contact: Julie Diamond
(770) 431-7800 x129

Baird, Hampton & Brown, Inc.
Engineering & Surveying
309 W. 7th St., Ste. 300 Ft. Worth, TX 76102
Tel: (817) 338-1277 Fax: (817) 338-6246 E-Mail: baird@bhb.com

08/12/03	REVISE PRIVATE STORM DRAINAGE	DATE	08/15/00
07/17/03	ADD 60' CANOPY PER CLIENT	CHECKED:	KB
03/20/03	CLARIFY OFFSITE DRAINAGE	DRAWN:	DAH
02/03/03	REALITY DRIVE CHANGED TO ARAPAHO ROAD	DESIGNED:	DAH
		NO.	

DRAINAGE ANALYSIS

RaceTrac Service Station #646
On-Site Improvements
Marsh Ln. & Arapaho Rd.
Addison, Texas

BHB PROJECT NO:
2002.015.000

SHEET NO:
C-1 of 9C

DRAWING FILE: E:\2002.000.000.000\2002.015.000.dwg \DRAINAGE_ANALYSIS.DWG