



BELT LINE ROAD

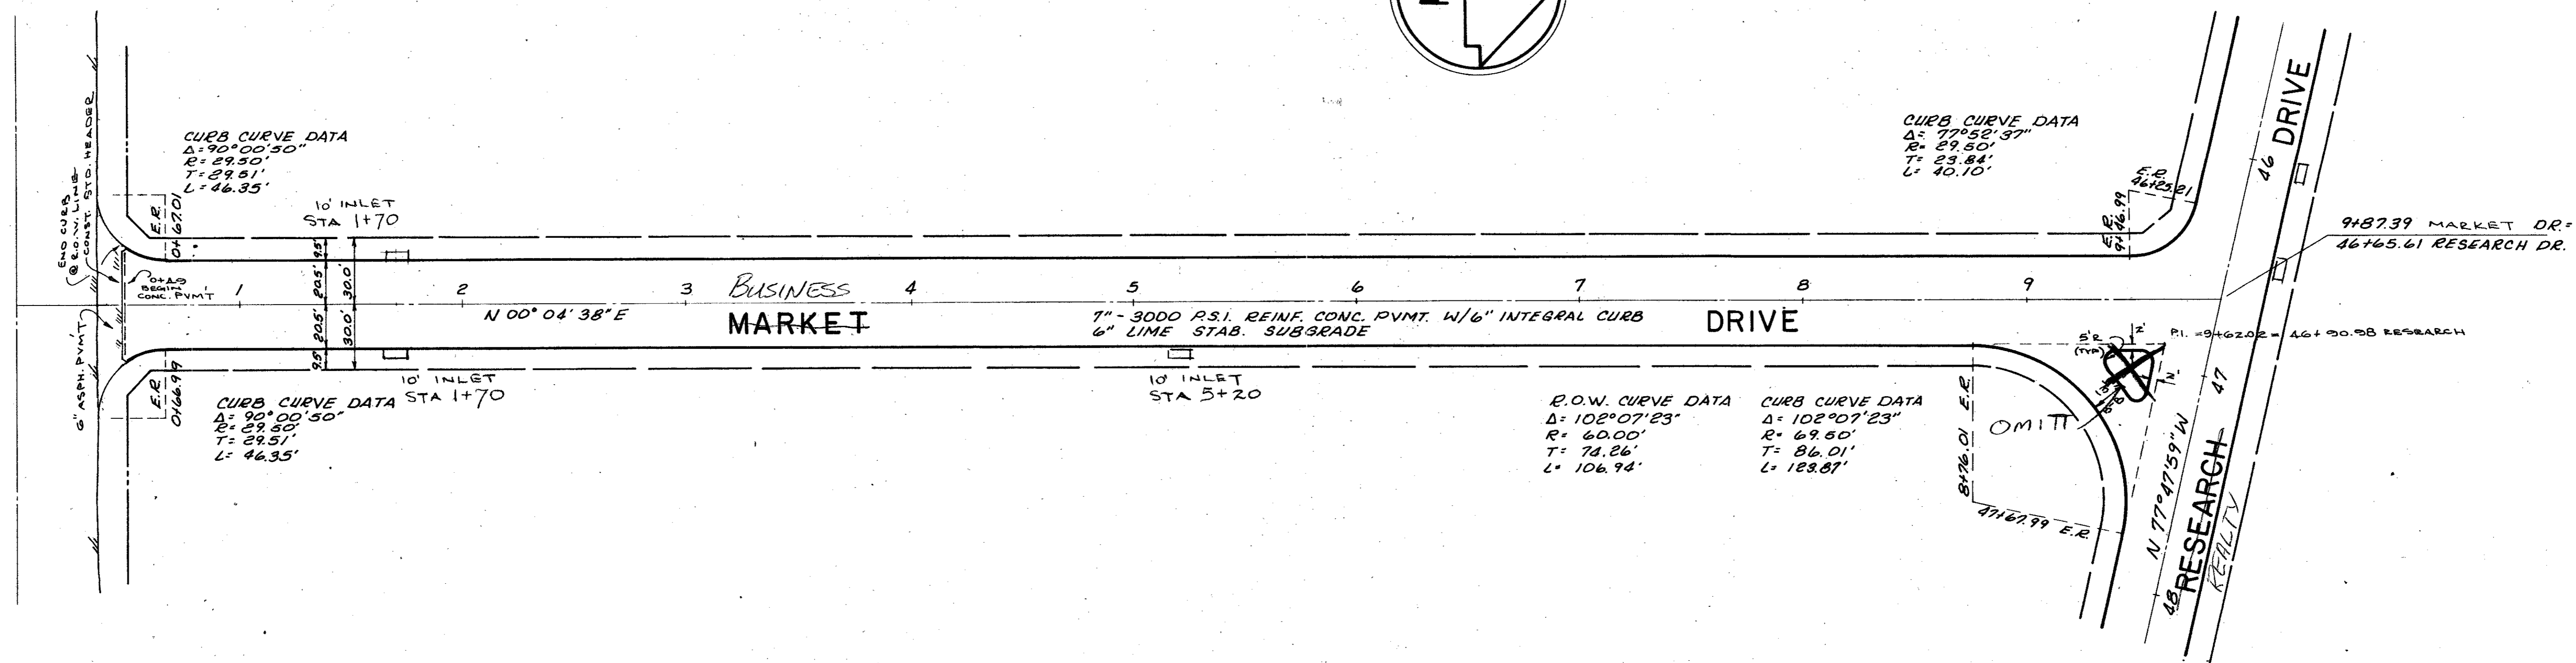

- BENCH MARK: " " on conc. East end of headwall North side Belt Line Rd. and 500' west of Southeast corner of Addition; Elev. 581.51 (set)
- BENCH MARK: R.R. Spike in P.P. North side Belt Line Rd. and 500' East of existing Marsh Lane; Elev. 579.27 (set)

NOTE: ALL DIMENSIONS ARE TO BACK OF CURB.

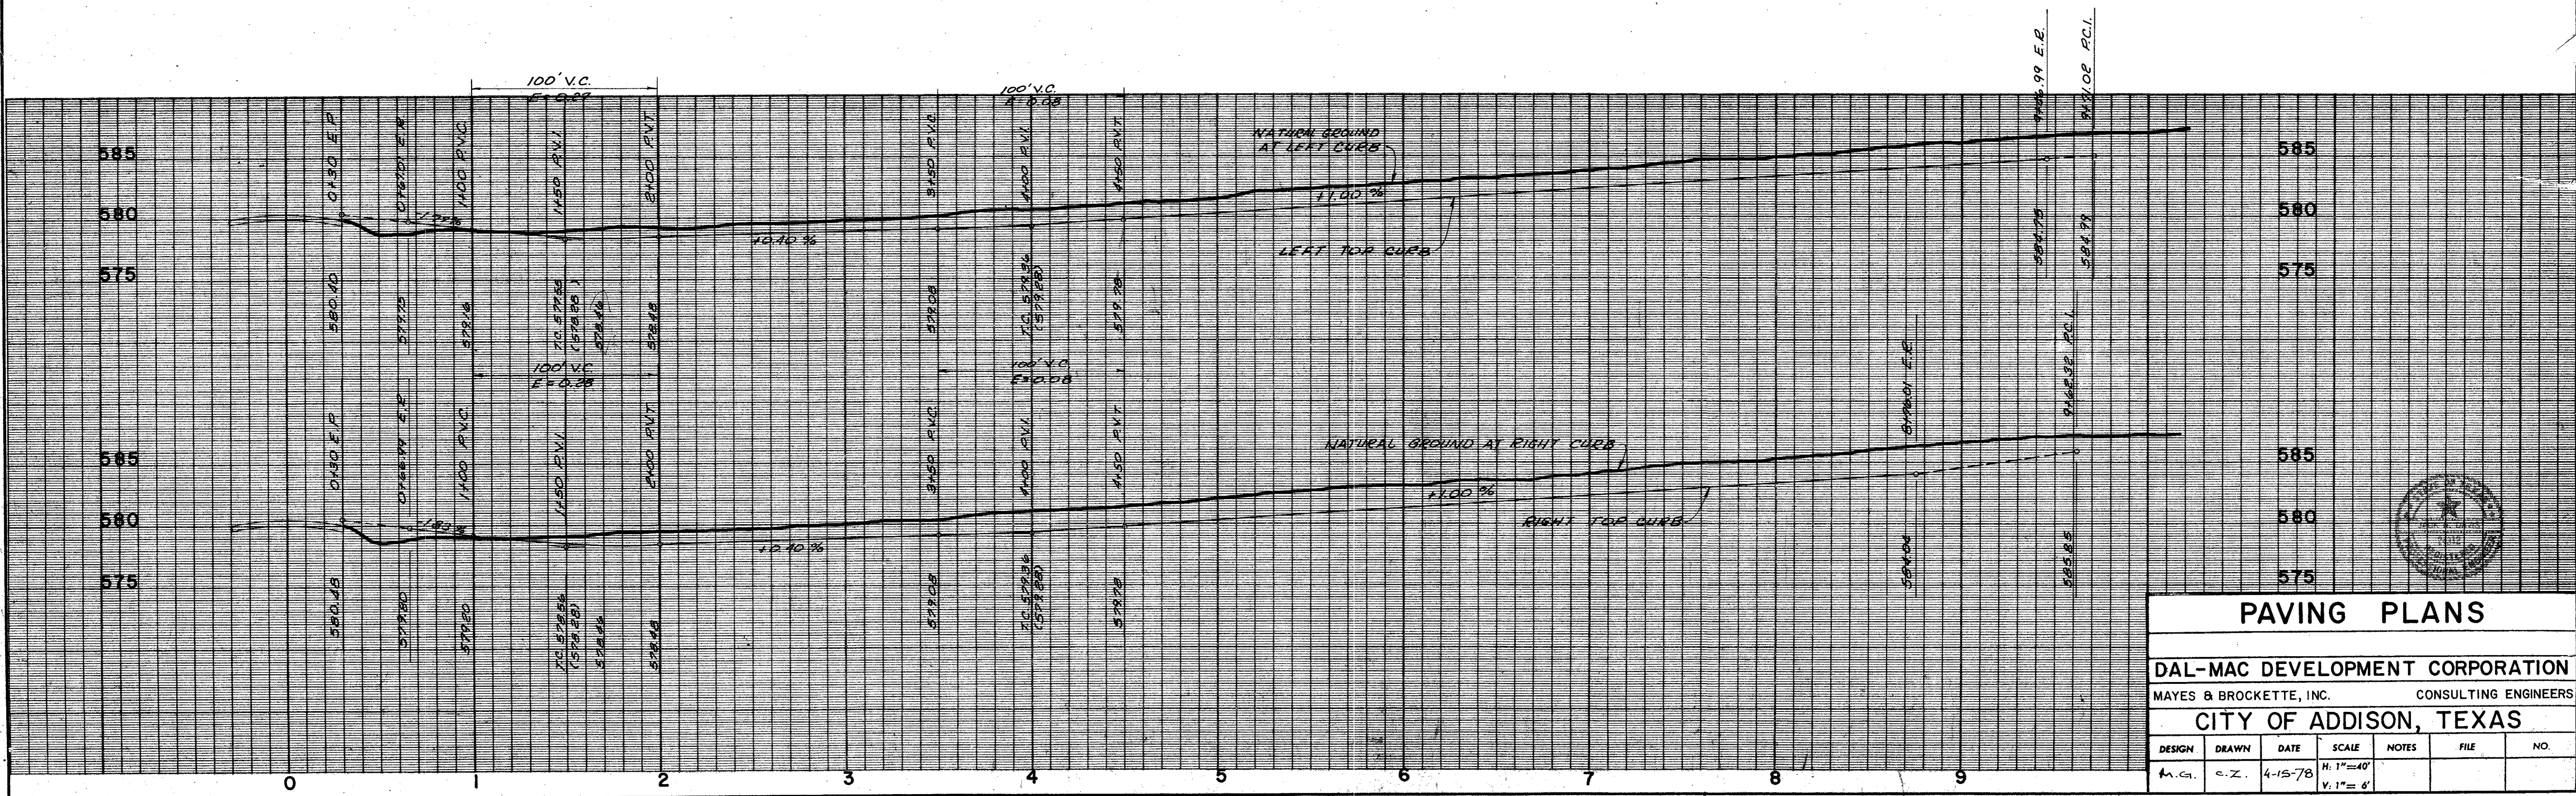

PAVING PLANS

DAL-MAC DEVELOPMENT CORPORATION
 MAYES & BROCKETTE, INC. CONSULTING ENGINEERS

CITY OF ADDISON, TEXAS

DESIGN	DRAWN	DATE	SCALE	NOTES	FILE	NO.
M.G.	E.Z.	4-15-78	H: 1"=40' V: 1"= 6'			