



20 0 20 40
 scale 1" = 20' feet

SEE SHEET 13

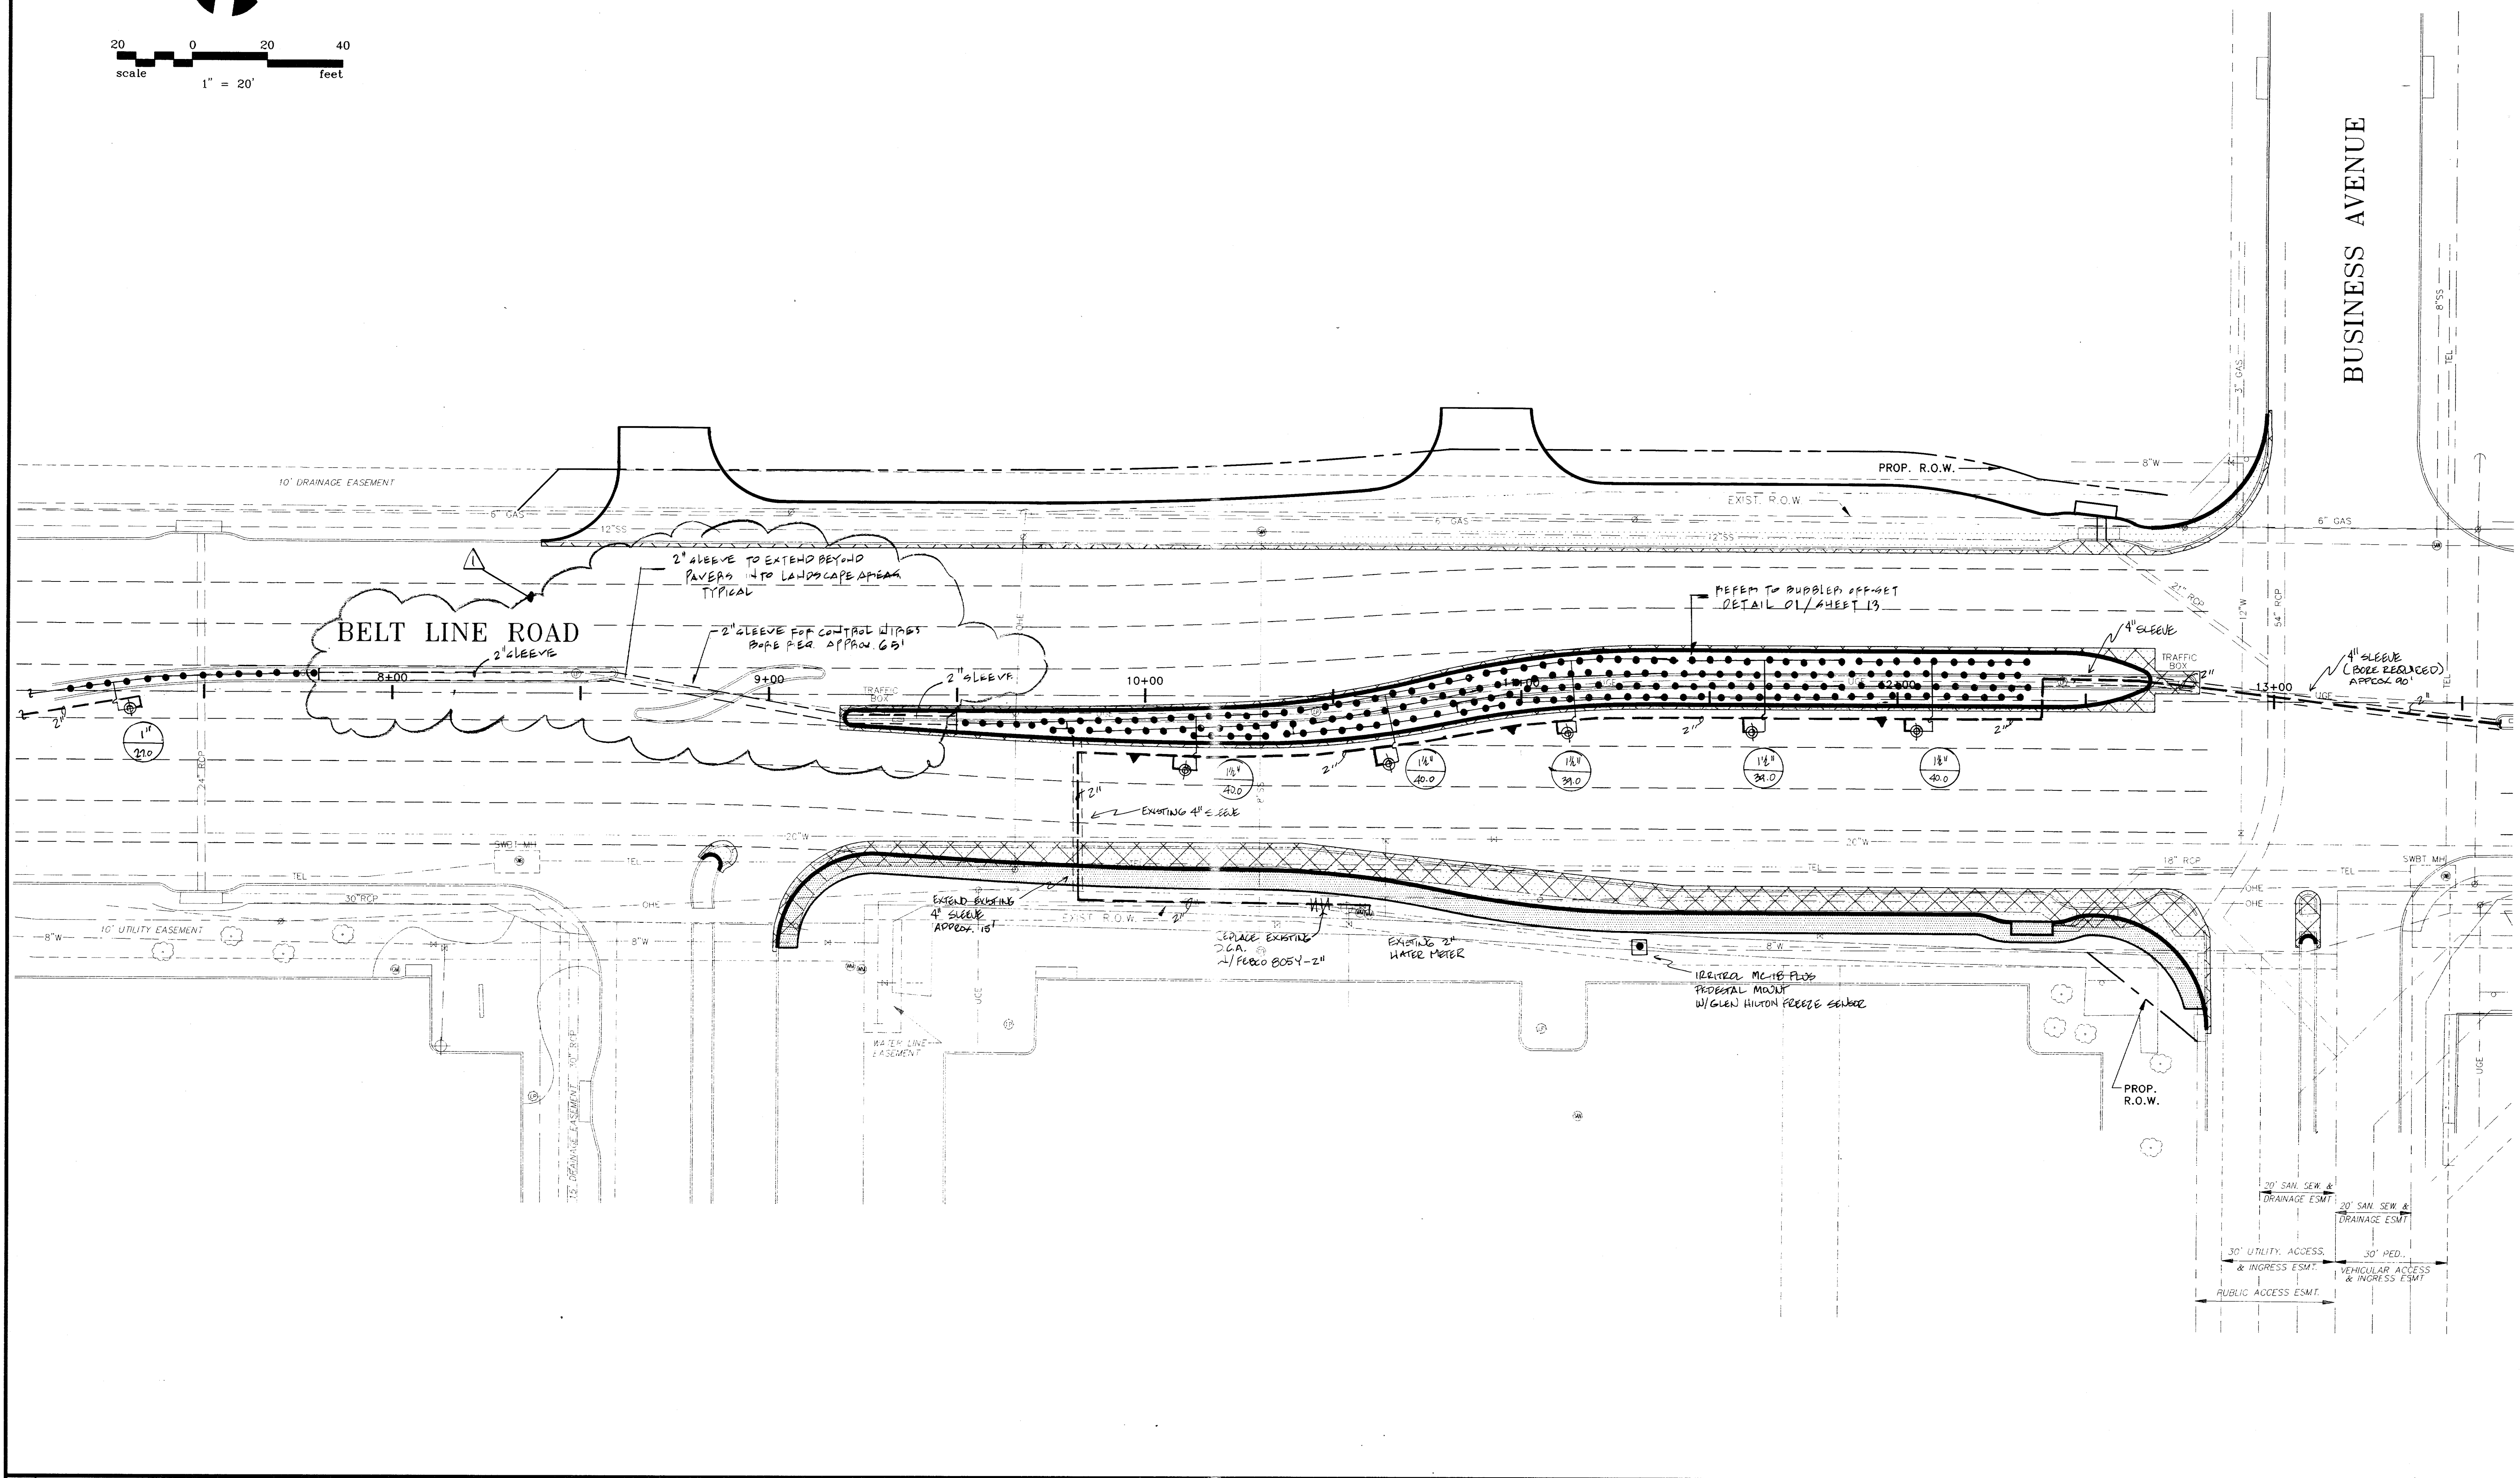

NO.	REVISION	BY	DATE
1	TOWN OF ADDISON COMMENTS	J.W.	3-9-94

DESIGNED BY: J.W.
 DRAWN BY: J.W.
 CHECKED BY: BA/SB
 SCALE: 1" = 20'
 DATE: MAR. 22, 1994
 FILE:

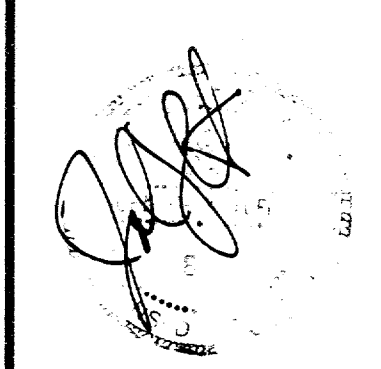

E&A **Espey, Huston & Associates, Inc.**
 Engineering & Environmental Consultants
 13800 Montfort Drive, Suite 230
 Dallas, Texas 75240 (214) 387-0771

SMR
 Landscape Architects
 703 McKinney, LB 107
 Suite 403
 Dallas, Texas 75202
 (214) 871 0083
 Steven M. Rahn, ASLA

IRRIGATION PLAN
 BELT LINE ROAD EAST OF MARSH LANE TO BUSINESS AVE.

PAVING IMPROVEMENTS
 BELT LINE ROAD AT BUSINESS AVENUE
 for
 THE TOWN OF ADDISON

SHEET NO. **22**
 OF **46** SHEETS
 JOB NO. 15411