


AREA NO.	C	I in./hr.	A Ac.	Q100 cfs.	REMARKS
A-1	0.90	11.6	1.894	19.8	
A-2	0.75	11.6	4.918	42.8	
A-3	0.90	11.6	1.858	19.4	
A-4	0.75	11.6	2.091	18.2	
A-5	0.75	11.6	1.398	12.2	
A-6	0.75	11.6	4.226	36.8	
A-7	0.90	11.6	1.286	13.4	
A-8	0.90	11.6	0.631	6.6	
B-1			9.309	75.3	TO EXIST 36" R.C.P.
B-2	0.90	11.6	2.267	23.7	
B-3	0.90	11.6	0.723	7.5	
B-4	0.90	11.6	0.373	3.9	
B-5	0.90	11.6	0.634	6.6	
B-6	0.90	11.6	4.260	44.5	
B-7	0.90	11.6	0.442	4.6	
B-8	0.90	11.6	0.867	9.1	
B-9	0.75	11.6	2.850	59.2	
	0.90		3.300		
B-10	0.75	11.6	0.382	3.5	AREA TO B-16
B-11	0.90	11.6	0.373	3.9	
B-12	0.90	11.6	0.623	6.5	
B-13	0.90	11.6	0.974	6.0	
B-14	0.75	11.6	2.860	87.9	
	0.90		0.600		
B-15	0.90	11.6	0.373	3.9	
B-16	0.75	11.6	0.683	6.1	INCLUDE AREA B-10
B-17	0.90	11.6	0.379	4.0	
B-18	0.90	11.6	1.670	17.4	
B-19	0.90	11.6	0.323	3.4	
B-20	0.90	11.6	0.389	5.1	

AREA NO.	C	I in./hr.	A Ac.	Q100 cfs.	REMARKS
C-1	0.90	11.6	0.809	8.4	
C-2	0.90	11.6	0.996	10.4	
C-3	0.75	11.6	5.251	45.7	
C-4	0.90	11.6	0.898	9.4	
*D-1	0.75	9.7	38.840	283.0	18.59 Ac. from Area M
D-2	0.90	11.6	1.515	15.8	
E-1	0.75	11.6	1.282	11.2	
E-2	0.75	11.6	1.007	8.8	
*E-3	0.75	9.7	46.213	336.0	41.22 Ac from Area M
E-4	0.75	11.6	0.344	3.0	AREA TO E-8
E-5	0.90	11.6	0.551	5.8	
E-6	0.75	11.6	1.070	9.3	
E-7	0.90	11.6	0.503	5.3	
E-8	0.75	11.6	0.697	6.1	INCLUDE AREA E-4
*M	0.75	9.7	59.770	435.0	41.22 Ac to Area E-3 18.55 Ac to Area D-1

LEGEND

- MAJOR DRAINAGE AREA
- DRAINAGE AREA DIVIDE
- (A-1) DRAINAGE AREA NO.
- PROPOSED STORM SEWER
- EXISTING STORM SEWER
- PROPOSED INLET

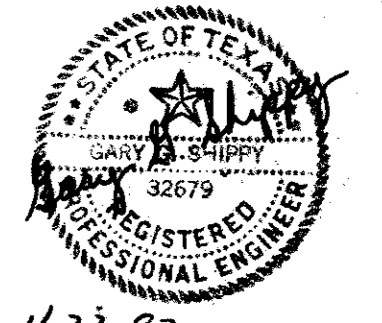

AS BUILT 11-22-83

4			
3			
2			
1			
NO.	DATE	REVISION	APPROV.
CITIES OF ADDISON AND FARMERS BRANCH, TEXAS MARSH LANE BROOKHAVEN CLUB DRIVE TO BELT LINE ROAD DRAINAGE AREA MAP			
Turner Collicott Braden Inc.			
Drawn	PAL	Scale: 1" = 200'	Date: JAN. 1982
Designed	GGG	Checked	GGG
Drawn	LJK	Approved	PAL
		Job No. 6042-010	Contract
		Sheet 25	of 66