


AS BUILT 11-22-83

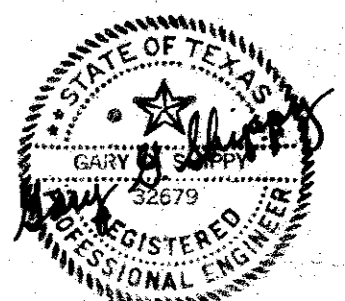

4			
3	<		
2			
①	6/82	CORRECTED DISTANCES	
NO	DATE	REVISION	APPROV.

CITIES OF ADDISON AND FARMERS BRANCH, TEXAS
MARSH LANE
 BROOKHAVEN CLUB DRIVE TO BELT LINE ROAD
PROJECT LOCATION MAP
AND TRAVERSE TIES

Turner Collie Braden Inc.

Unit	P.A.L.	Scale:	Horz. 1" = 100'	Date	FEB, 1982
Designed	G.G.S.	Checked	G.G.S.	Job No.	6042-010 contract
Drawn	L.J.K.	Approved	PAL	Sheet	2 of 68