


ITEM	DESCRIPTION	UNIT	QTY.
465&SP	21" RCP	L.F.	71
470&SP	10' Std Inlet	Each	2
479	Manhole Type "M" Adj	Each	1
SS-6	Adj Water Valve Box	Each	2
SS-13	Misc. San Sewer Adj	Each	1

B.M. No. 14
 "X" CUT TOP FLANGE BOLT EAST SIDE HYD. BETWEEN "CHATANOGA" AND "TENN." 60' W. OF MARSH ON SOUTH SIDE BELT LINE ROAD. ELEV. 570.85

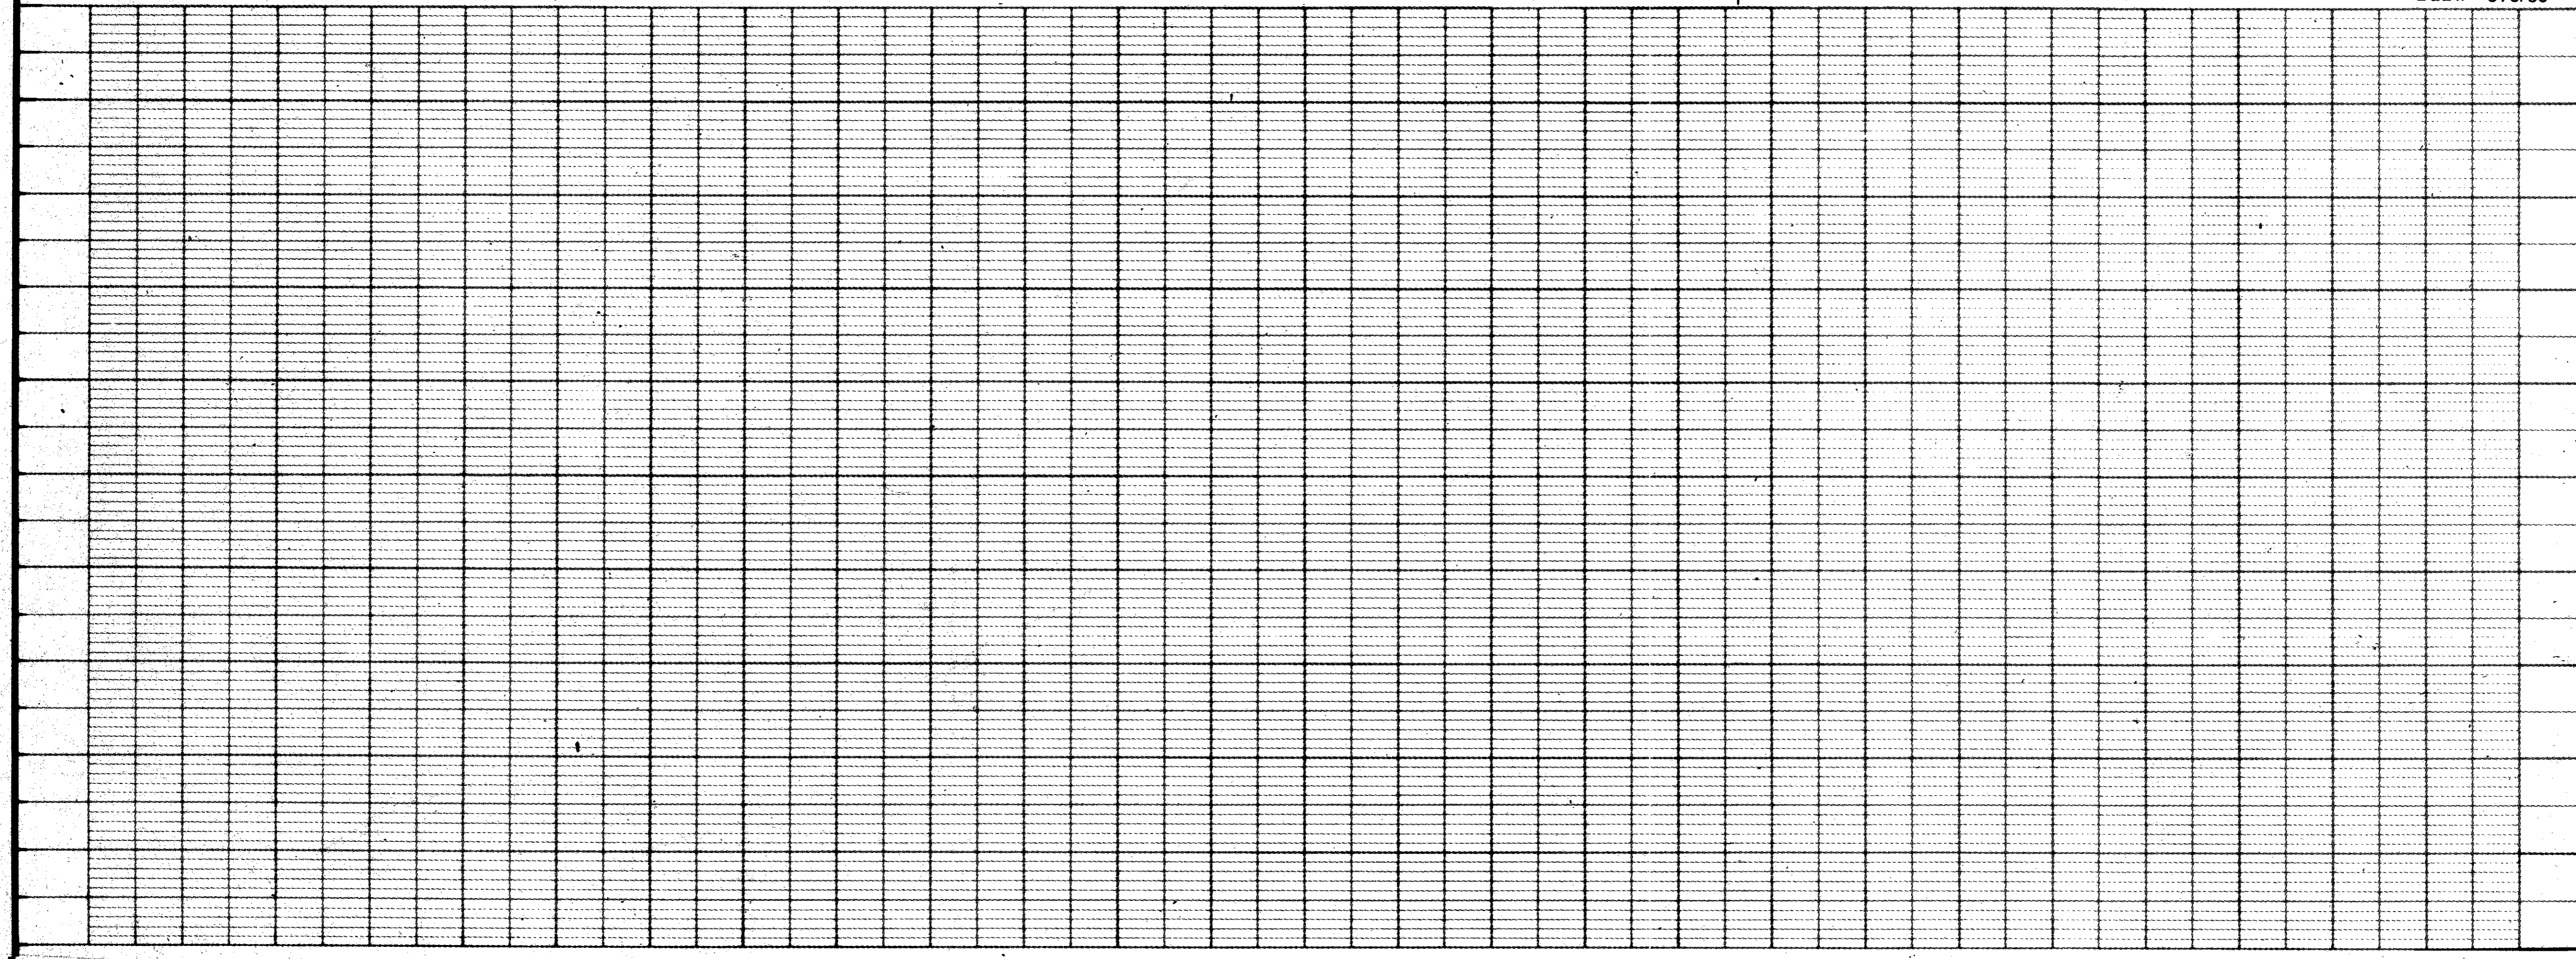

AS BUILTS 11-22-83

NO.	DATE	REVISION	APPROV.
1	8/82	REVISED PER CHANGE ORDER N° 1.	

CITIES OF ADDISON AND FARMERS BRANCH, TEXAS
MARSH LANE
 BROOKHAVEN CLUB DRIVE TO BELT LINE ROAD
DRAINAGE PLAN
LINE "K"

Turner Collie & Braden Inc.			
Unit	PAL	Scale: Horiz. 1" = 20' Vert. 1" = 5'	Date FEB. 1982
Designer	GGG	Checker	Job No. 6042-010
Drawn	GG	Approved	Sheet 46 of 66