

DELTA=08°32'58"
 R=309.50
 L=46.18
 T=23.13
 LC=46.14
 CB=N 07°39'51" E

DELTA=03°41'52"
 R=590.50
 L=38.11
 T=19.06
 LC=38.10
 CB=N 10°05'33" E

MARSH LANE
 VARIABLE WIDTH R.O.W.

BELT LINE ROAD
 VARIABLE WIDTH R.O.W.

DRAINAGE CRITERIA

Q = C I A
 C = 0.90
 I₁₀₀ = 8.88 in/hr
 tc = 10 min.

1.60 → Acres
 8.8 → Q₁₀₀ in cfs

LEGEND

---550--- Existing Contour
 [50] Proposed Contour
 → Flow Arrow
 --- Existing Curb
 --- Proposed Curb
 - - - - - Drainage Divide Line


AS-BUILT

NOTE:
 THESE PLANS HAVE BEEN REVISED
 TO CONFORM WITH CONSTRUCTION
 RECORDS PROVIDED BY CONTRACTOR.

DRAINAGE AREA MAP
 MARSH / BELT LINE SHOPPING CENTER
 TOWN OF ADDISON
 DALLAS COUNTY, TEXAS

BROCKETTE · DAVIS · DRAKE , inc.
 consulting engineers
 Civil & Structural Engineering · Surveying
 4144 North Central Expressway, Suite 1100 Dallas, Texas 75204
 (214)824-3647, fax (214) 824-7064

DESIGN	DRAWN	DATE	SCALE	NOTES	FILE	NO.
JAR	FG	7/24/00	1"=40'	BDD	C99158	C-4

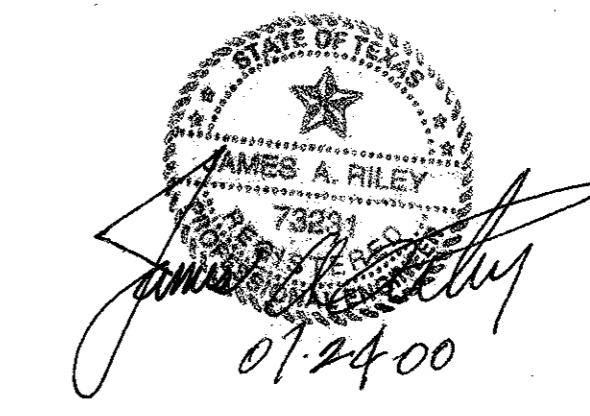

Marsh Belt Line/dmap-rnb.dwg