

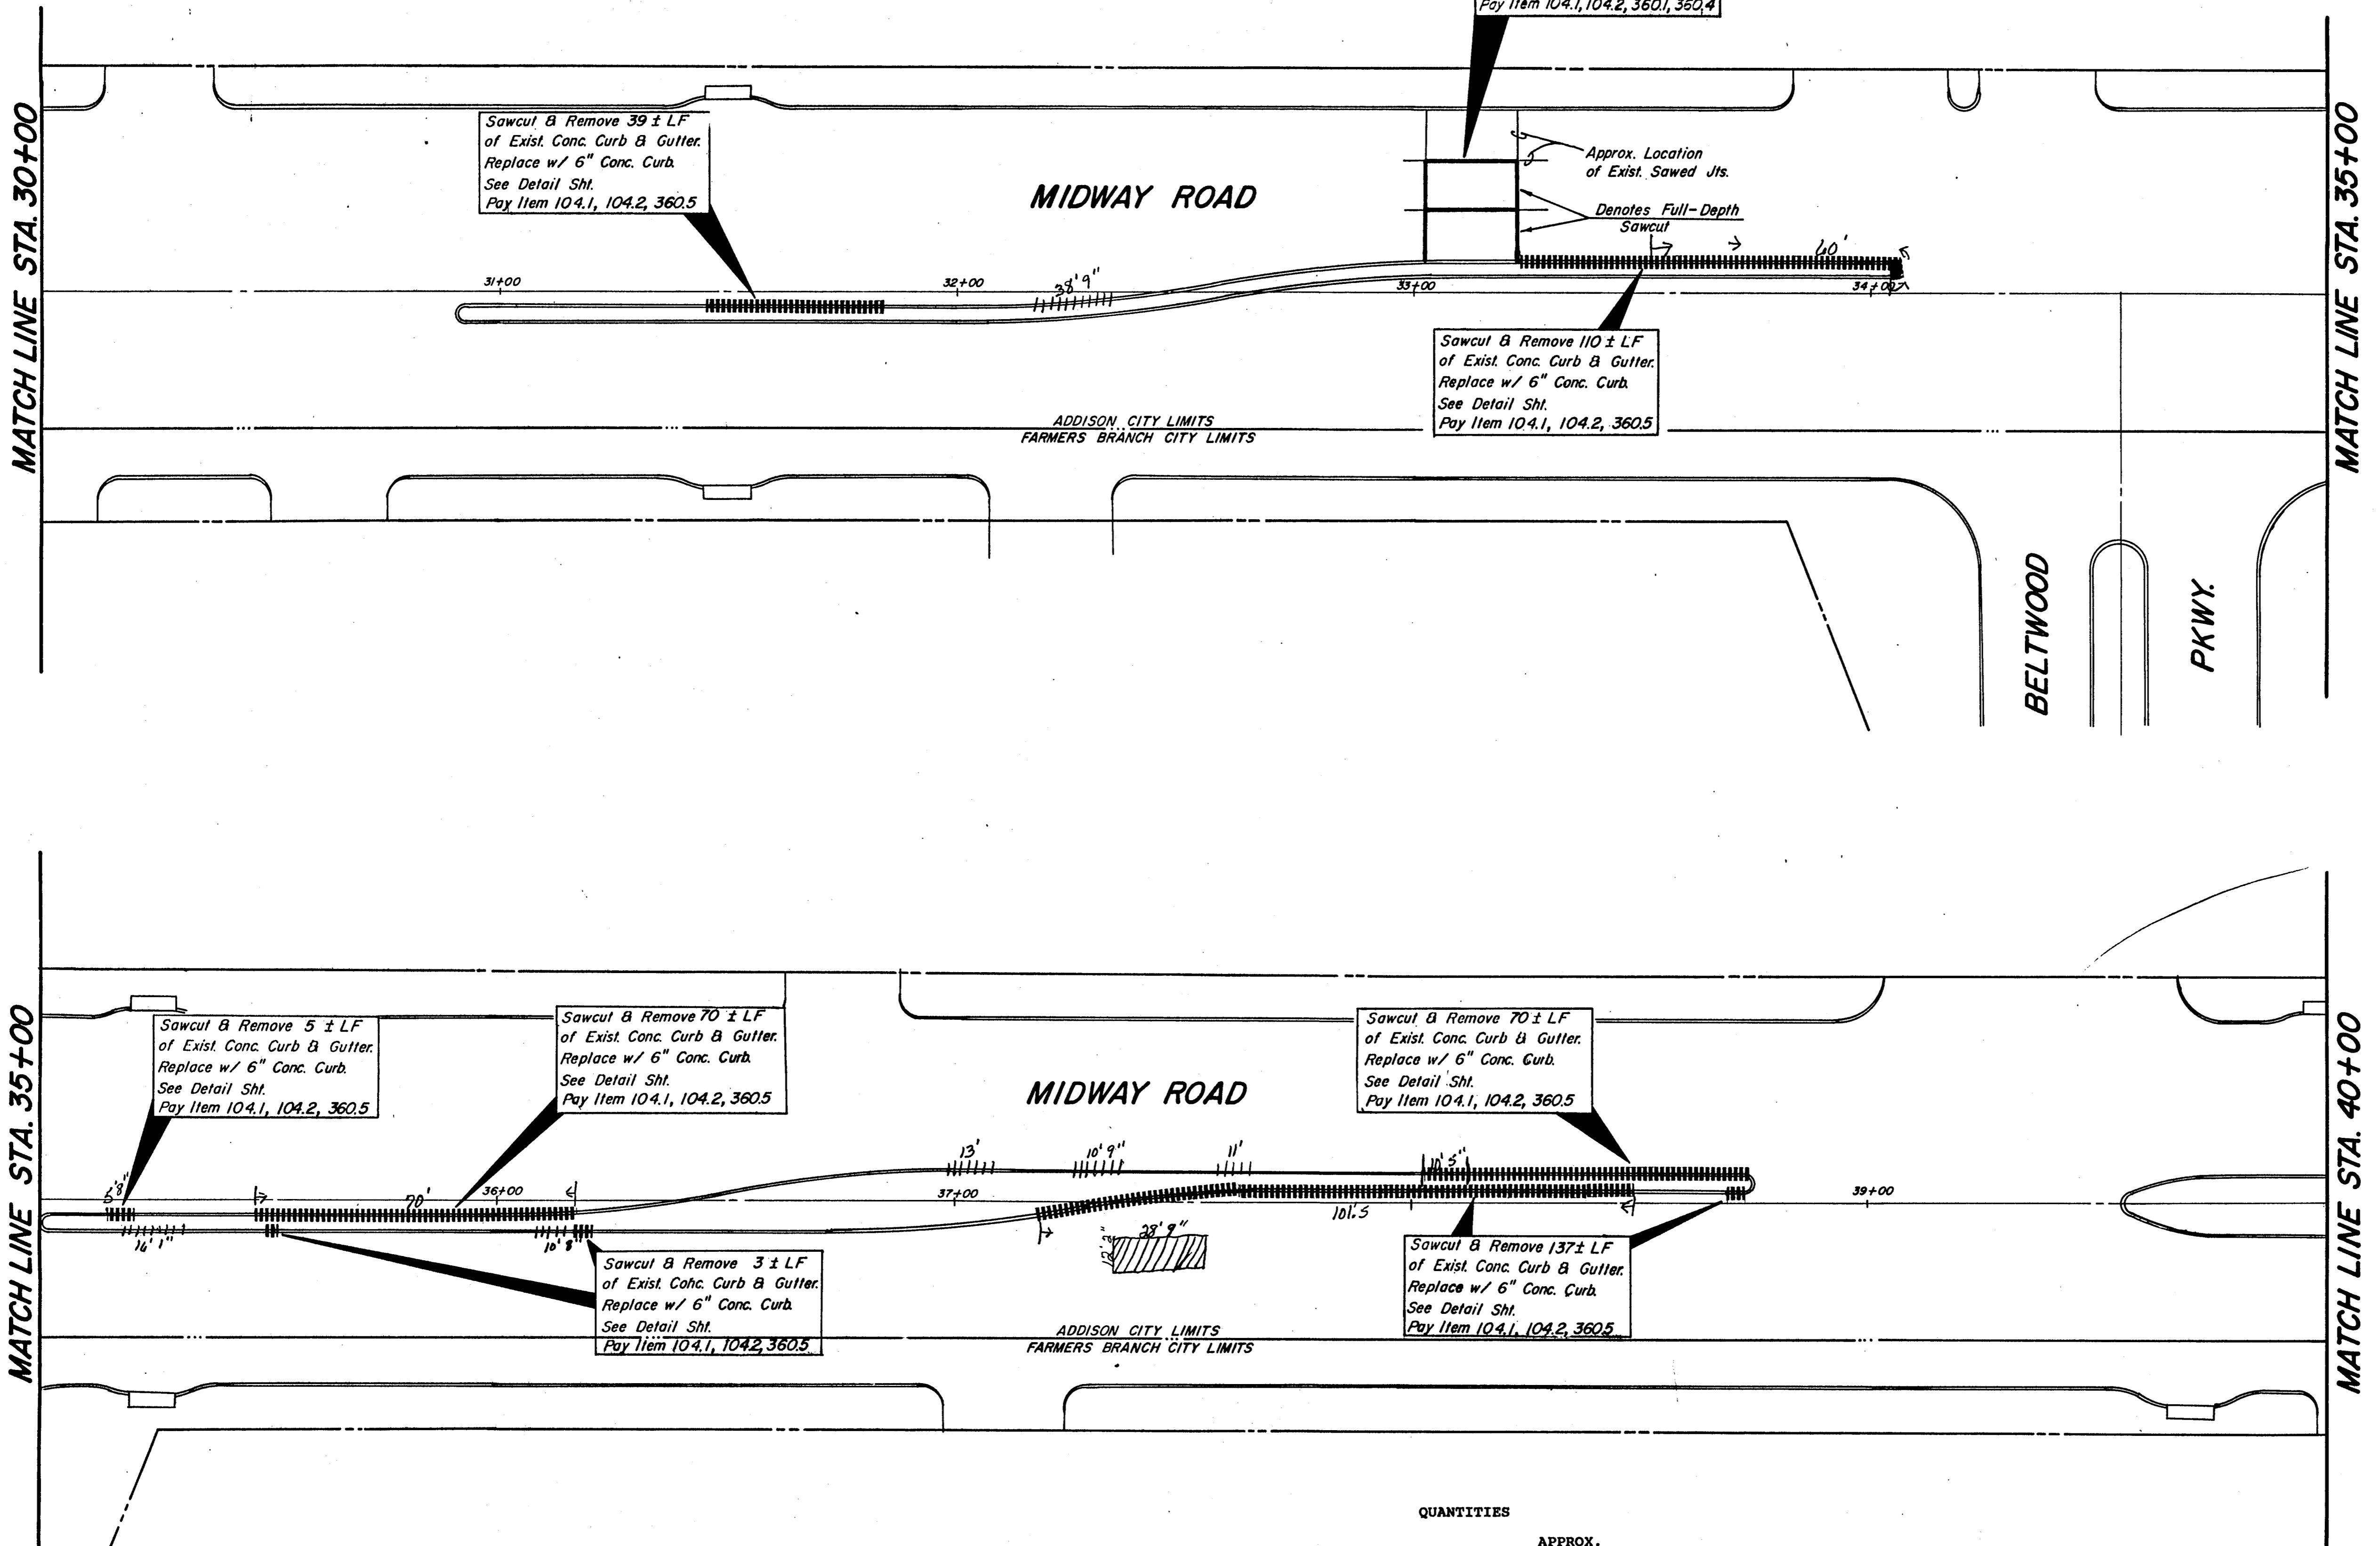


E MET
 0.75
 0.25
 2.0

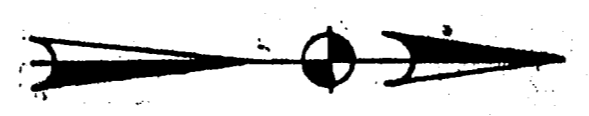

RECORD DRAWING

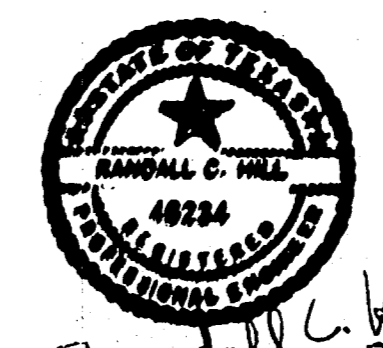

Randall C. Hill
 10-8-88

C-6

No.	Revision	By	Date
TOWN OF ADDISON DALLAS COUNTY, TEXAS			
MISC. PAVEMENT IMPROVEMENTS			
MIDWAY ROAD STA. 30+00 to STA. 40+00			
GINN, INC. Consulting Engineers Dallas, Texas			
Designed - RCH	Drawn - DEM	Date - JULY, 1988	Job No. - 87372
Approved - HWG	Checked - RCH	Scale - 1" = 20'	Sheet 6 of 16