



HES 2:17
 18- 4:0 PM
 20 Ro

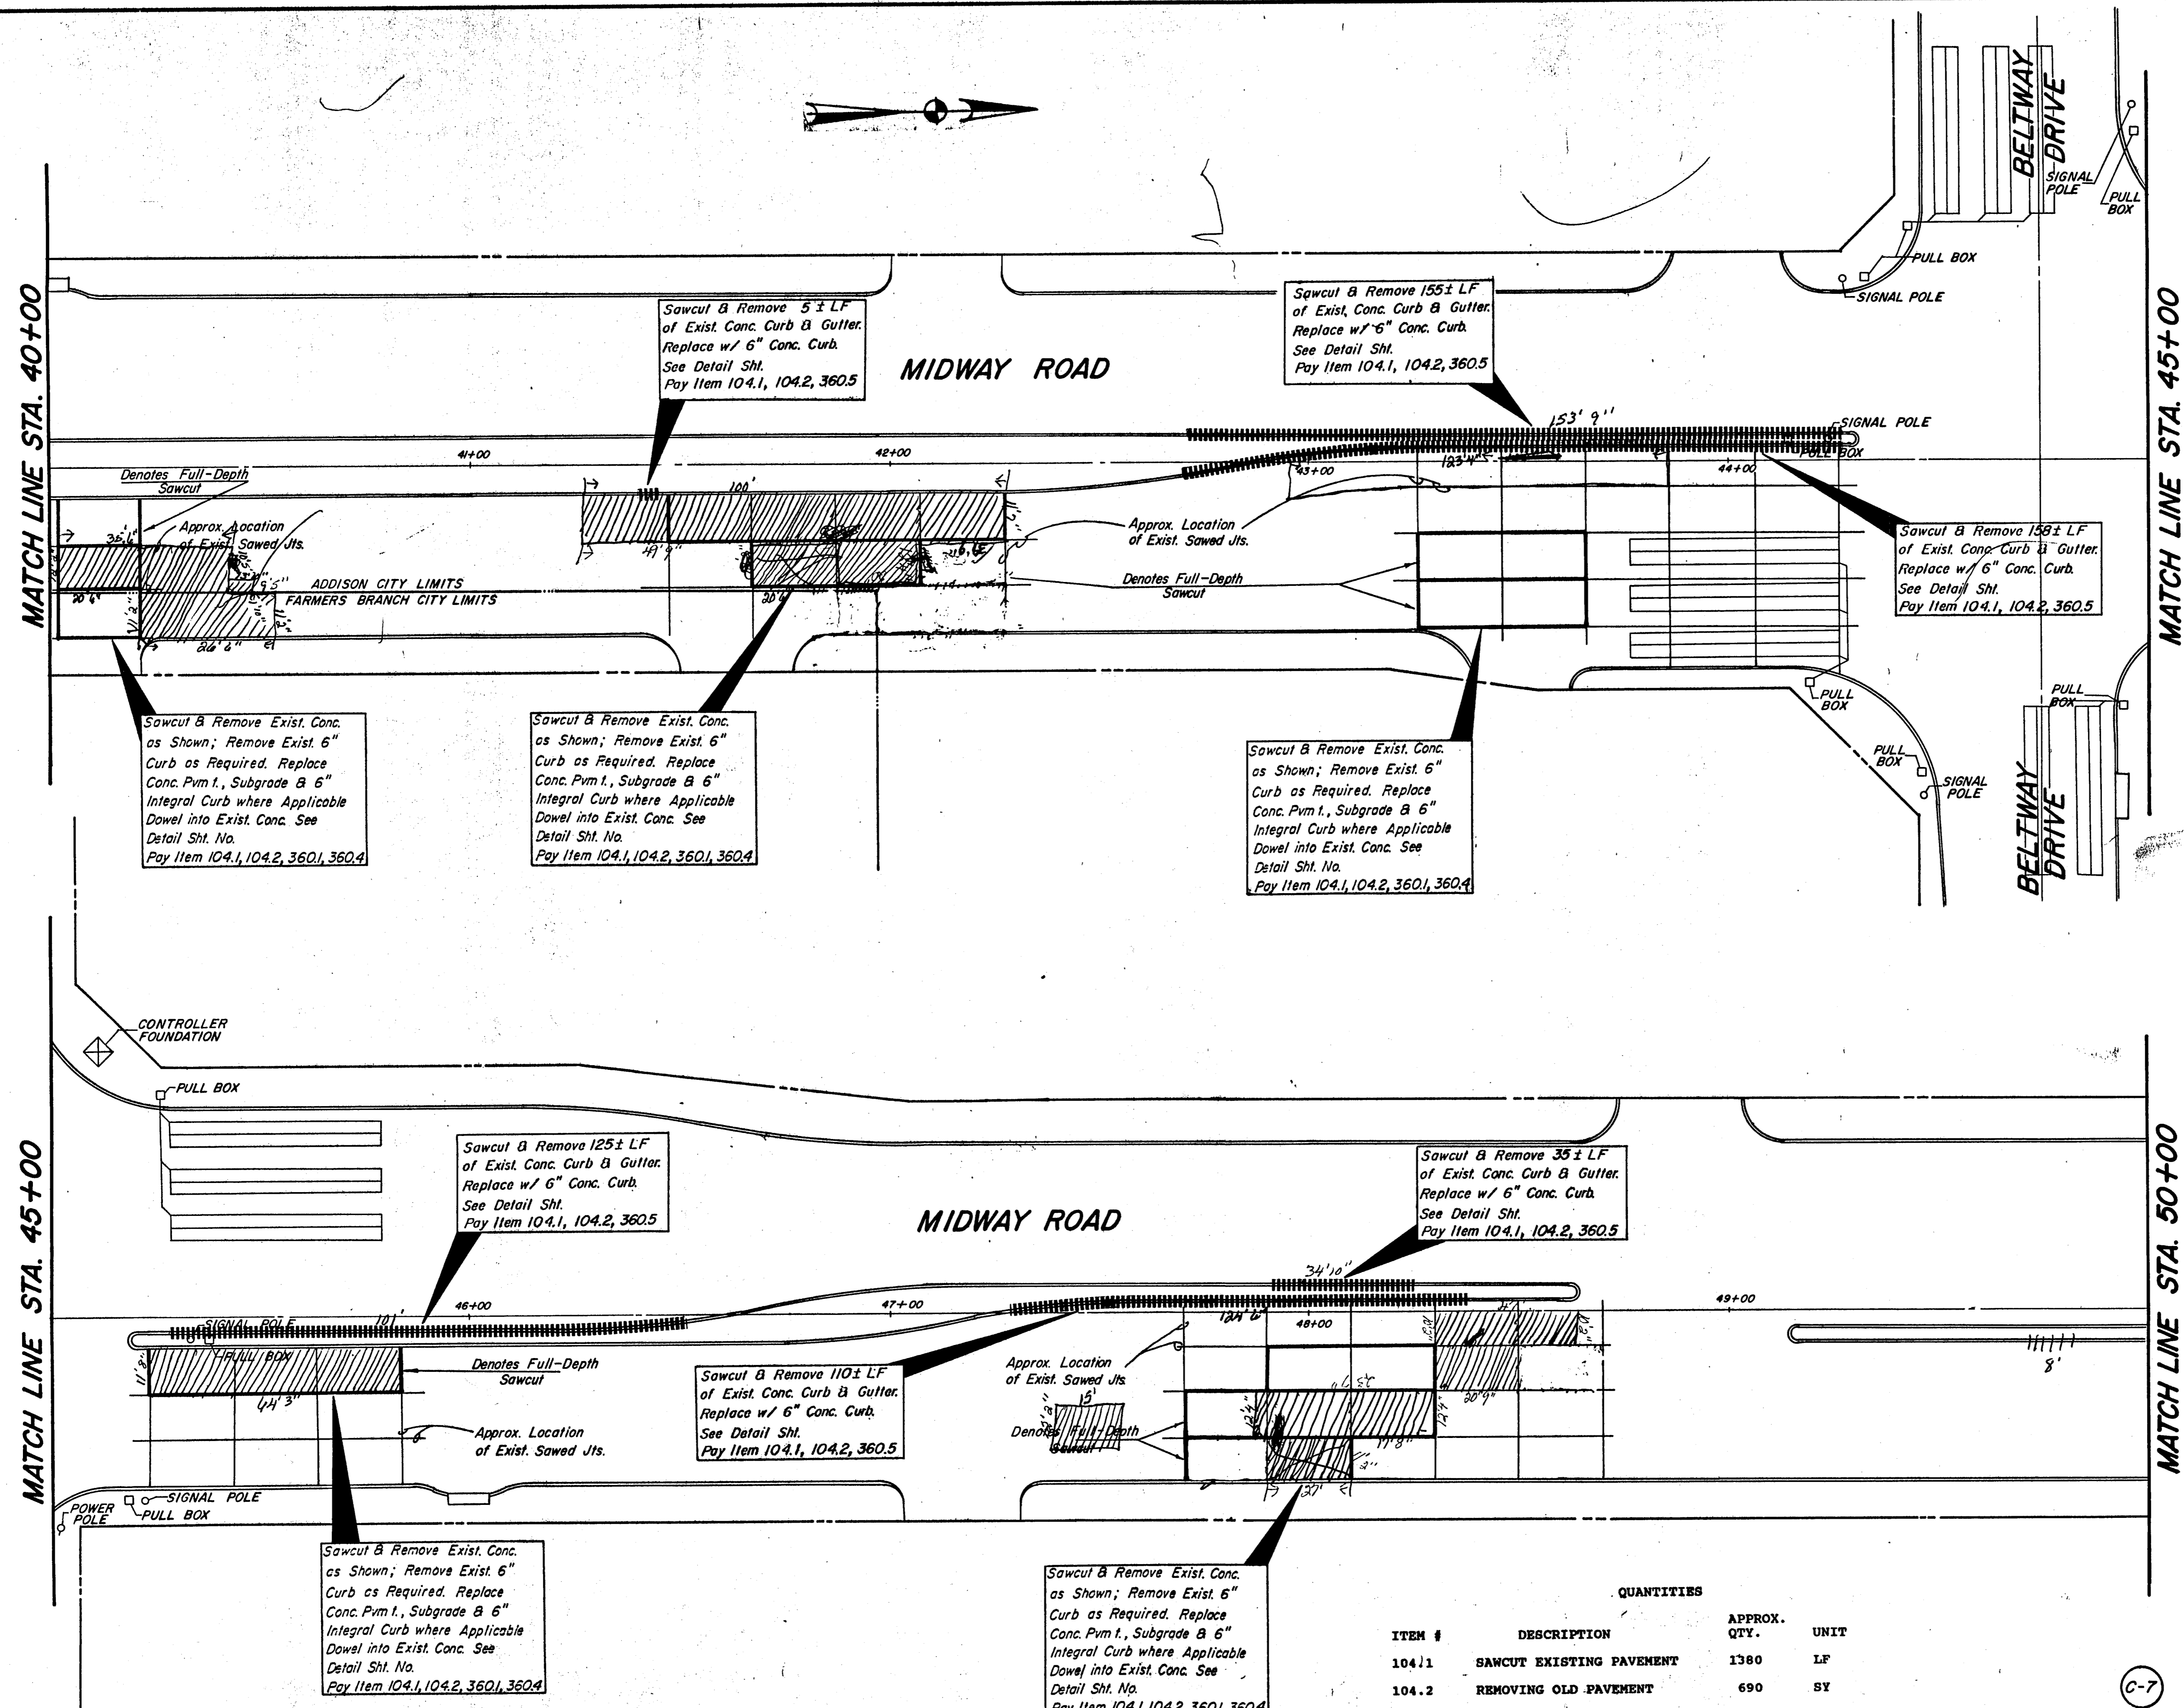

RECORD DRAWING

QUANTITIES

ITEM #	DESCRIPTION	APPROX. QTY.	UNIT
104.1	SAWCUT EXISTING PAVEMENT	1380	LF
104.2	REMOVING OLD PAVEMENT	690	SY
360.1	10" REINF. CONC. PAVEMENT	592	SY
360.4	6" INTEGRAL CONC. CURB	200	LF
360.5	6" DOWELED CURB & GUTTER	588	LF
674.1	4" TRAF. BUTTON, WHITE (NON-REFLECTIVE)	62	EA
674.2	4" TRAF. BUTTON, WHITE (SINGLE REFLECTIVE, P-18-U)	13	EA
676.2	8" TRAF. BUTTON, WHITE (SINGLE REFLECTIVE, P-18-1-U)	5	EA

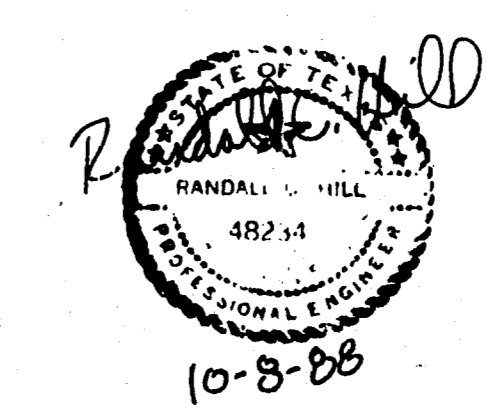

C-7

No.	Revision	By	Date

TOWN OF ADDISON
 DALLAS COUNTY, TEXAS

MISC. PAVEMENT IMPROVEMENTS

MIDWAY ROAD
 STA. 40+00 to STA. 50+00

GINN, INC.
 Consulting Engineers Dallas, Texas

Designed - RCH Drawn - DEM Date - JULY, 1988 Job No. - 87372
 Approved - HWG Checked - RCH Scale - 1" = 20' Sheet 7 of 16