


RECORD DRAWINGS September 30, 2009  
 NOTE: THE INTENT OF THE OWNER AND ENGINEER WAS TO CONSTRUCT THE IMPROVEMENTS ACCORDING TO THESE PLANS AS APPROVED BY THE TOWN OF ADDISON. THE LINES AND GRADES WERE SET ON THE GROUND FOR CONSTRUCTION ACCORDING TO SAID PLANS. WE ARE NOT AWARE OF ANY CHANGES OR REVISIONS TO THESE PLANS DURING CONSTRUCTION EXCEPT AS NOTED ON THE PLANS.

NOTE:  
 LOT 1 LANDSCAPE PLANS WILL BE PROVIDED WITH ARCHITECTURAL PLANS

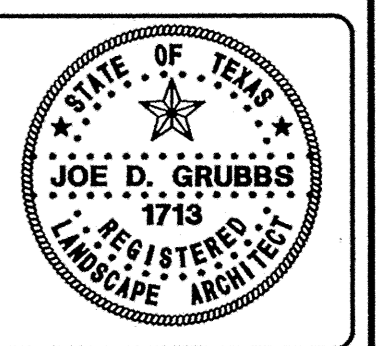

**Meridian Square**  
 R.O.W. Improvements  
 Addison, Texas

Issued For:  
**CONSTRUCTION**  
 Job No.  
**08132.00**  
 Scale  
**1" = 20'-0"**  
 Drawn By:  
**JDS**  
 Date  
**1-30-2009**

**Landscape Plan**

Sheet Number:  
**L1**  
 of **L4** Sheets

#	Revisions:	Date: