

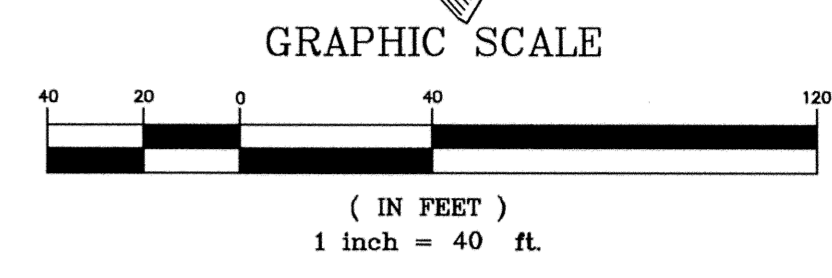
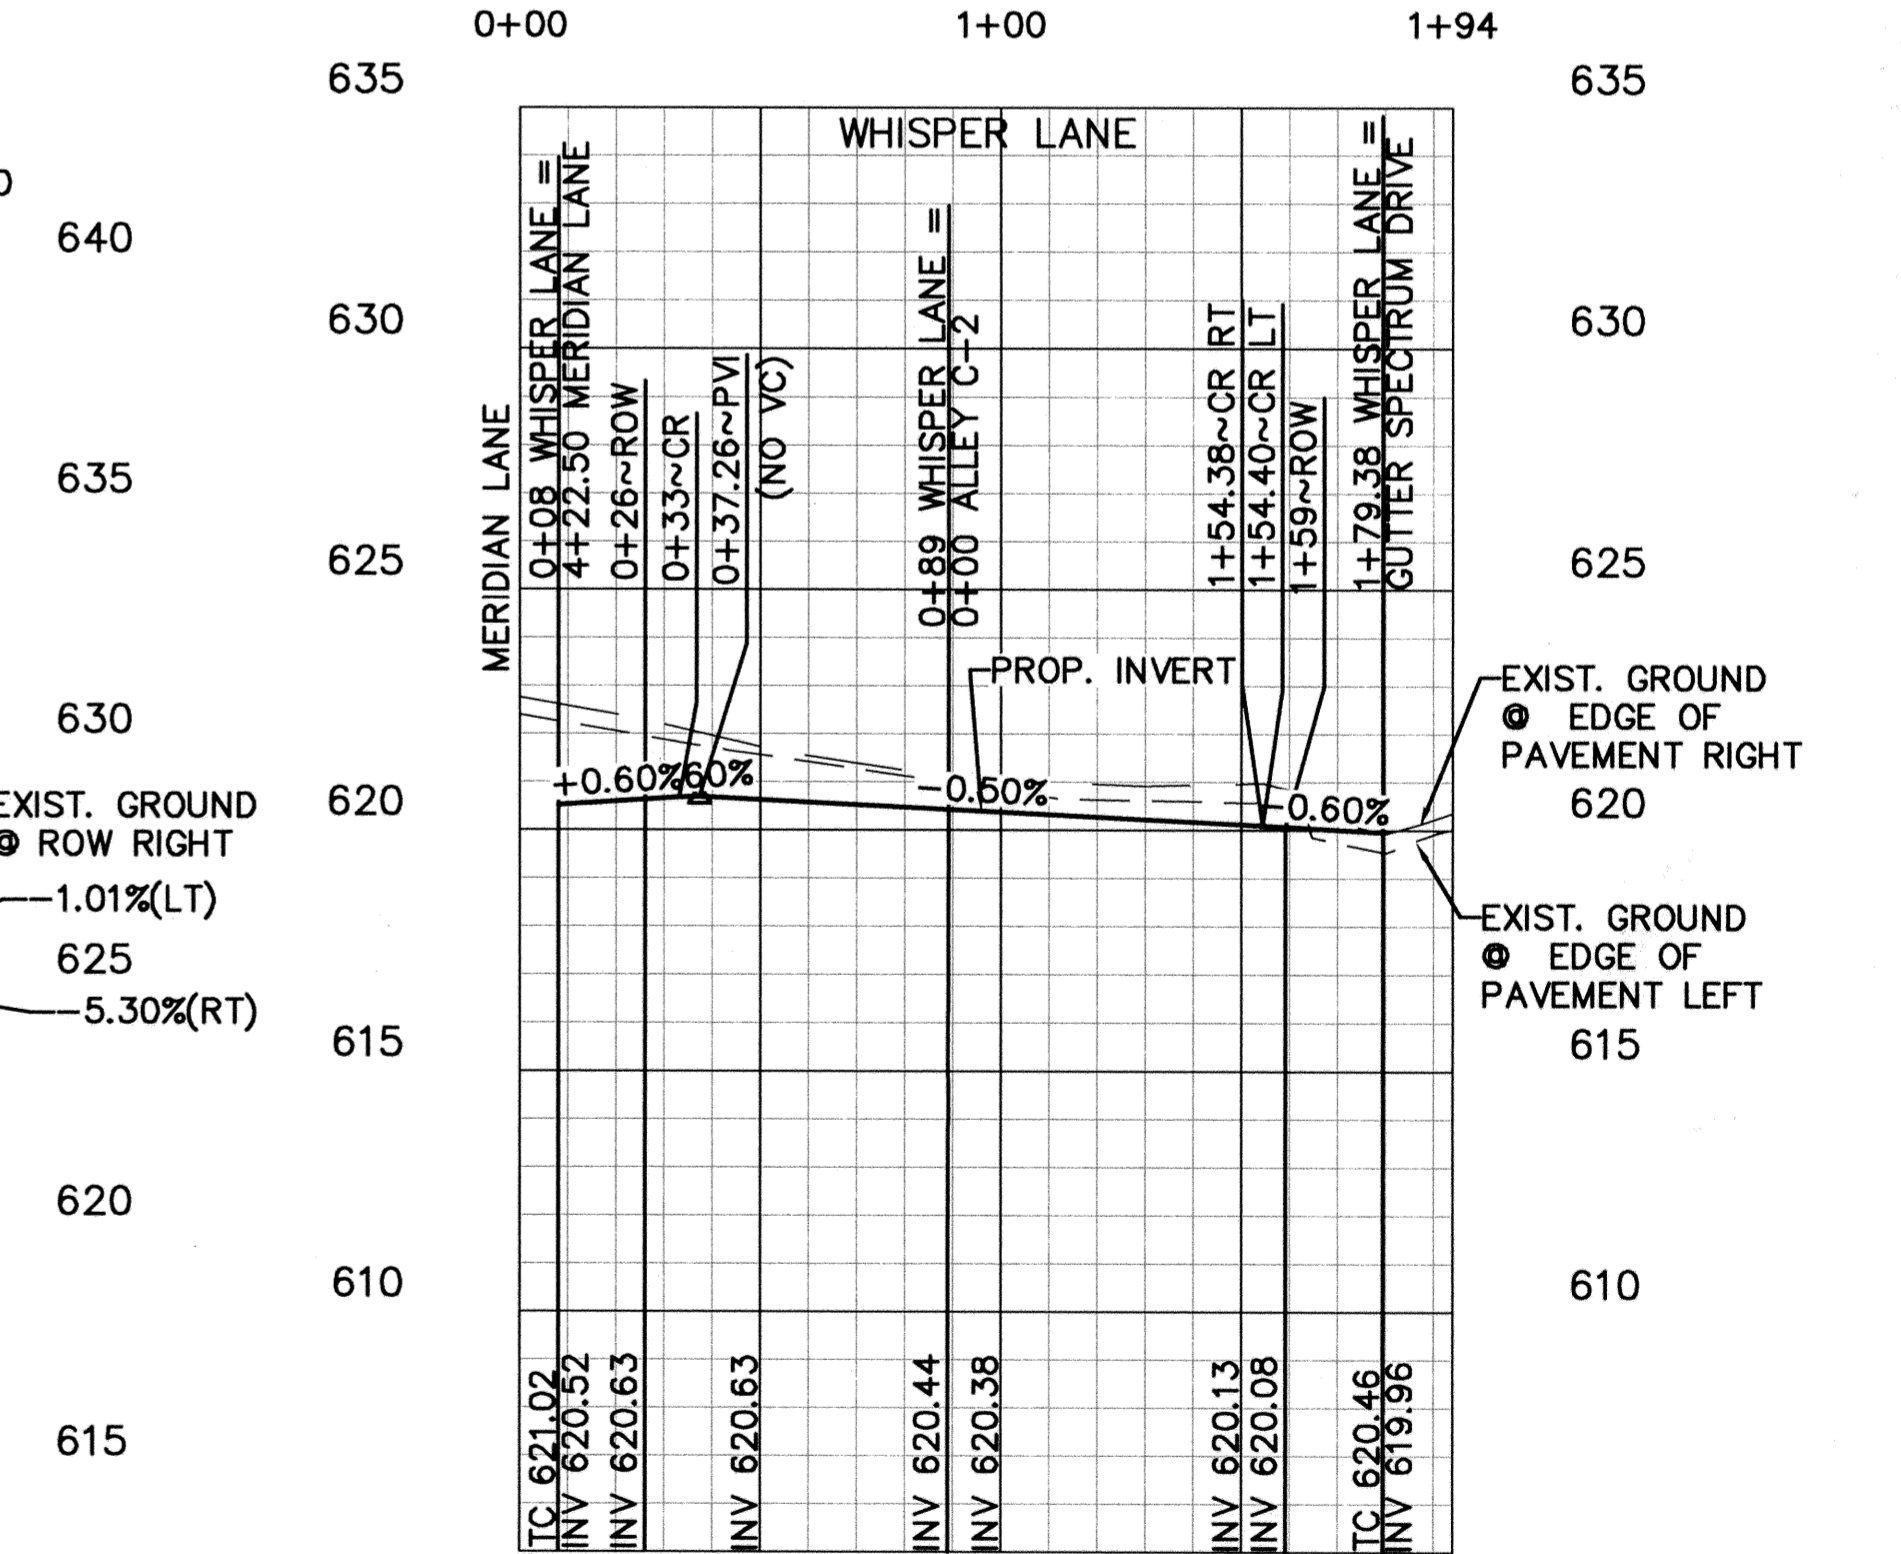
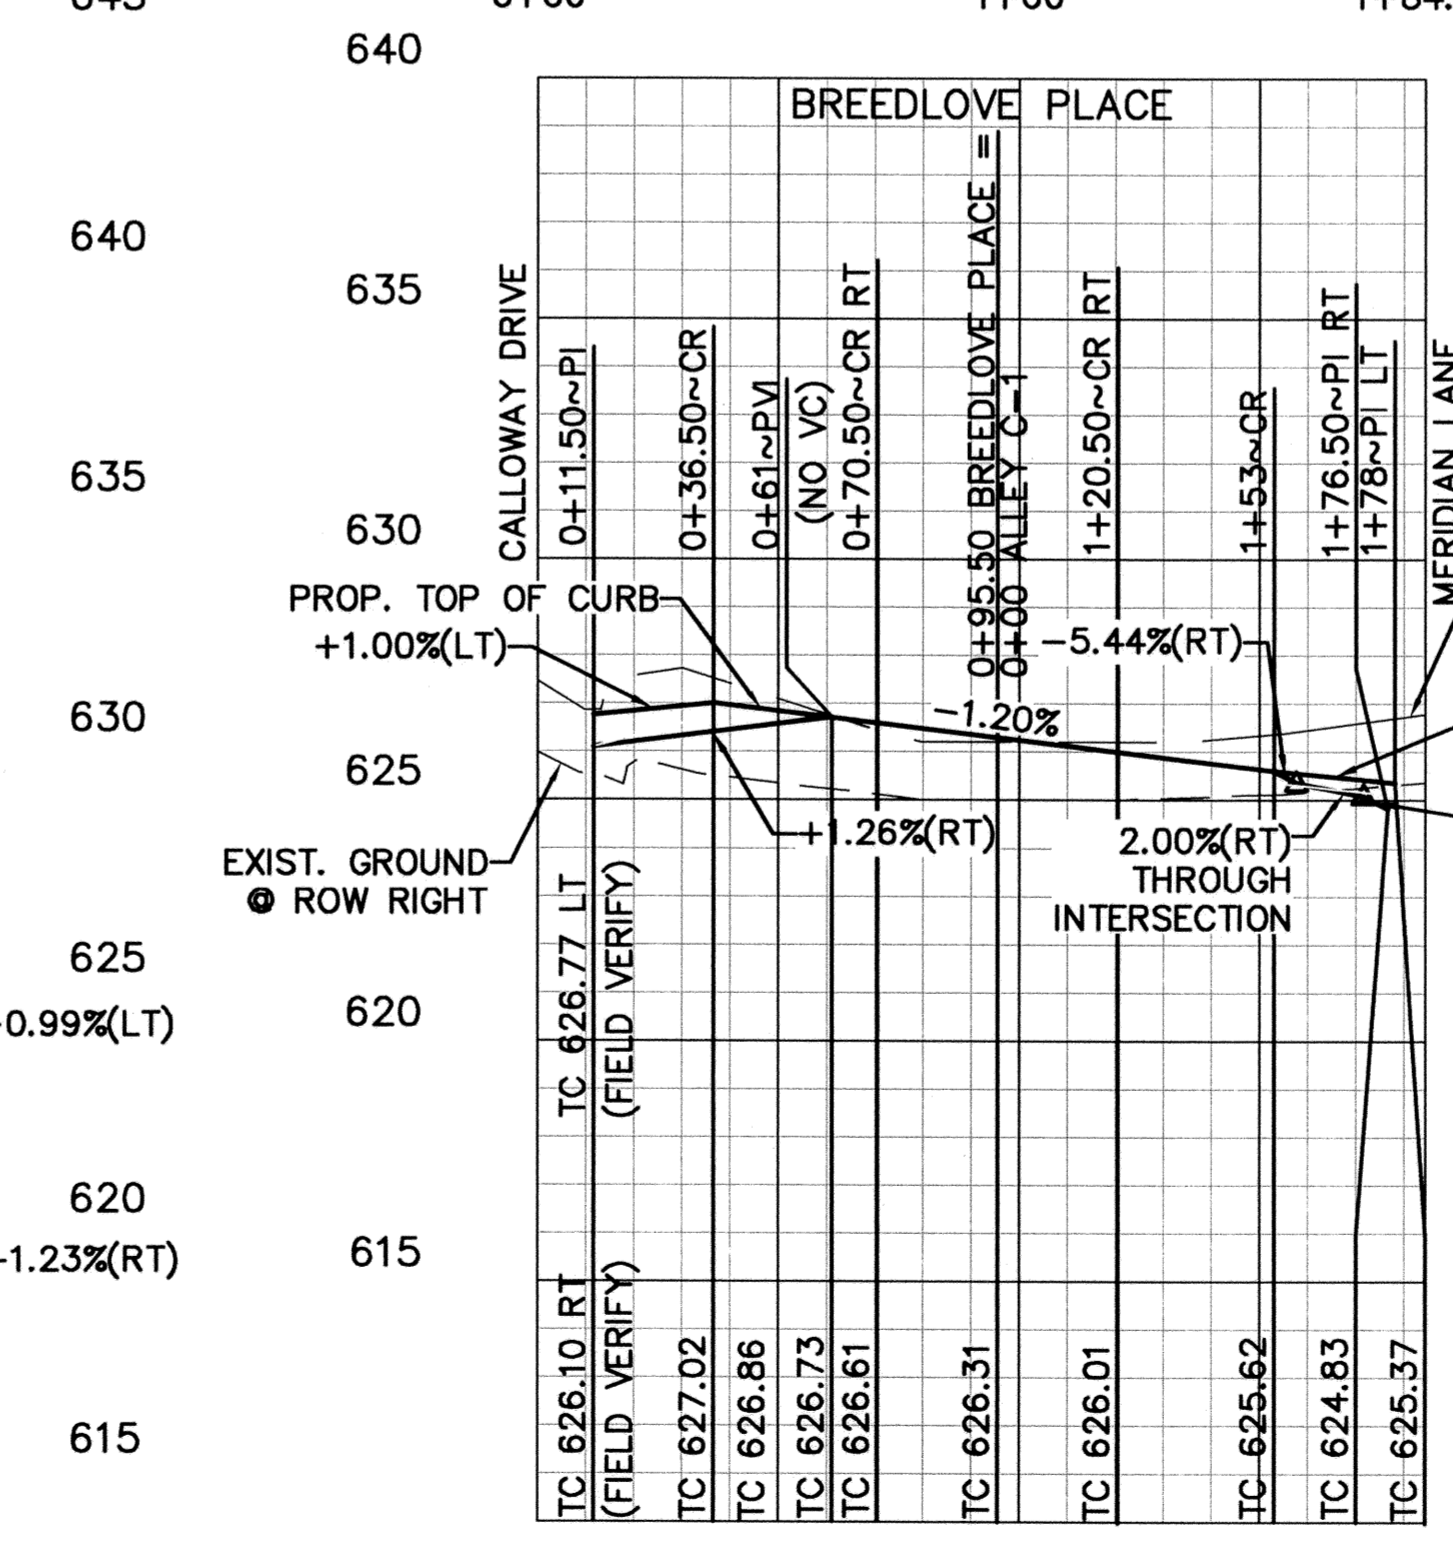
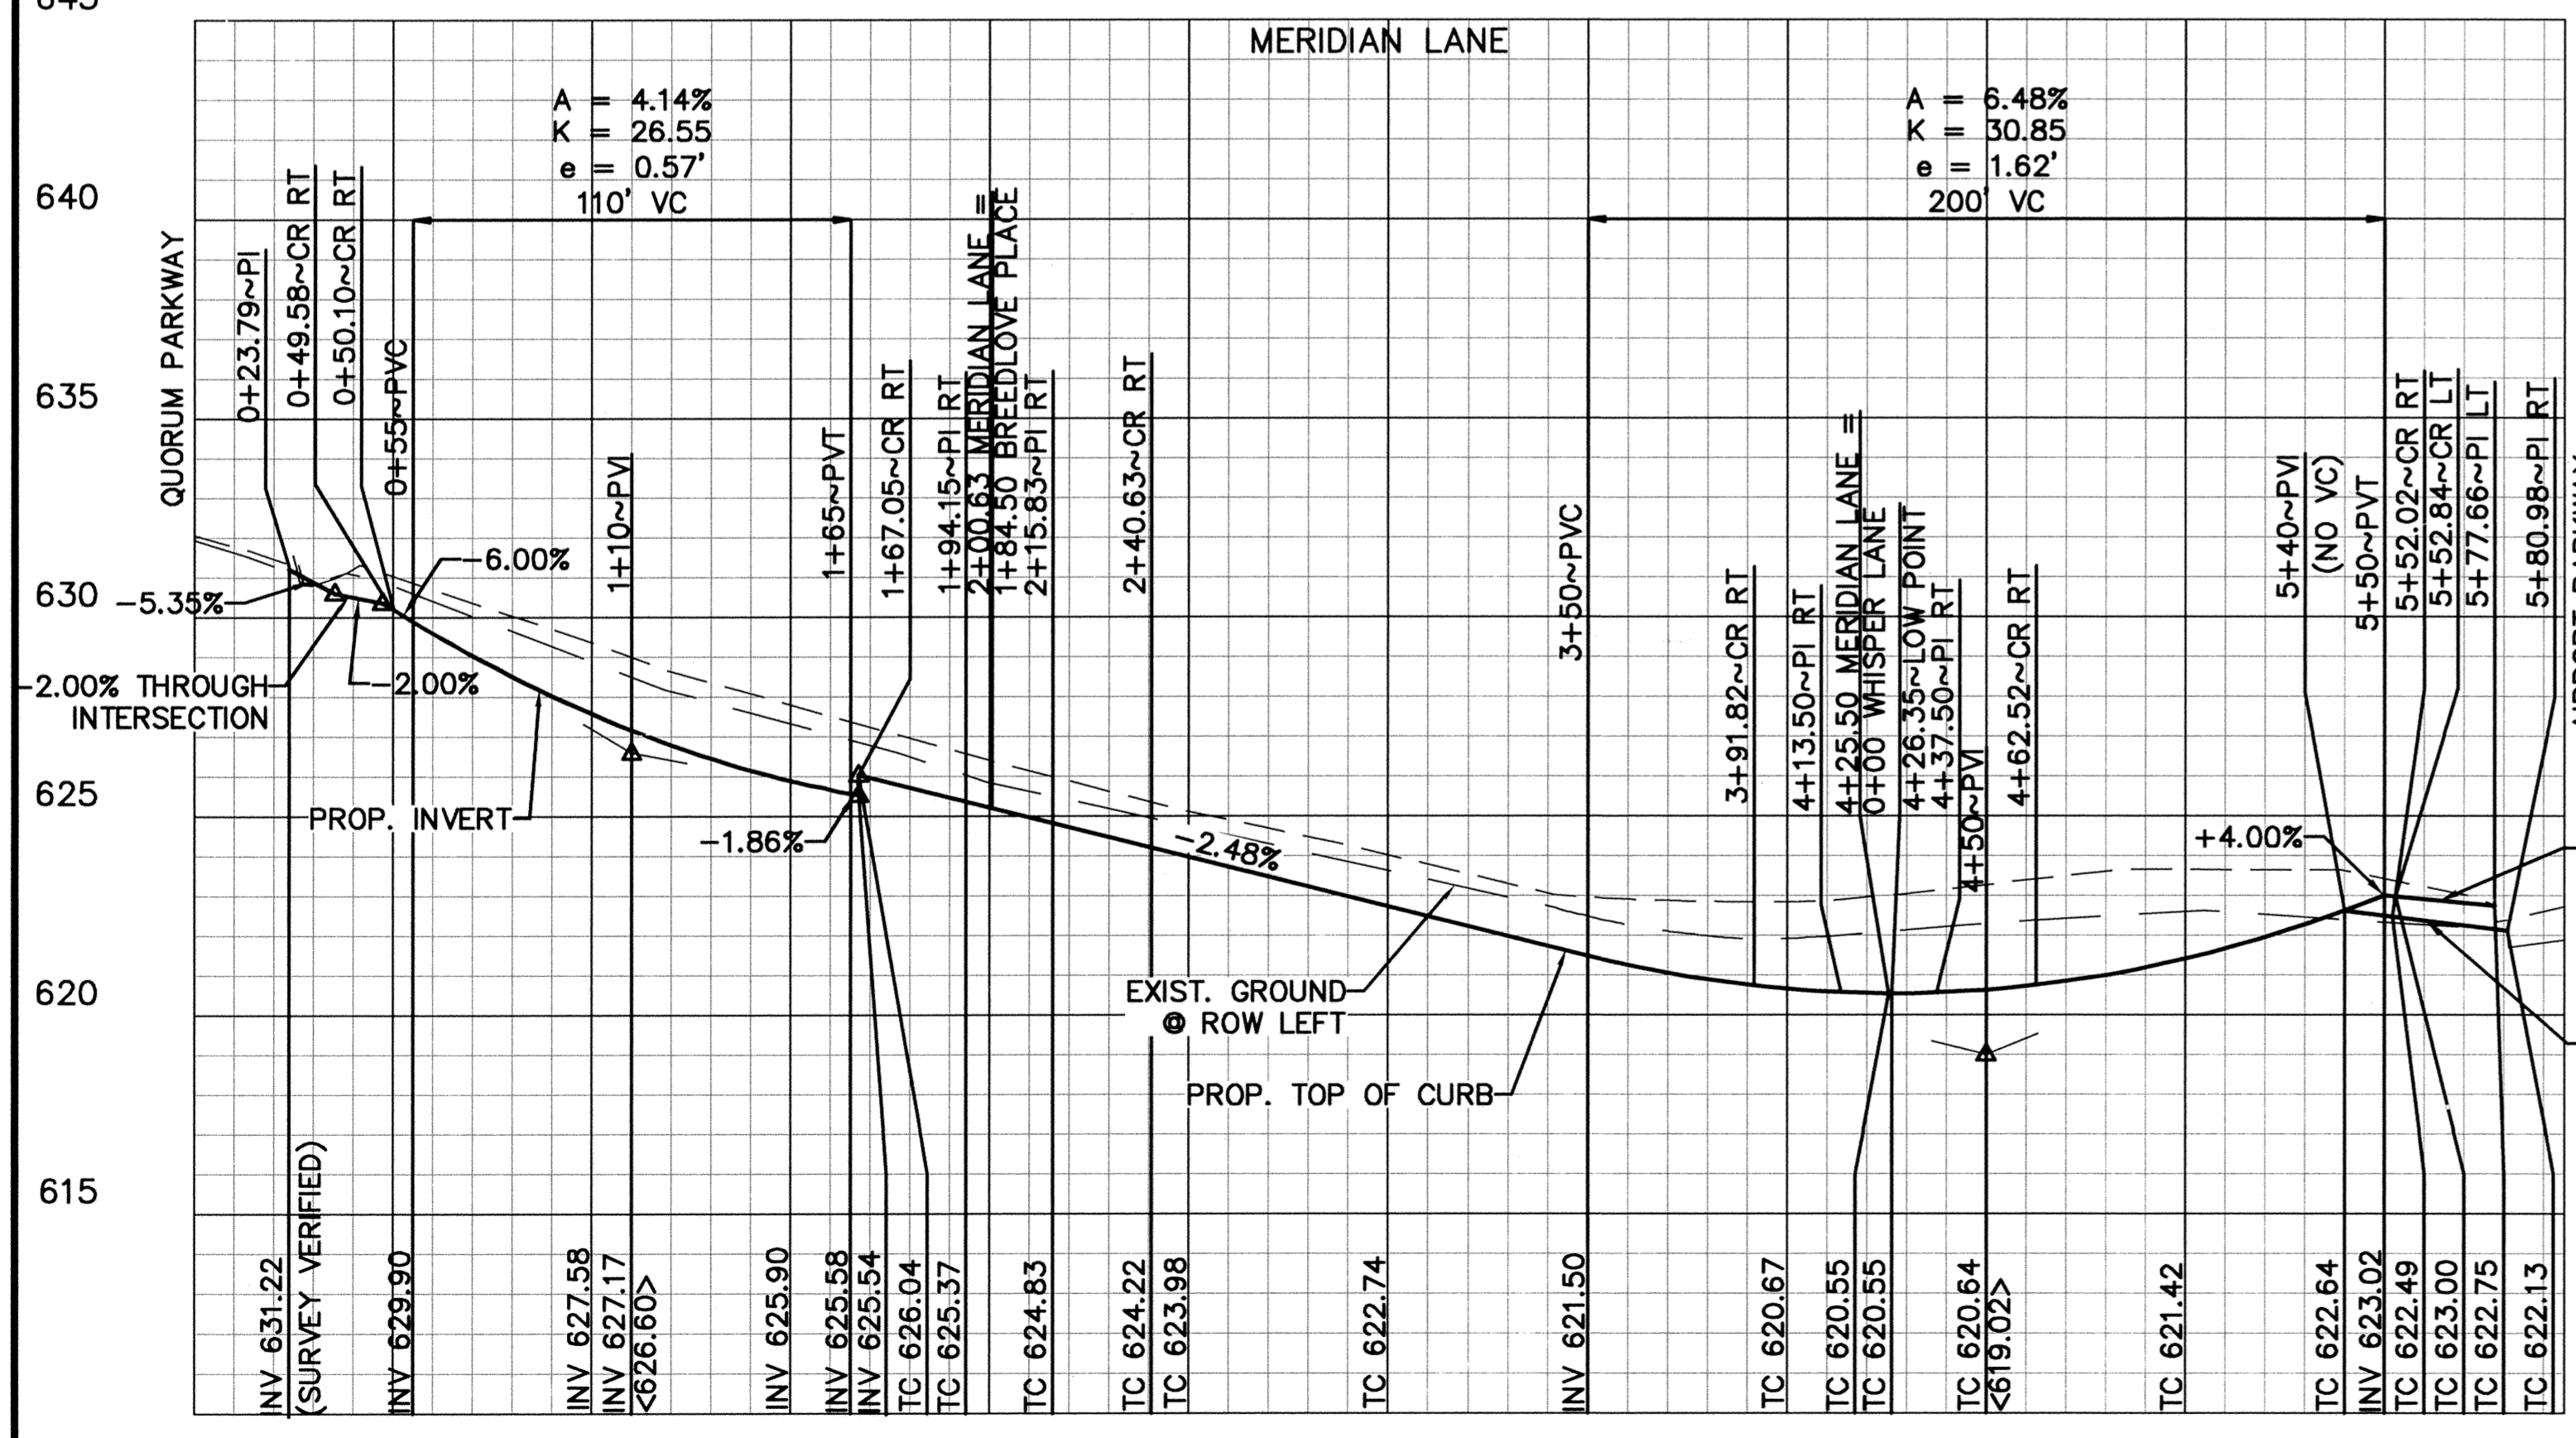


ROADWAY CHORD TABLE					
CURVE	DELTA	RADIUS	TANGENT	LENGTH	CHORD BEARING & DIST.
C1	090°41'50"	40.00'	40.49'	63.32'	N44°34'29"E 56.91

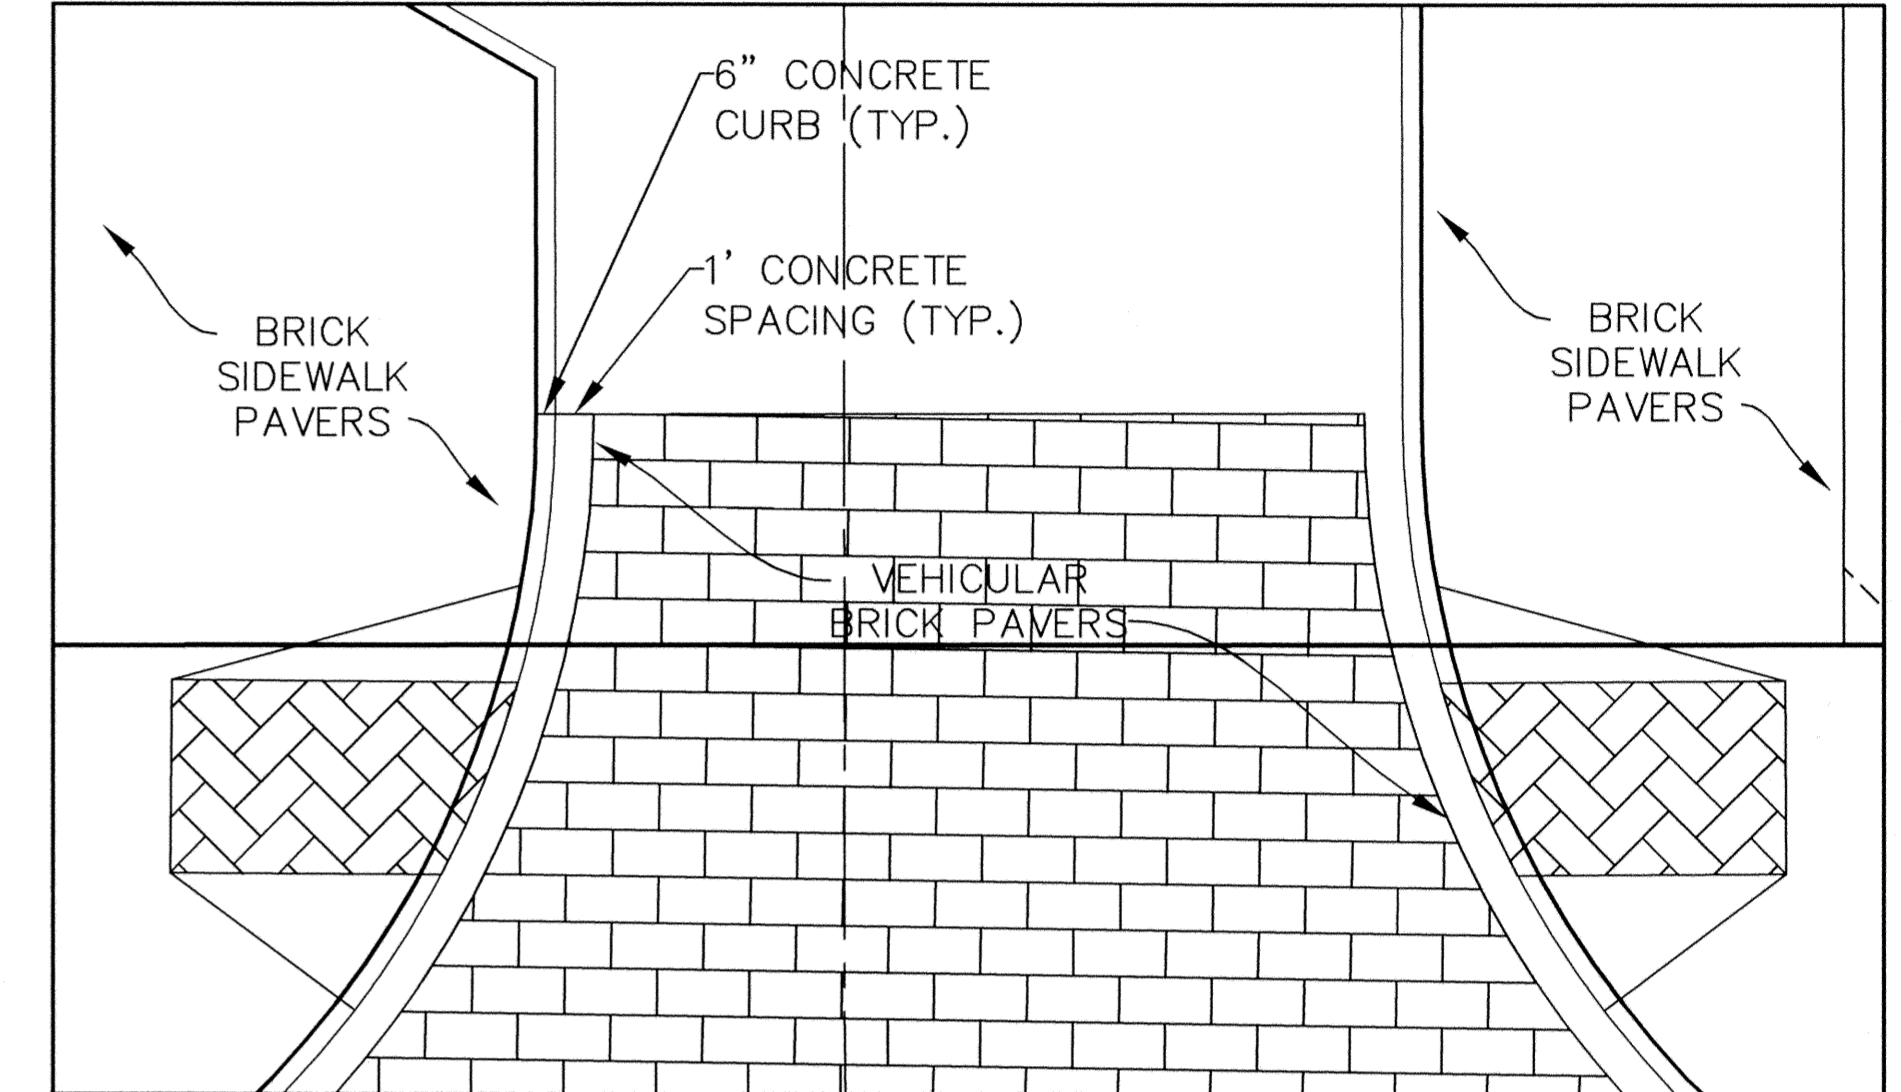


NOTE:  
 1) MERIDIAN LANE SHALL CROSS-SLOPE AT 2% AS INDICATED FROM STA. 1+87.06 TO STA. 4+60  
 2) MERIDIAN LANE STA. 4+60 BEGIN TRANSITION FROM 2% CROSS SLOPE TO 4" CROWN.  
 3) 5+00 END TRANSITION

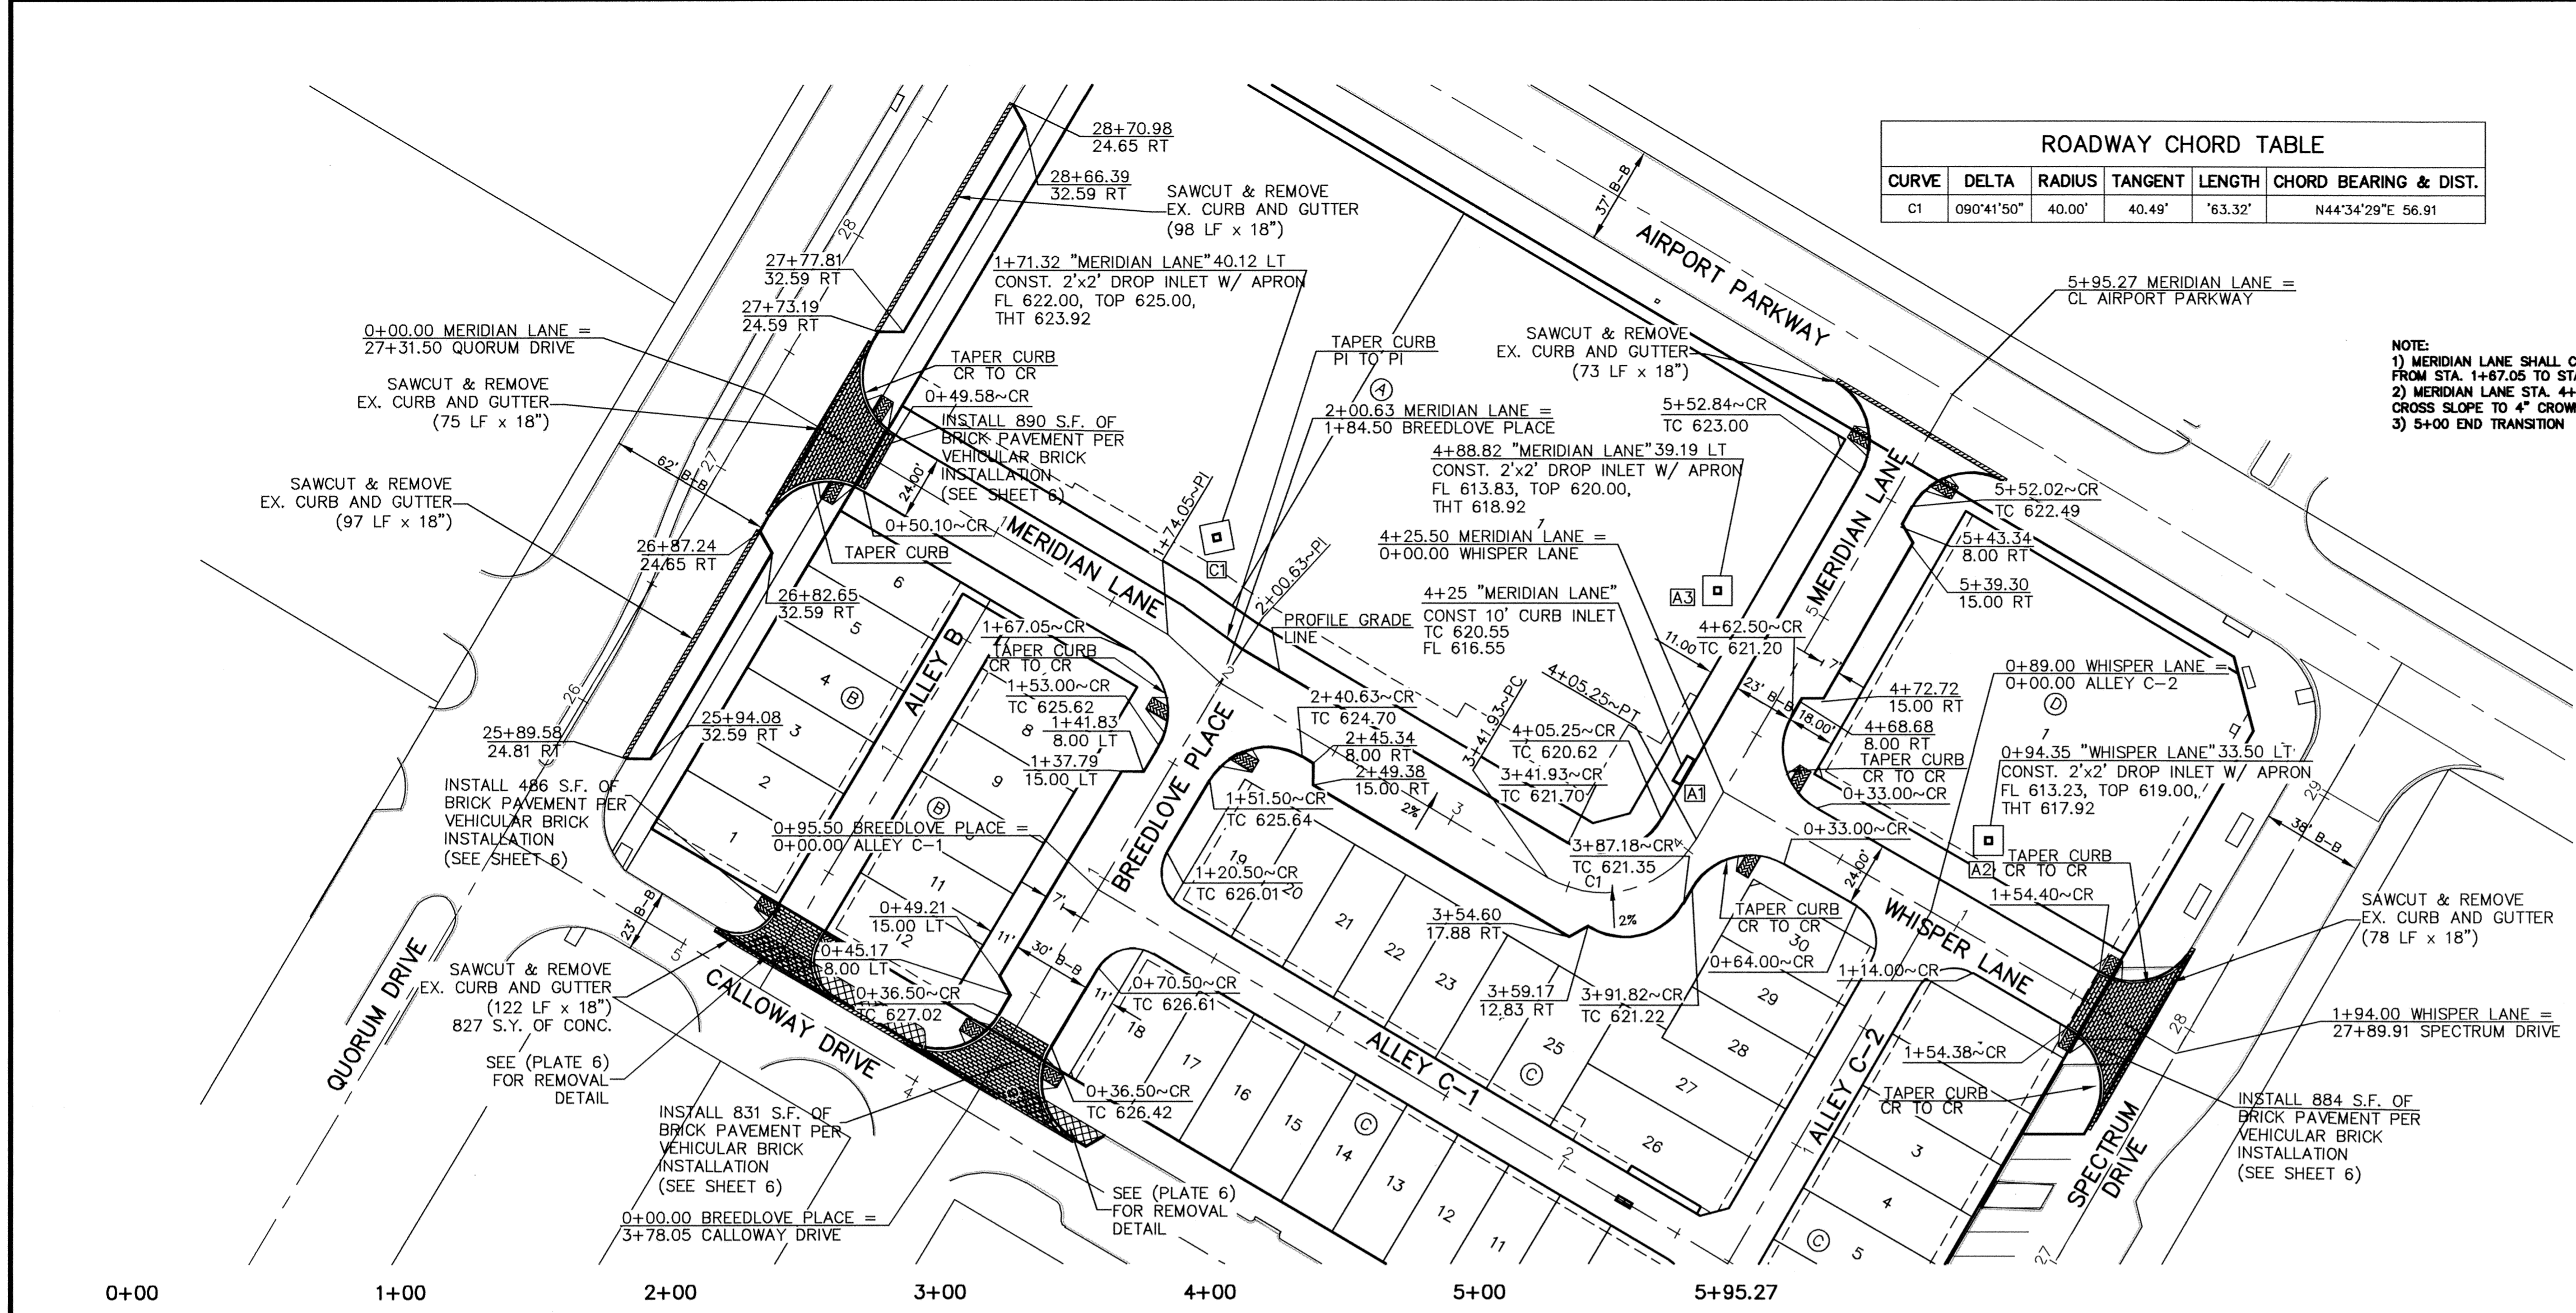

**BENCHMARKS:**  
 1. SQUARE CUT AT THE BACK OF CURB ON THE CENTER OF A CONCRETE INLET LOCATED ON THE EAST SIDE OF QUORUM PARKWAY APPROXIMATELY ±65' SOUTH OF THE CENTERLINE INTERSECTION OF QUORUM PARKWAY AND AIRPORT PARKWAY.  
 ELEVATION = 630.71'

2. SQUARE CUT ON THE NORTHWEST CORNER OF A CONCRETE INLET LOCATED ON THE NORTH SIDE OF AIRPORT PARKWAY AT THE CENTERLINE INTERSECTION OF AIRPORT PARKWAY AND SPECTRUM DRIVE.  
 ELEVATION = 619.31'

THESE CONSTRUCTION PLANS WERE PREPARED UNDER THE RESPONSIBLE SUPERVISION OF J. CASEY ROSS, LICENSED PROFESSIONAL ENGINEER NO. 97272.  
*J. Casey Ross 9/30/09*

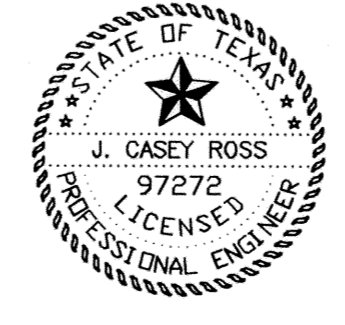

NO.	DATE	BY	REVISION
1	4/08/08	JCR	REVISED ALL TOWNHOME LOT LINES & ADJUSTED WHISPER LANE ALIGNMENT

RECORD DRAWINGS Sept. 30, 2009  
 NOTE: THE INTENT OF THE OWNER AND ENGINEER WAS TO CONSTRUCT THE IMPROVEMENTS ACCORDING TO THESE PLANS AS APPROVED BY THE TOWN OF ADDISON. THE LINES AND GRADES WERE SET ON THE GROUND FOR CONSTRUCTION ACCORDING TO SAID PLANS. WE ARE NOT AWARE OF ANY CHANGES OR REVISIONS TO THESE PLANS DURING CONSTRUCTION EXCEPT AS NOTED ON THE PLANS.

**STREETS  
 PAVING PLAN & PROFILE  
 MERIDIAN SQUARE**

TOWN OF ADDISON  
 DALLAS COUNTY, TEXAS

**DOWDEY, ANDERSON & ASSOCIATES, INC.**  
 5225 Village Creek Drive, Suite 200 Plano, Texas 75093 972-931-0694

DESIGN	DRAWN	CHECKED	DATE	SCALE	JOB	SHEET
JBA	WBJ	JCR	11/17/08	H: 1" = 40' V: 1" = 4'	07031B	1