

Δ = 6°43'08"
 R = 300'
 T = 17.61'
 L = 35.18'

Δ = 12°44'18"
 R = 370.00'
 T = 41.30'
 L = 82.26'

Δ = 12°44'18"
 R = 430.00'
 T = 48.00'
 L = 95.60'


AS BUILT PLANS

NOTE: THE INTENT OF THE OWNER AND ENGINEER WAS TO CONSTRUCT THE UTILITIES ACCORDING TO THESE PLANS AS APPROVED BY THE CITY OF ADDISON. THE LINES AND GRADES WERE SET ON THE GROUND FOR CONSTRUCTION ACCORDING TO SAID PLANS. THE CITY OF ADDISON INSPECTED THE CONSTRUCTION. THE OWNER OR ENGINEER DID NOT VERIFY LINES OR GRADES AFTER CONSTRUCTION. WE ARE NOT AWARE OF ANY CHANGES OR REVISIONS TO THESE PLANS DURING CONSTRUCTION EXCEPT SOME PARKING ISLANDS HAVE CHANGED.

NOV. 14, 1985

WATER & SANITARY SEWER NOTES:
 1. ALL WATER MAINS TO BE P.V.C. PIPE.
 2. SANITARY SEWER PIPE TO BE P.V.C.
 3. ALL CONST. MATERIAL AND METHODS TO BE IN ACCORDANCE WITH THE CITY OF ADDISON SPECIFICATION.

OWNERSHIP OF DOCUMENTS
 THIS DOCUMENT, AND THE IDEAS AND DESIGNS INCORPORATED HEREIN, AS AN INSTRUMENT OF PROFESSIONAL SERVICE, IS THE PROPERTY OF THREADGILL-DOWDEY & ASSOCIATES. IT IS NOT TO BE USED, IN WHOLE OR IN PART, FOR ANY OTHER PROJECT WITHOUT THE WRITTEN AUTHORIZATION OF THREADGILL-DOWDEY & ASSOCIATES.

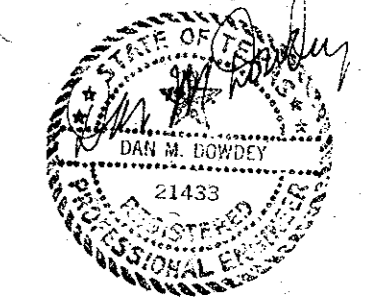

WATER & SANI. SEW. PLANS						
HUIE ADDISON ADDITION						
THOMAS L. CHENOWETH SURVEY, ABST. 27.3						
ADDISON, DALLAS CO., TEXAS						
THREADGILL - DOWDEY and ASSOCIATES						
CONSULTING ENGINEERS DALLAS, TEXAS						
DESIGN	DRAWN	CHECKED	DATE	SCALE	JOB	SHEET
AR.W.	R.E.	D.M.D.	5-84	1"=40'	9208	1