

**LINE "A"**

**LINE "B"**


**LINE "C"**

**AS BUILT**

Winkelmann & Associates, Inc. hereby certifies that this plan, to the best of our knowledge is "As Built." All modifications from the originally approved construction documents have been made as per information provided by the contractor. Winkelmann & Associates, Inc. does not carry any liability for the accuracy of quality of construction as no field inspection was performed.

*F.E. Minton*  
 F.E. Minton  
 10-14-94  
 DATE

NOTE:  
 THE CONTRACTOR SHALL SUBMIT A TRENCH EXCAVATION PROTECTION PLAN, PREPARED, SIGNED, AND SEALED BY A GEOTECHNICAL ENGINEER REGISTERED IN THE STATE OF TEXAS, FOR SANITARY SEWER LINES "A", "B", & "C".

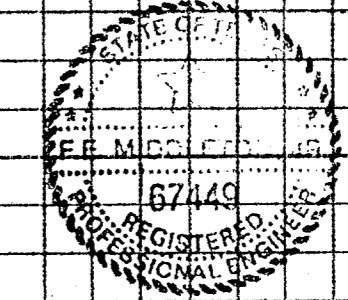

BENCHMARK NO. 1:  
 "1" CUT IN CURB LOCATED ON NORTHEAST CORNER OF AN INLET ON THE WEST SIDE OF MIDWAY ROAD APPROXIMATELY 911 FEET SOUTH OF BELTWAY DRIVE.  
 ELEV. = 615.72

BENCHMARK NO. 2:  
 "1" CUT IN CURB LOCATED ON SOUTH SIDE OF BELTWAY DRIVE APPROXIMATELY 627 FEET EAST OF MIDWAY ROAD.  
 ELEV. = 631.63

REVISED LINES "A" & "B"  
 2-11-94  
 FEM

CITY COMMENTS  
 12-6-93  
 FEM

APPROV  
 12-6-93  
 FEM

Winkelmann & Associates, Inc.  
 CONSULTING CIVIL ENGINEERS & SURVEYORS  
 1200 Hillcrest Blvd., Suite 200  
 Dallas, Texas 75230  
 (214) 967-7090  
 (214) 967-7099

THOMAS L. CHEMONEWETH SURVEY,  
 ABSTRACT NO. 273  
 TOWN OF ADDISON, DALLAS COUNTY, TEXAS

CLIENT:  
 MACOUTCHIN PROPERTIES  
 14902 PRESTON ROAD, SUITE 200  
 DALLAS, TEXAS 75280

**SANITARY SEWER PROFILES**

Scale: 1" = 10'-0"  
 Date: 11-22-93  
 Designed By: TL  
 Drawn By: TL  
 Checked By: FEM  
 File: 156SSPF.dwg  
 Project No.: 15602.01

SHEET  
 10