


MIDWAY ROAD

WILEY POST ROAD

RECORD DRAWINGS

These record drawings have been prepared using information provided by the Construction Contractor and/or Owner. The signature below only signifies that the plans have been revised in accordance with the information provided and does not guarantee that these plans accurately show every detail of the constructed project.

Richard W. Burns 05/08/07
Signature Date

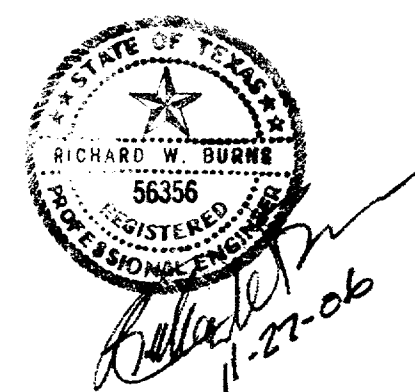

DEVELOPED SITE - STORM DRAINAGE CALCULATIONS

DESIGN AREA	T/C MIN.	AREA ACRES	C	I 100 YR.	G 100 YR.
1	10	0.276	0.90	8.74	2.17
2	10	0.333	0.90	8.74	2.62
3	10	0.025	0.90	8.74	0.20

NOTE:

- DESIGN AREA 1 DRAINS TO CURB INLET IN MIDWAY ROAD.
- DESIGN AREA 2 DRAINS TO CURB LINET IN WILEY POST ROAD.
- DESIGN AREA 3 DRAINS TO INTERSECTION.

REVISED 01/18/07, COMBINED SAN. SEWER SERV. & SAND TRAP SERV.
REVISED 01/18/07, ADJUSTED FINAL GRADES
REVISED 01/06/07 PER CITY COMMENTS DATED 01/04/07
REVISED 12/29/06 PER CITY COMMENTS DATED 12/20/06

DRAINAGE STUDY
LOT 12, BLOCK B, ADDISON
AIRPORT INDUSTRIAL DISTRICT
ENTERPRISE RENT-A-CAR
15500 MIDWAY ROAD
ADDISON, TEXAS
AMC BUILDING COMPANY
4040 VERNON WAY
KELLER, TEXAS 76248
TEL. : 817.296.2895, FAX. : 817.741.7322

KMT, INC., RICHARD W. BURNS, P.E.
P. O. BOX 1776
KELLER, TEXAS 76244
TEL. : 817.431.3785
FAX : 817.431.8272

REVISED : 01/18/07
REVISED : 01/06/07
REVISED : 12/29/06
PREPARED : 11/27/06