




NOTES:
 1. ALL CURB SHALL BE 12" HIGH, 6" WIDE & 12" DEEP (ON ONE SIDE) THROUGH EXPANSION JOINTS.
 2. CURB SHALL HAVE A HEAVY BRUSH FINISH WITH GROOVES ALIGNED PERPENDICULAR TO THE DIRECTION OF TRAVEL.
 3. ALL RAMPED CURBS SHALL COMPLY WITH THE LATEST REQUIREMENTS OF THE ARCHITECTURAL BARRIERS ACT.
 4. CONCRETE FOR RAMPED CURBS SHALL BE CLASS A.
 5. CONCRETE FOR RAMPED CURBS SHALL BE CLASS A.
 6. RAMPED CURBS SHALL BE ACCEPTABLE. THE RED CONCRETE STAIN BY TALSAR OF 1/2" MAX PER 1/2" TO CONCRETE STAIN BY TALSAR. THE STAIN SHALL BE APPLIED PER MANUFACTURER'S SPECIFICATIONS.

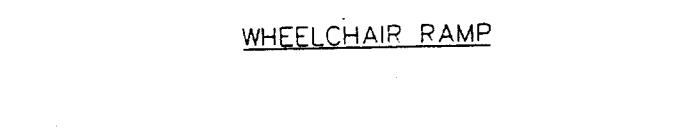



CONST. 6" WIDE CURB BOTH SIDES OF RAMP
 MATCH S.W. HEIGHT
 PROP. 4" SIDEWALK
 MATCH EXIST. CURB HEIGHT
 8% MAX. SLOPE
 SAW CUT FULL P.V.M.T. DEPTH & REMOVE CURB. CONNECT SIDEWALK RAMP TO EXIST. CONC. WITH LONGITUDINAL BUTT JOINT.

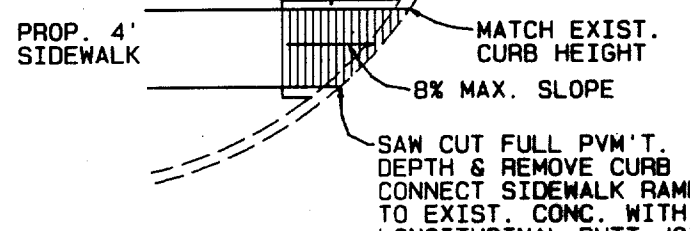

SIDEWALK RAMP
 N.T.S.

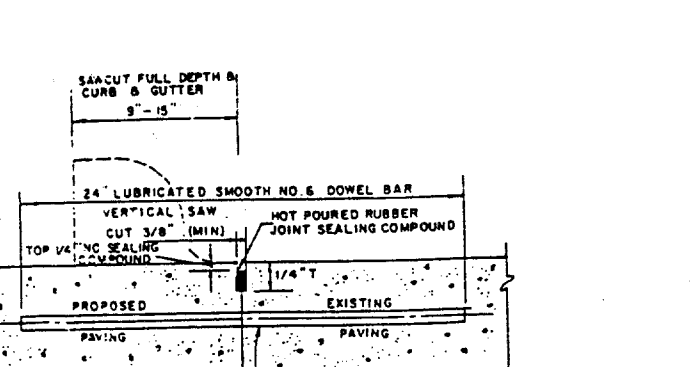


NOTES:
 1. PAVEMENT THICKNESS
 2. 1/2" SANDWICH PANEL MAY BE USED UP TO 3" THICK AND 1" JOINT SPACING
 3. JOINT SPACING
 4. JOINT SPACING
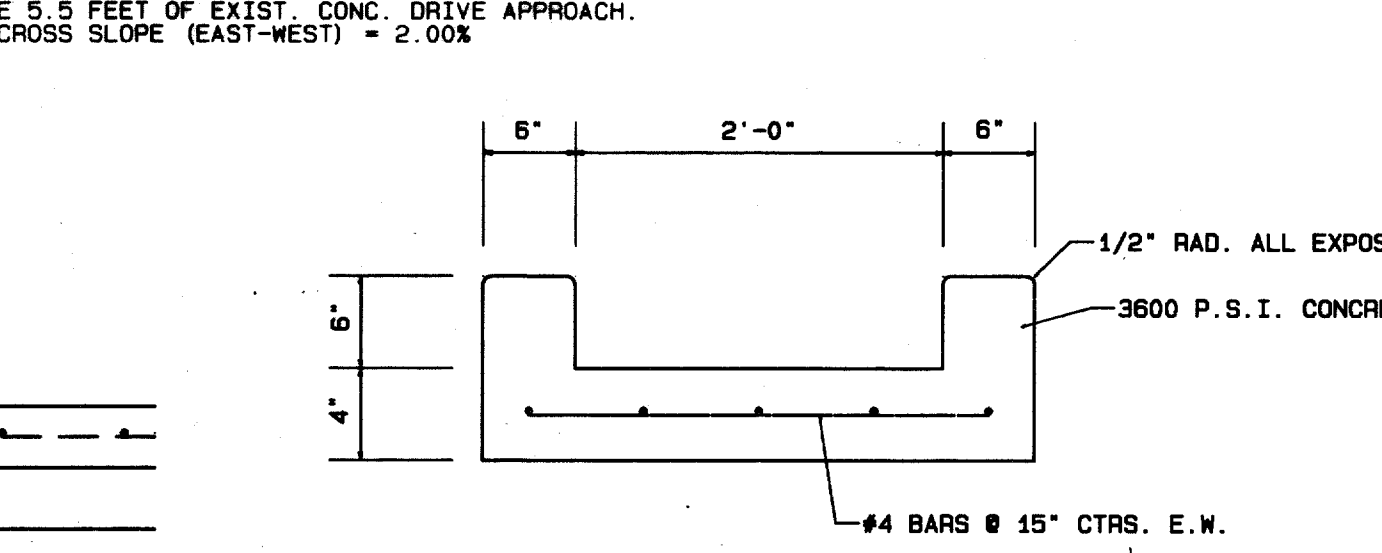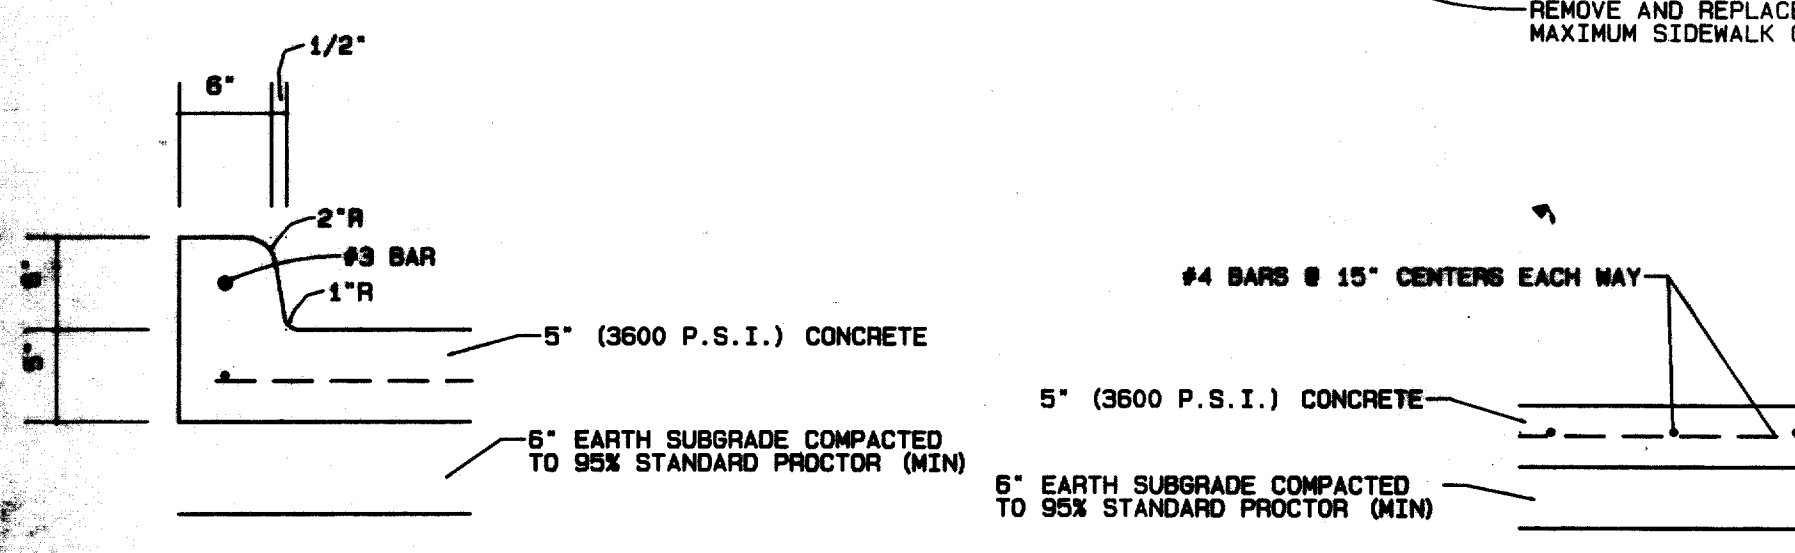

NOTE:
 1. A TOUCH PAD FOR THE 4" DOUBLE CHECK DETECTOR ASSEMBLY SHALL BE MOUNTED ON THE EXTERIOR OF THE BUILDING AND SHALL BE ACCESSIBLE AT ALL TIMES.

RECORD DRAWINGS
 These record drawings have been prepared using information provided by the Construction Contractor and/or Owner. The signature below only signifies that the plans have been revised in accordance with the information provided and does not guarantee that these plans accurately show every detail of the constructed project.

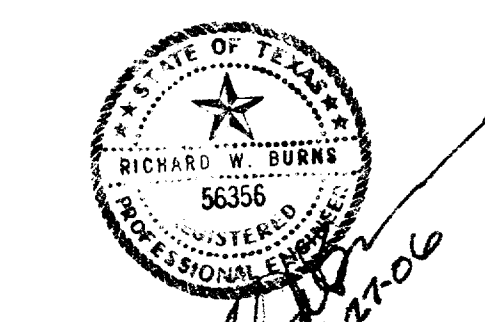

REVISED 01/18/07, COMBINED SAN. SEWER SERV. & SAND TRAP SERV
 REVISED 01/18/07, ADJUSTED FINAL GRADES
 REVISED 01/06/07 PER CITY COMMENTS DATED 01/04/07
 REVISED 12/29/06 PER CITY COMMENTS DATED 12/20/06

SITE PLAN
LOT 12, BLOCK B, ADDISON
AIRPORT INDUSTRIAL DISTRICT
ENTERPRISE RENT-A-CAR
15500 MIDWAY ROAD
ADDISON, TEXAS
AMC BUILDING COMPANY
4040 VERNON WAY
KELLER, TEXAS 76248
TEL. : 817.296.2895, FAX. : 817.741.7822

KMT, INC., RICHARD W. BURNS, P.E.
 P. O. BOX 1775
 KELLER, TEXAS 76244
 TEL. : 817.431.3785
 FAX. : 817.431.8272

REVISED : 01/18/07
 REVISED : 01/06/07
 REVISED : 12/29/06
 PREPARED : 11/27/06