


*Add 2" vent  
discharge line*



**PLUMBING  
FLOOR PLAN- PART 'A'**

SCALE : 1/16"=1'-0"

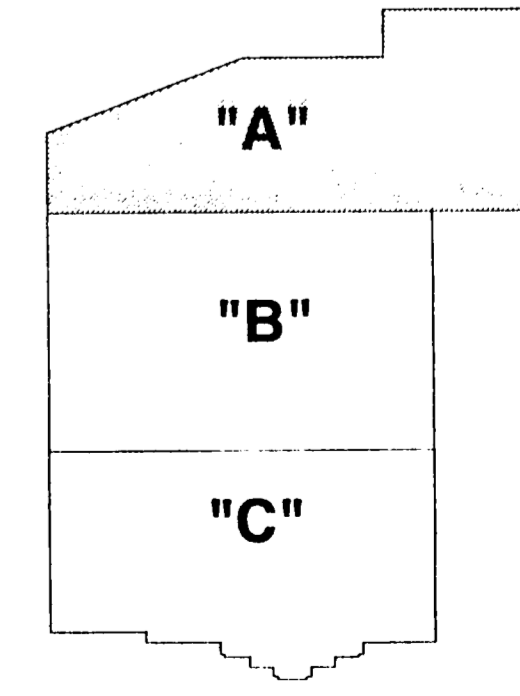

**KEY PLAN**

**COLUMBIA PLUMBING**  
(214) 484-8918

**IZZARELLI-HISAW**  
GENERAL CONSTRUCTION, INC.  
3050 REGENT BLVD.  
SUITE 130  
IRVING, TEXAS 75063 (214) 556-1333

PROPOSED FACILITY FOR:  
**BAS REALTY**  
LIMITED PARTNERSHIP

DATE: 4-20-95  
JOB NO: 95010  
REV. DATE  
REV. DATE  
REV. DATE

SHEET:  
**P 2.0**

OF