


FORNEY ENG.

MR. SHAW  
358-3101  
SEE TYP. SECTION SHEET 12

B.M. #6 On Conc. Base To Lamp Post At S.W. Corner Of Inter. Willey Post Rd & Midway Rd. Elev. 631.34  
B.M. #7 On Bottom Step To Loading Dock At 15302 Midway Rd. Elev. 635.05

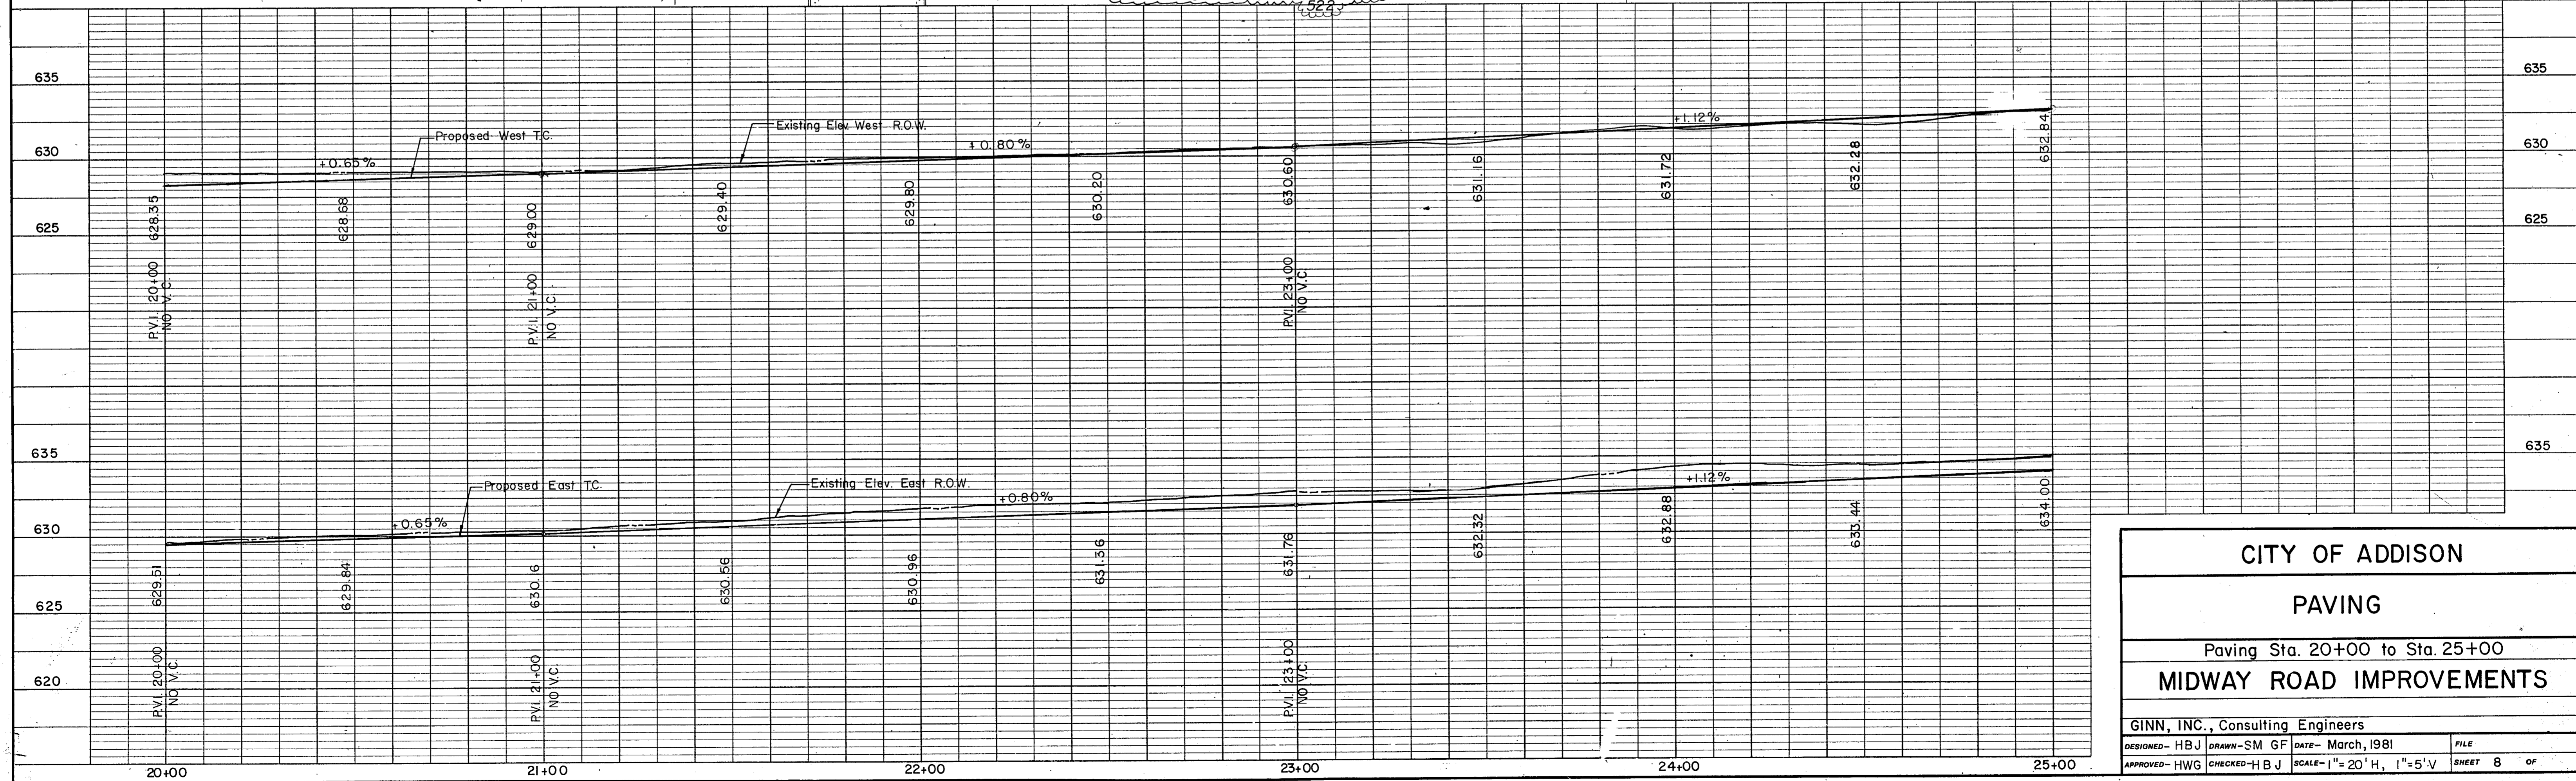

<b>CITY OF ADDISON</b>	
<b>PAVING</b>	
Paving Sta. 20+00 to Sta. 25+00	
<b>MIDWAY ROAD IMPROVEMENTS</b>	
GINN, INC., Consulting Engineers	
DESIGNED - HBJ	DRAWN - SM GF
DATE - March, 1981	FILE
APPROVED - HWG	CHECKED - HBJ
SCALE - 1" = 20' H, 1" = 5' V	SHEET 8 OF