

Sta. 30+00
I.P. Set 100' Lt.

Sta. 30+00
I.P. Set 50' Lt.

Sta. 30+00
I.P. Set 50' Rt.

Sta. 30+00
I.P. Set 100' Rt.



Sta. 35+00
I.P. Set 100' Lt.

Sta. 35+00
I.P. Set 50' Lt.

Sta. 35+00
I.P. Set 50' Rt.

Sta. 35+00
I.P. Set 100' Rt.

CAUTION: Underground Telephone

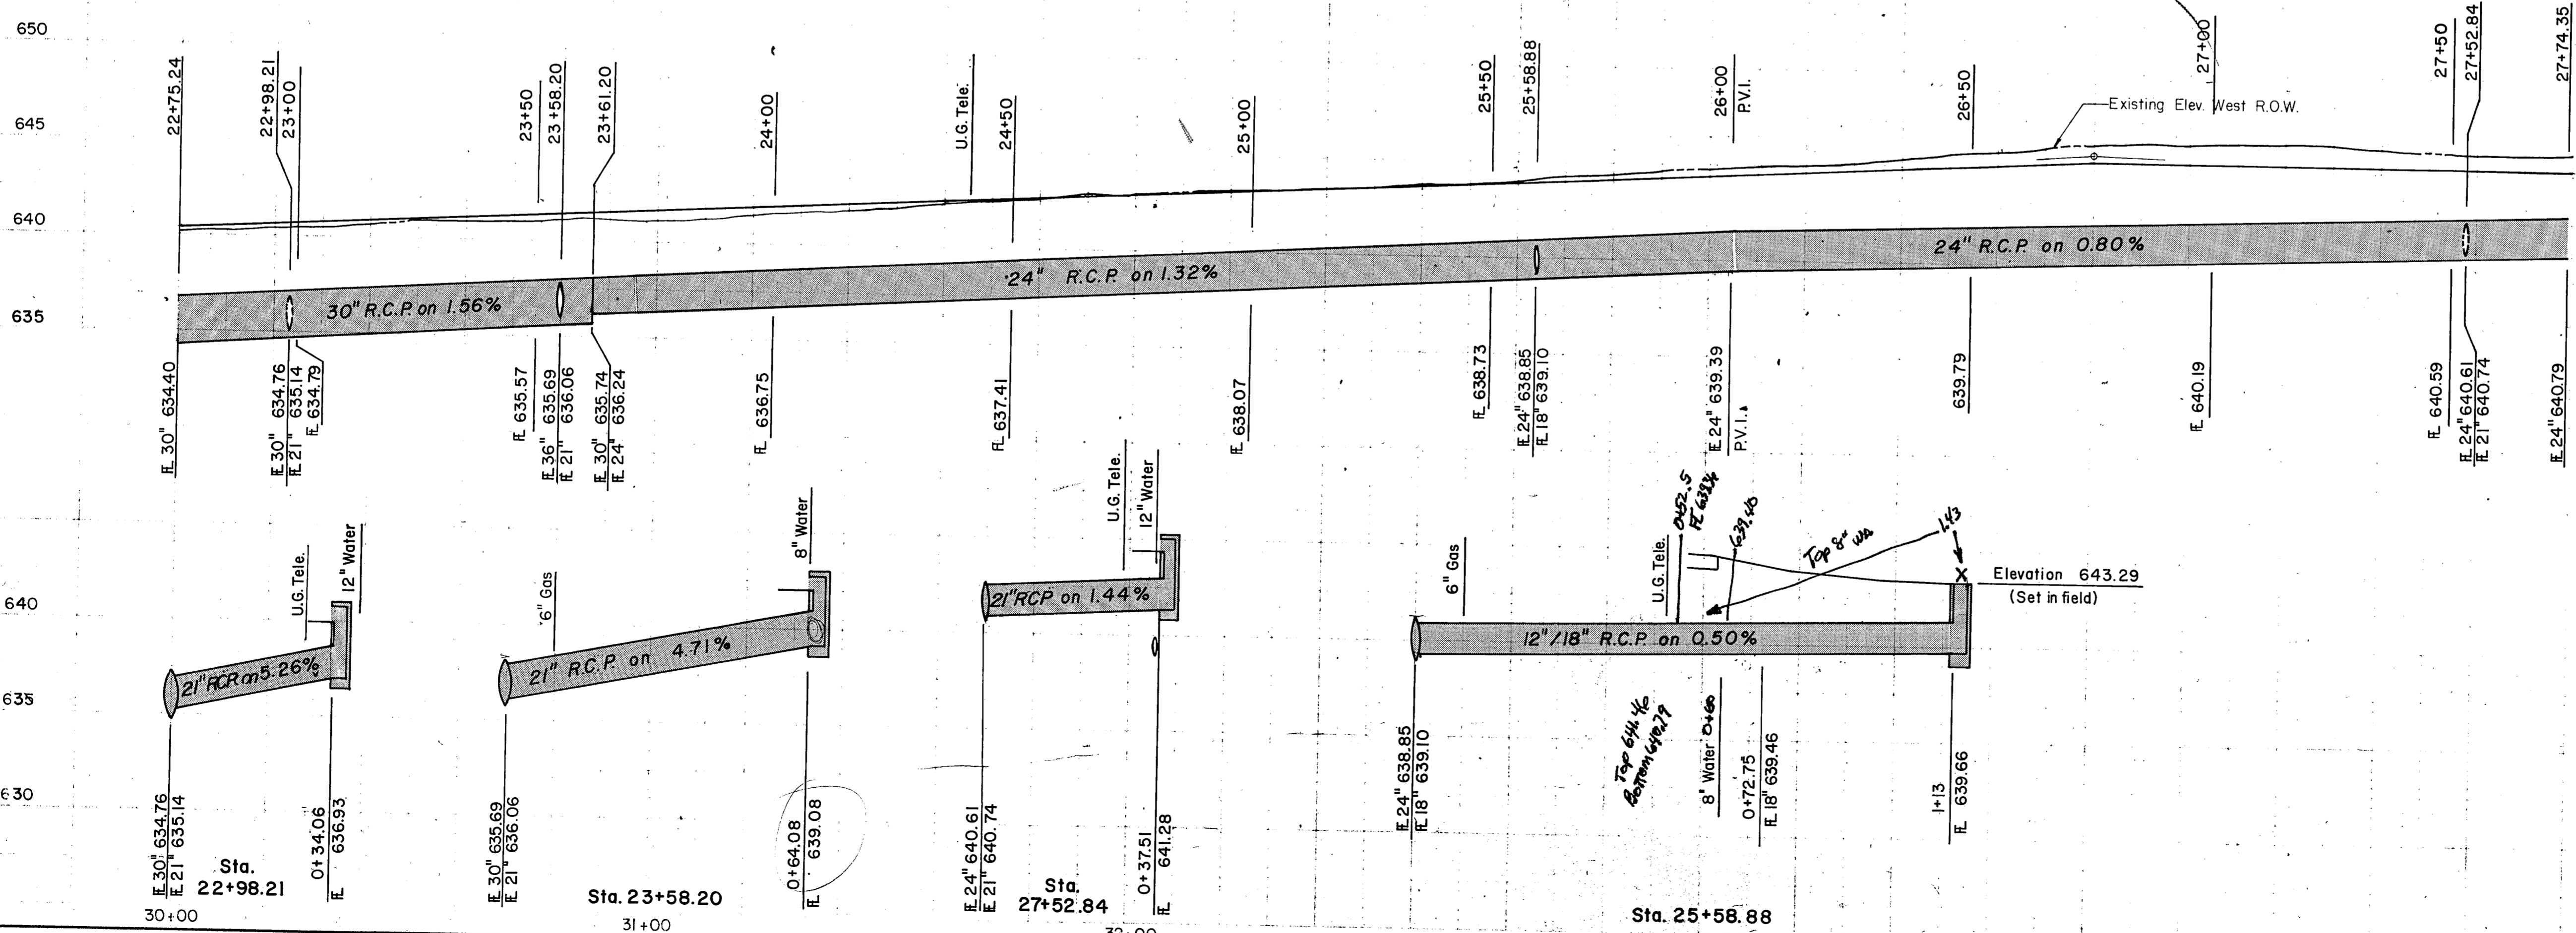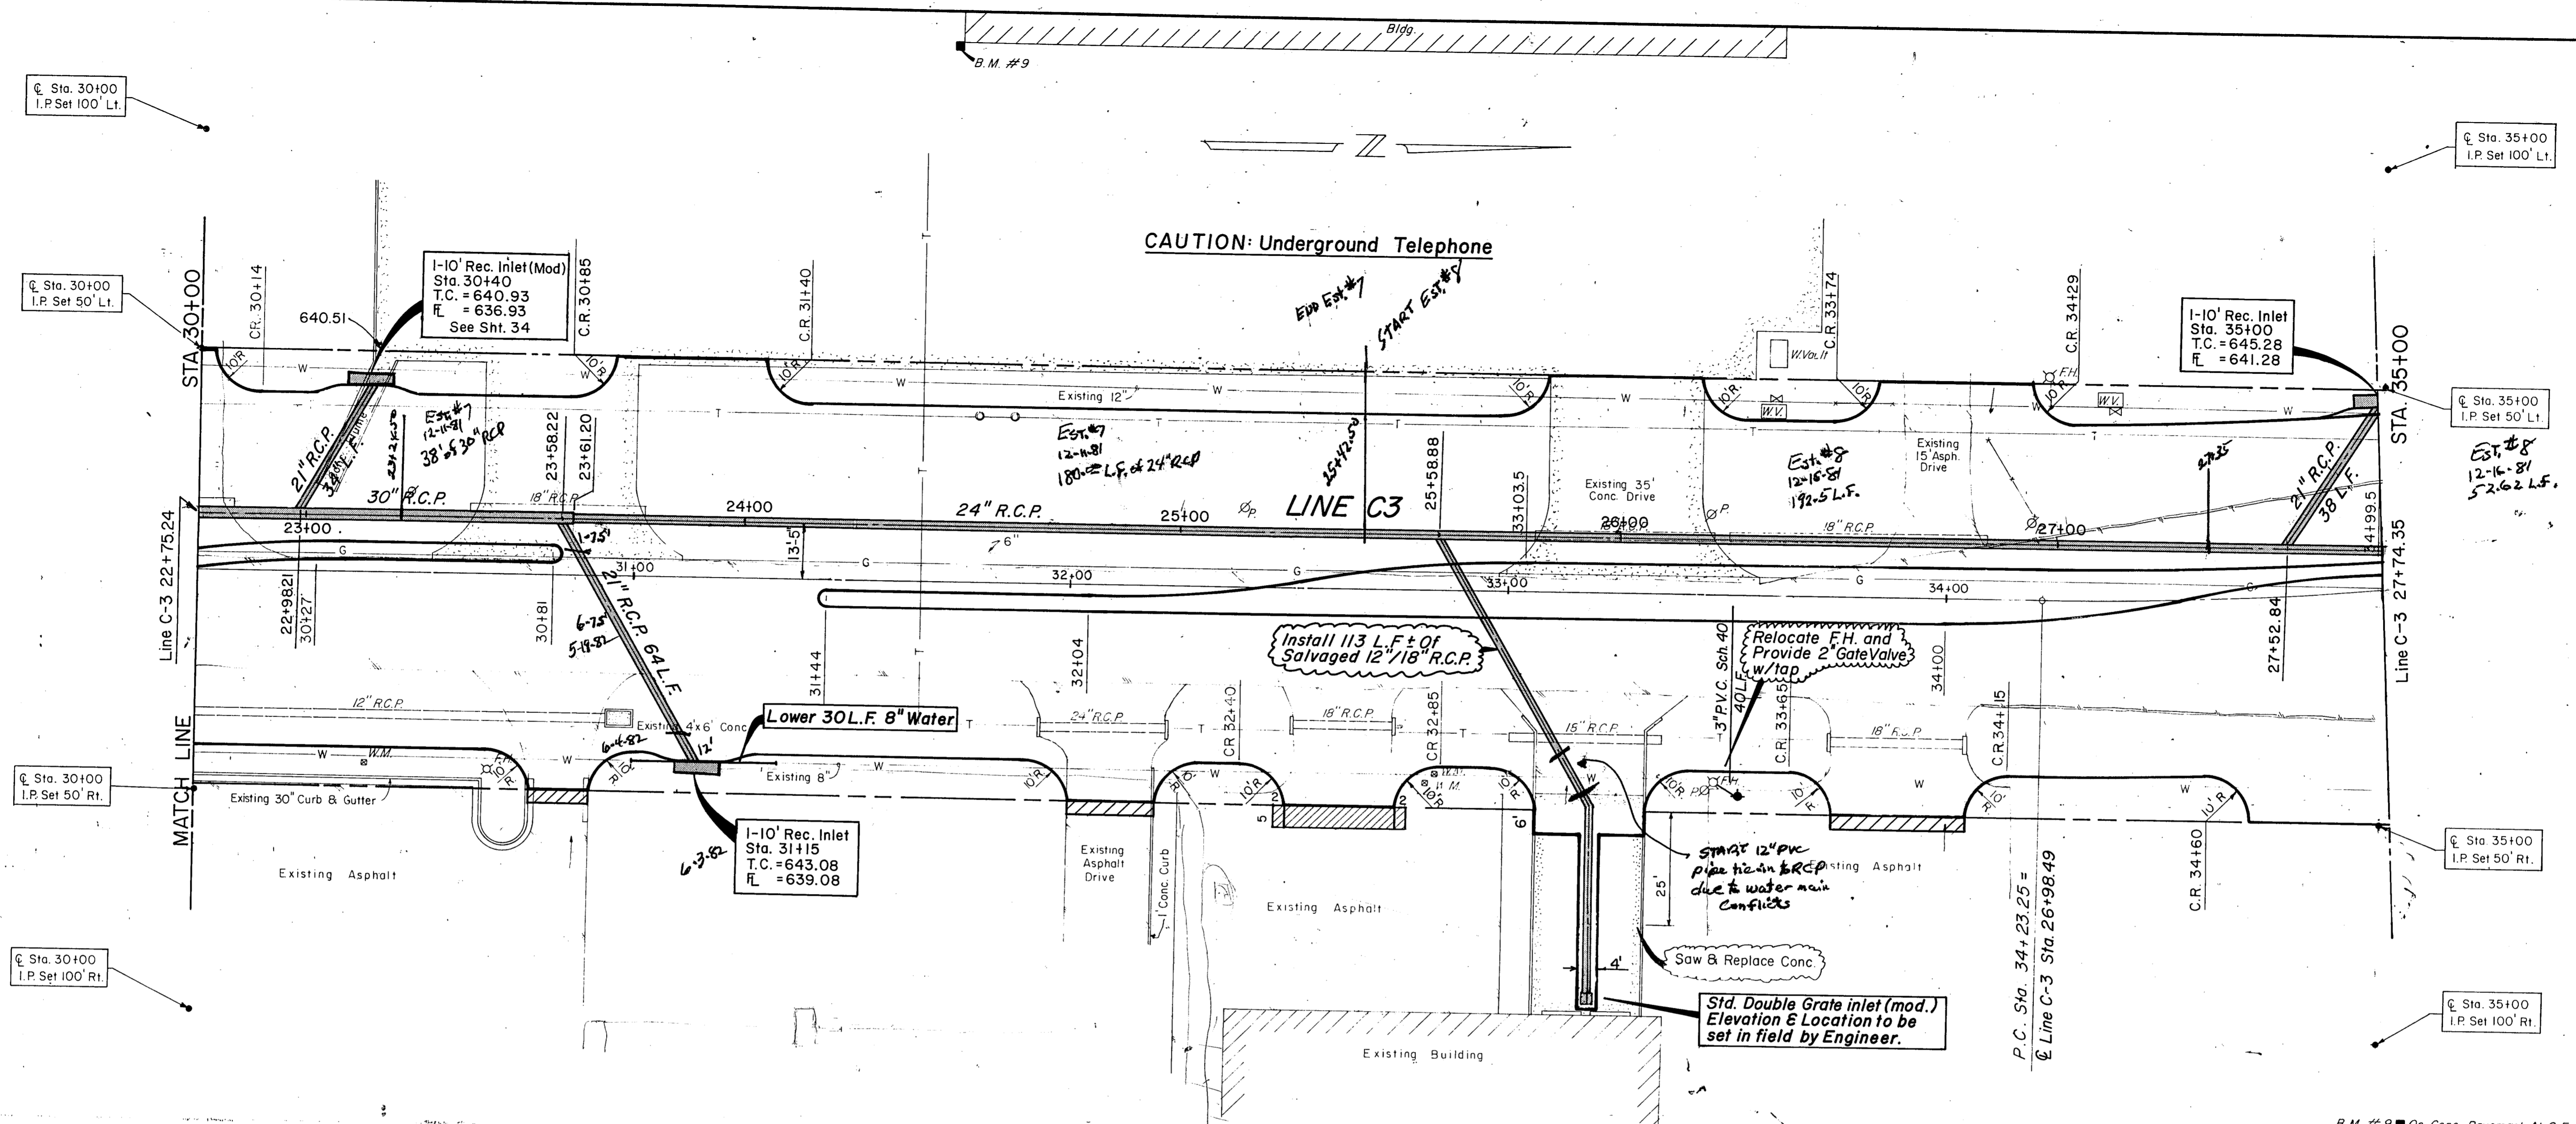

B.M. #9 On Conc. Pavement At S.E. Corner Of Bldg. At 15635 Midway Rd. Elev. 642.61

CITY OF ADDISON			
DRAINAGE LINE C3			
PAVING STA. 30+00 TO STA. 35+00			
MIDWAY ROAD IMPROVEMENTS			
GINN, INC., Consulting Engineers			
DESIGNED - ACF	DRAWN - SM RB	DATE - March, 1981	FILE
APPROVED - HWG	CHECKED - HBJ	SCALE - 1" = 20' H, 1" = 5' V	SHEET 21 OF