


NOTE:
Sanitary Sewer shall be Relocated prior to Construction of Box Culvert.

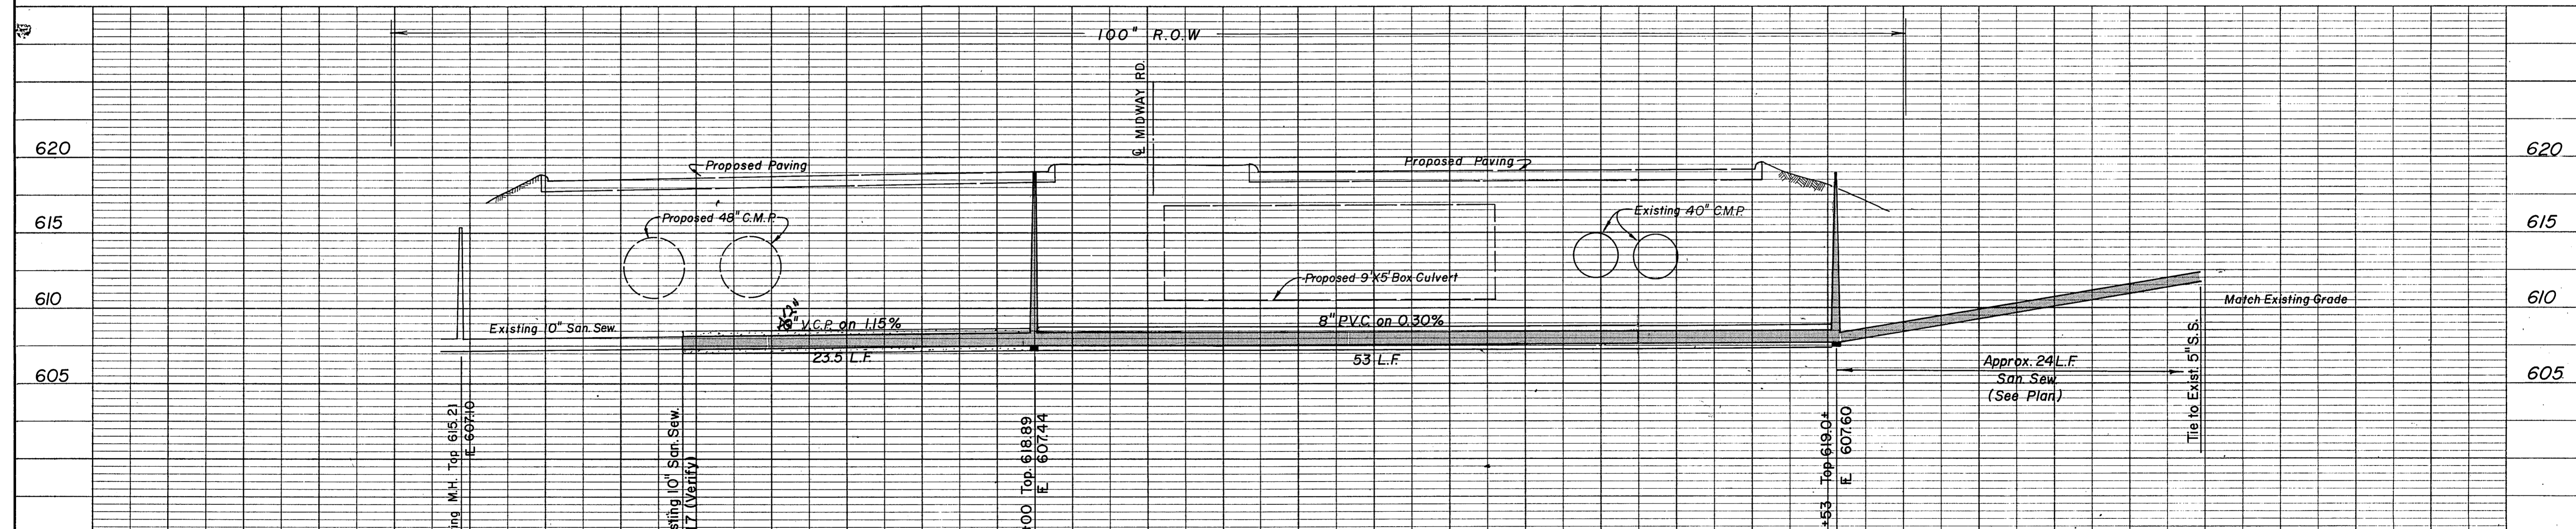

CITY OF ADDISON			
SANITARY SEWER			
RELOCATION			
MIDWAY ROAD IMPROVEMENTS			
<small>GINN, INC., Consulting Engineers</small>			
<small>DESIGNED-ACF</small>	<small>DRAWN-RGB</small>	<small>DATE-MARCH, 1981</small>	<small>FILE</small>
<small>APPROVED-HWJ</small>	<small>CHECKED-HBJ</small>	<small>SCALE-3/16"=1'H. 1"=5'V</small>	<small>SHEET 23 OF 1</small>