


CONSTRUCT M.H.
18' Lt. @ Sta. 8+09
(Verify location exist. pipe)
Top El. = 609.5
F. El. = 602.56
NOTE: DROP M.H.

Construct 368 L.F. - 6" sanitary sewer line @ 0.65% slope
Est. #1
7-3-81 7-4-81

TIE PROPOSED CONC. RIPRAP TO EXISTING FLUME AS SHOWN. MATCH EXIST. GRADE AT EDGE OF FLUME. SEE SHT. 30

PLAN
1" = 20'

FOR SECTION A-A, SEE SHT. 32

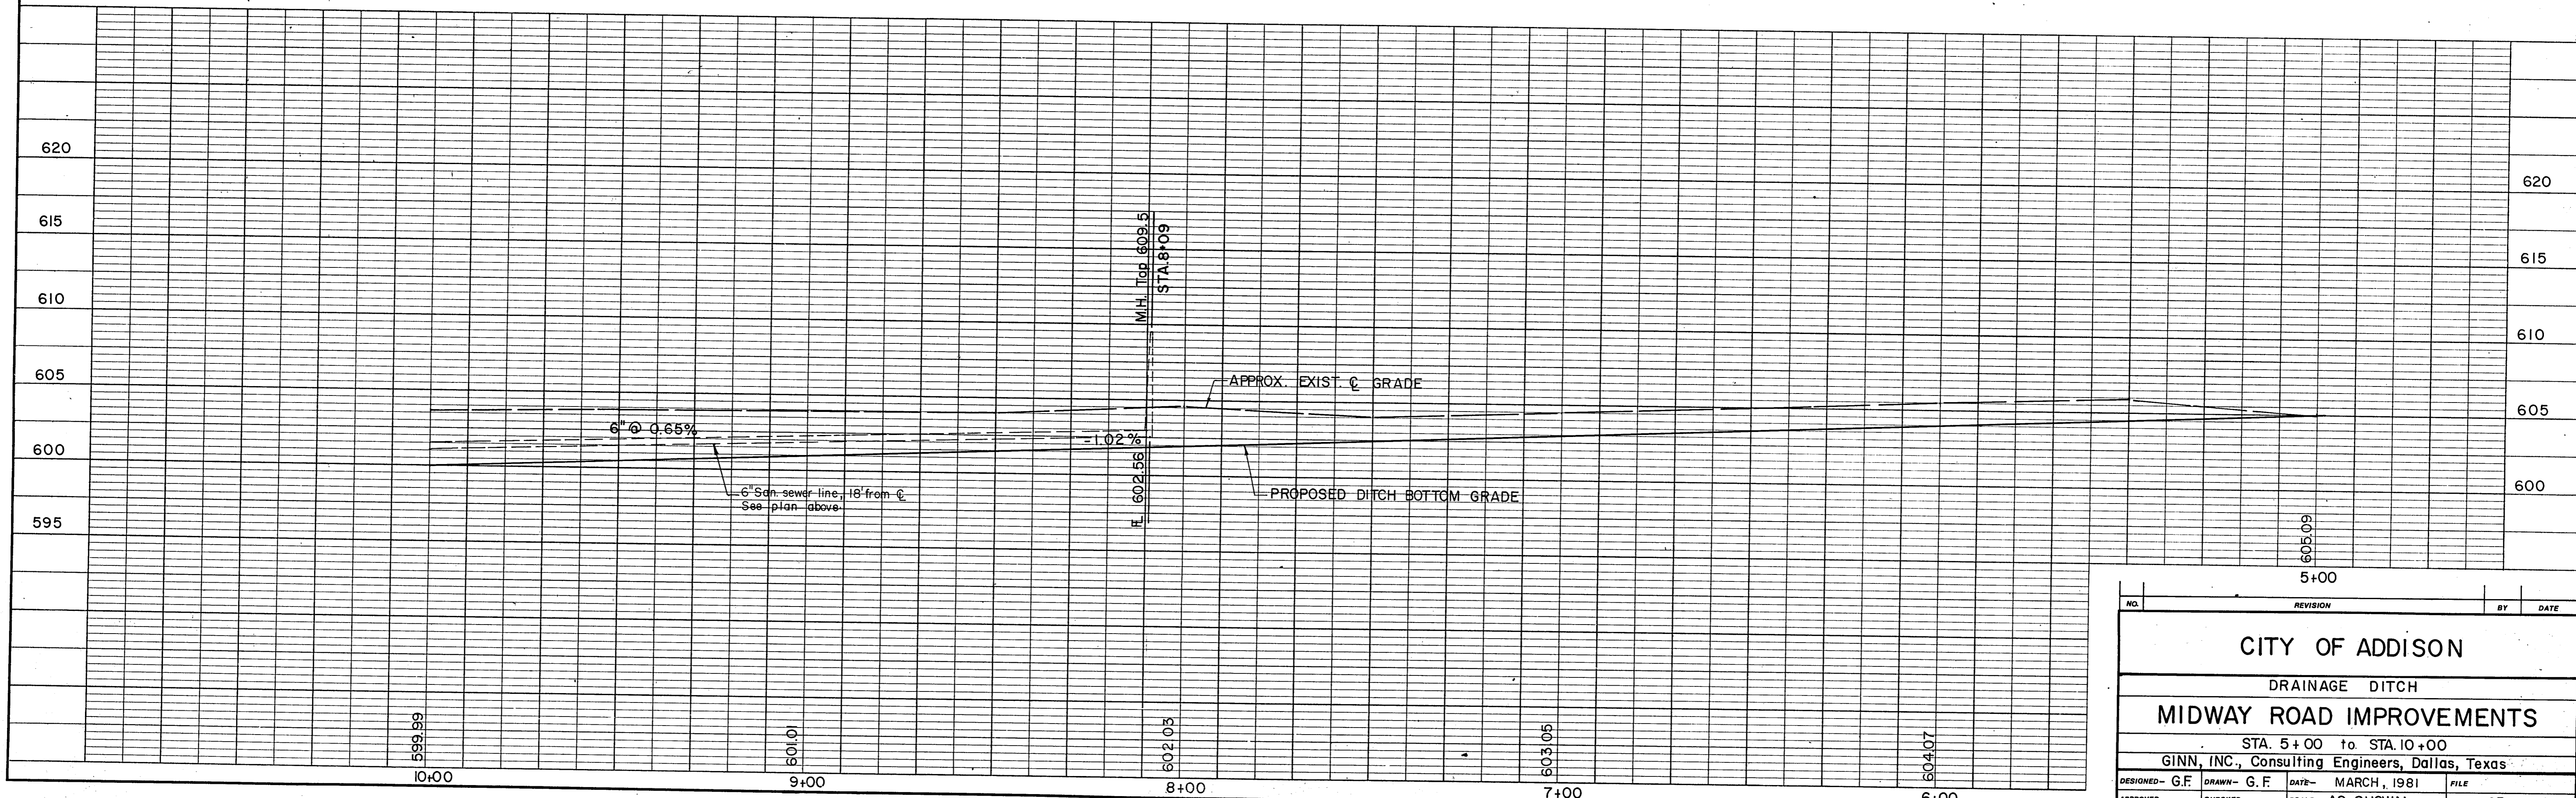

NO.	REVISION	BY	DATE
CITY OF ADDISON DRAINAGE DITCH MIDWAY ROAD IMPROVEMENTS STA. 5+00 to STA. 10+00 GINN, INC., Consulting Engineers, Dallas, Texas			
DESIGNED-	G.F.	DRAWN-	G.F.
DATE-	MARCH, 1981	FILE	
APPROVED-	CHECKED-	SCALE-	AS SHOWN
		SHEET	27 OF