


MATCH LINE STA. 13+00


MATCH LINE STA. 18+00

### MIDWAY ROAD

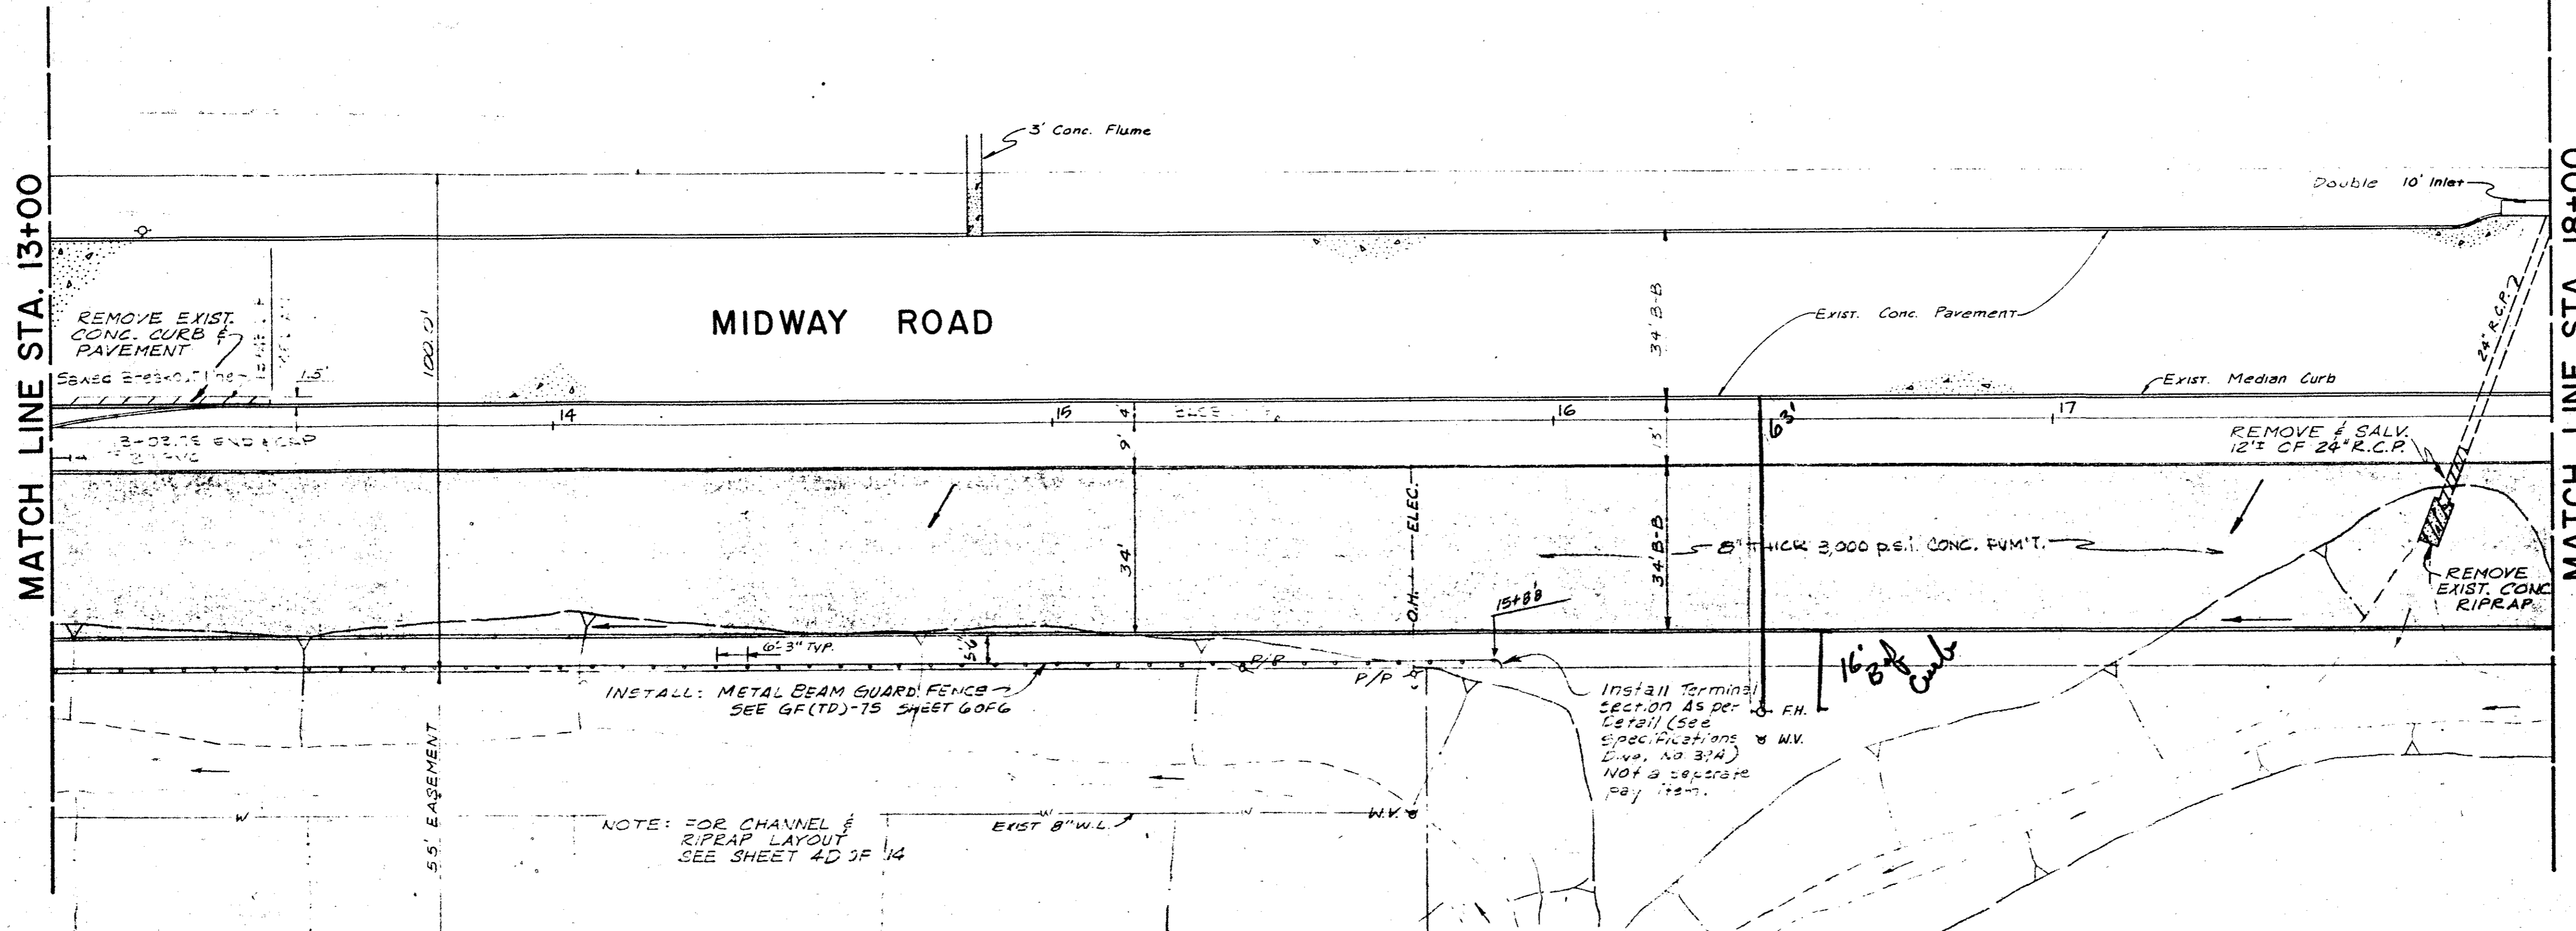

For General Notes and Typical Detail See Sheet 14

T.P. - Top Operating Nut F.H. STA. 18+35.5 Lt. Elev. 606.97

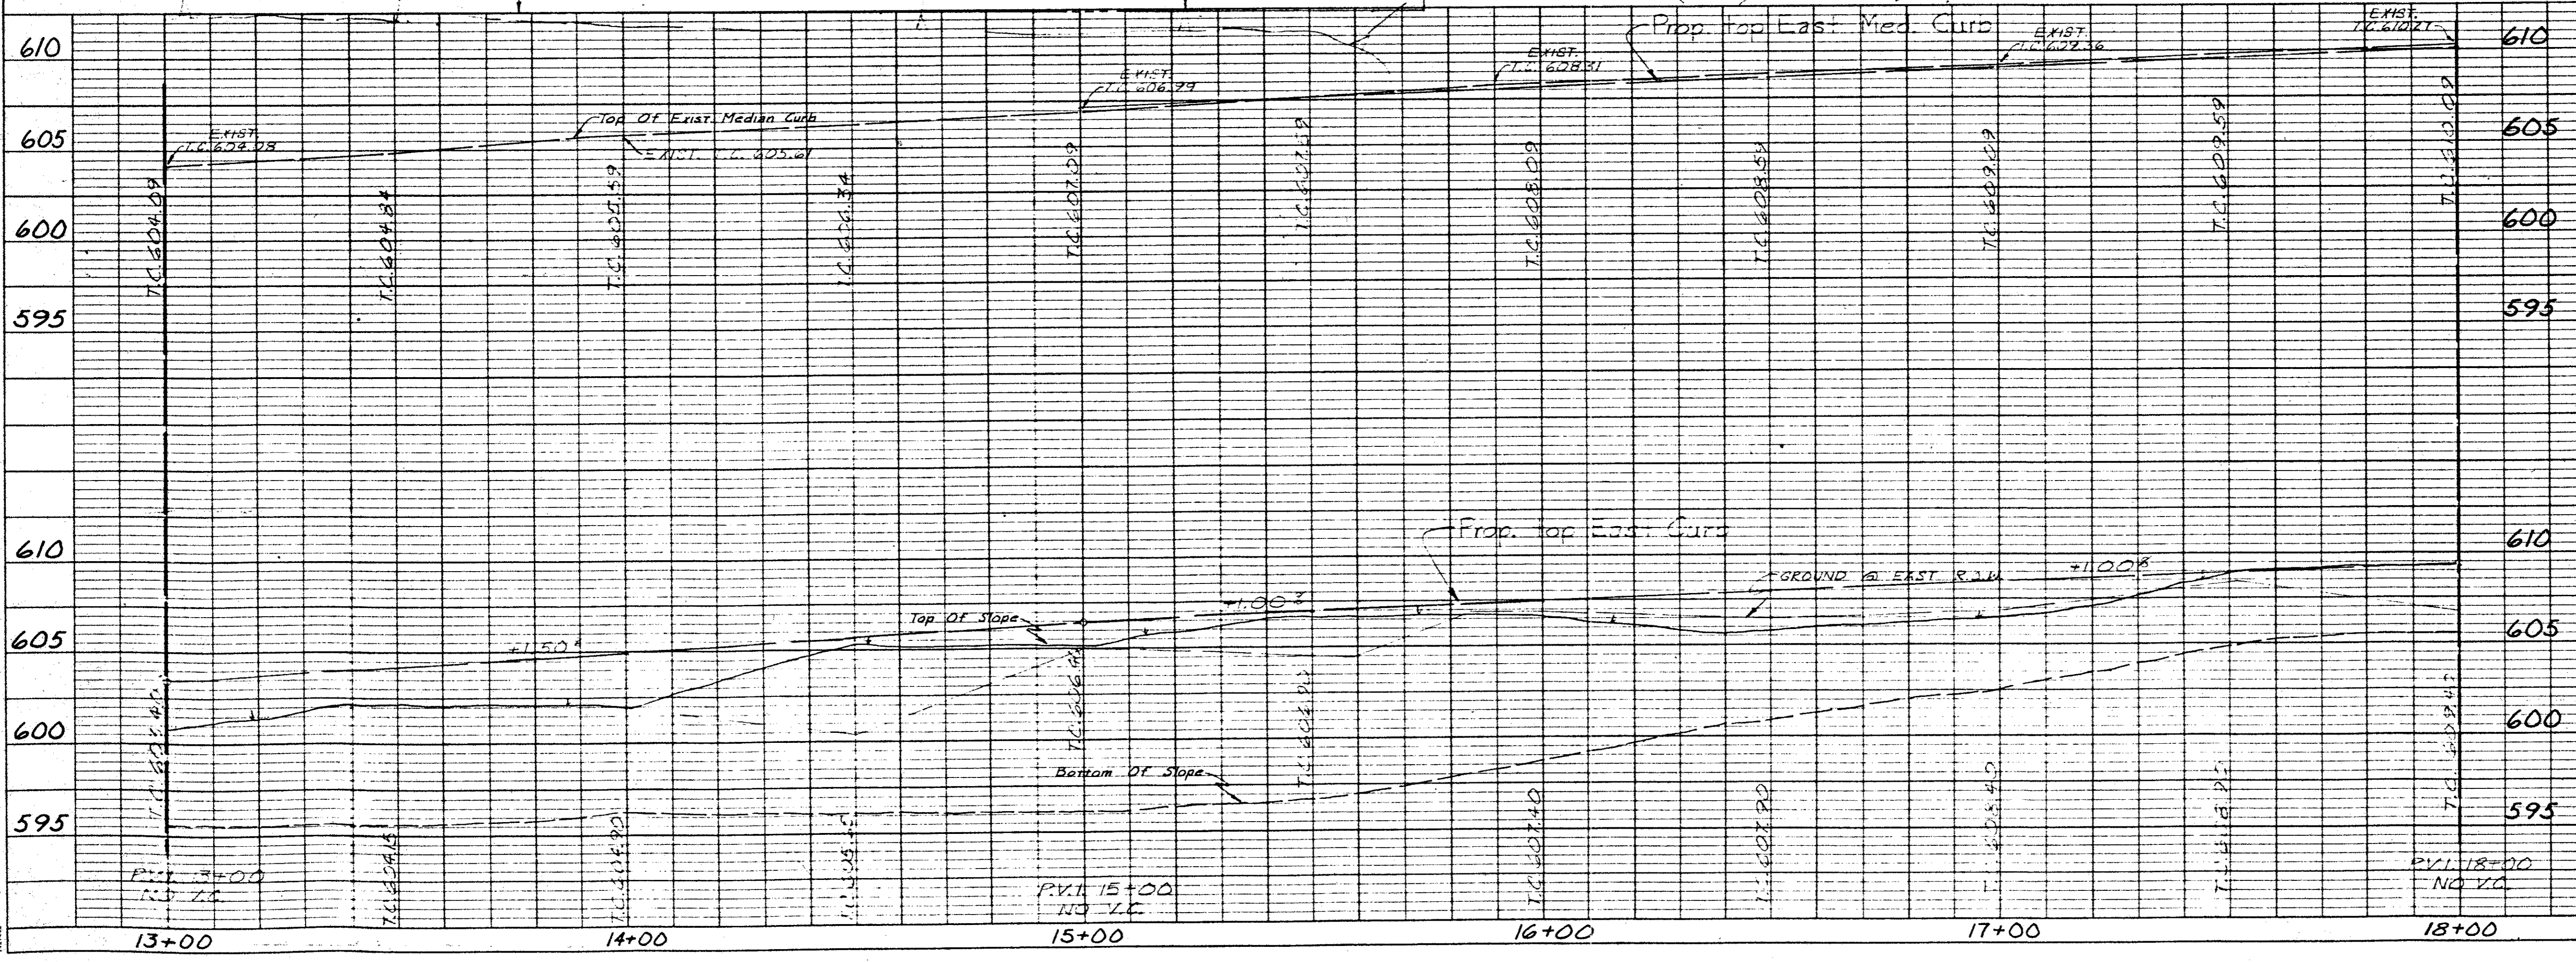

REVISION NO.	REMARKS	DATE
CITY OF CARROLLTON PAVING IMPROVEMENTS <b>MIDWAY ROAD</b> KELLER SPRINGS RD. TO TRINITY MILLS RD.		
<b>HUNTER ASSOCIATES INC.</b> ENGINEERS/PLANNERS/SURVEYORS DALLAS, TEXAS      AUSTIN, TEXAS 214-349-9171      512-454-8718		
DESIGNED BY: J.S.	SCALE: 1" = 20' H 1" = 5' V	
DRAWN BY: P.D.F.	APPROVED BY:	
JOB NUMBER: DB3099	DATE: SEPT 83	SHEET 4 OF 14

PLAN  
 SURVIVED  
 PORTLAND CEMENT CHECKED  
 NOTE BOOK  
 NO. \_\_\_\_\_

PROFILE  
 SURVIVED  
 PORTLAND CEMENT CHECKED  
 STRUCTURE NOTATIONS CHECKED  
 NOTE BOOK  
 NO. \_\_\_\_\_