

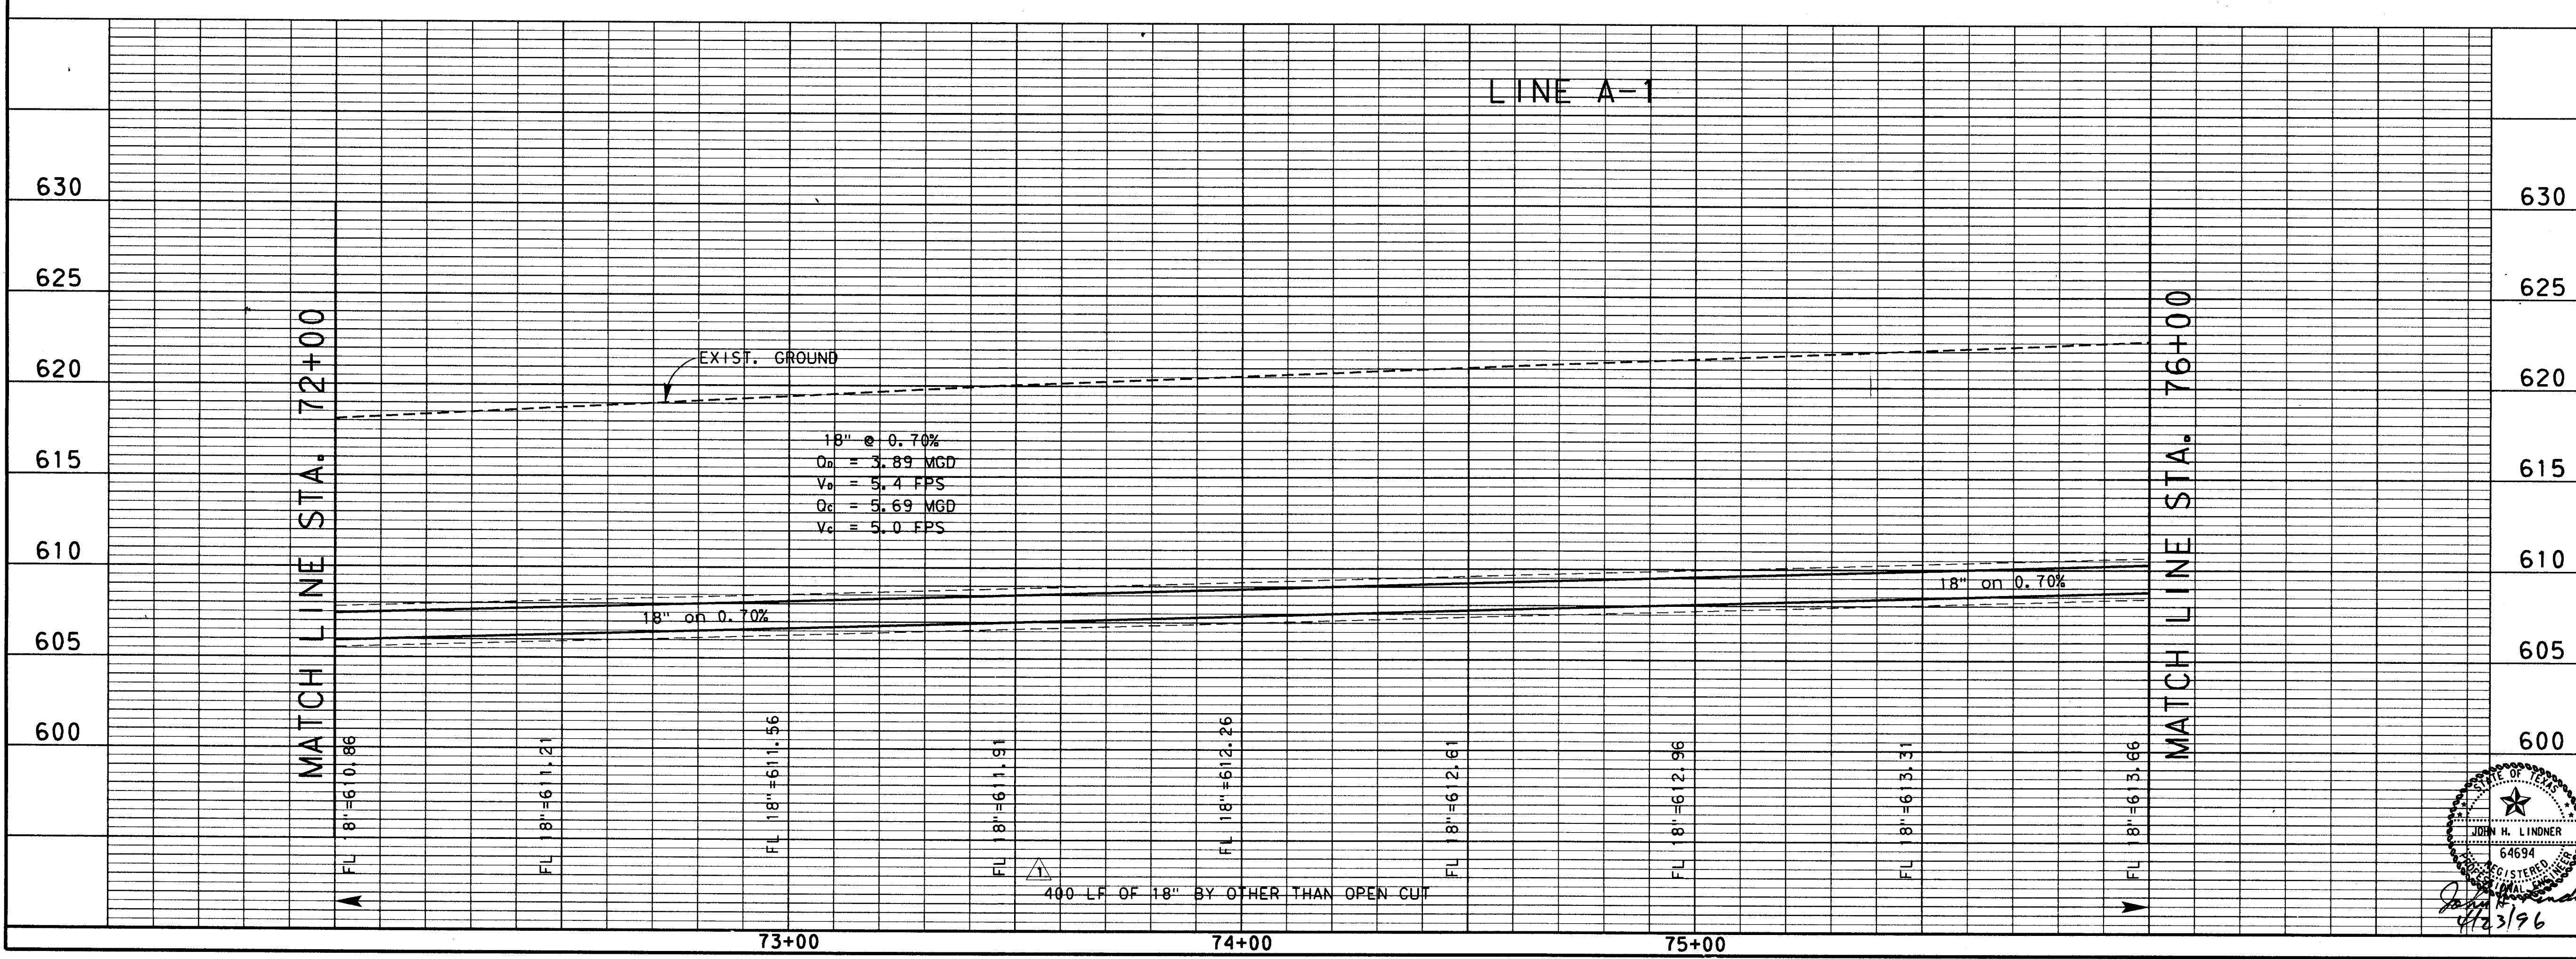


ELEVATION  
 APPROXIMATE  
 81008  
 81009  
 81010  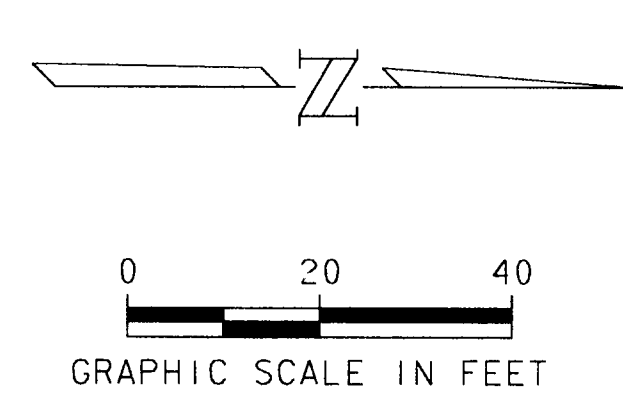
|  |            |                              |                |
|--|------------|------------------------------|----------------|
| 4  |            |                              |                |
| 3  |            |                              |                |
| 2  | 9-4-98     | AS BUILT DRAWING             | J. H. L.       |
| 1  | 4-23-96    | ADDENDUM NO. 1               | J. H. L.       |
| NO.  | DATE       | REVISION                     | APPROV.        |
| TOWN OF ADDISON, TEXAS   |            |                              |                |
| MIDWAY/BELTLINE SANITARY SEWER<br>PHASE II   |            |                              |                |
| LINE A-1<br>FROM STATION 72+00 TO STATION 76+00  |            |                              |                |
| <b>Carter-Burgess</b><br><small>Consultants in Engineering, Architecture,<br/>Planning and the Environment.</small><br>CARTER & BURGESS, INC.<br>7950 ELMBROOK DRIVE, SUITE 250<br>DALLAS, TX 75247-4963 |            |                              |                |
| Unit   | Scale      | Horiz. 1"=20'<br>Vert. 1"=5' | Date 04-05-96  |
| Designed   | J. Lindner | Checked                      | J. Lindner     |
| Drawn  | R. Howman  | Approved                     | J. Lindner     |
| Job No.  | 93327601D  |                              | Sheet 21 of 63 |

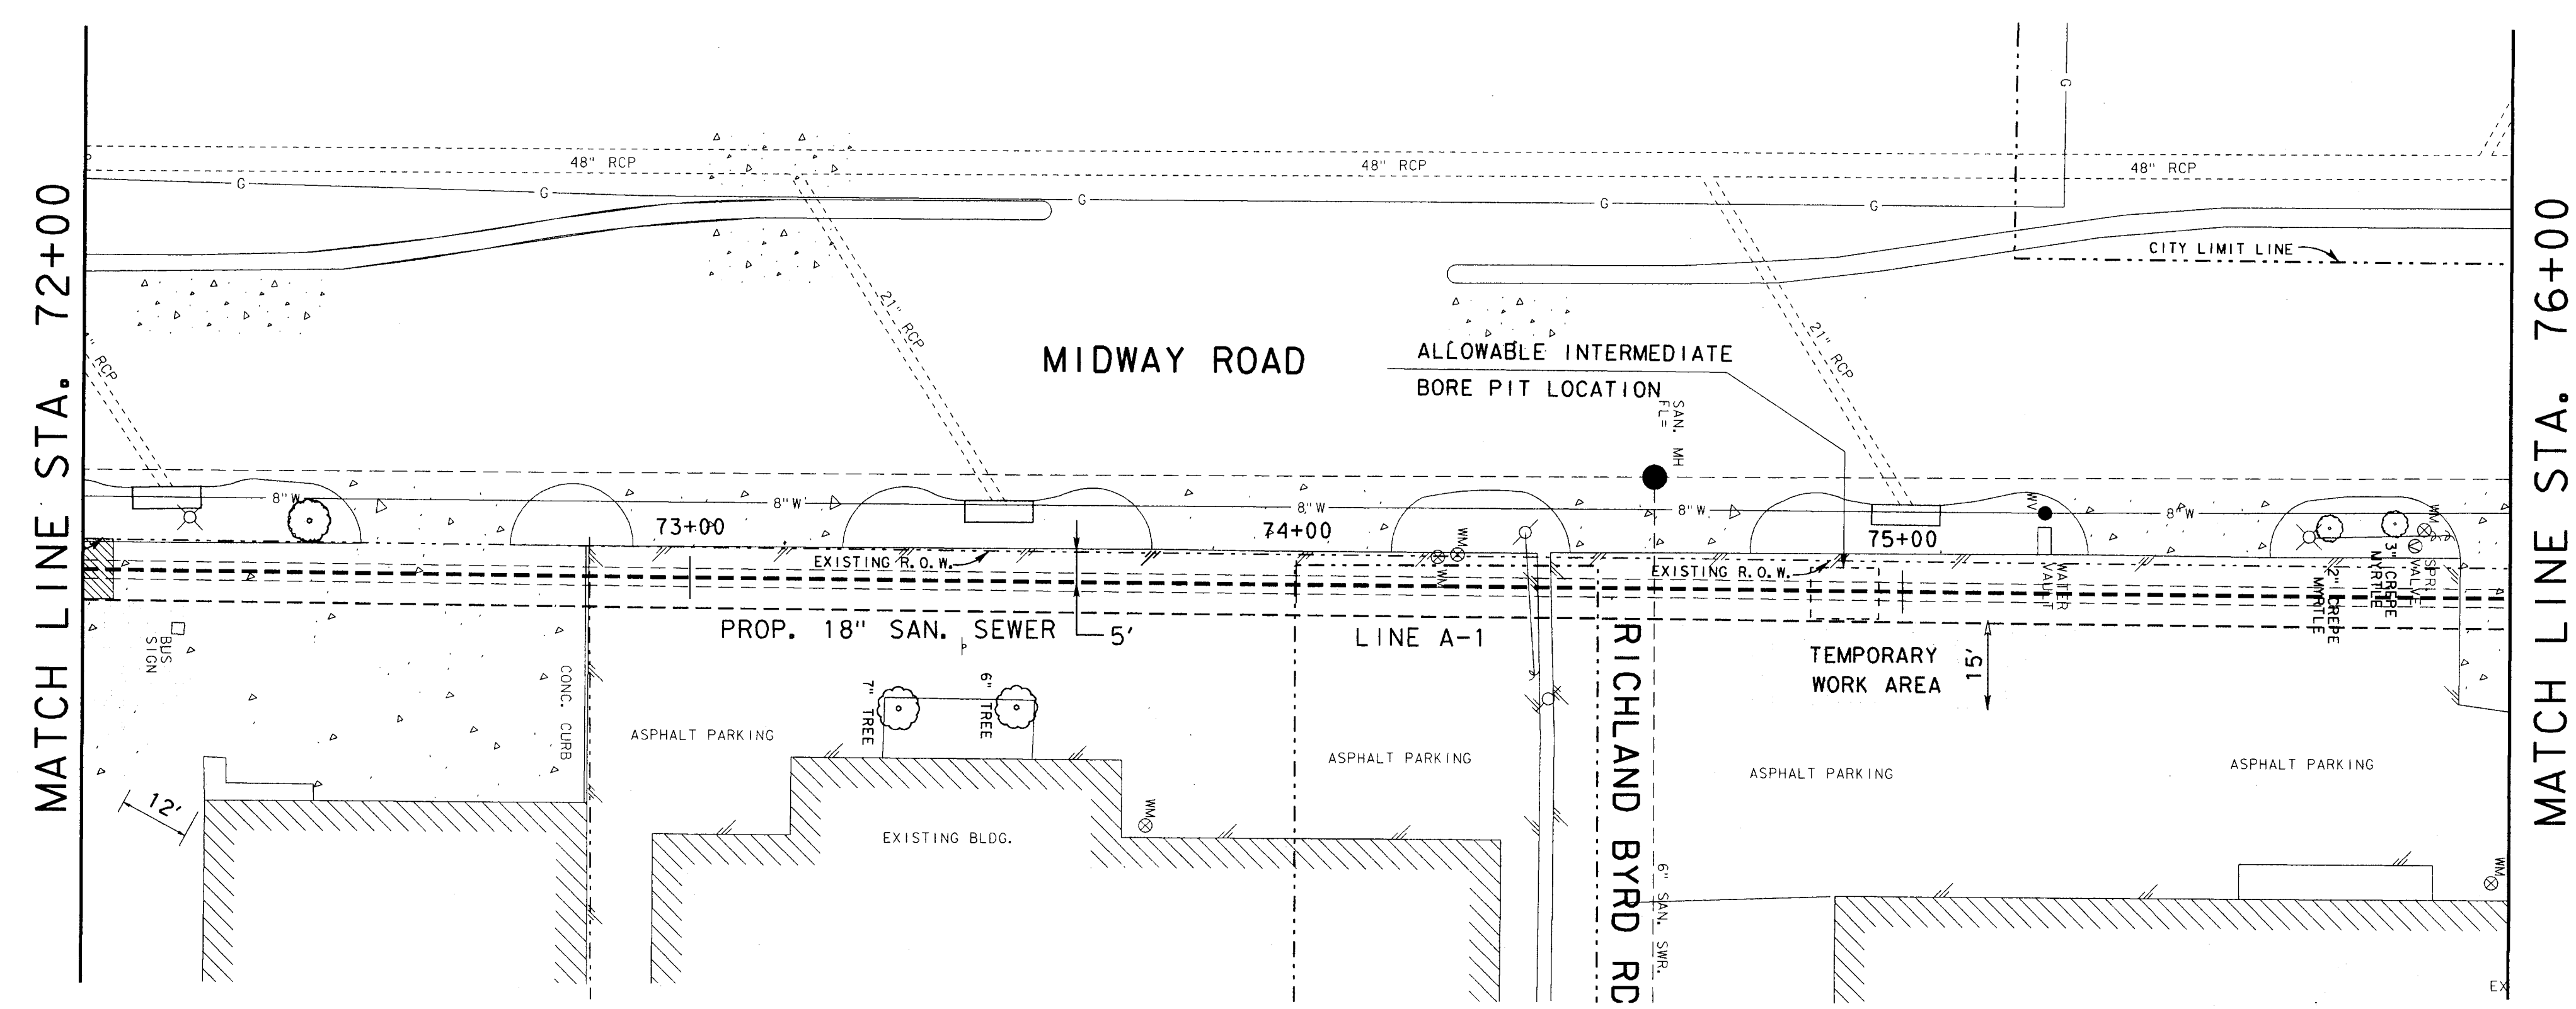