


LOWER LEVEL FLOOR PLAN
 1/4" = 1' - 0"
 A 40

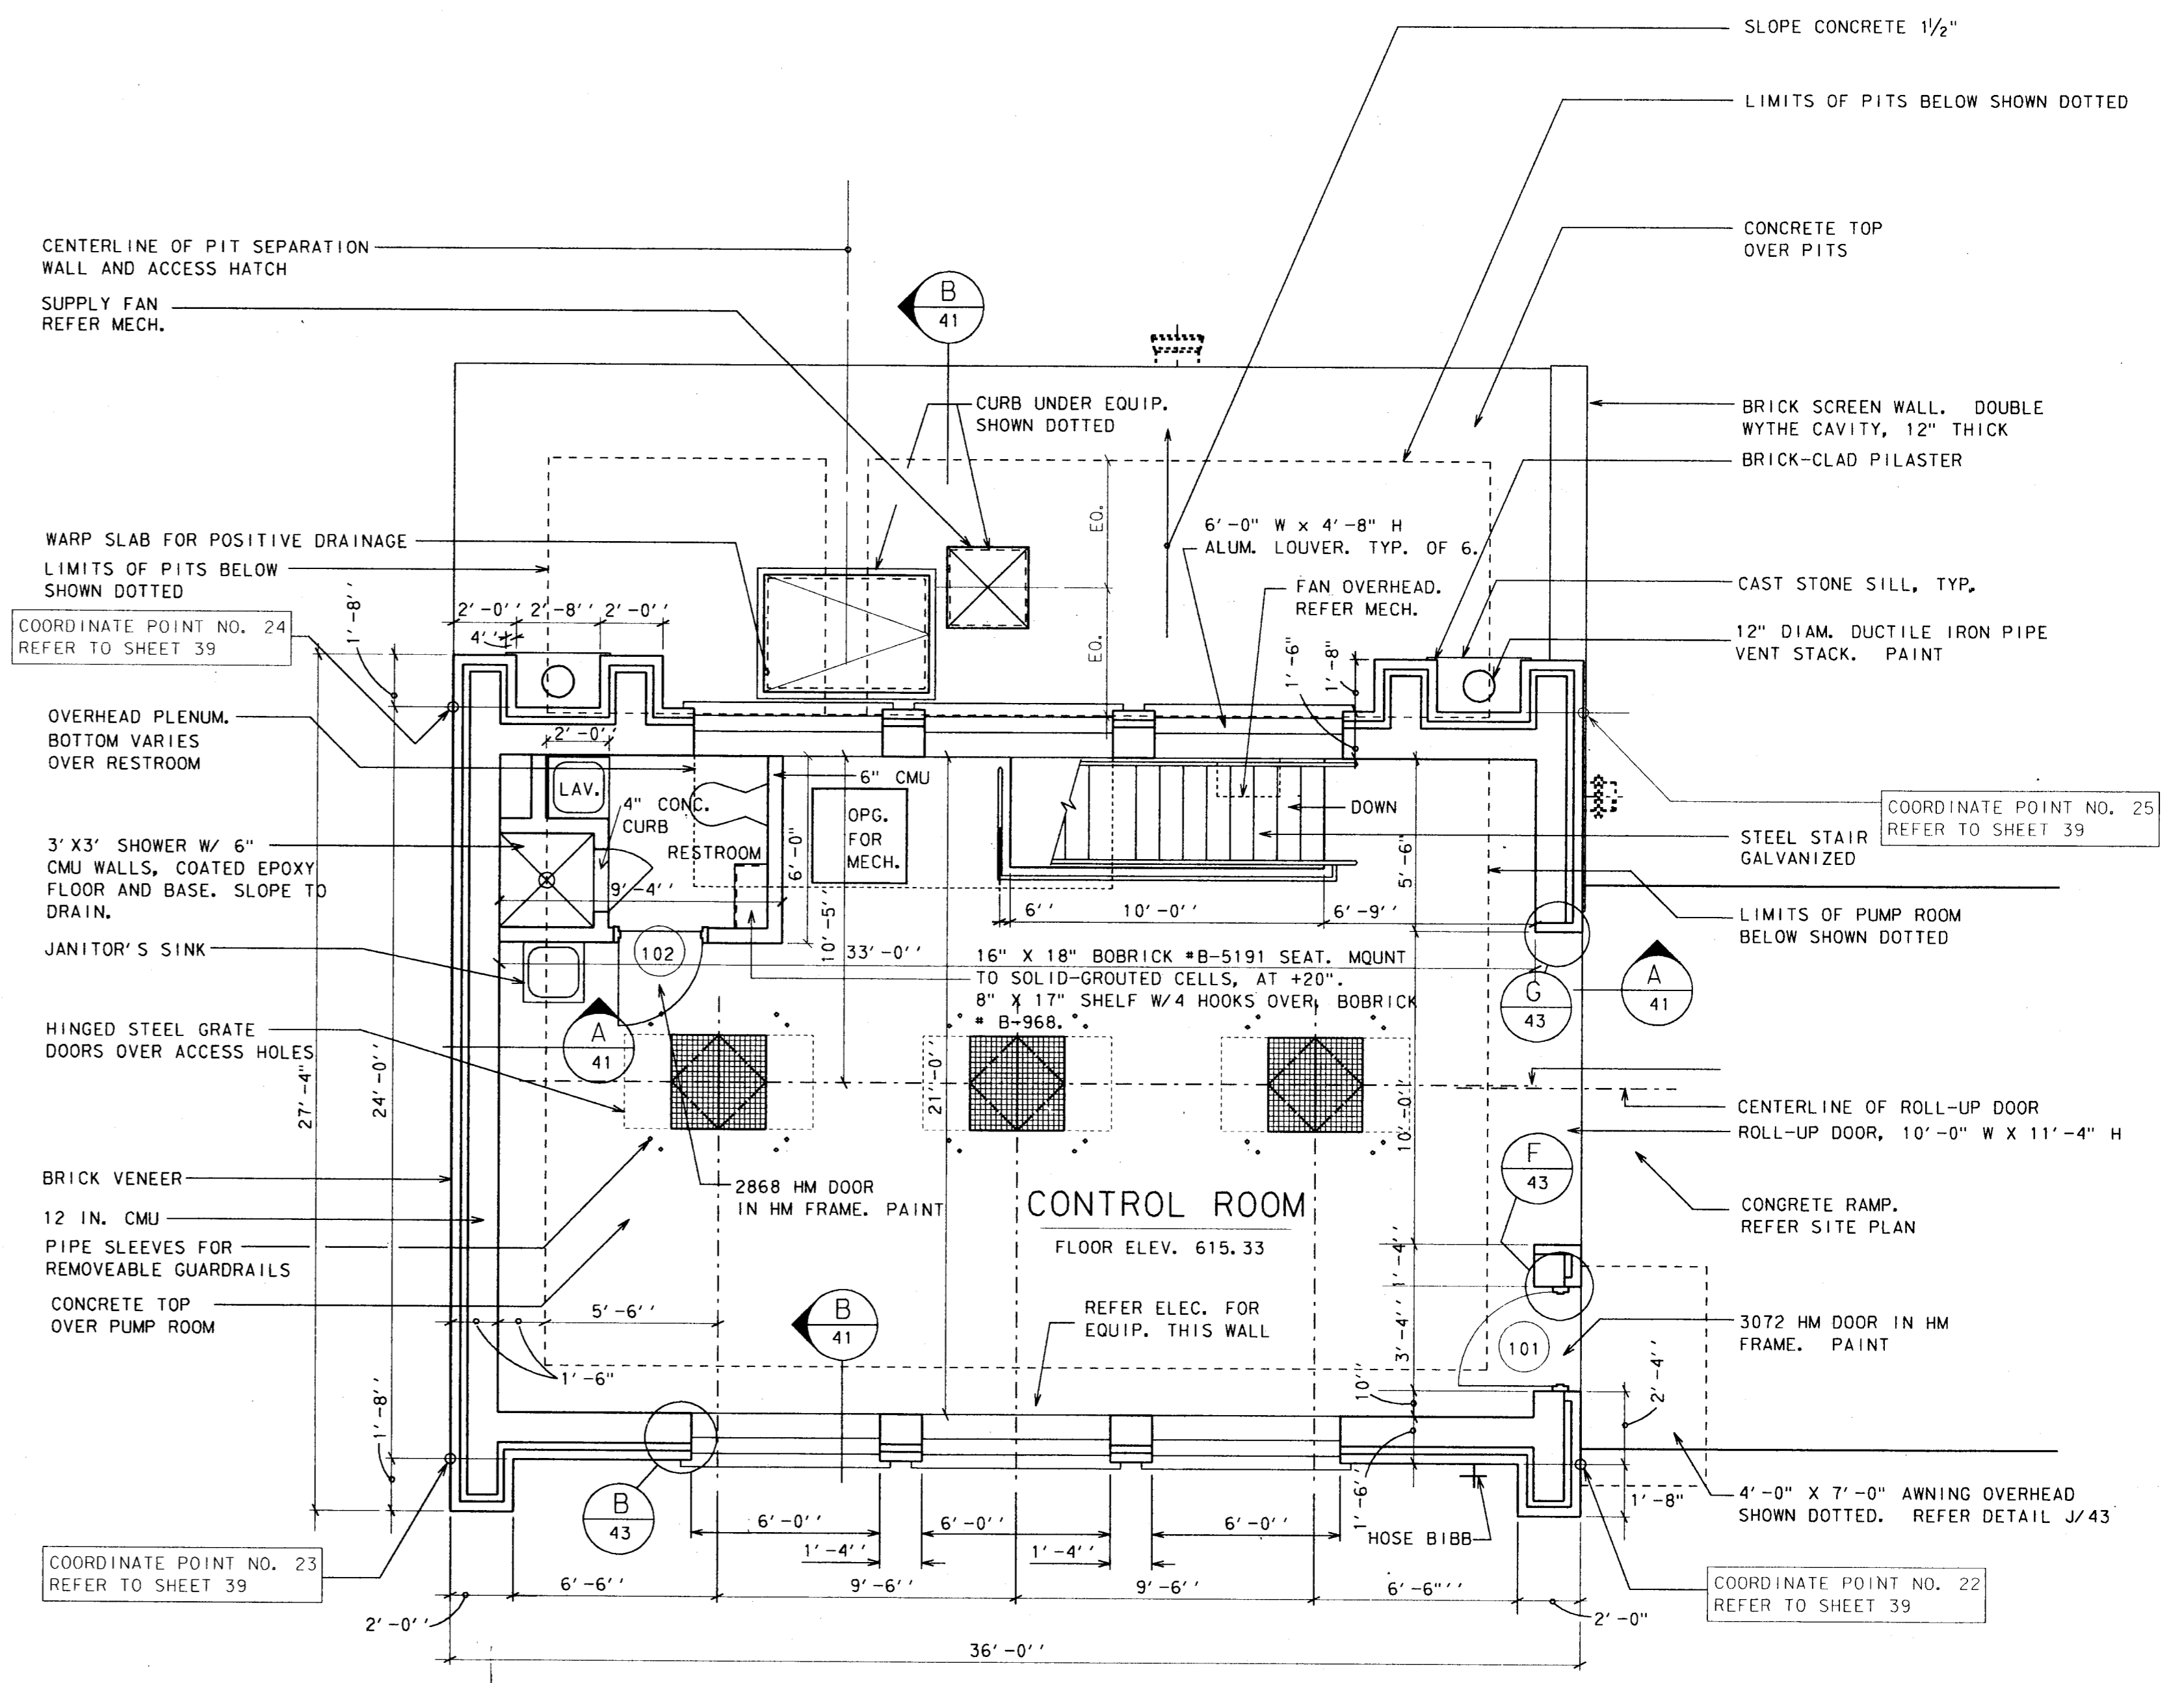

GROUND LEVEL FLOOR PLAN
 1/4" = 1' - 0"
 B 40

GENERAL NOTES:
 1. REFER TO SPECIFICATION SECTIONS
 09700 - SPECIAL FLOOR COATINGS AND
 09800 - SPECIAL COATINGS FOR FINISHES.
 2. SHOWER DOOR:
 HEAVY DUTY, 2'-0" x 6'-0". 1/4" WIDE STAINLESS
 STEEL FRAME HARDWARE AND ACCESSORIES. 1/2"
 TEMPERED PRIVACY GLASS. PROVIDE ALL STRIKES,
 BLOCKS, ATTACHMENTS AND OTHER COMPONENTS
 FOR COMPLETE SYSTEM.

4			
3			
2			
1	9-4-98	AS BUILT DRAWING	J. H. L.
NO.	DATE	REVISION	APPROV.
TOWN OF ADDISON, TEXAS			
MIDWAY/BELTLINE SANITARY SEWER PHASE II			
LIFT STATION - ARCHITECTURE FLOOR PLAN			
Carter & Burgess <small>Consultants in Engineering, Architecture, Planning and the Environment</small> CARTER & BURGESS, INC. <small>7350 ELMBROOK DRIVE, SUITE 250 DALLAS, TX 75247-4961</small>			
Unit	Scale	Date	04-05-96
Designed	R. WRIGHT	Checked	R. WRIGHT
Drawn	R. WRIGHT	Approved	J. Lindner
Job No.	93327601D	Sheet	40 of 63

