



ELEVATION 11
 ELEVATION 12
 ELEVATION 13
 ELEVATION 100

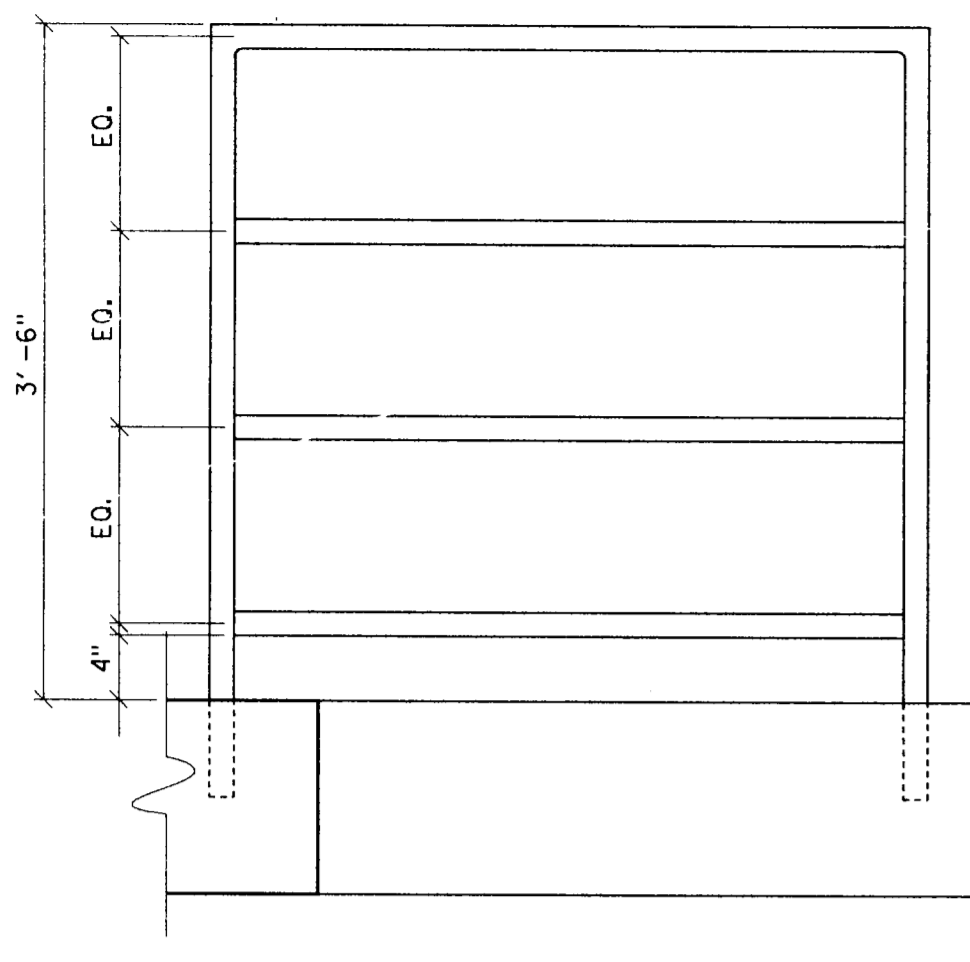


GUARDRAIL AT
 STAIR OPENING
 1"=1'-0"
 A
 44

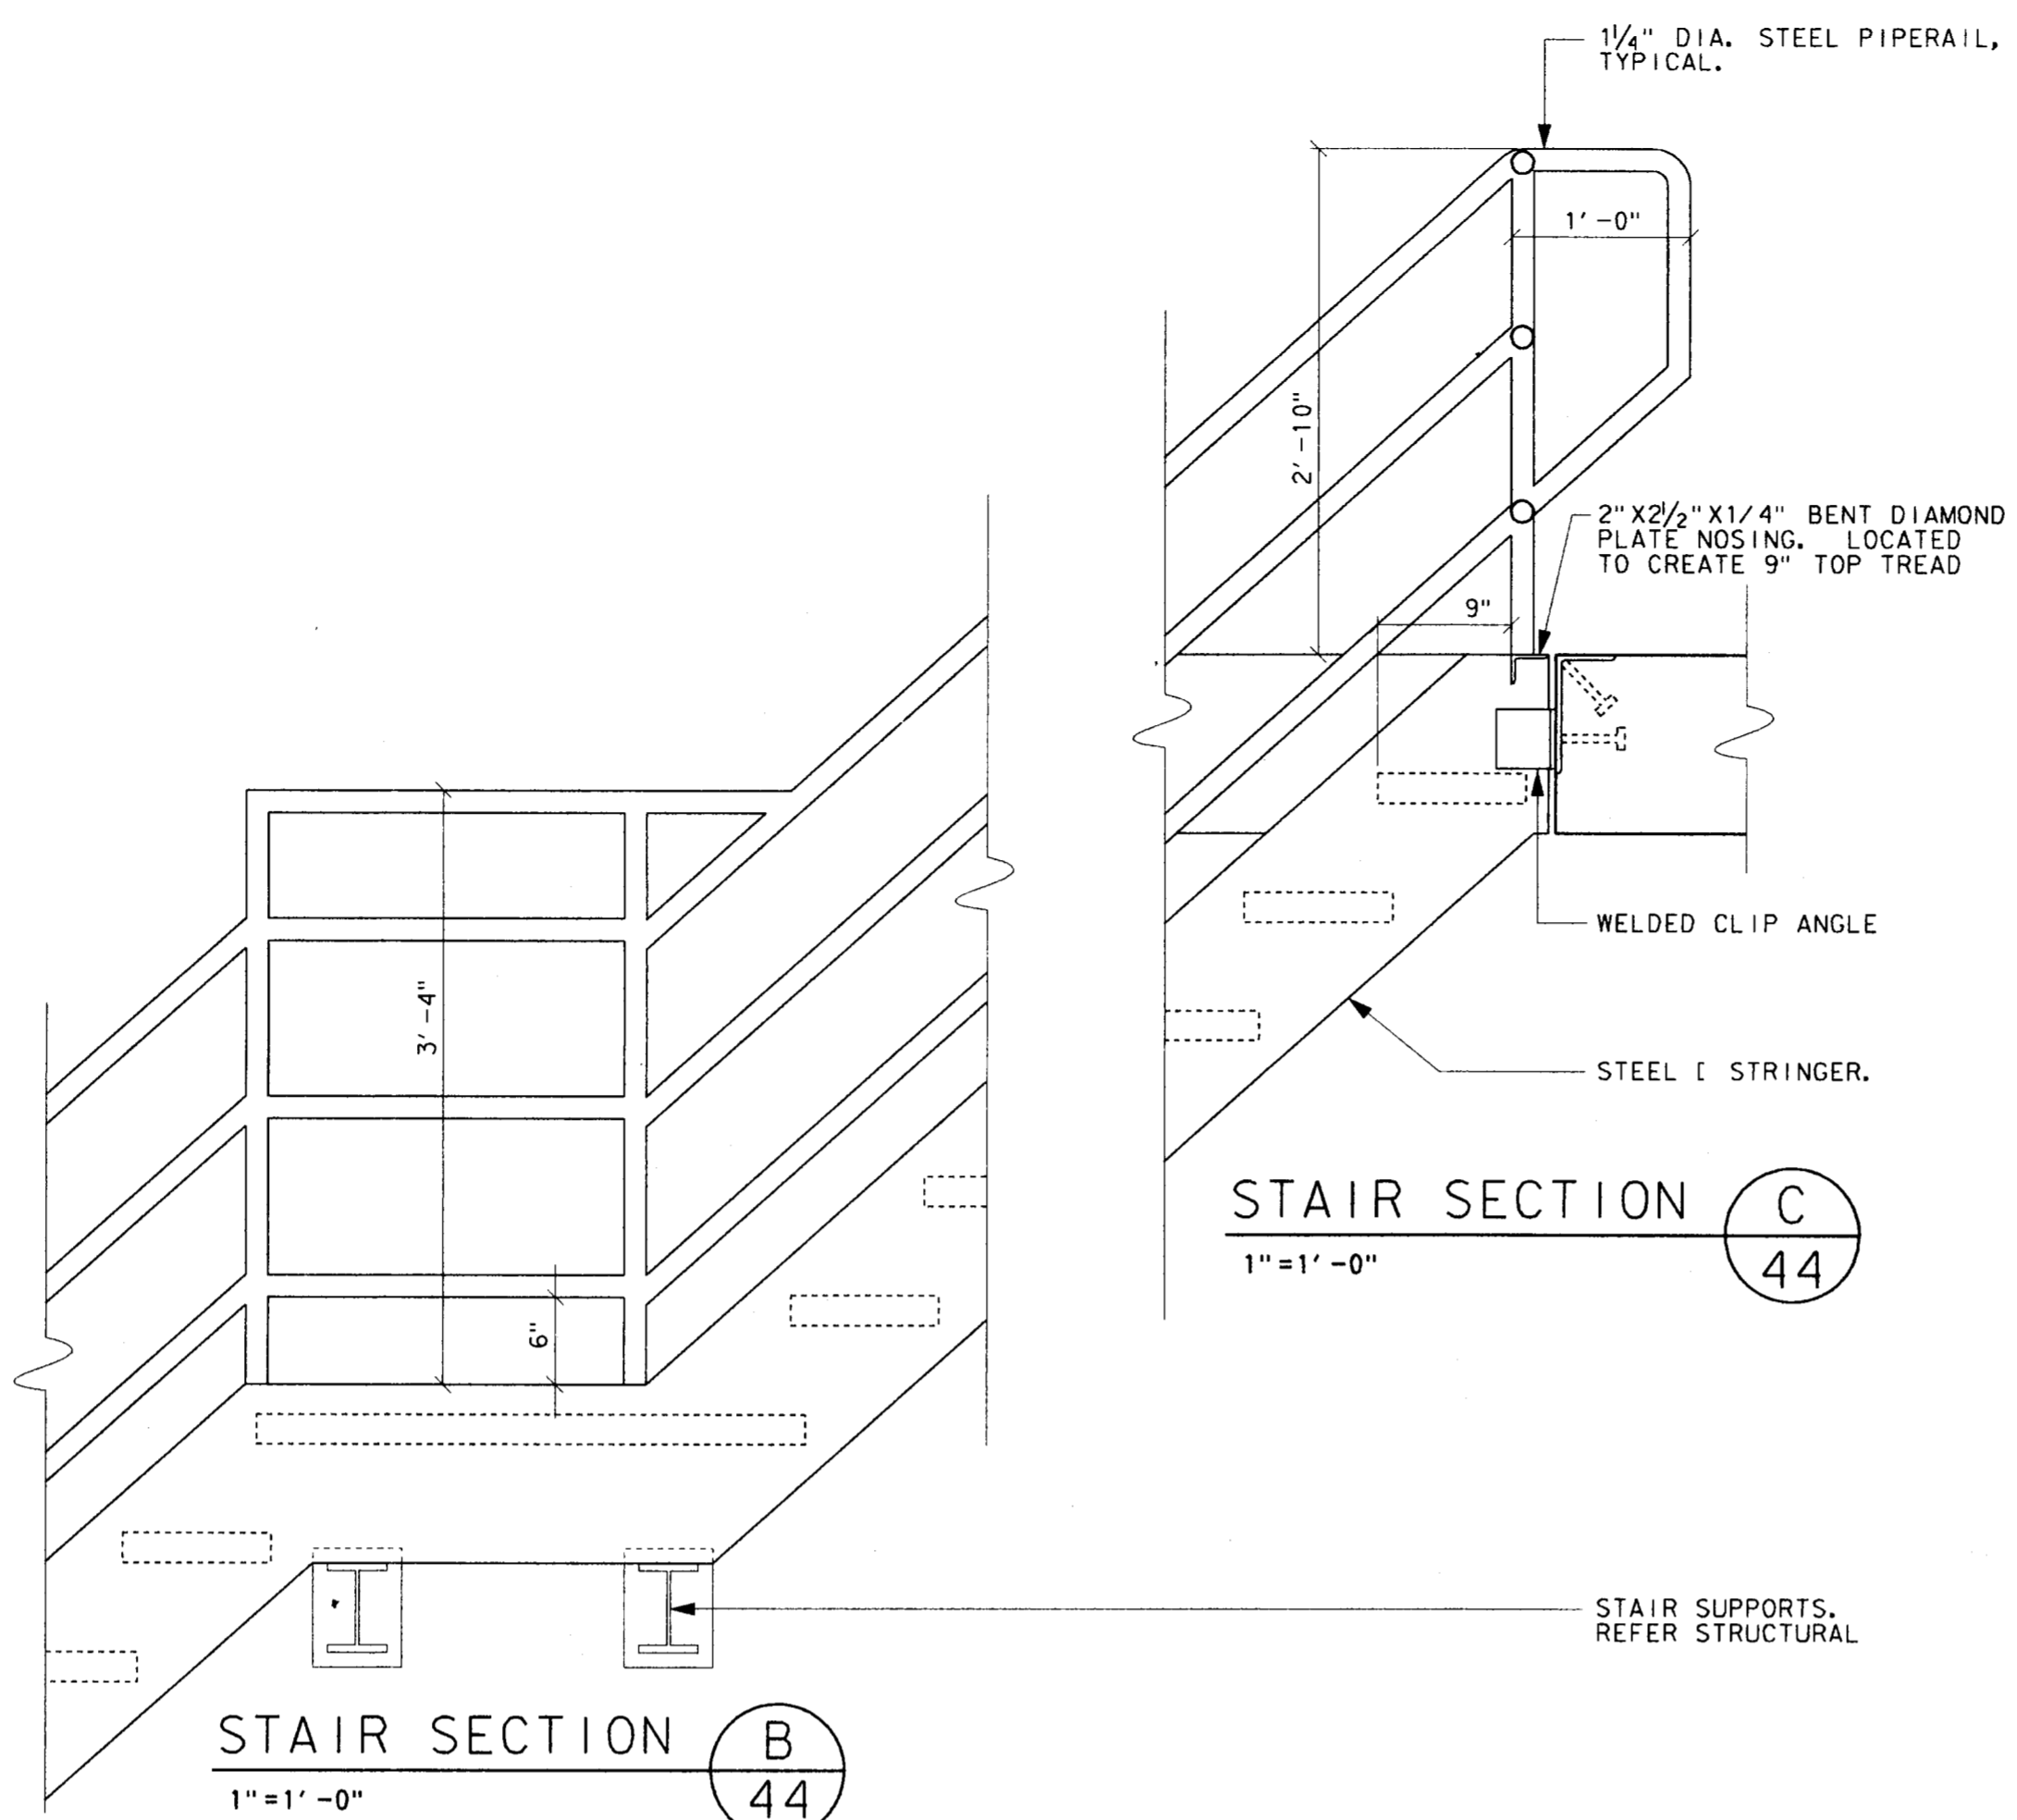


STAIR SECTION
 1"=1'-0"
 C
 44


STAIR SECTION
 1"=1'-0"
 B
 44

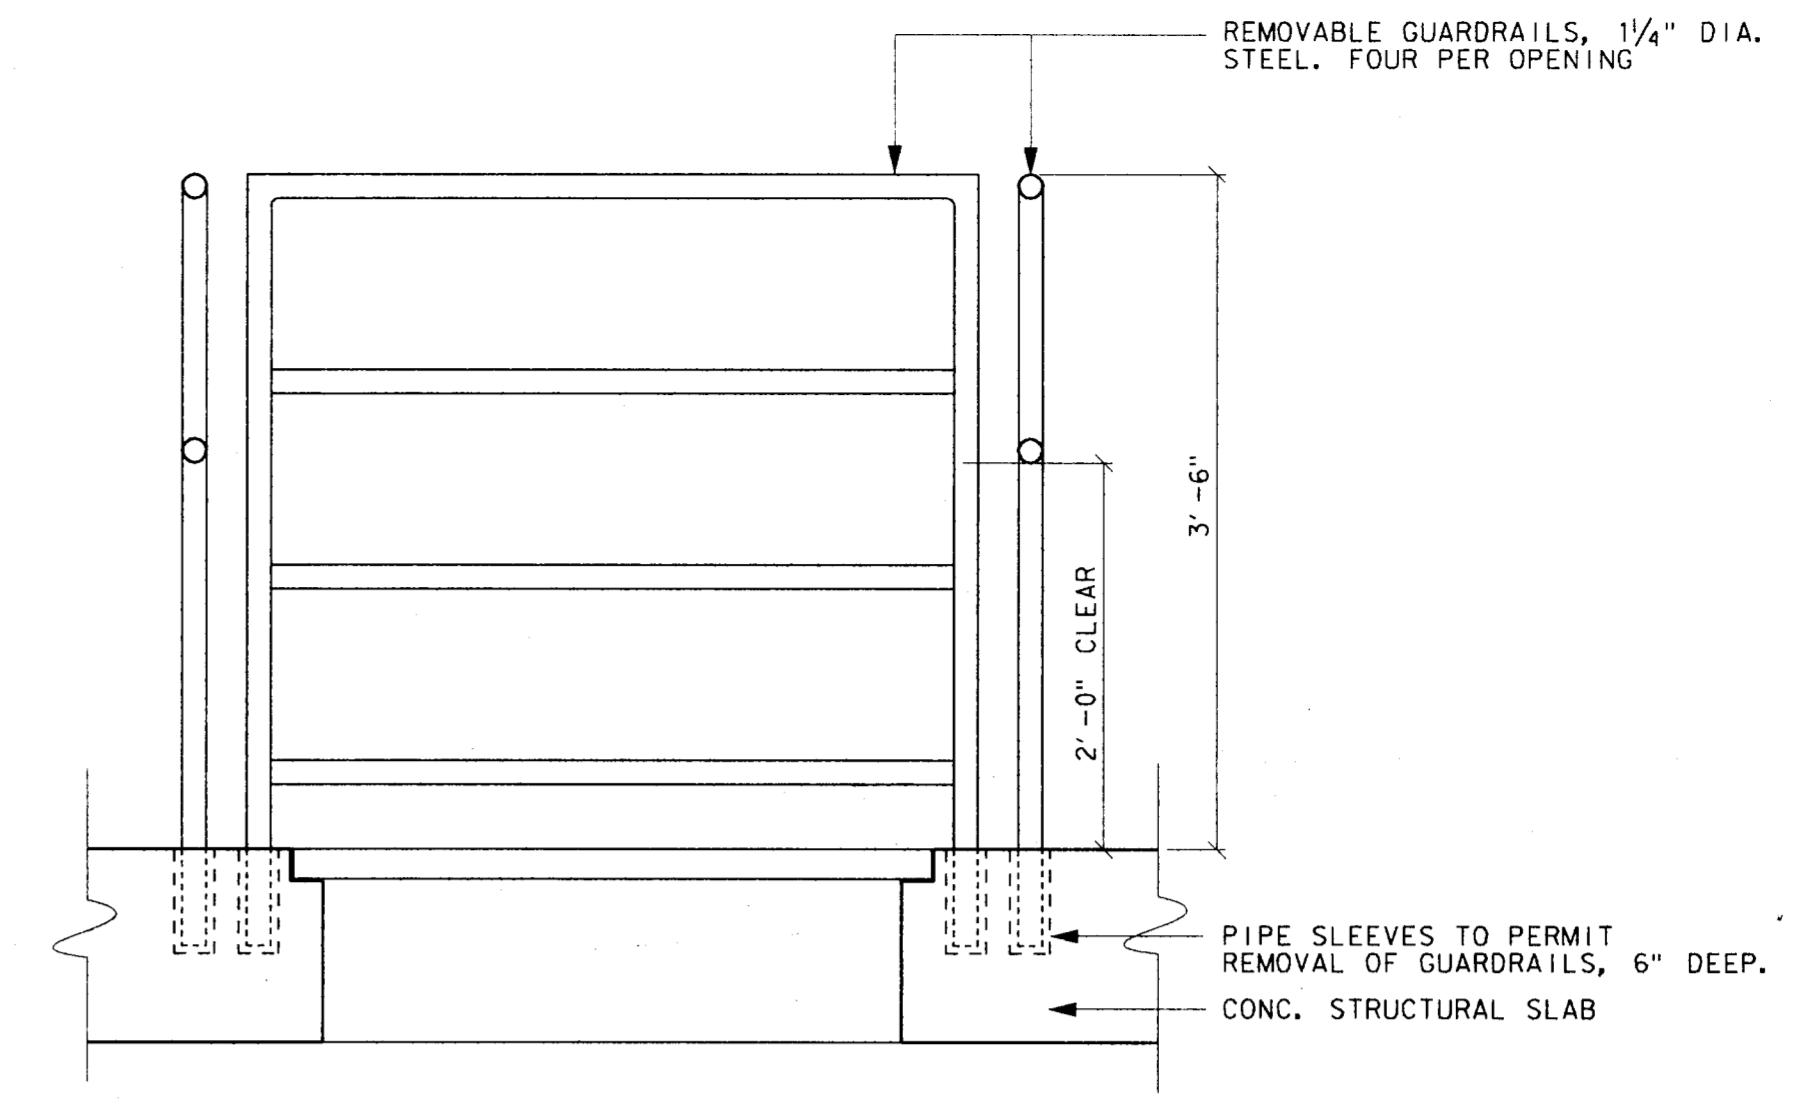


GUARDRAIL AT ACCESS HOLE
 1"=1'-0"
 D
 44

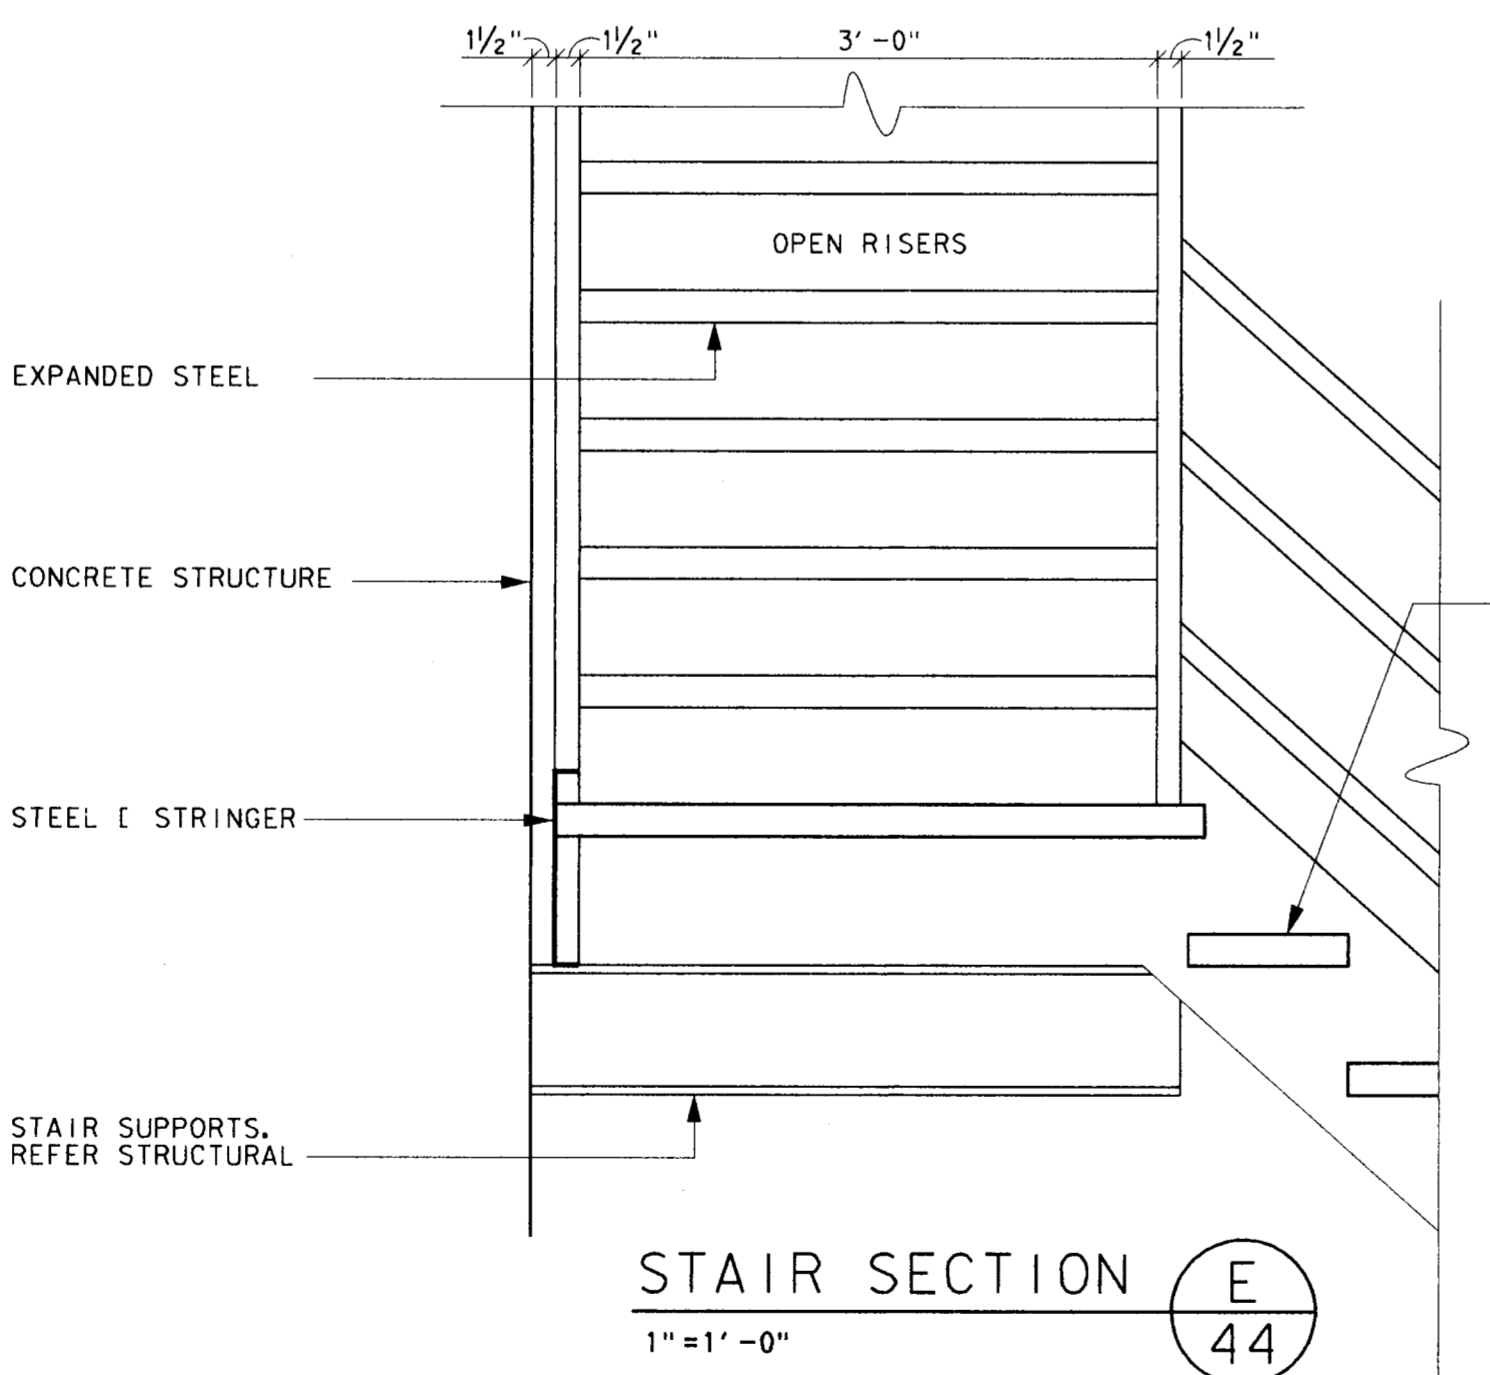

STAIR SECTION
 1"=1'-0"
 E
 44

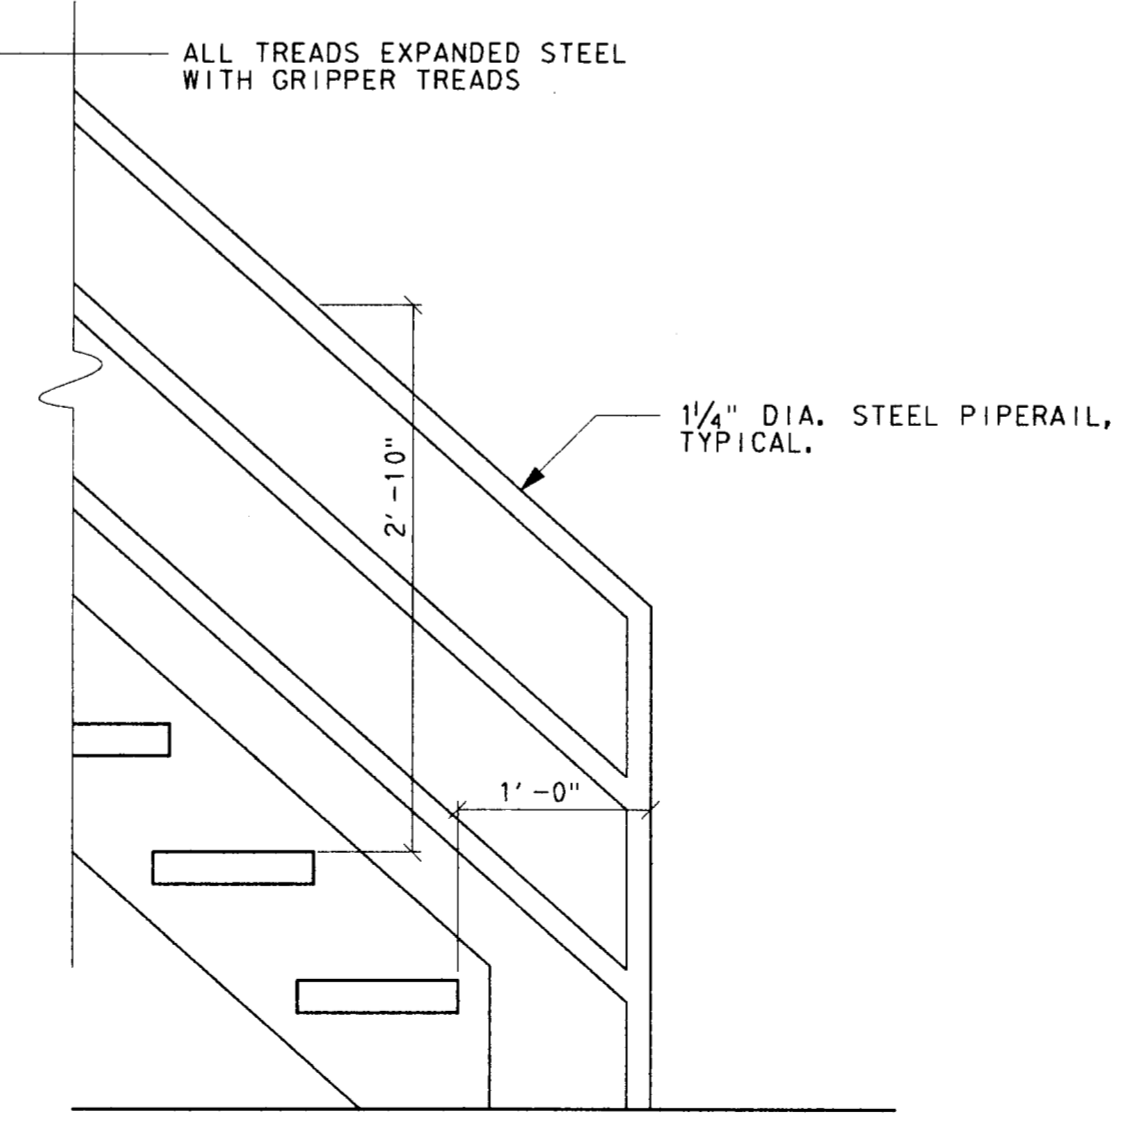

STAIR SECTION
 1"=1'-0"
 G
 44

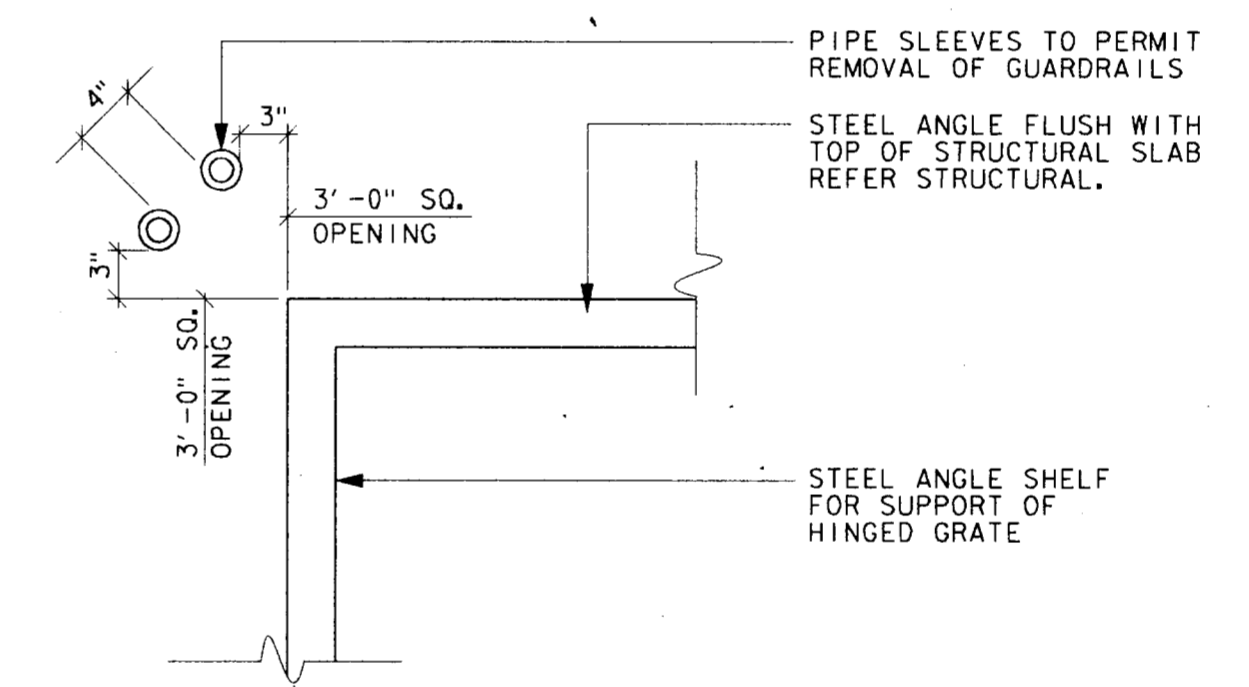


PLAN DETAIL AT ACCESS HOLE
 1"=1'-0"
 F
 44

4			
3			
2			
1	9-4-98	AS BUILT DRAWING	J. H. L.
NO.	DATE	REVISION	APPROV.

TOWN OF ADDISON, TEXAS
 MIDWAY/BELTLINE SANITARY SEWER
 PHASE II
 LIFT STATION -
 ARCHITECTURAL DETAILS - SHEET 2

Carter Burgess
 Consultants in Engineering, Architecture,
 Planning and the Environment
 CARTER & BURGESS, INC.
 7950 ELMSTOCK DRIVE, SUITE 250
 DALLAS, TX 75247-4561

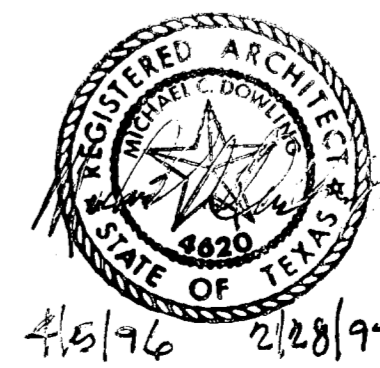

Unit	Scale	Date	04-05-96
Designed	R. WRIGHT	Checked	R. WRIGHT
Drawn	R. WRIGHT	Approved	J. Lindner
Job No.	93327601D	Sheet	44 of 63