

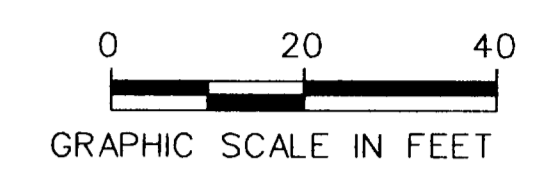



REVISIONS
 1. DATE: 9/4/98
 2. DATE: 9/4/98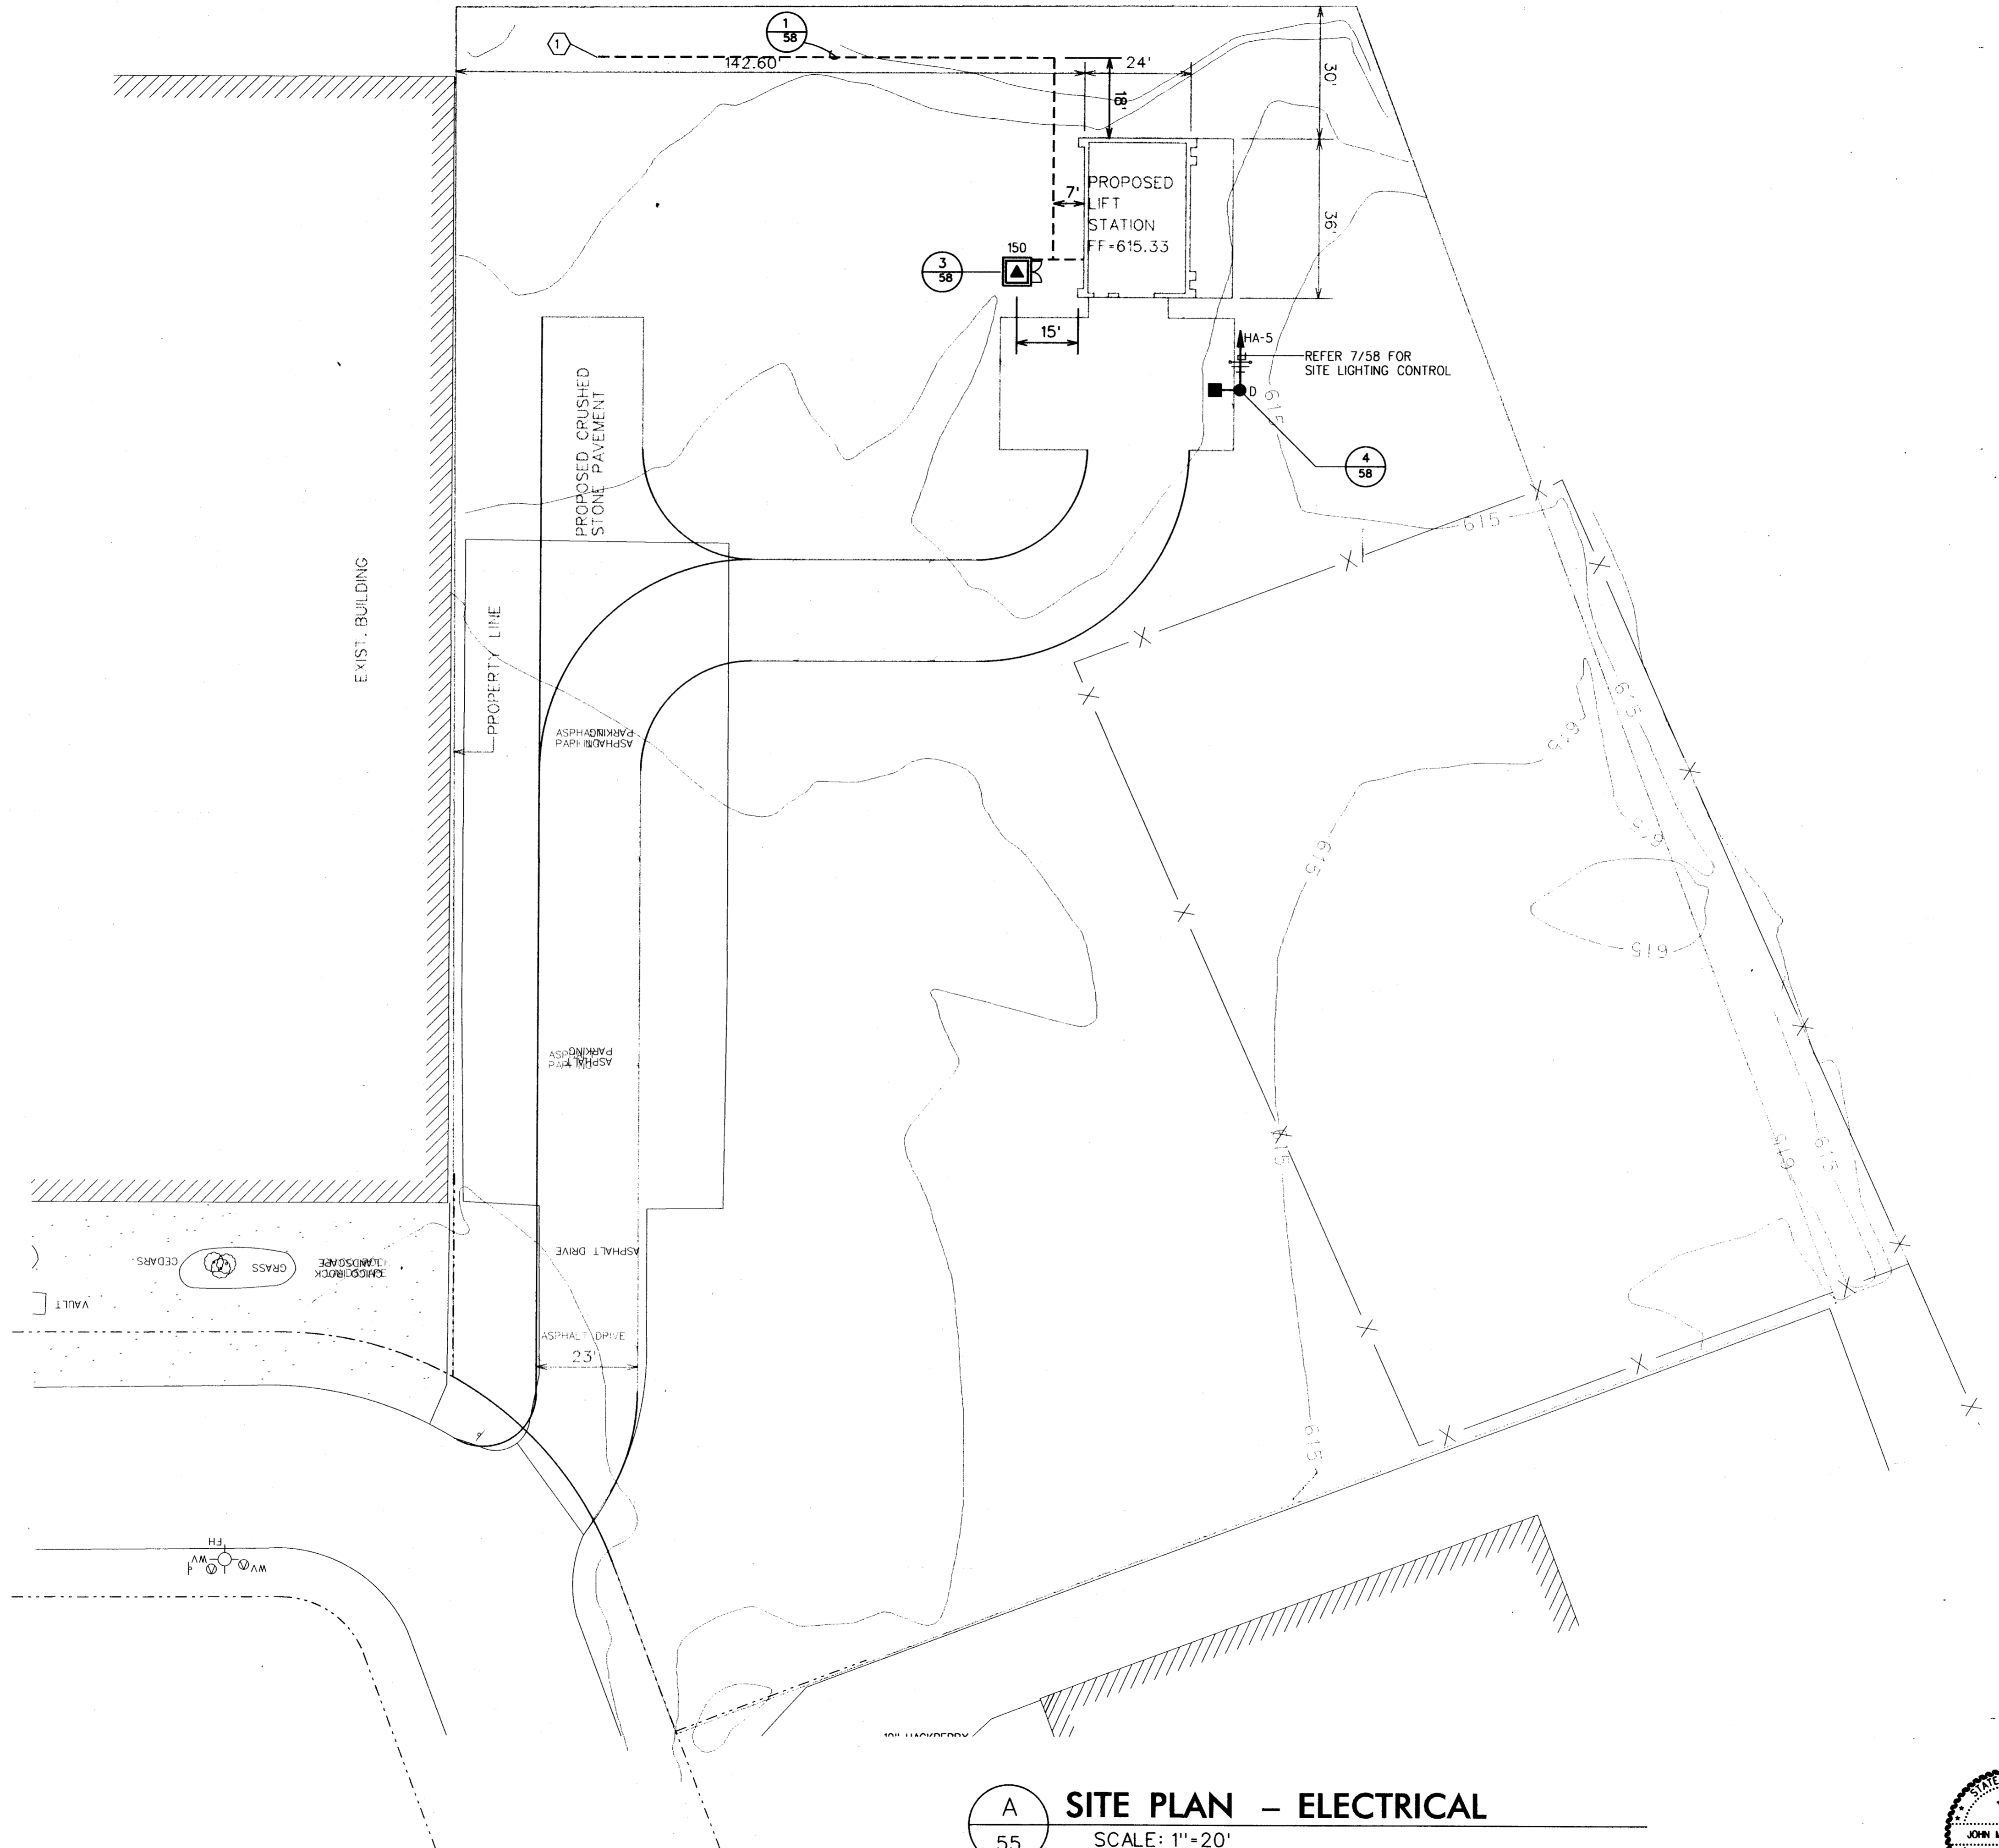
GENERAL NOTES
 1. VERIFY LOCATION OF TU ELECTRIC PRIMARY DIP POLE PRIOR TO INSTALLATION OF UNDERGROUND PRIMARY DUCT BANK. TWO 4" C (ONE ACTIVE, ONE SPARE). TU REPRESENTATIVE - JOEL PORTER (214) 888-1313

A SITE PLAN - ELECTRICAL
 55 SCALE: 1"=20'

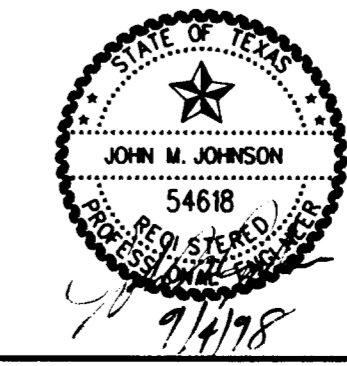

4			
3			
2			
1	9/4/98	AS BUILT DRAWINGS	
NO.	DATE	REVISION	APPROV.
TOWN OF ADDISON, TEXAS			
MIDWAY/BELTLINE SANITARY SEWER PHASE II			
LIFT STATION ELECTRICAL SITE PLAN			
 Carter & Burgess CONSULTANTS IN ENGINEERING, ARCHITECTURE, PLANNING AND THE ENVIRONMENT CARTER & BURGESS, INC. 7950 ELMBROOK DRIVE, SUITE 250 DALLAS, TX 75247-4961			
Unit	Scale: Horiz. 1"=20'	Date	04-05-96
Designed	Checked	Job No.	9332760ID
Drawn	J. WEBB	Approved	J. Lindner
		Sheet	55 of 63