


CURVE DATA
 $\Delta = 11^\circ 44' 20''$
 $R = 954.93'$
 $T = 98.17'$
 $L = 195.65'$

Record Drawing 4/9/85

B.M. #1 On N.W. Corner Parking To Gulf Gas Station at S.W. Corner Inter. Belt Line & Midway Rd. Elev. 624.32
 B.M. #2 On S.E. Corner Of Conc. Walk To Bldg. At 15101 Midway Rd. Elev. 614.84

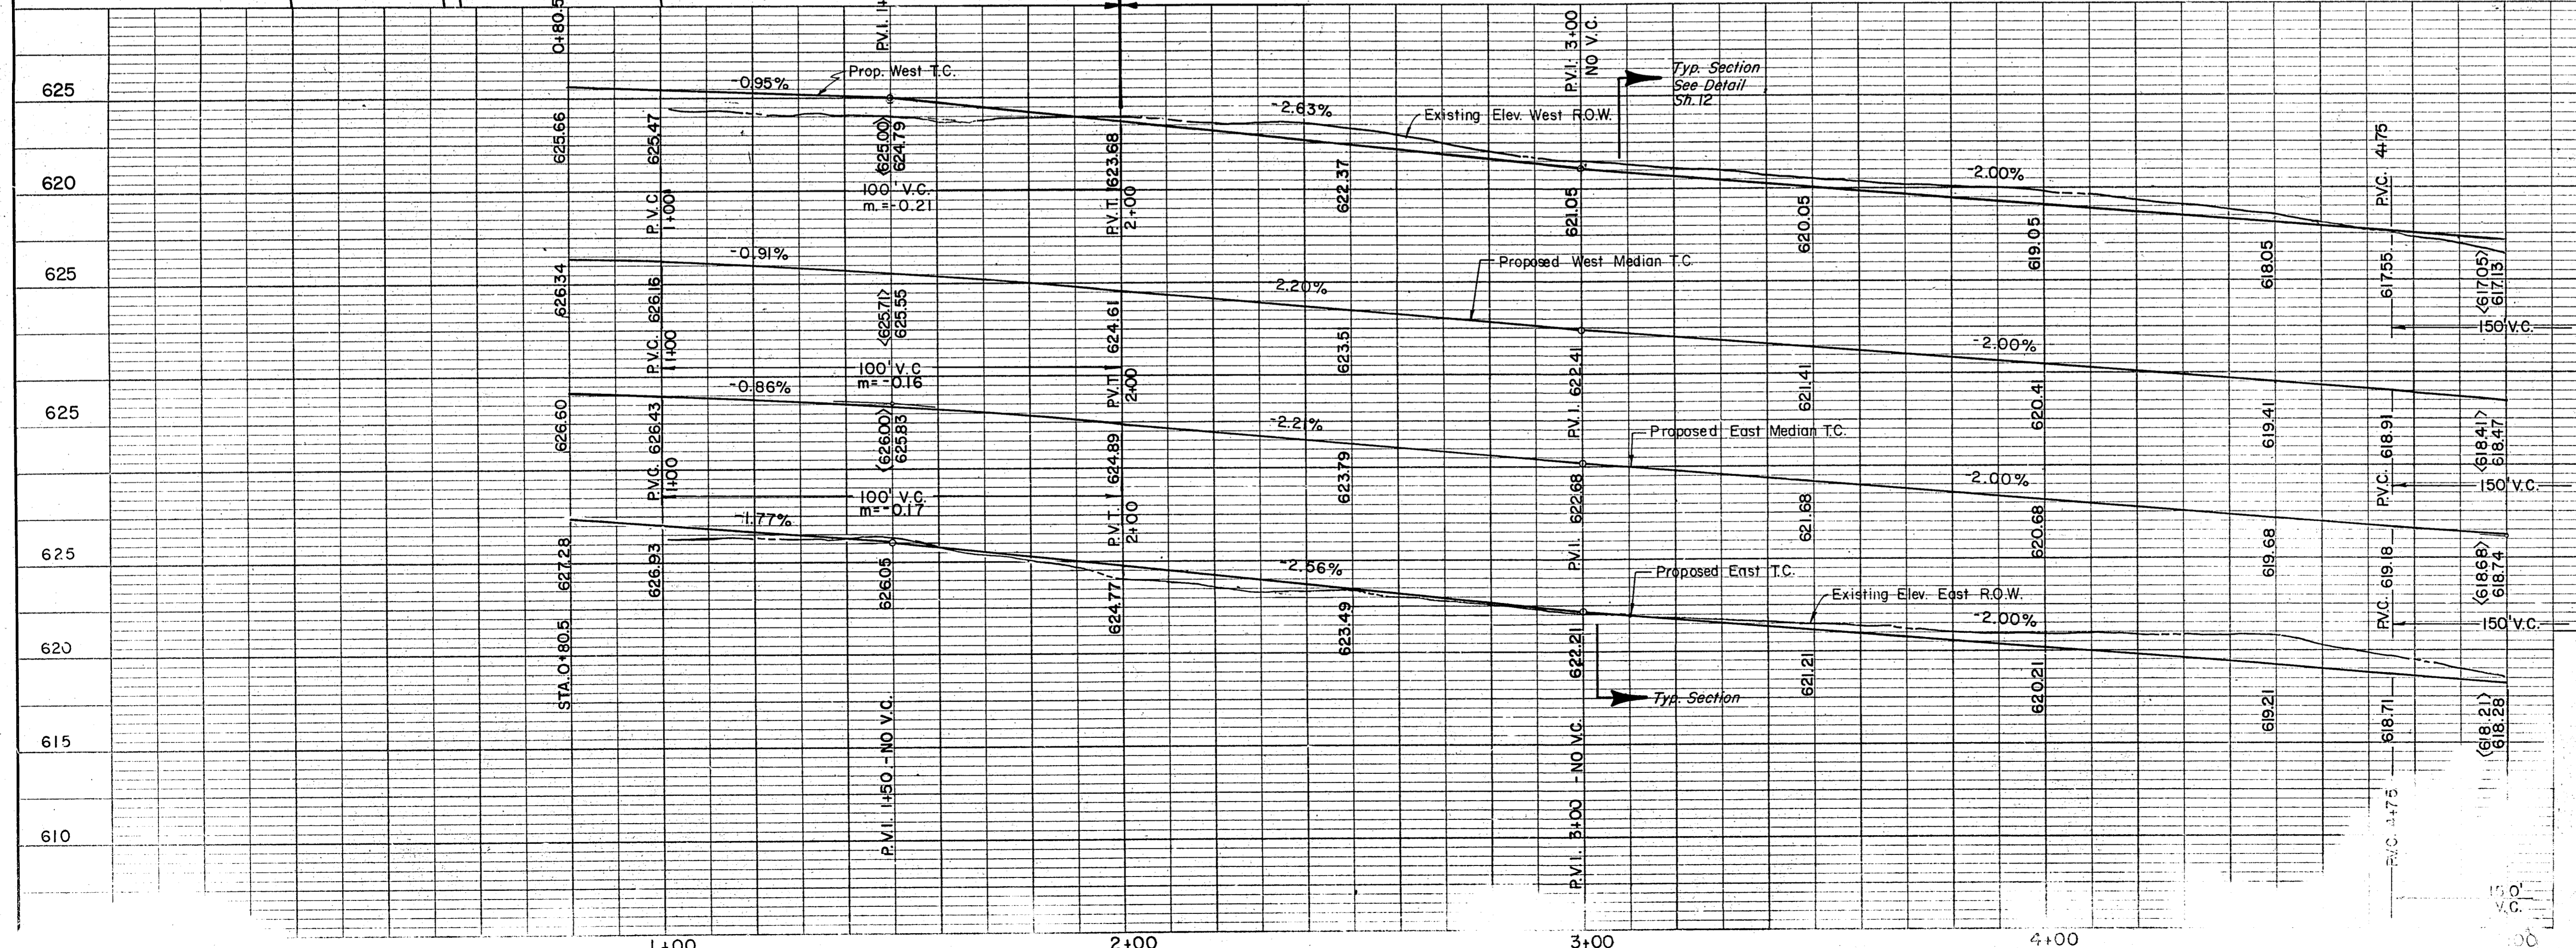

MOVED DRIVE OF...
 DELETED 2 RECESSED INLET

CITY

Paving Co.
MIDWAY

GINN, INC., Con.
 DESIGNED - H.B.J. DRAWN -
 APPROVED - H.W.G. CHECKED -