


ESTIMATED QUANTITIES			
ITEM	DESCRIPTION	UNIT	QUANTITY
100.	Prepare Roadway R.O.W	Sta.	5
104.1	Remove Old Concrete, Pavement & Median	SY	59
104.2	Sawed Break-Out Groove	LF	3762
110	Unclassified Road Excavation(Dans Cont.)	CY	3762
160	Placing 4" Topsoil	CY	
248	6" Flex Base (Dens Cont) (Ty A, Gr 2, Cl 3)	CY	
260.1	Lime (Ty A) Slurry Method	Ton	44.11
260.2	6" Lime Treated Subgrade (Dens Cont)	SY	3528.89
340.1	3" Hot Mix Asphalt (Ty D) Resurf Shoulder	Ton	69.67
340.2	6" Hot Mix Asphalt (Ty B)	Ton	607.02
360.1	8" Conc Pavement (3000 PSI)	SY	5254.82
360.2	6" Conc Monolithic Curb(3000 PSI)	LF	1556
360.3	4" Non-Reinf Conc In Median(2000PSI)	SY	140
360.4	Conc. St. Header	LF	78
479.1	Adjust Water Valves	EA	7
522	Conc Curb & Gutter Class A	LF	
524	Conc Driveways, Appr 5" Reinf Conc(3000PSI)	SY	192.5
630.1	Foundation (Ty A) Traffic Sig In Place	EA	4
630.2	Foundation (Ty B) Traffic Sig In Place	EA	
630.3	Foundation (Ty C) Traffic Sig In Place	EA	4
630.4	Foundation (Ty D) Illumination	EA	2
640.1	1/2" PVC Conduit, Furnish & Install	LF	500
640.2	2" PVC Conduit, Furnish & Install	LF	433
640.3	3" PVC Conduit, Furnish & Install	LF	475
640.4	Pull Box, Complete In Place	EA	8
752.1	Traffic Buttons-Single Refl Ty P15 White	EA	40
752.2	Traffic Buttons-Single Refl Ty P19-White	EA	38
754.1	Traffic Buttons-Nonrefl, Ty P7 White	EA	200

- LEGEND**
- Bench Mark
  - Iron Pin
  - Monument
  - Gas Meter
  - Gas Valve
  - Gas Line
  - Power Pole (Typical Pole Symbol)
  - Flow Line
  - Guy Wire Anchor
  - Telephone Line
  - Water Meter
  - Water Valve
  - Water Line
  - Fire Hydrant
  - Manhole
  - Sanitary Sewer Line
  - Fence Line
  - Flow Direction Indicator
  - Property or Right-of-Way Line(ROW)
  - Easement Line
  - Traffic Pull Box
  - Block Area Pole Foundation (Type A or B)
  - Precast Pole Foundation (Type C)
  - Signal Illumination Pole Foundation (Type D)
  - Top of Curb
  - Flow Line

B.M. "a" Top of Curb At N.W. Corner Of Parking Lot For Gulf Oil Station At S.W. Corner Int. Midway & Belt Line, ELEV = 624.32

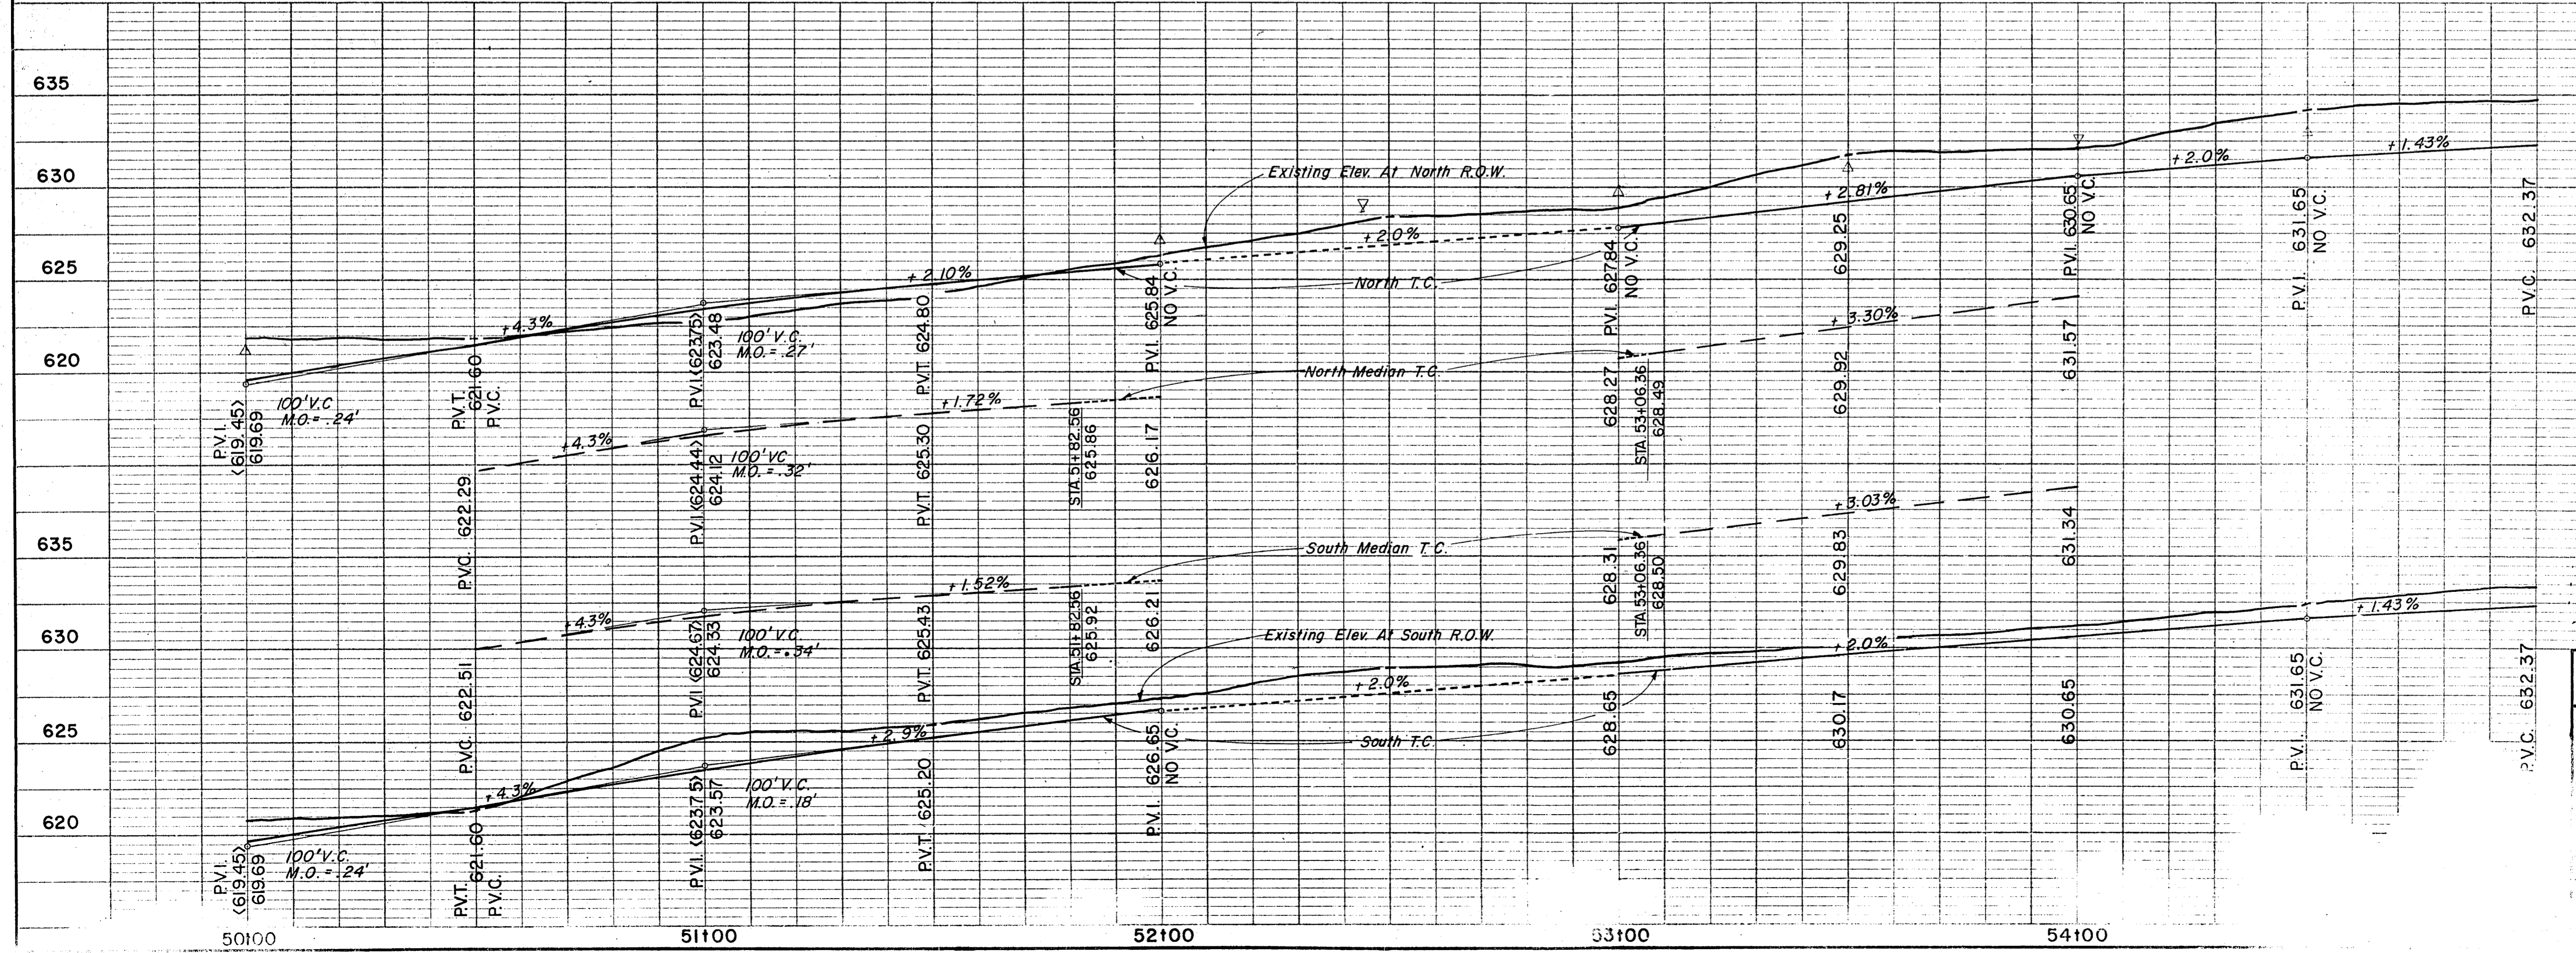

3 Add Drive -51+35  
 Moved drive 5' East  
 Add Drive +50+14, Chg G  
 No Previous

**CITY OF**  
**COUNTY OF**  
 DEF  
 PAV