
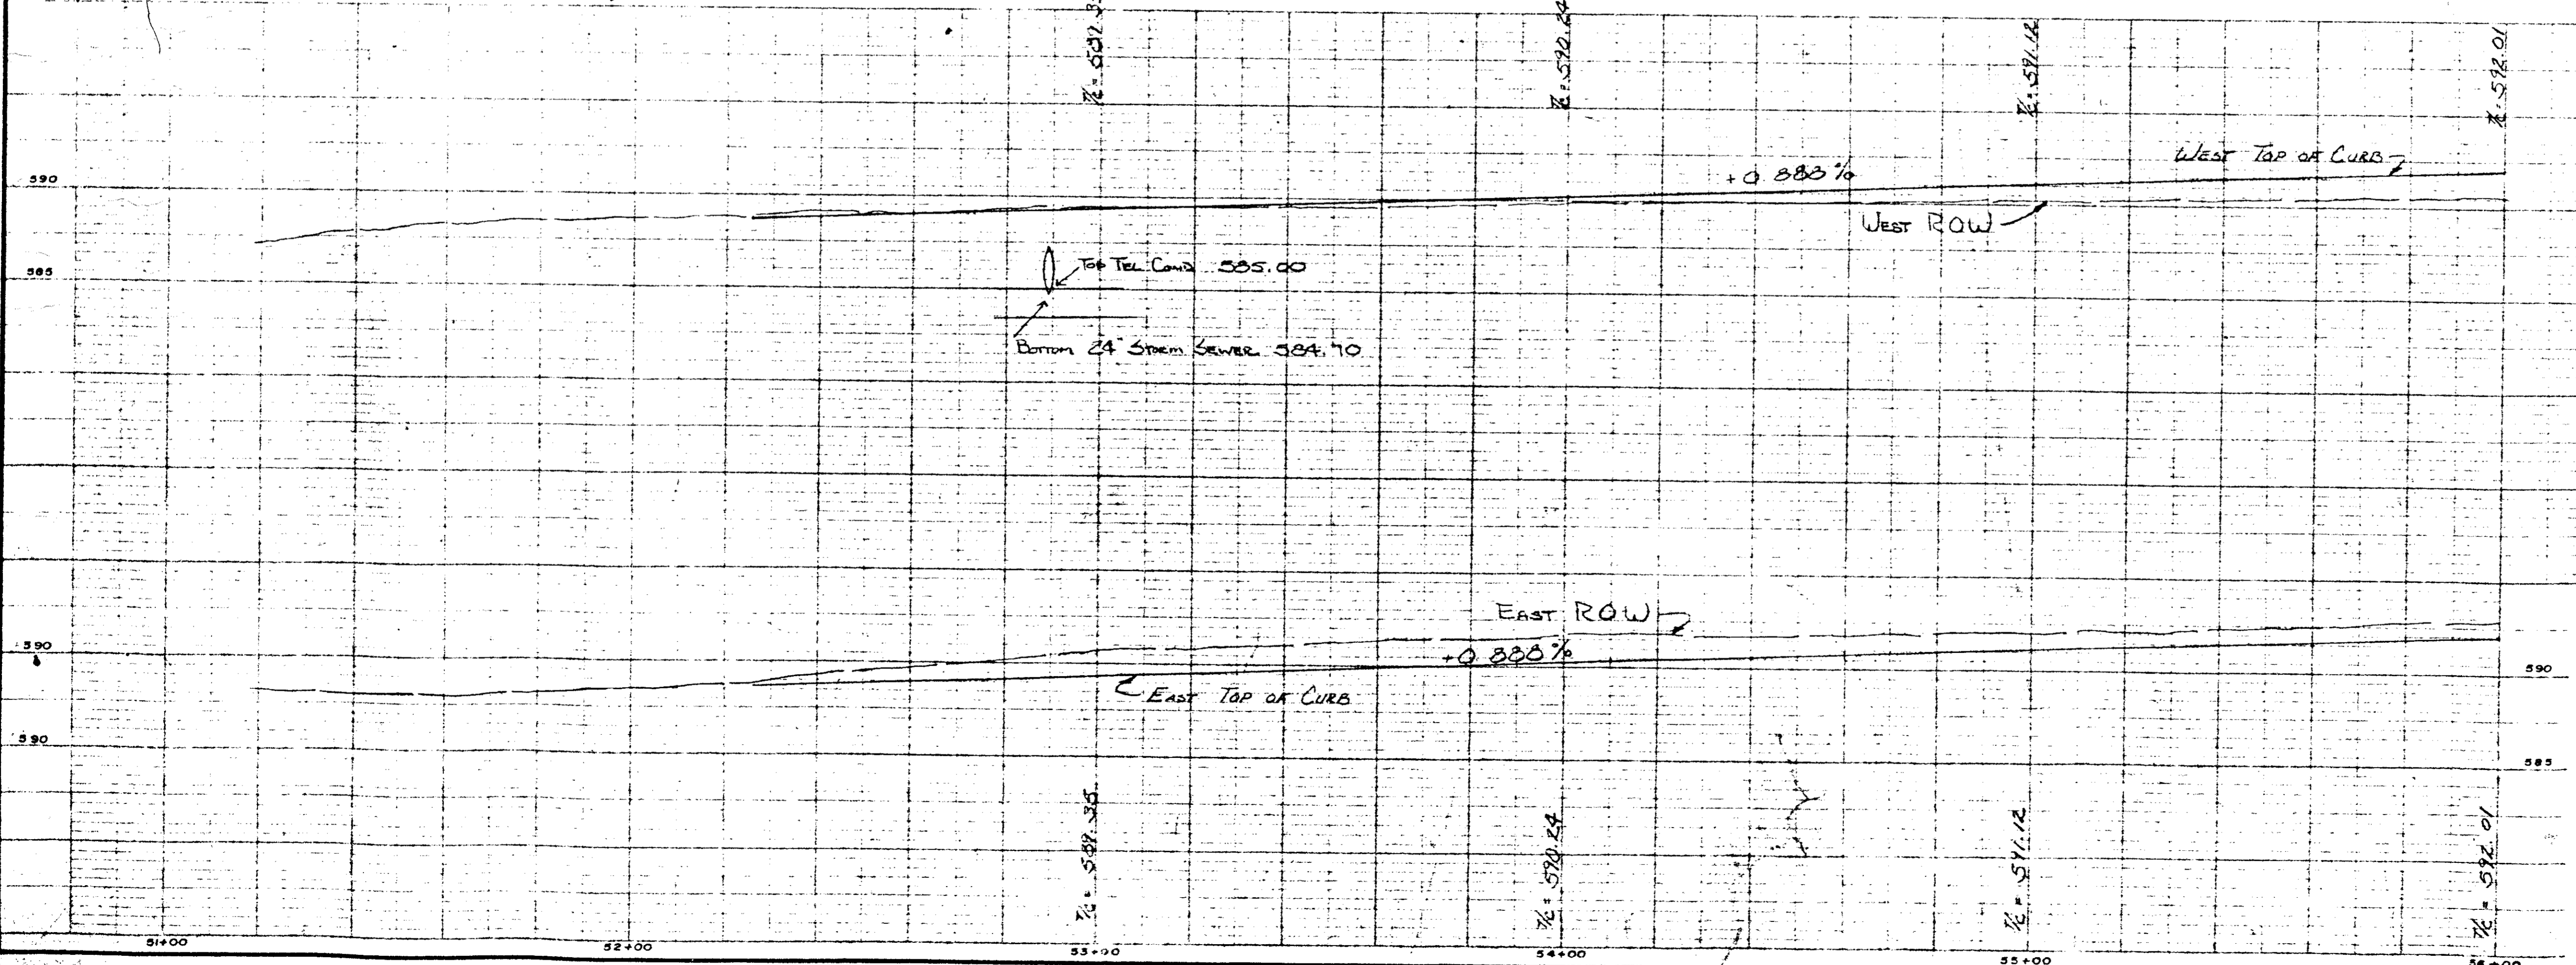


N

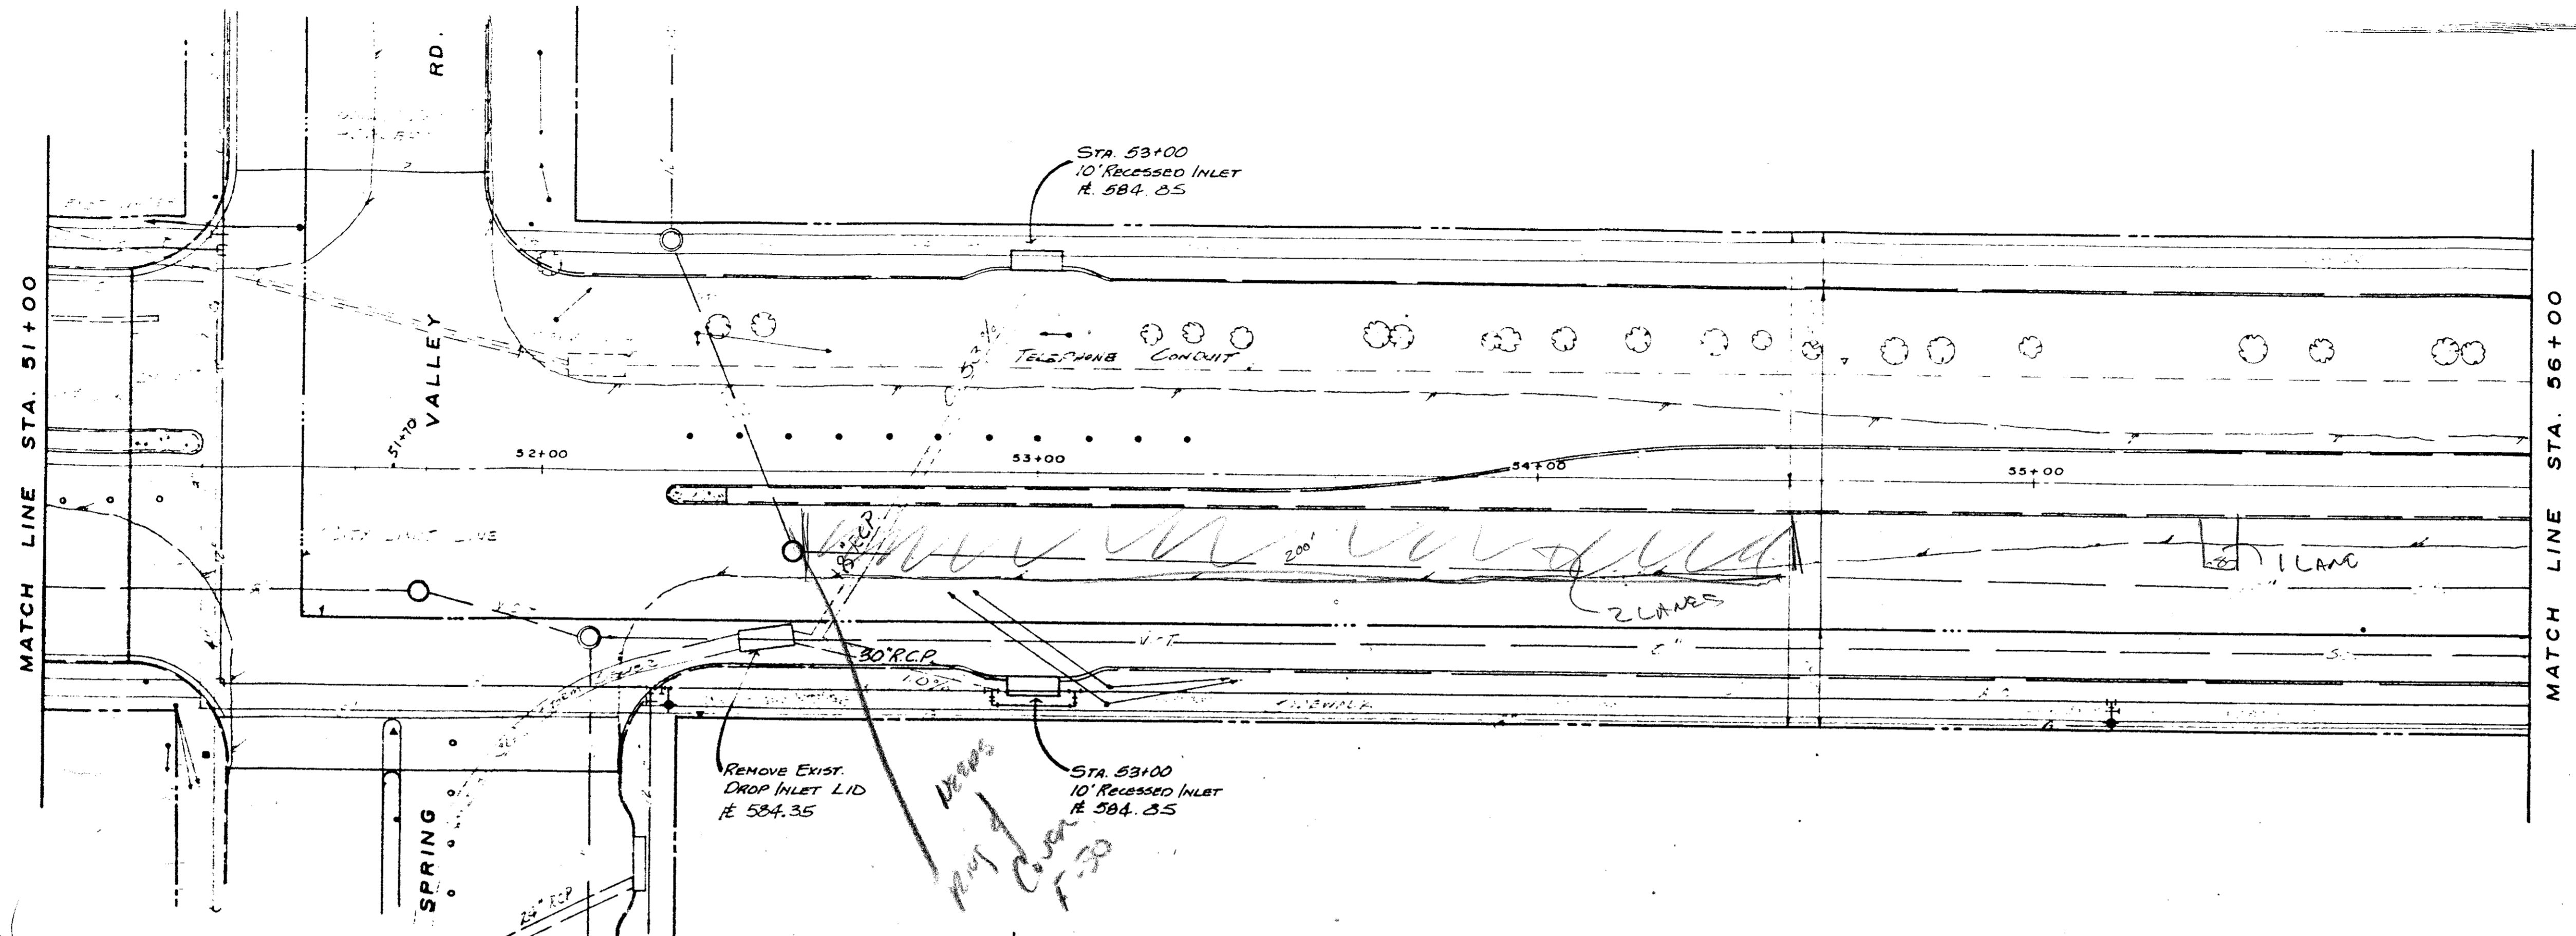

NO.	REVISION	BY	DATE

CITY OF FARMERS BRANCH, TEXAS
 PUBLIC WORKS DEPARTMENT
 ENGINEERING DIVISION

MIDWAY ROAD PAVING
 SPRING VALLEY RD. TO BELT LINE RD.

DRAWN BY D. D. APPROVED BY T. P.
 DESIGNED BY J. P. DATE 3-78

PROJECT NO. SCALE: H. 1" = 20'
 V. 1" = 5' SHEET 3 OF 3

F 284 PD