
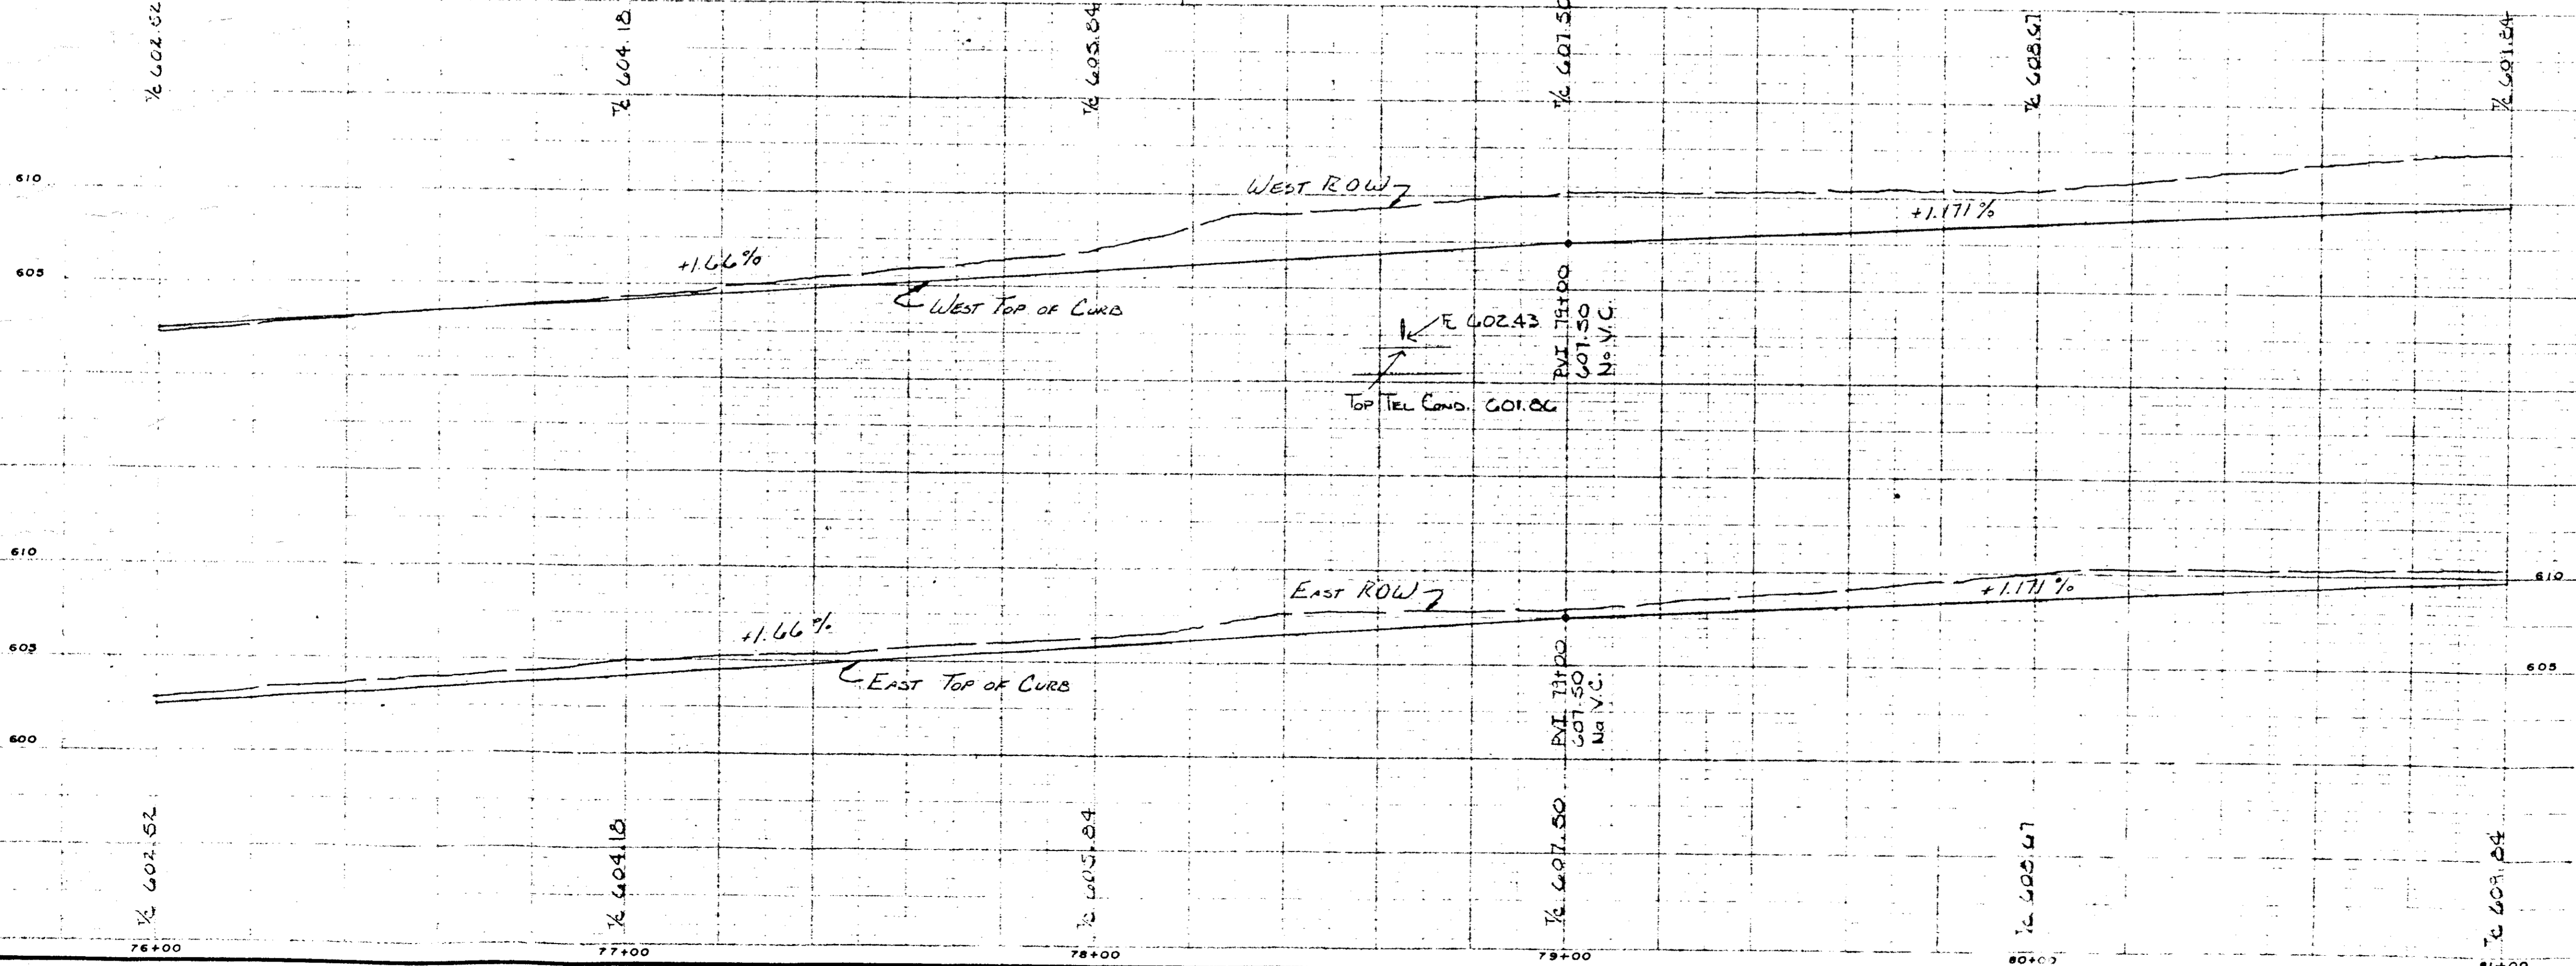


MATCH LINE STA. 76+00

MATCH LINE STA. 81+00

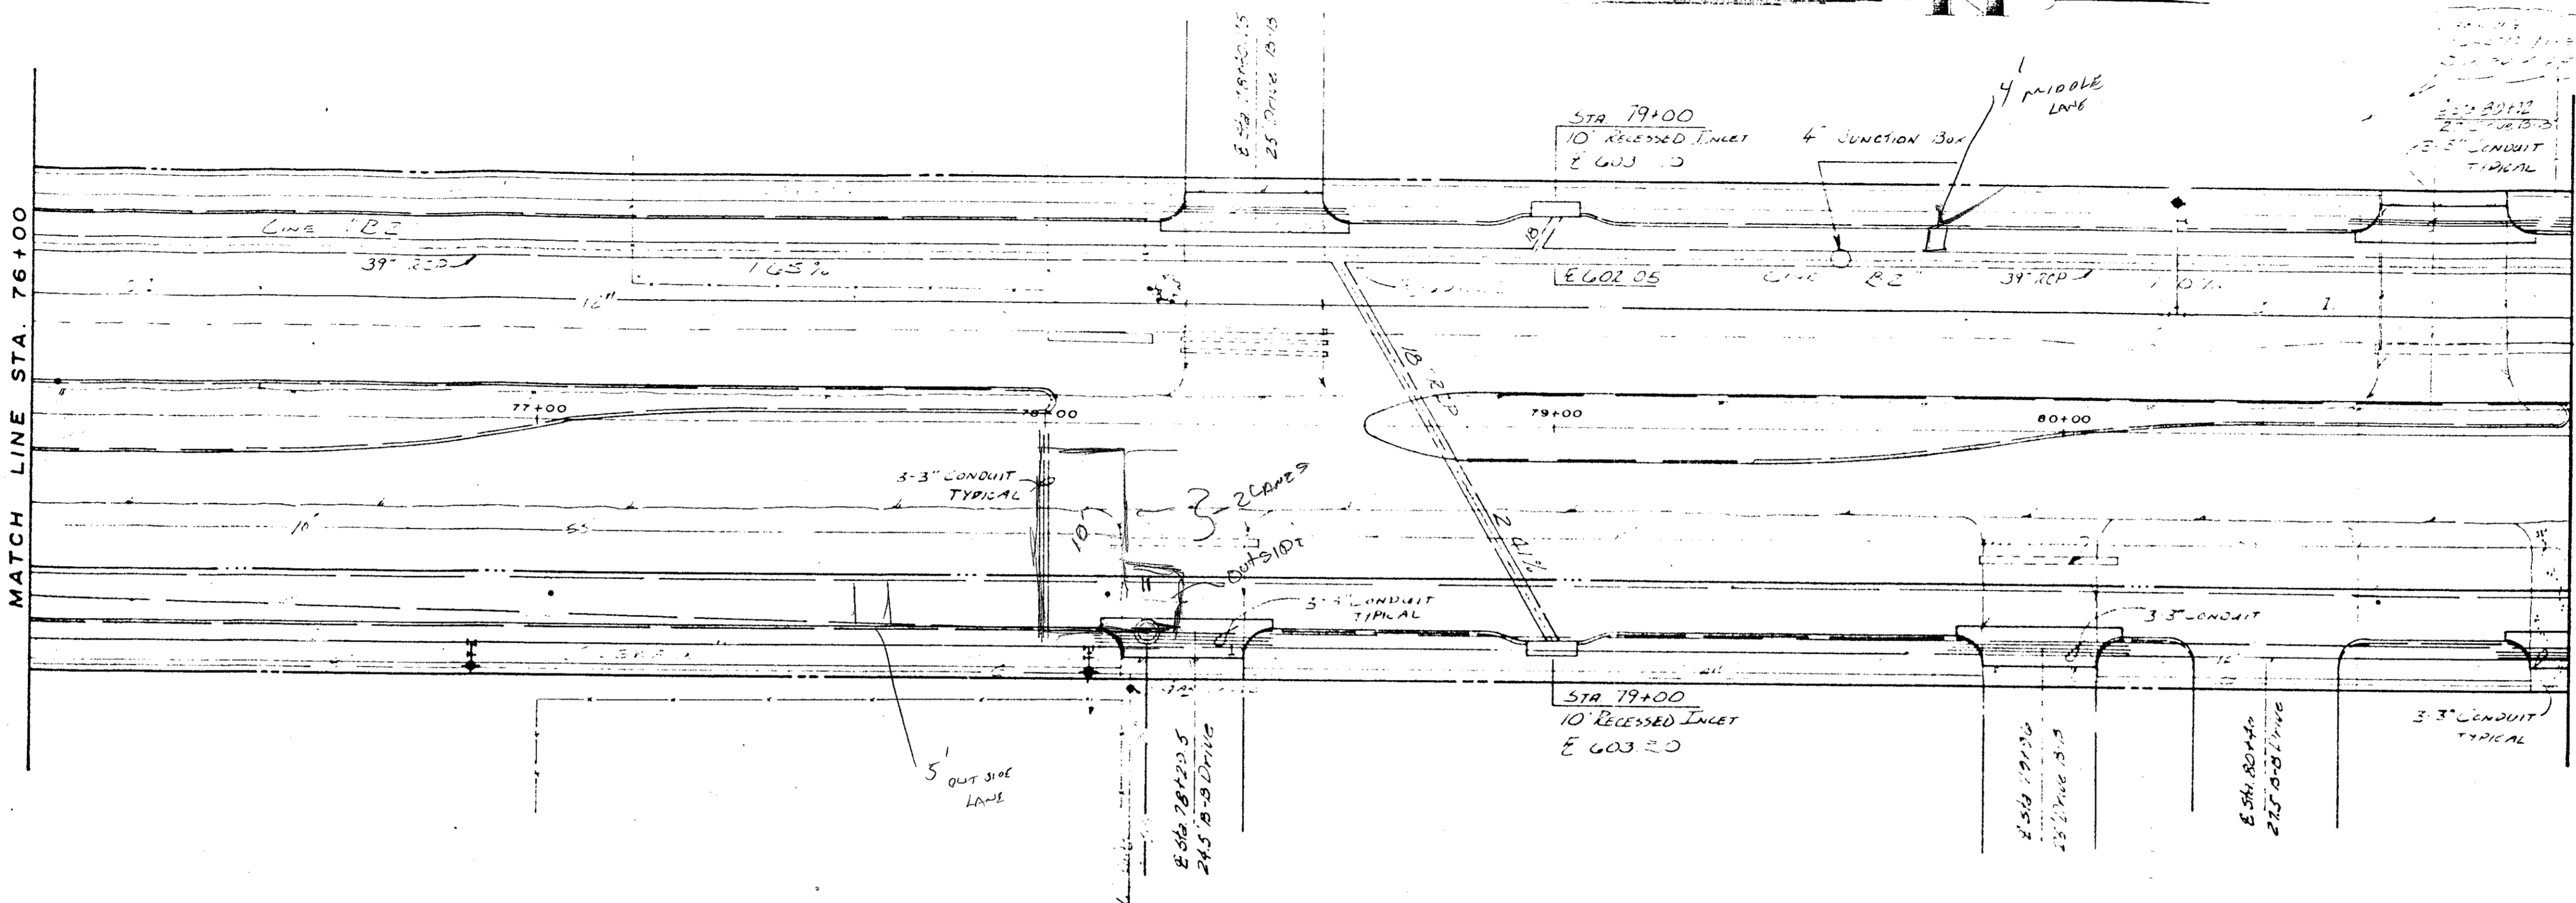

NO.	REVISION	BY	DATE
CITY OF FARMERS BRANCH, TEXAS PUBLIC WORKS DEPARTMENT ENGINEERING DIVISION			
MIDWAY ROAD PAVING SPRING VALLEY RD. TO BELT LINE RD.			
DRAWN BY D. D.		APPROVED BY	
DESIGNED BY J. P.		DATE 3-79	
PROJECT NO.	SCALE H. 1" = 20' V. 1" = 5'	SHEET 8 OF	