
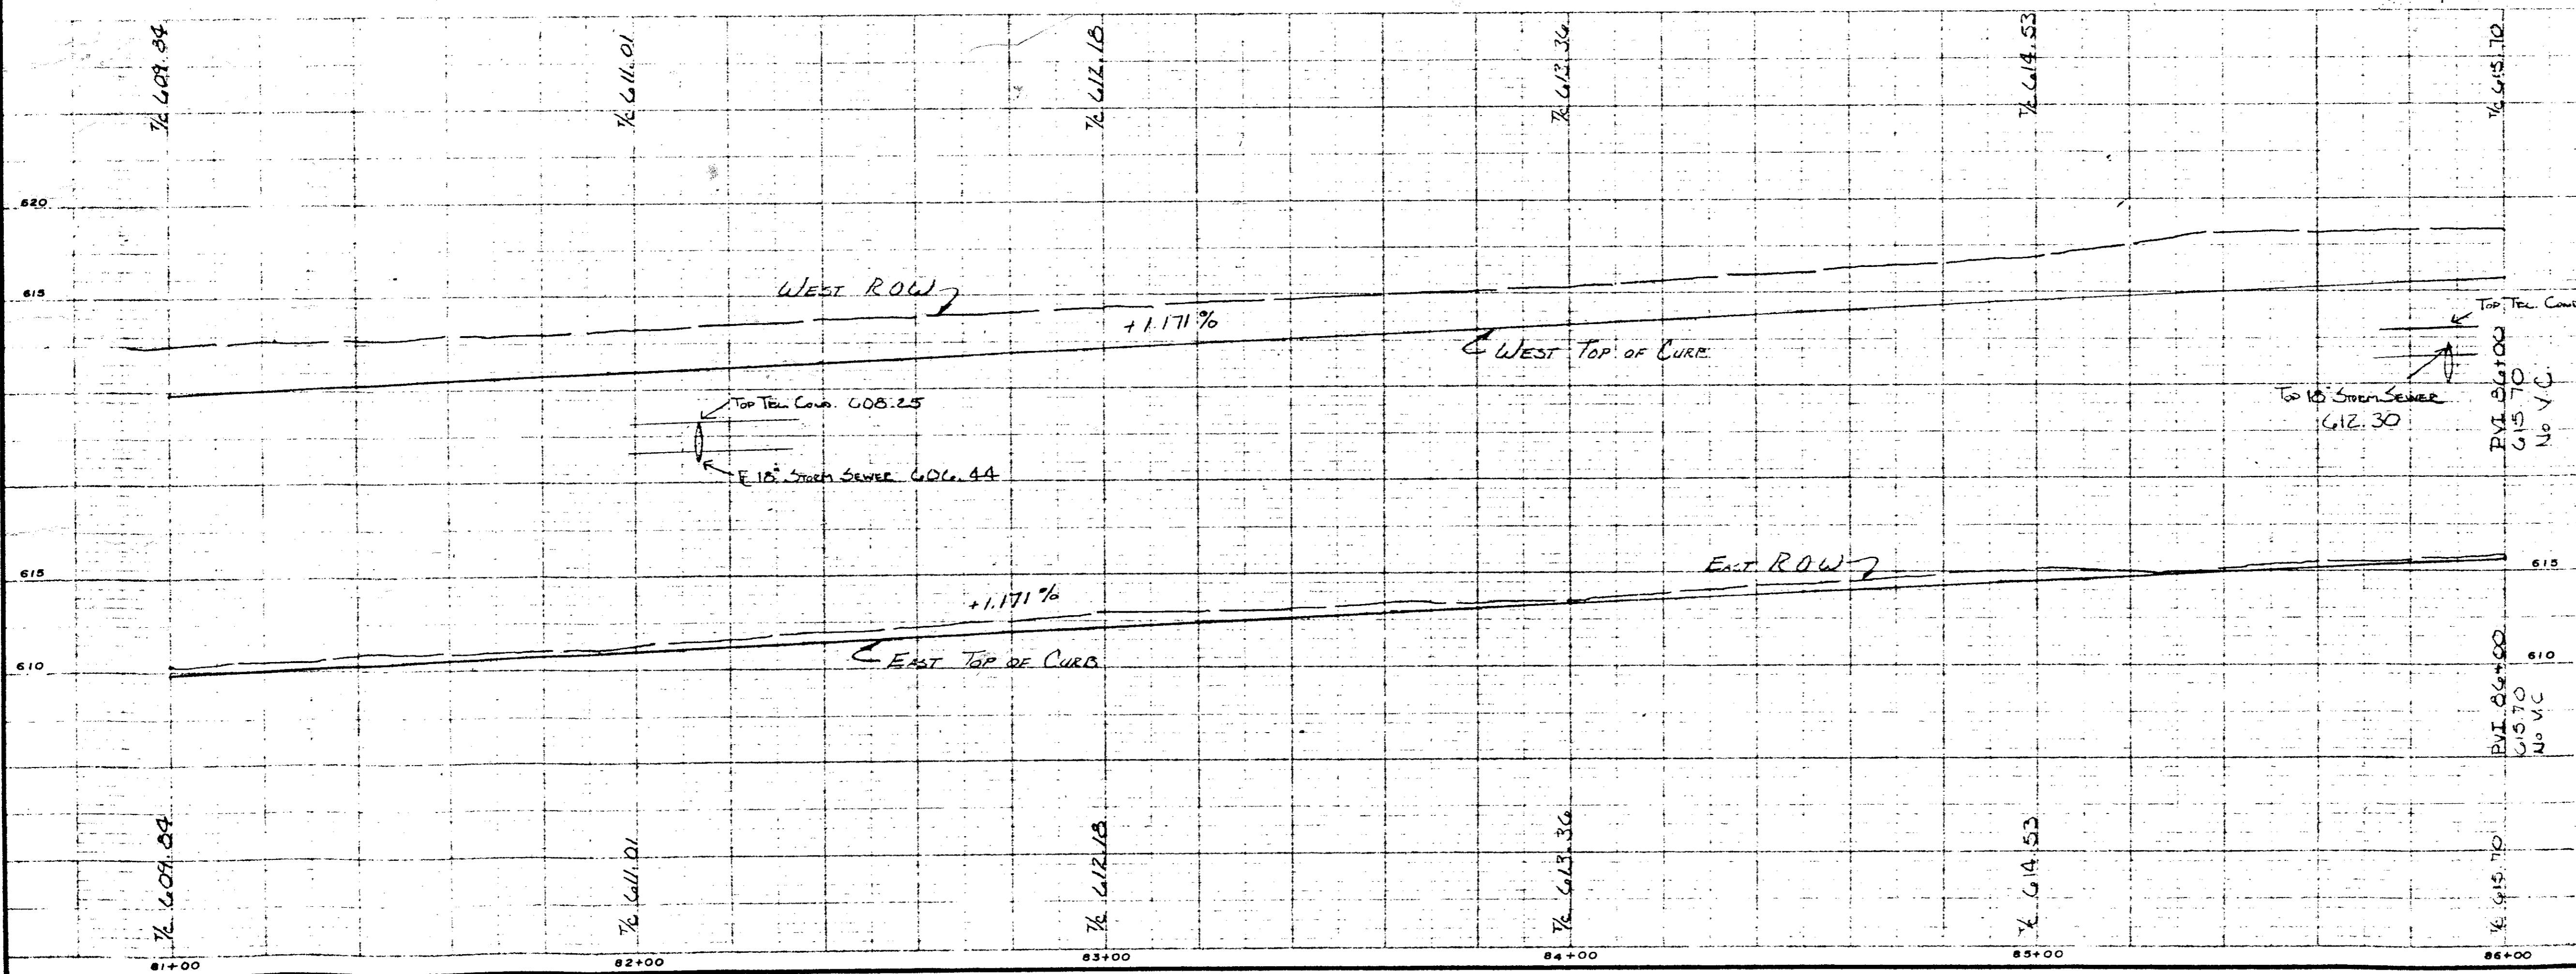


Check
for Ref'd Curve
total Project

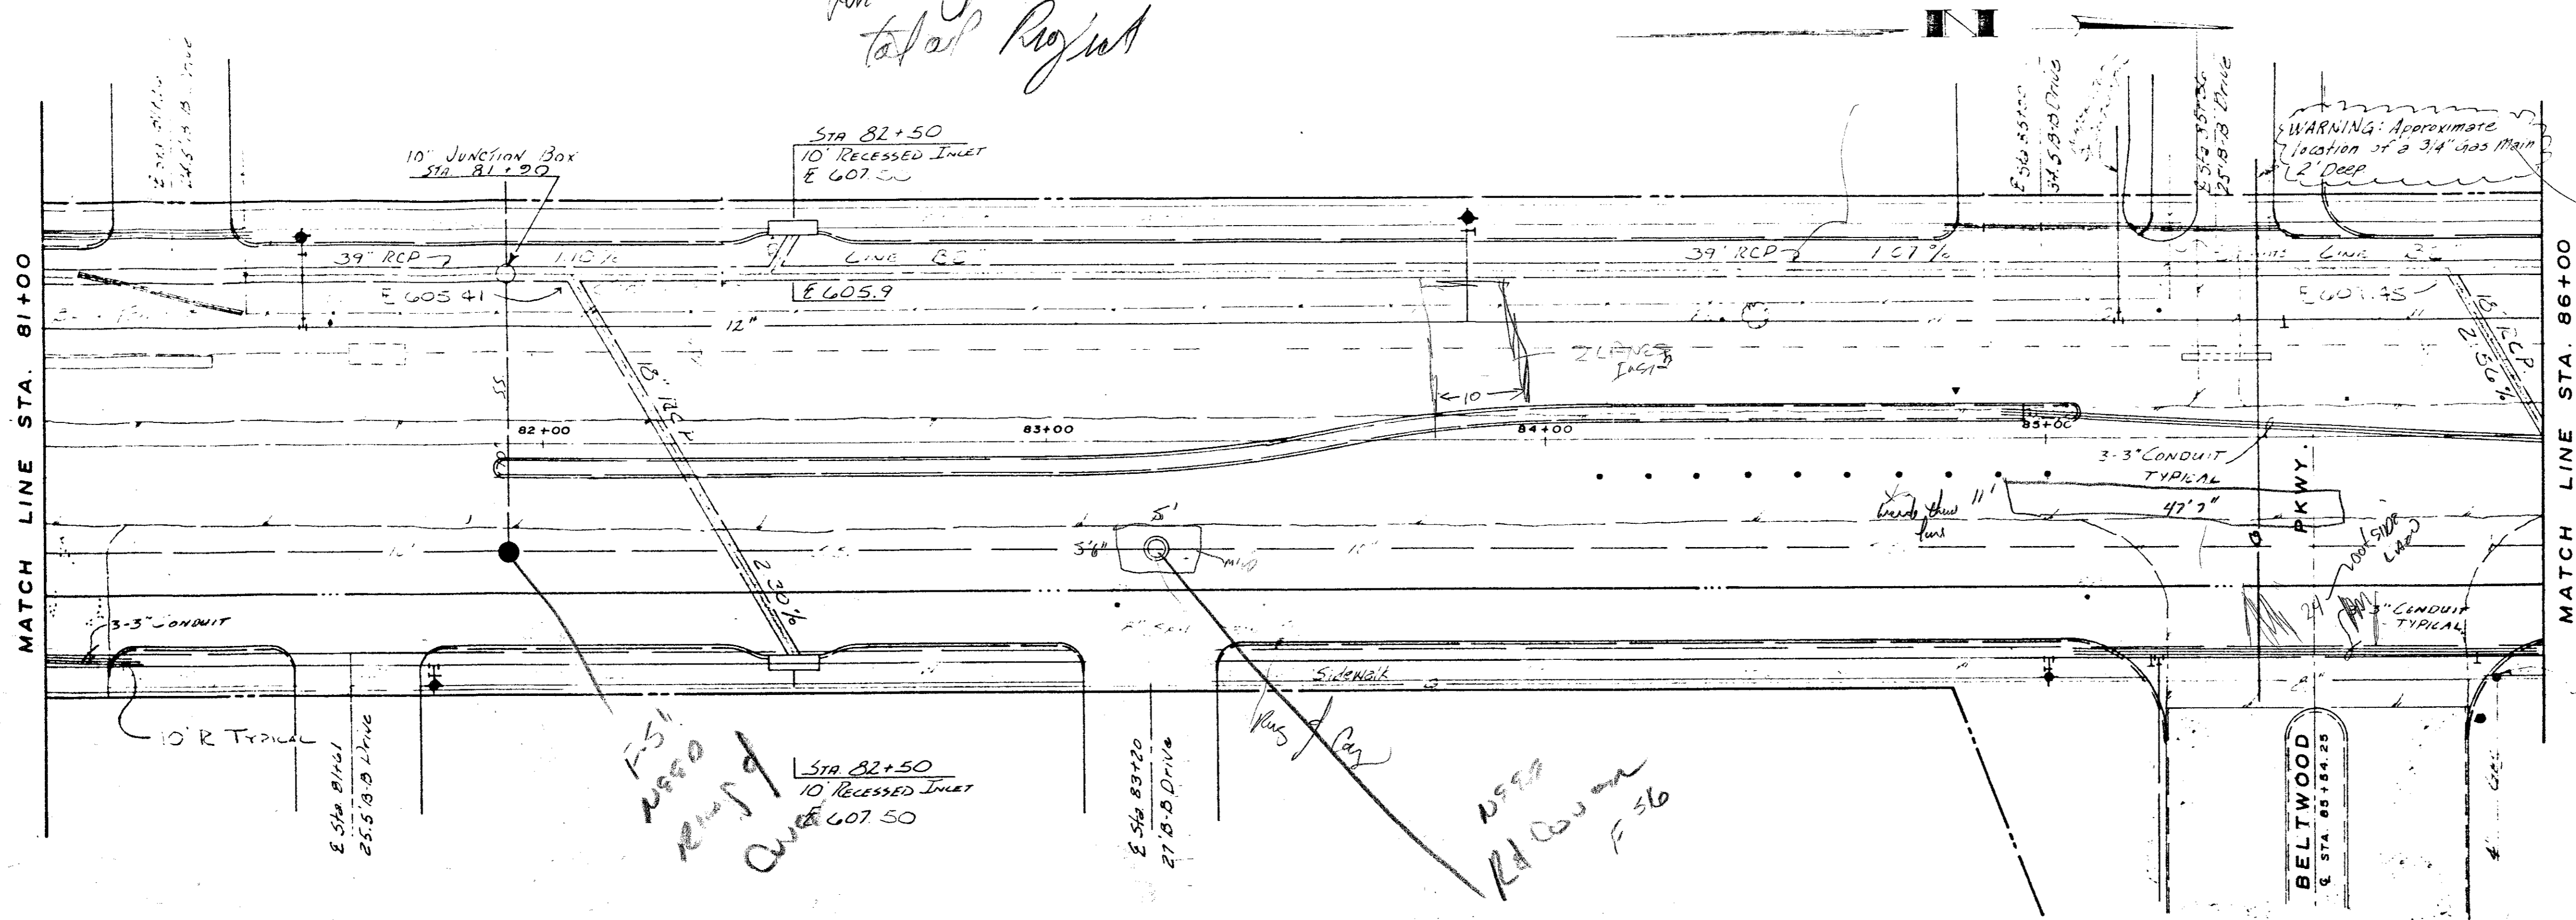

NO.	REVISION	BY	DATE

CITY OF FARMERS BRANCH, TEXAS
PUBLIC WORKS DEPARTMENT
ENGINEERING DIVISION

MIDWAY ROAD PAVING
SPRING VALLEY RD. TO BELT LINE RD.

DRAWN BY: O. D. APPROVED BY: _____
DESIGNED BY: J. P. DATE: 3-78

PROJECT NO. _____ SCALE: H. 1" = 20' SHEET 9 OF _____
V. 1" = 8'