


NOTE - COMPACTED FILL MUST BE IN PLACE PRIOR TO START OF CONSTRUCTION.

- BENCH MARKS**
1. "D" ON NORTH END CONC. HWY. ALONG EAST R. ELEV. = 584.76
 2. IR SPIKE IN 16" ELM EAST SIDE OF MONFORT, 55' SOUTH OF NORTH R. ELEV. = 614.37
 3. FINISH FLOOR BLDG @ N.E. CORNER OF PROPERTY ELEV. = 577.5



DESIGNED BY: *Don A. Tipton* DATE: 8/11/81
 DON A. TIPTON, INC. - CONSULTING ENGINEERS
Robert P. Treadwell DATE: 10-1-81
 ENGINEER OF DESIGN - WATER UTILITIES DEPT.
 CONTRACT NO. 81-405-P + 80-406-P - R. & J. Const. Co.

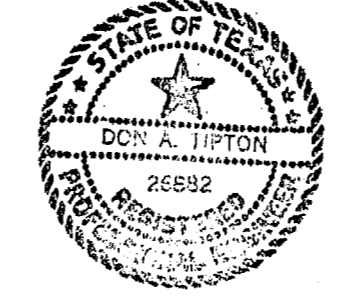

Revision of 8" D.I. WATER
 DESIGNED BY: *Robert P. Treadwell* DATE: 11/3/81
 Don A. Tipton, Inc. Consulting Engineers
Robert P. Treadwell DATE: 11-6-81
 ENGINEER OF DESIGN WATER UTILITIES DEPT.

WATER & SEWER PROFILE					
PRESTONWOOD JUNCTION CENTER					
DON A. TIPTON, INC. - CONSULT. ENG.					
DALLAS WATER UTILITIES DEPT.					
CITY OF DALLAS, TEXAS					
DESIGN	DRAWN	DATE	SCALE	NOTES	FILE NO.
DAT. INC.	DAT. INC.	8/81	1"=40' H 1/8"=6' V	DAT. INC.	411Q 1980