


△ LINE "A" ADJUSTED TO FIELD CONDITION  
 MOVED WATER MAIN 4' CHANGED 5%  
 DESIGNED BY *[Signature]* DATE: 1-23-85  
 ENGINEER OF DESIGN WATER UTIL. DEPT. DATE: 1-30-85  
 CONTRACT NO. \_\_\_\_\_

Benchmark No. 1 △  
 "X" cut in bonnet bolt of F.H. approx. 120' east of  
 northwest property corner of Prestonwood Pond 2.  
 Elevation: 601.36  
 Benchmark No. 2  
 R.R. Spike in Power Pole Approx. 295'  
 South of Southwest Property Corner  
 Elevation: 610.45

DESIGNED BY *[Signature]* DATE: 11-27-84  
 ENGINEER OF DESIGN WATER UTILITIES DEPT. DATE: 1-10-85  
 CONTRACT NO. *84-235P 84-236P Triple H Const. 11-28-84*

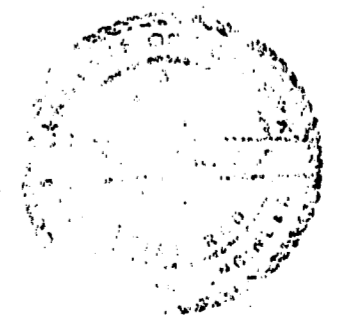

<b>SAN. SEWER PROFILES</b>					
PRESTONWOOD POND 2					
TREECE & COMPANY, INC.					
WATER UTILITIES DEPT. CITY OF DALLAS, TEXAS					
DESIGN	DRAWN	DATE	SCALE	NOTES	FILE NO.
T.A.C.	T.A.C.	Oct. '84	1"=40' H. 1"=6' V.		4110 1960

93