

LOT CORNER COORDINATES


#	Y	X
49	1416.196	2697.396
50	1416.196	2399.684
54	1416.196	2272.684
56	1416.196	2009.133
59	1543.196	2399.684
60	1747.419	2399.684
61	1543.196	2583.245
62	1385.925	2724.604

Prestonwood Pond II
 AIR 1960 Sh. 92, 93

ABST. 197
 CITY OF ADDISON

MARY I. MCENTIRE KNIGHT
 5.000 ACRES
 VOL. 76010 Page 12
 DATE: 1-15-76

Prestonwood Junction
 4112 1960 Sh. 47, 48

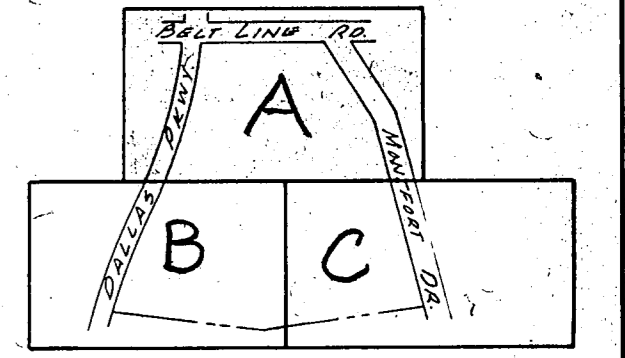

KEY MAP

ABST 182 PAGE 1
 CITY OF ADDISON

ELECTRIC DATA SYSTEMS CORP.
 4.945 ACRES
 RECORDED IN ABST. 1146 PAGE 2
 DATE: 6-28-74

MARY I. MCENTIRE KNIGHT
 Vol. 7124 Page 155

Note: FOR GENERAL NOTES SEE SHEETS 1 & 2 FOR SANITARY SEWER PROFILES, SEE SHEETS 3 & 4 FOR WATER LINE PROFILES, MULTIFUNCTION DRIVE.

34

FOR WATER RELOCATION
 SEE 411Q-1909A SH. 15

BENCHMARK: STANDARD WATER DEPT. BENCHMARK
 CENTER POINT NORTHWEST CORNER
 BELT LINE ROAD AND DALLAS PKWY.
 ELEV. 628.08

LOCATION: VILLAGE ON THE PARKWAY (CHANGE ORDER NO. 2)
 DESIGNED: ALBERT H. HALP ASSOCIATES, INC. & ENGINEERS
 DATE: 1-19-79
 R.O.V. APPROVED: [Signature]
 ENGINEER OF DESIGN: DALLAS WATER UTILITIES DEPT.
 CONTRACT NO. 78-2617, 78-2622 P. STIMSON & SEPT. 25, 1978

LOCATION: VILLAGE ON THE PARKWAY - PHASE I
 DESIGNED: ALBERT H. HALP ASSOCIATES, INC. & ENGINEERS
 DATE: 10-17-78
 R.O.V. APPROVED: [Signature]
 ENGINEER OF DESIGN: DALLAS WATER UTILITIES DEPT.
 CONTRACT NO. 78-2617, 78-2622 P. STIMSON & SEPT. 25, 1978

WATER & SANITARY SEWER PLANS						
VILLAGE ON THE PARKWAY						
VILLAGE PARKWAY VENTURE						
ALBERT H. HALP ASSOCIATES, INC. - ENGINEERS						
CITY OF ADDISON, TEXAS						
DESIGN	DRAWN	DATE	SCALE	NOTES	FILE	NO.
ALH	T.P.	MAY 1978	1"=40'	6193	411Q	1960

REVISIONS:
 1. REVISED 1/31/79 CHANGED B WATER MAIN TO 12" MAIN BETWEEN LOT B & A-C, CHANGED FIRE HYDRANT AND SERVICE LINE LOCATIONS.
 2. REVISED AS PER CHANGE ORDER #1 (411Q-1909) (MOVED B WATER SERVICE FOR LOT B 85' EAST)