

CONSTRUCTION PLANS FOR WHITE ROCK CREEK BASIN OAKS NORTH DRIVE DRAINAGE IMPROVEMENTS FROM 14920 OAKS N. DR. TO 14953 OAKS N. DR. TOWN OF ADDISON PROJECT NO. 20-04 NOVEMBER 2019

RECORD DRAWINGS

THE INTENT OF THE OWNER AND ENGINEER WAS TO CONSTRUCT THE FACILITIES ACCORDING TO THESE PLANS AS APPROVED BY THE TOWN OF ADDISON. THE OWNER OR ENGINEER DID NOT VERIFY LINES OR GRADES AFTER CONSTRUCTION AND IS NOT AWARE OF ANY CHANGES OR REVISIONS TO THESE PLANS DURING CONSTRUCTION EXCEPT AS NOTED BASED ON INFORMATION PROVIDED BY: JOE FUNK CONSTRUCTION, INC.
11226 INDIAN TRAIL
DALLAS, TX 75229

RECORD DRAWINGS

PLANS AND DETAILS APPROVED FOR THIS PROJECT

SHEET NO.	SHEET TITLE
1	COVER SHEET
2	SUMMARY OF QUANTITY SHEET
3	GENERAL NOTES
4	HORIZONTAL ALIGNMENT DATA
5	SURVEY CONTROL AND ROW MAP
6 THRU 7	REMOVAL PLANS
8	TRAFFIC CONTROL PLAN - NARRATIVE AND OVERALL PHASE MAP
9	DRAINAGE AREA MAP
10	INLET CALCULATIONS
11	HYDRAULIC CALCULATIONS
12 THRU 14	DRAINAGE PLAN & PROFILE
15	DRAINAGE LATERAL PROFILES
16	PAVING PLAN
17 THRU 18	EROSION CONTROL PLANS
19	SW3P
CD-01 THRU CD-06	CONSTRUCTION DETAILS
N/A	TXDOT DETAILS
	BC(1)-14 1/12
	BC(2)-14 2/12
	BC(4)-14 4/12
	BC(5)-14 5/12
	BC(8)-14 8/12
	BC(9)-14 9/12
	BC(10)-14 10/12
	BC(11)-14 11/12
	BC(12)-14 12/12
	TCP (2-2)-18
	PED-18 (4 SHEETS)

MAYOR

JOE CHOW

CITY COUNCIL


TOM BRAUN (MAYOR PRO TEMPORE)
LORI WARD (DEPUTY MAYOR PRO TEMPORE)
PAUL WALDEN
IVAN HUGHES
GUILLERMO QUINTANILLA
MARLIN WILLESEN

CITY MANAGER

WESLEY S. PIERSON

DIRECTOR OF PUBLIC WORKS AND
ENGINEERING

LISA A. PYLES

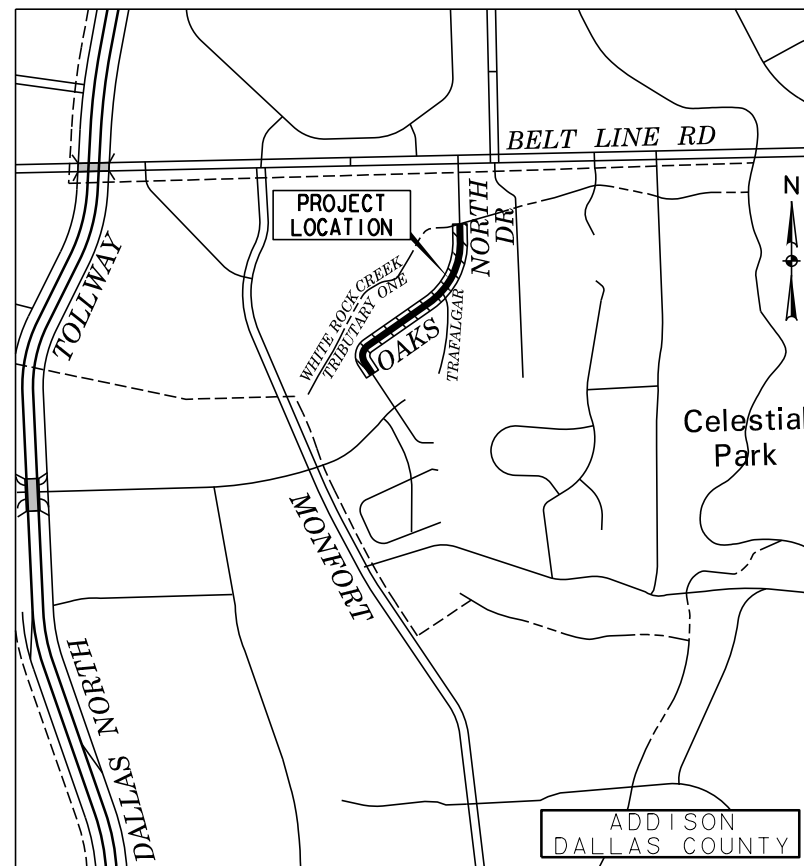

LOCATION MAP-NOT TO SCALE MAPSCO 15-A
PROJECT LENGTH: 961 LF




**PREPARED FOR
TOWN OF ADDISON, TEXAS**

PUBLIC WORKS AND ENGINEERING DEPARTMENT
16801 WESTGROVE DRIVE, ADDISON, TEXAS 75001-5190

CRIADO

4100 SPRING VALLEY ROAD, SUITE 1001
DALLAS, TX 75244
O: 972-392-9092 F: 972-392-9192
FIRM NO. F-4373

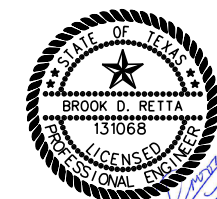

Nov 07, 2019