

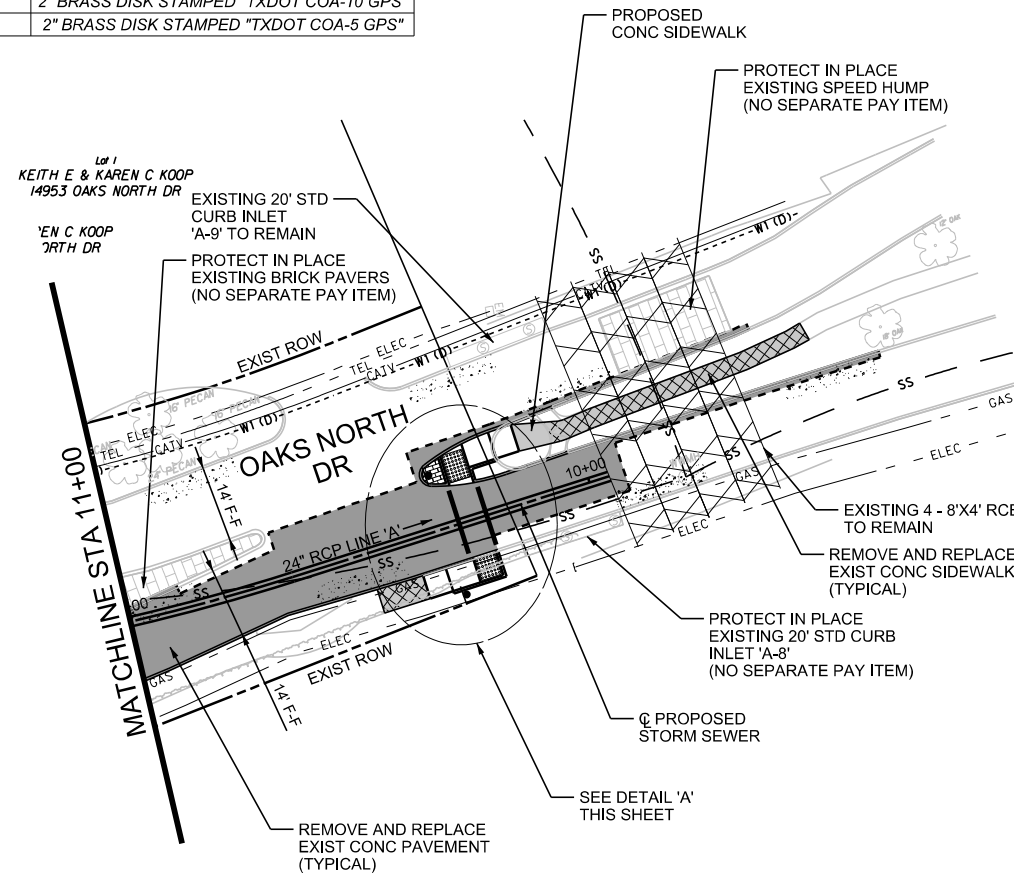


BENCHMARKS & CONTROL POINTS				
POINT	NORTHING	EASTING	ELEVATION	DESCRIPTION
COA-10	7,033,108.643	2,486,403.339	593.89	2" BRASS DISK STAMPED "TXDOT COA-10 GPS"
COA-5	7,036,216.214	2,482,155.872	630.10	2" BRASS DISK STAMPED "TXDOT COA-5 GPS"

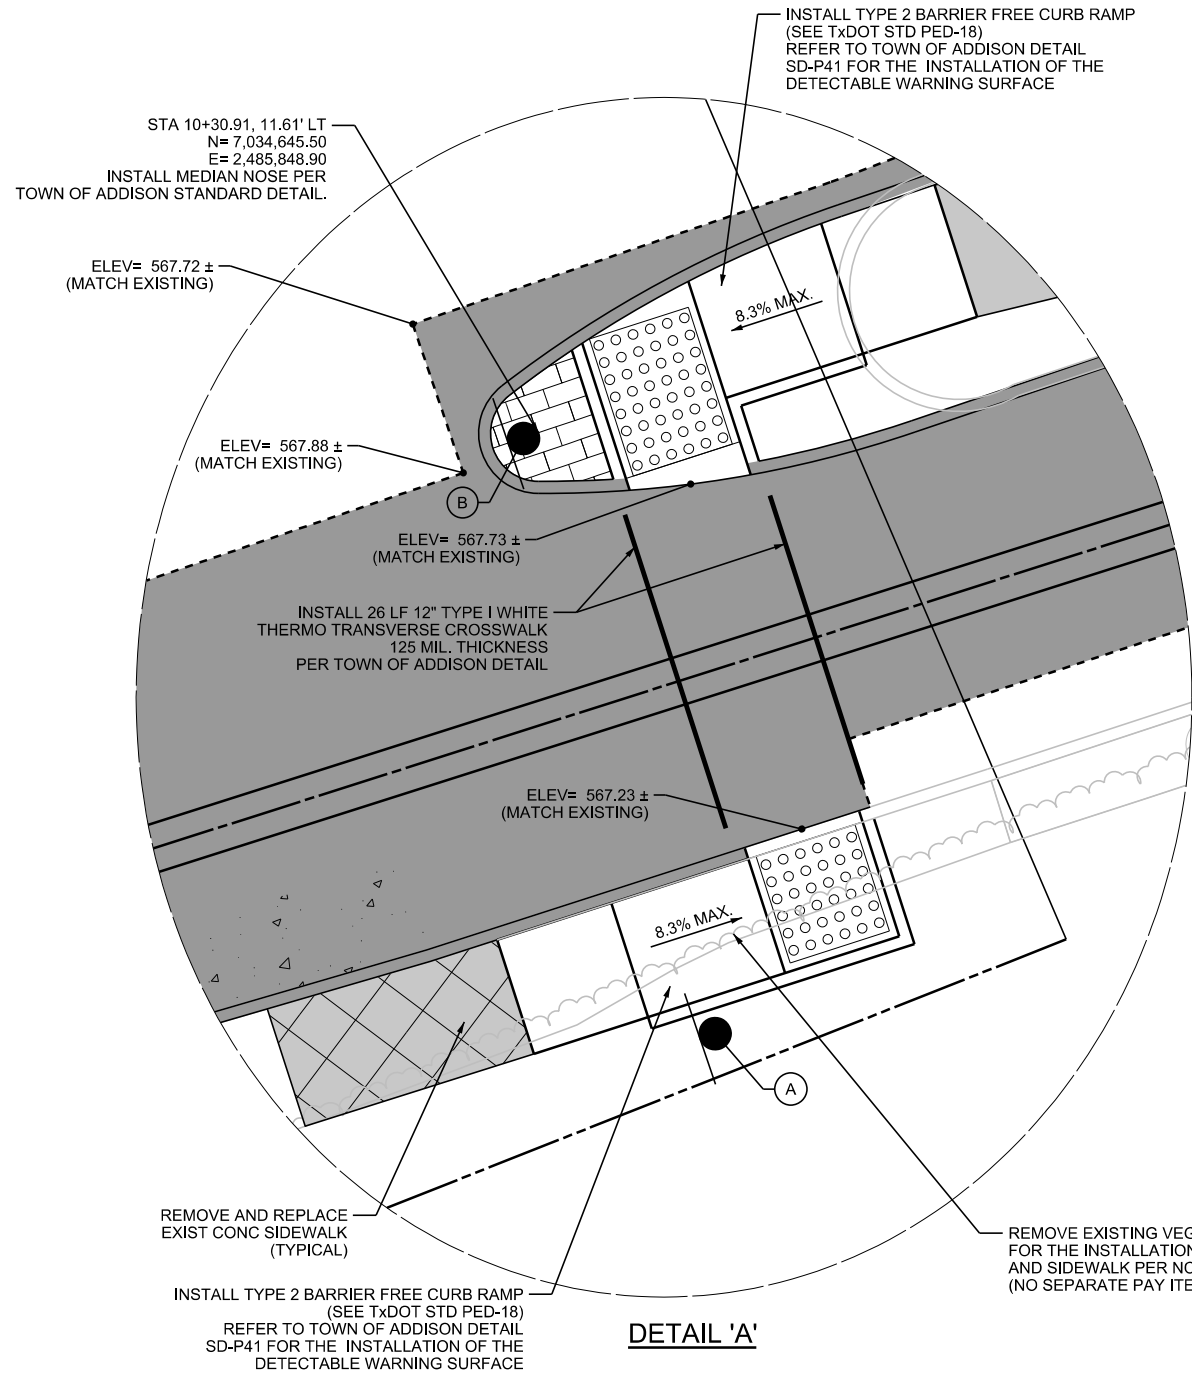

- LEGEND**
- REMOVE AND REPLACE REINFORCED CONCRETE PAVEMENT (HIGH EARLY STRENGTH)
  - REMOVE AND REPLACE REINFORCED CONCRETE SIDEWALK (EXPOSED AGGREGATE)
  - SAWCUT LINE (NO SEPARATE PAY ITEM)
  - PROPOSED SIGN

- NOTES:**
1. ALL DIMENSIONS AND STATION/OFFSETS ARE BASED ON THE CENTERLINE FOR THE PROPOSED STORM DRAIN TRUNK LINE.
  2. UNLESS NOTED, UTILITY CROSSING LOCATIONS BASED ON ASSUMED DEPTHS AND SHALL BE UNCOVERED AND VERIFIED BY CONTRACTOR PRIOR TO START OF CONSTRUCTION.
  3. POSITIVE DRAINAGE MUST BE MAINTAINED AT ALL TIMES.
  4. SURFACE OF PROPOSED SIDEWALK SHALL BE EXPOSED AGGREGATE (MATCH EXISTING SURFACE).
  5. TOWN INSPECTOR WILL DETERMINE FINAL PAVEMENT REMOVAL LIMITS. ACTUAL LIMITS OF REMOVAL MAY VARY BASED ON SITE CONDITIONS.
  6. NO SEPARATE PAY ITEM FOR PAVEMENT REPAIR HEADER. THIS ITEM SHALL BE SUBSIDIARY TO REINFORCED CONCRETE PAVEMENT ITEM.

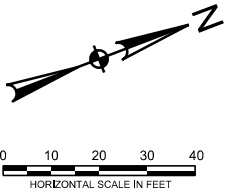

REVISIONS			
REV NO.	DATE	DESCRIPTION	BY
1			
2			




**CRIADO** 4100 SPRING VALLEY ROAD, SUITE 1001  
DALLAS, TX 75244  
O: 972-392-9092 F: 972-392-9192  
FIRM NO. F-4373

**PAVING PLAN**

**OAKS NORTH DRIVE  
DRAINAGE IMPROVEMENTS  
TOWN OF ADDISON, TEXAS**

DESIGN	DRAWN	DATE	SCALE	NOTES	FILE	NO.
CRIADO	CRIADO	NOV 2019	AS SHOWN	R14285.01	PAVE-01	16

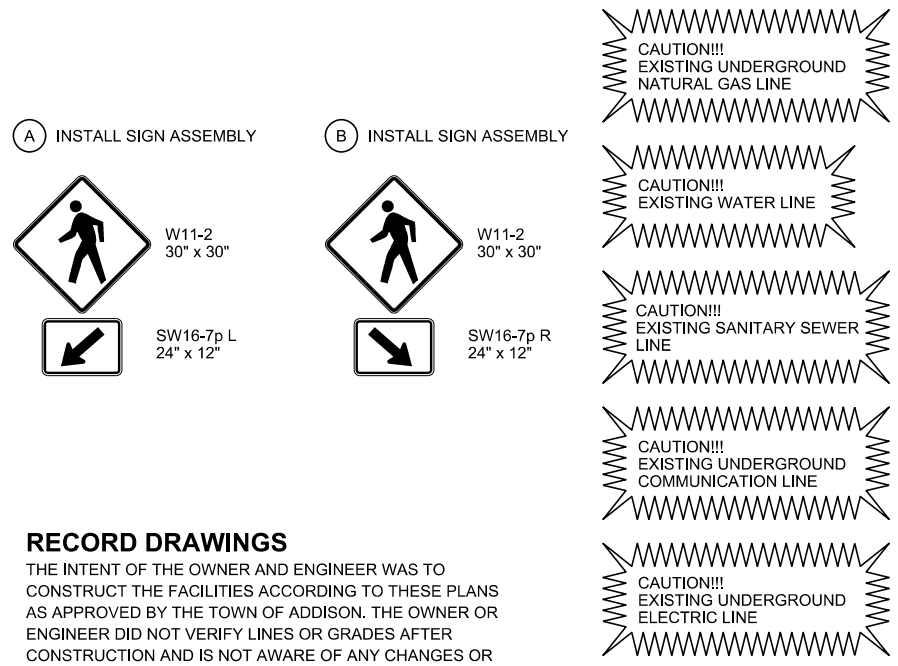

**RECORD DRAWINGS**

THE INTENT OF THE OWNER AND ENGINEER WAS TO CONSTRUCT THE FACILITIES ACCORDING TO THESE PLANS AS APPROVED BY THE TOWN OF ADDISON. THE OWNER OR ENGINEER DID NOT VERIFY LINES OR GRADES AFTER CONSTRUCTION AND IS NOT AWARE OF ANY CHANGES OR REVISIONS TO THESE PLANS DURING CONSTRUCTION EXCEPT AS NOTED BASED ON INFORMATION PROVIDED BY: JOE FUNK CONSTRUCTION, INC. 11226 INDIAN TRAIL DALLAS, TX 75229

DATE: 11/18/2020 TIME: 12:06:27 PM FILE NAME: N:\PROJECTS\14285.00\_Addison\_2017\Various Projects\14285.01\_White Rock Drainage\07\_DCN\076\_Sheet\1428501\_PAVE\_01.dgn